

**BRICK CHURCH ROAD
WATERLINE EXTENSION**



EBANKI IN COUNTY VIRGINIA

REVISIONS
1. ADDRESS VDOT COMMENTS - 6/4/19 - DRJ
2. ADDRESS VDOT COMMENTS - 6/28/19 - DR.
DESIGNED BY: GLR
DRAWN BY: PDG, DRJ
CHECKED BY: WNR
SCALE: 1" = 40'
DATE: APRIL 2019
PROJECT NUMBER: WCIP-340
SHEET TITLE:

PLAN & PROFILE

4

4 OF 11

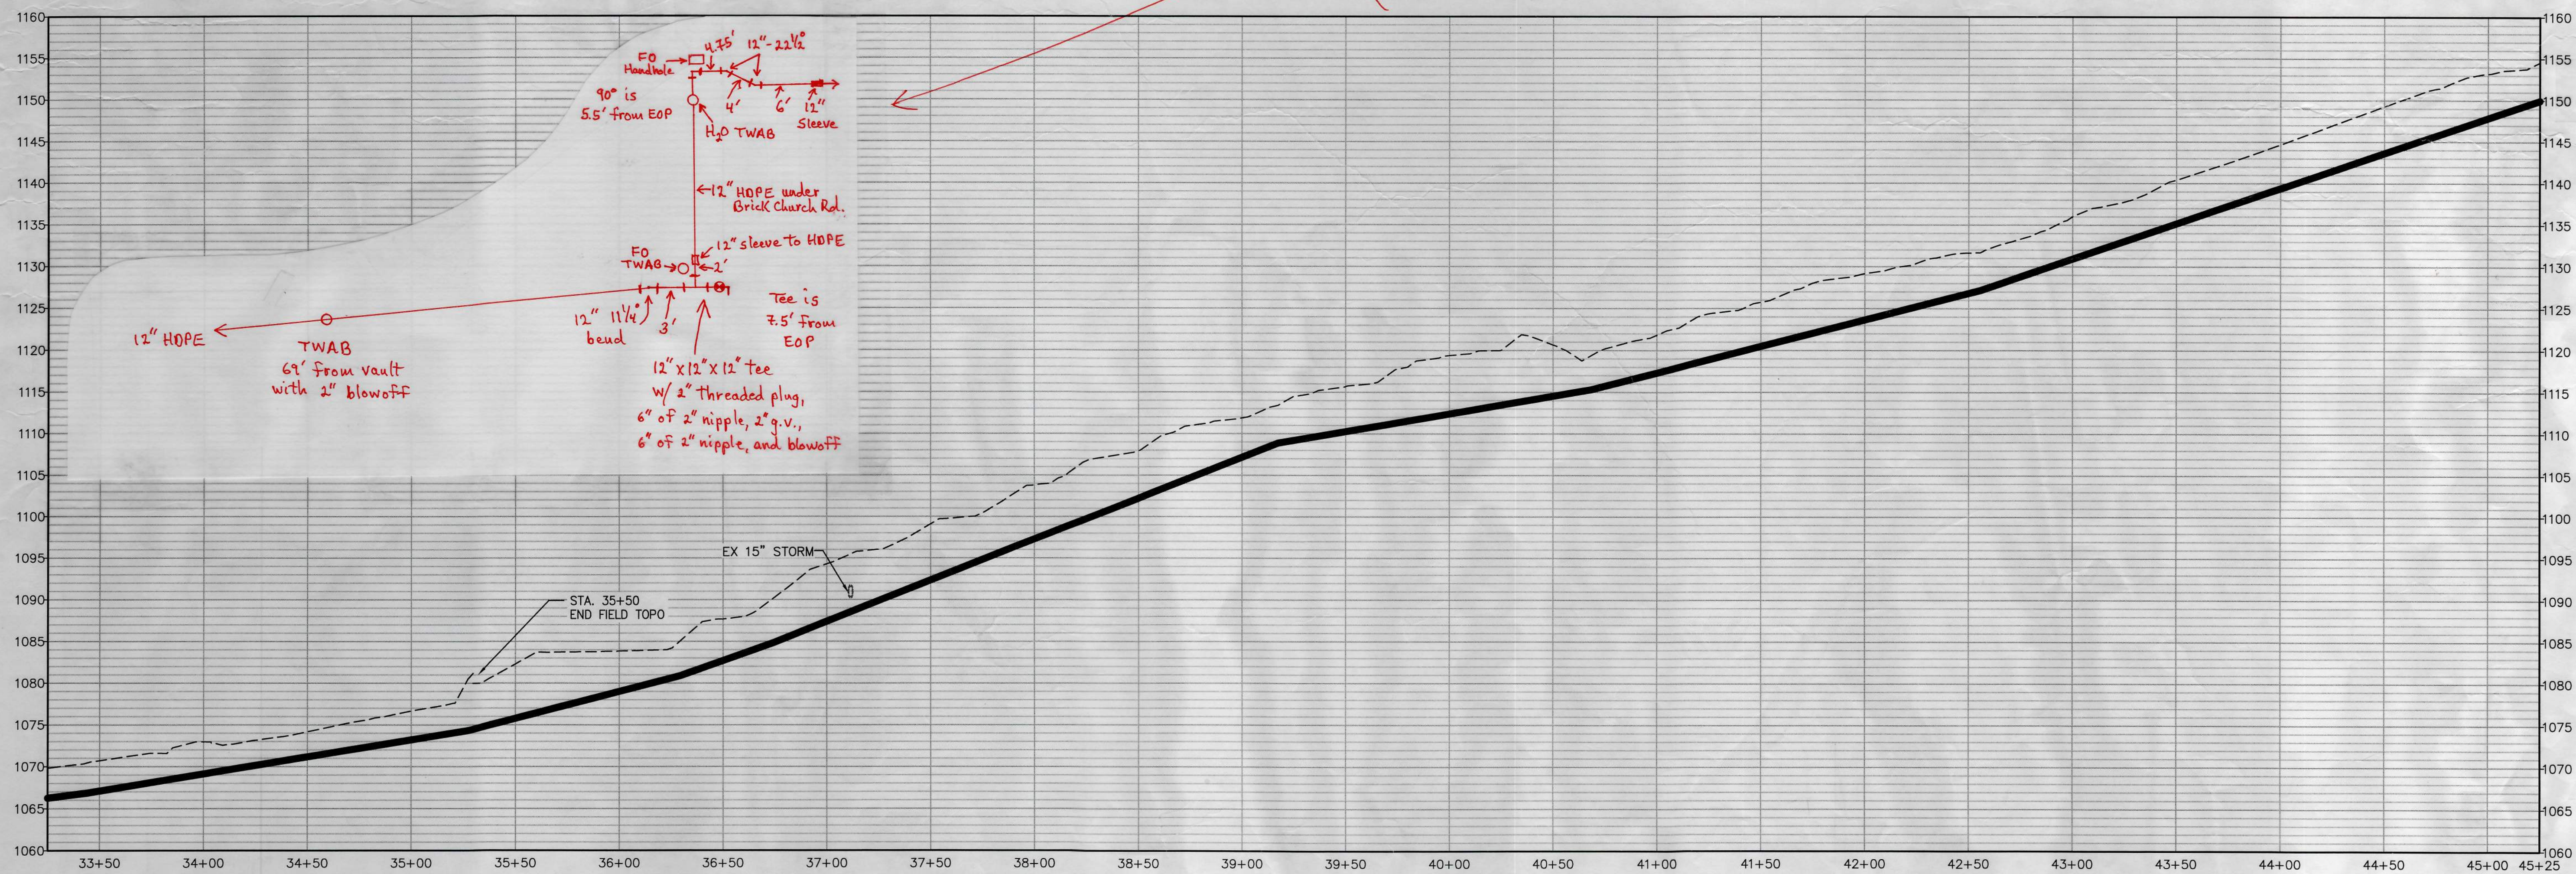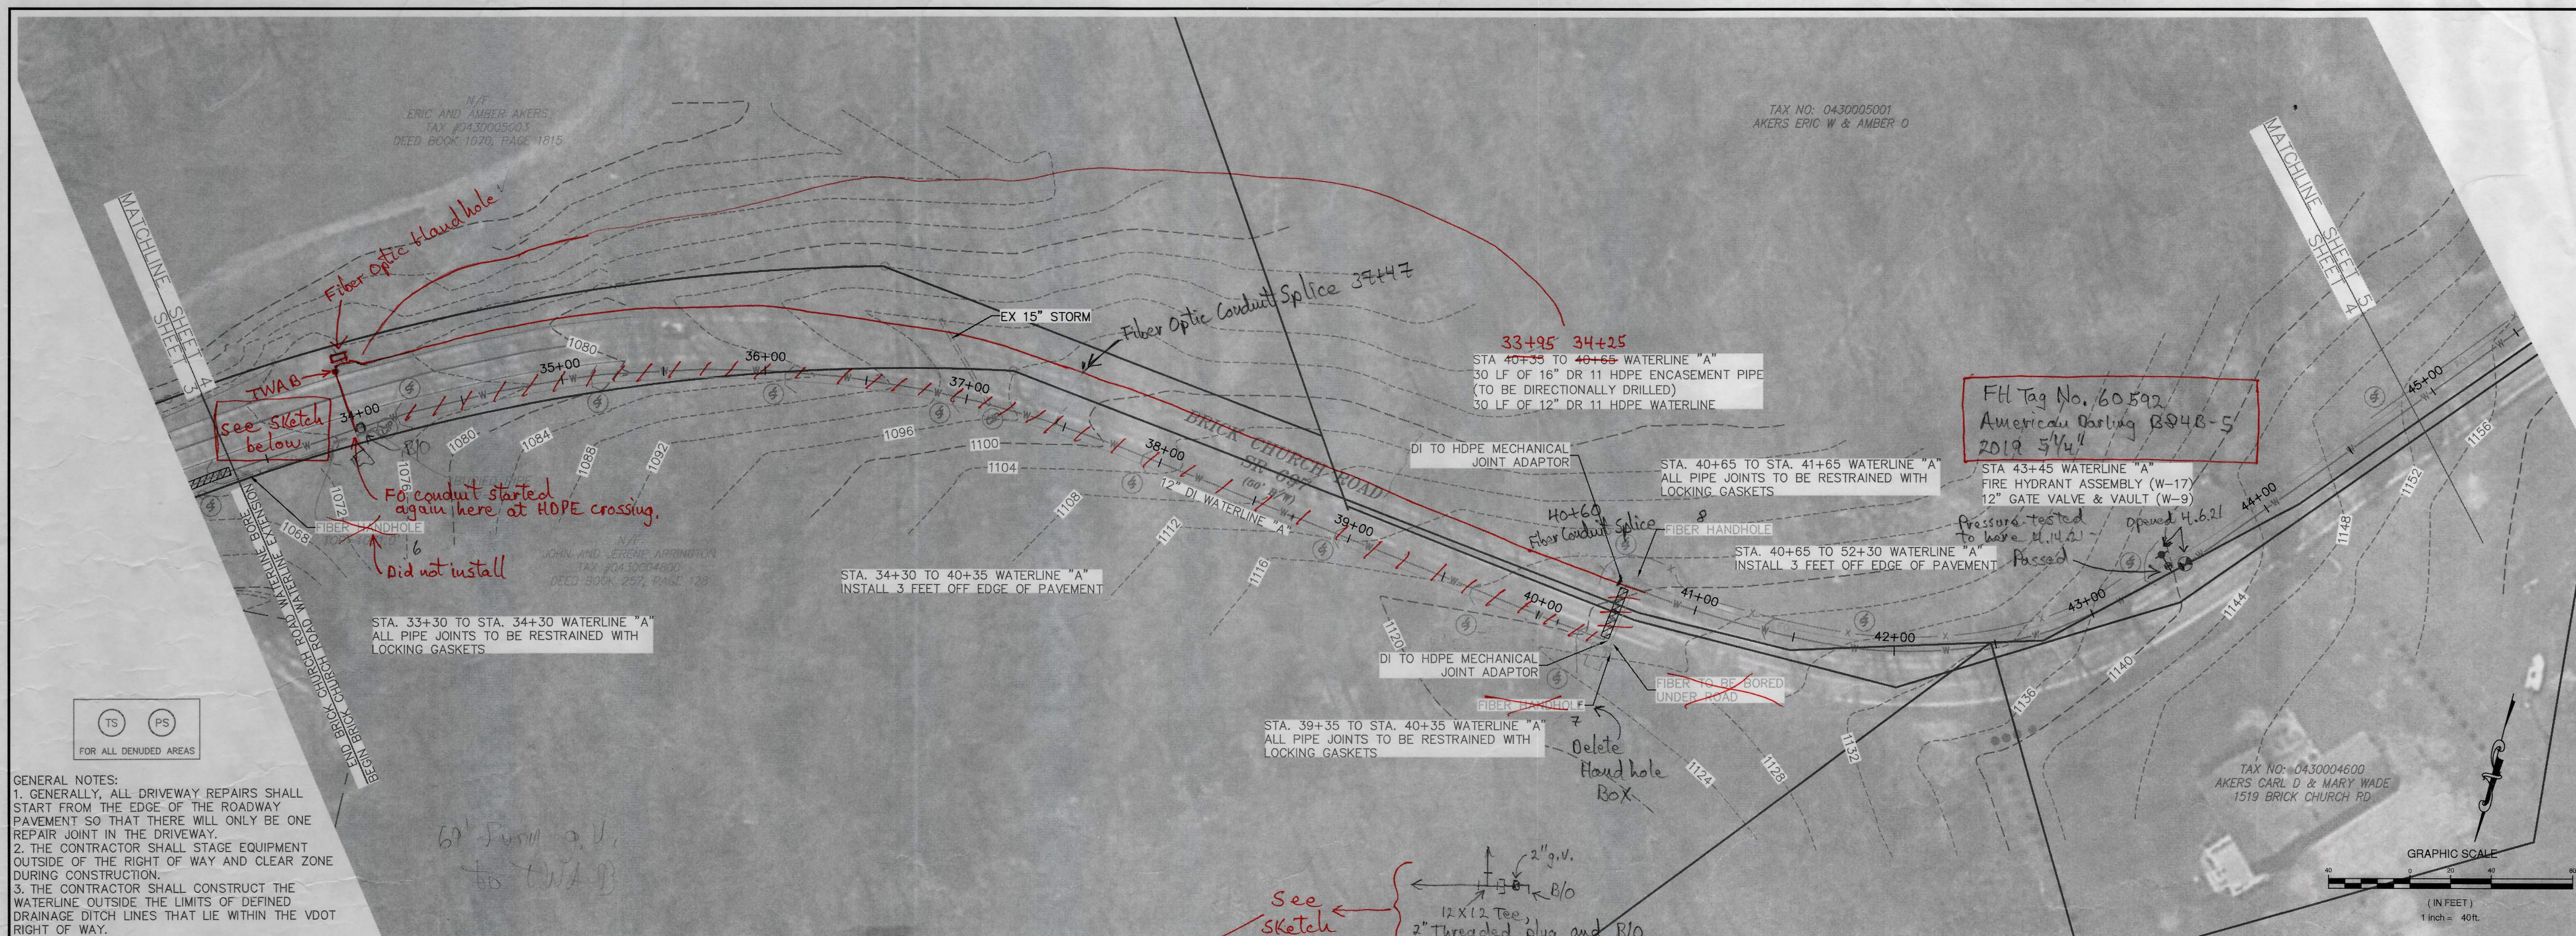

PROFILE: STA 33+25 TO STA 45+25 - Scale: H: 1"=40', V: 1"=10'