





GENERAL NOTES:
1. GENERALLY, ALL DRIVEWAY REPAIRS SHALL START FROM THE EDGE OF THE ROADWAY PAVEMENT SO THAT THERE WILL ONLY BE ONE REPAIR JOINT IN THE DRIVEWAY.
2. THE CONTRACTOR SHALL STAGE EQUIPMENT OUTSIDE OF THE RIGHT OF WAY AND CLEAR ZONE DURING CONSTRUCTION.
3. THE CONTRACTOR SHALL CONSTRUCT THE WATERLINE OUTSIDE THE LIMITS OF DEFINED DRAINAGE DITCH LINES THAT LIE WITHIN THE VDOT RIGHT OF WAY.

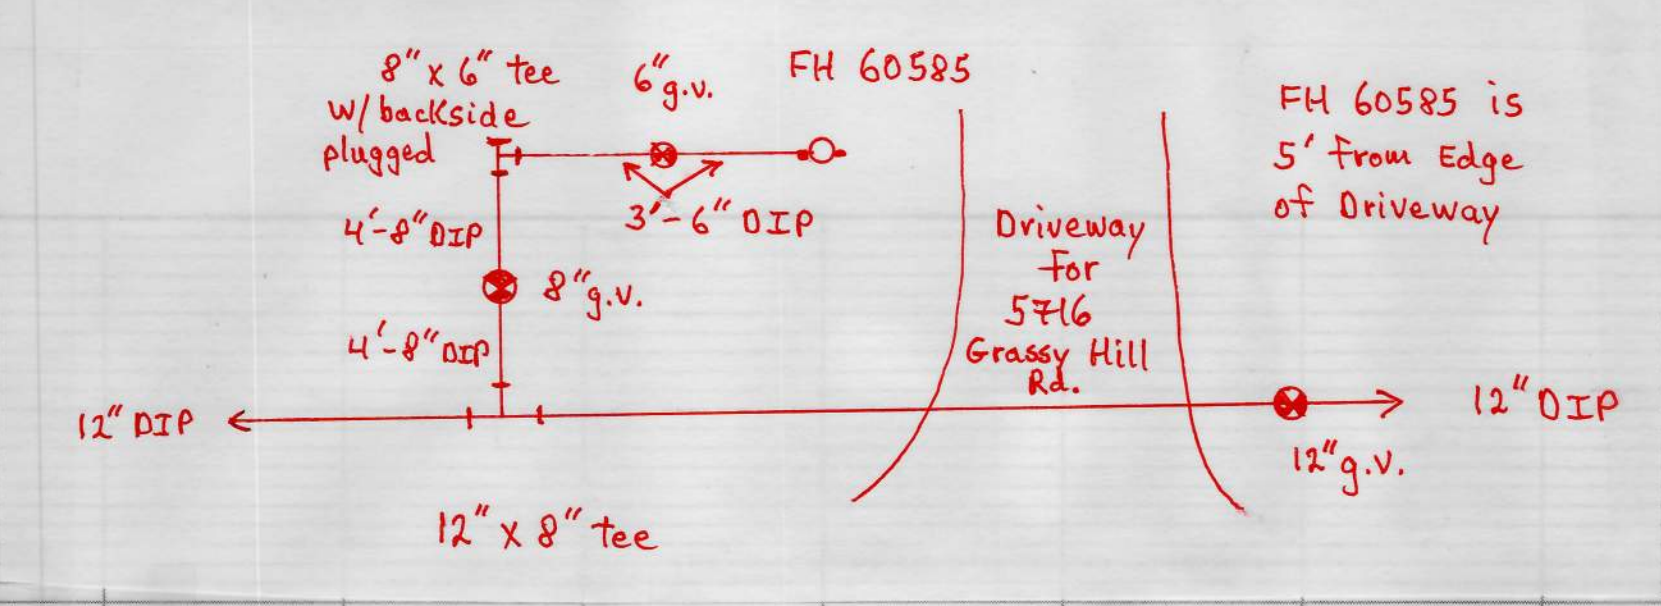

I instructed Downie (contractor) to hold off on installing the last handhole until we know if we will be installing fiber conduit on the Grassy Hill project on 4.30.20.
on 5.7.20 I told Downie to leave the fiber conduit on the reel in the field, and don't install a handhole box yet.
there is 410' of conduit left on the reel.

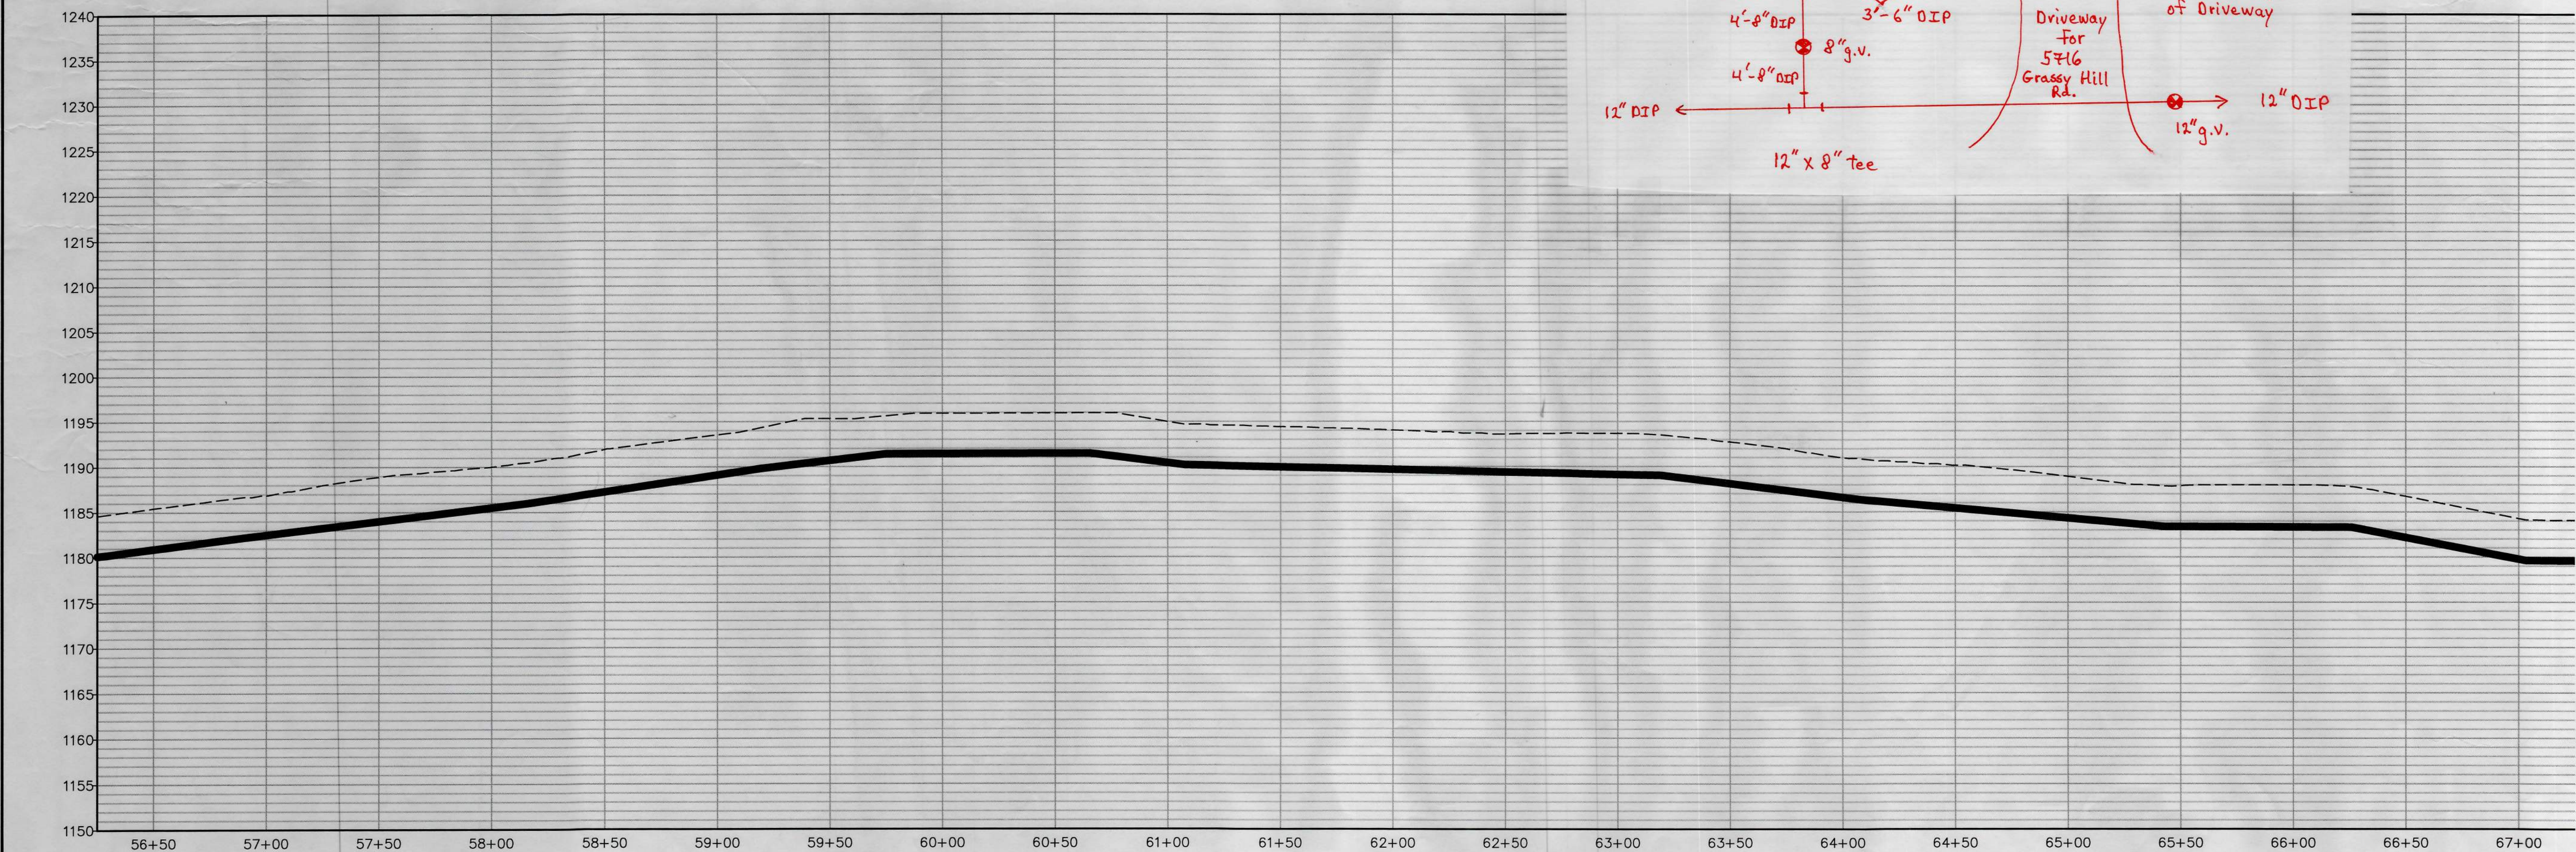

BRICK CHURCH ROAD WATERLINE EXTENSION

FRANKLIN COUNTY, VIRGINIA

REVISIONS	
1. ADDRESS VDOT COMMENTS - 6/4/19 - DRJ	
2. ADDRESS VDOT COMMENTS - 6/28/19 - DRJ	
DESIGNED BY:	GLR
DRAWN BY:	PDG, DRJ
CHECKED BY:	WNR
SCALE:	1" = 40'
DATE:	APRIL 2019
PROJECT NUMBER:	WCIP-340
SHEET TITLE:	

PLAN & PROFILE