
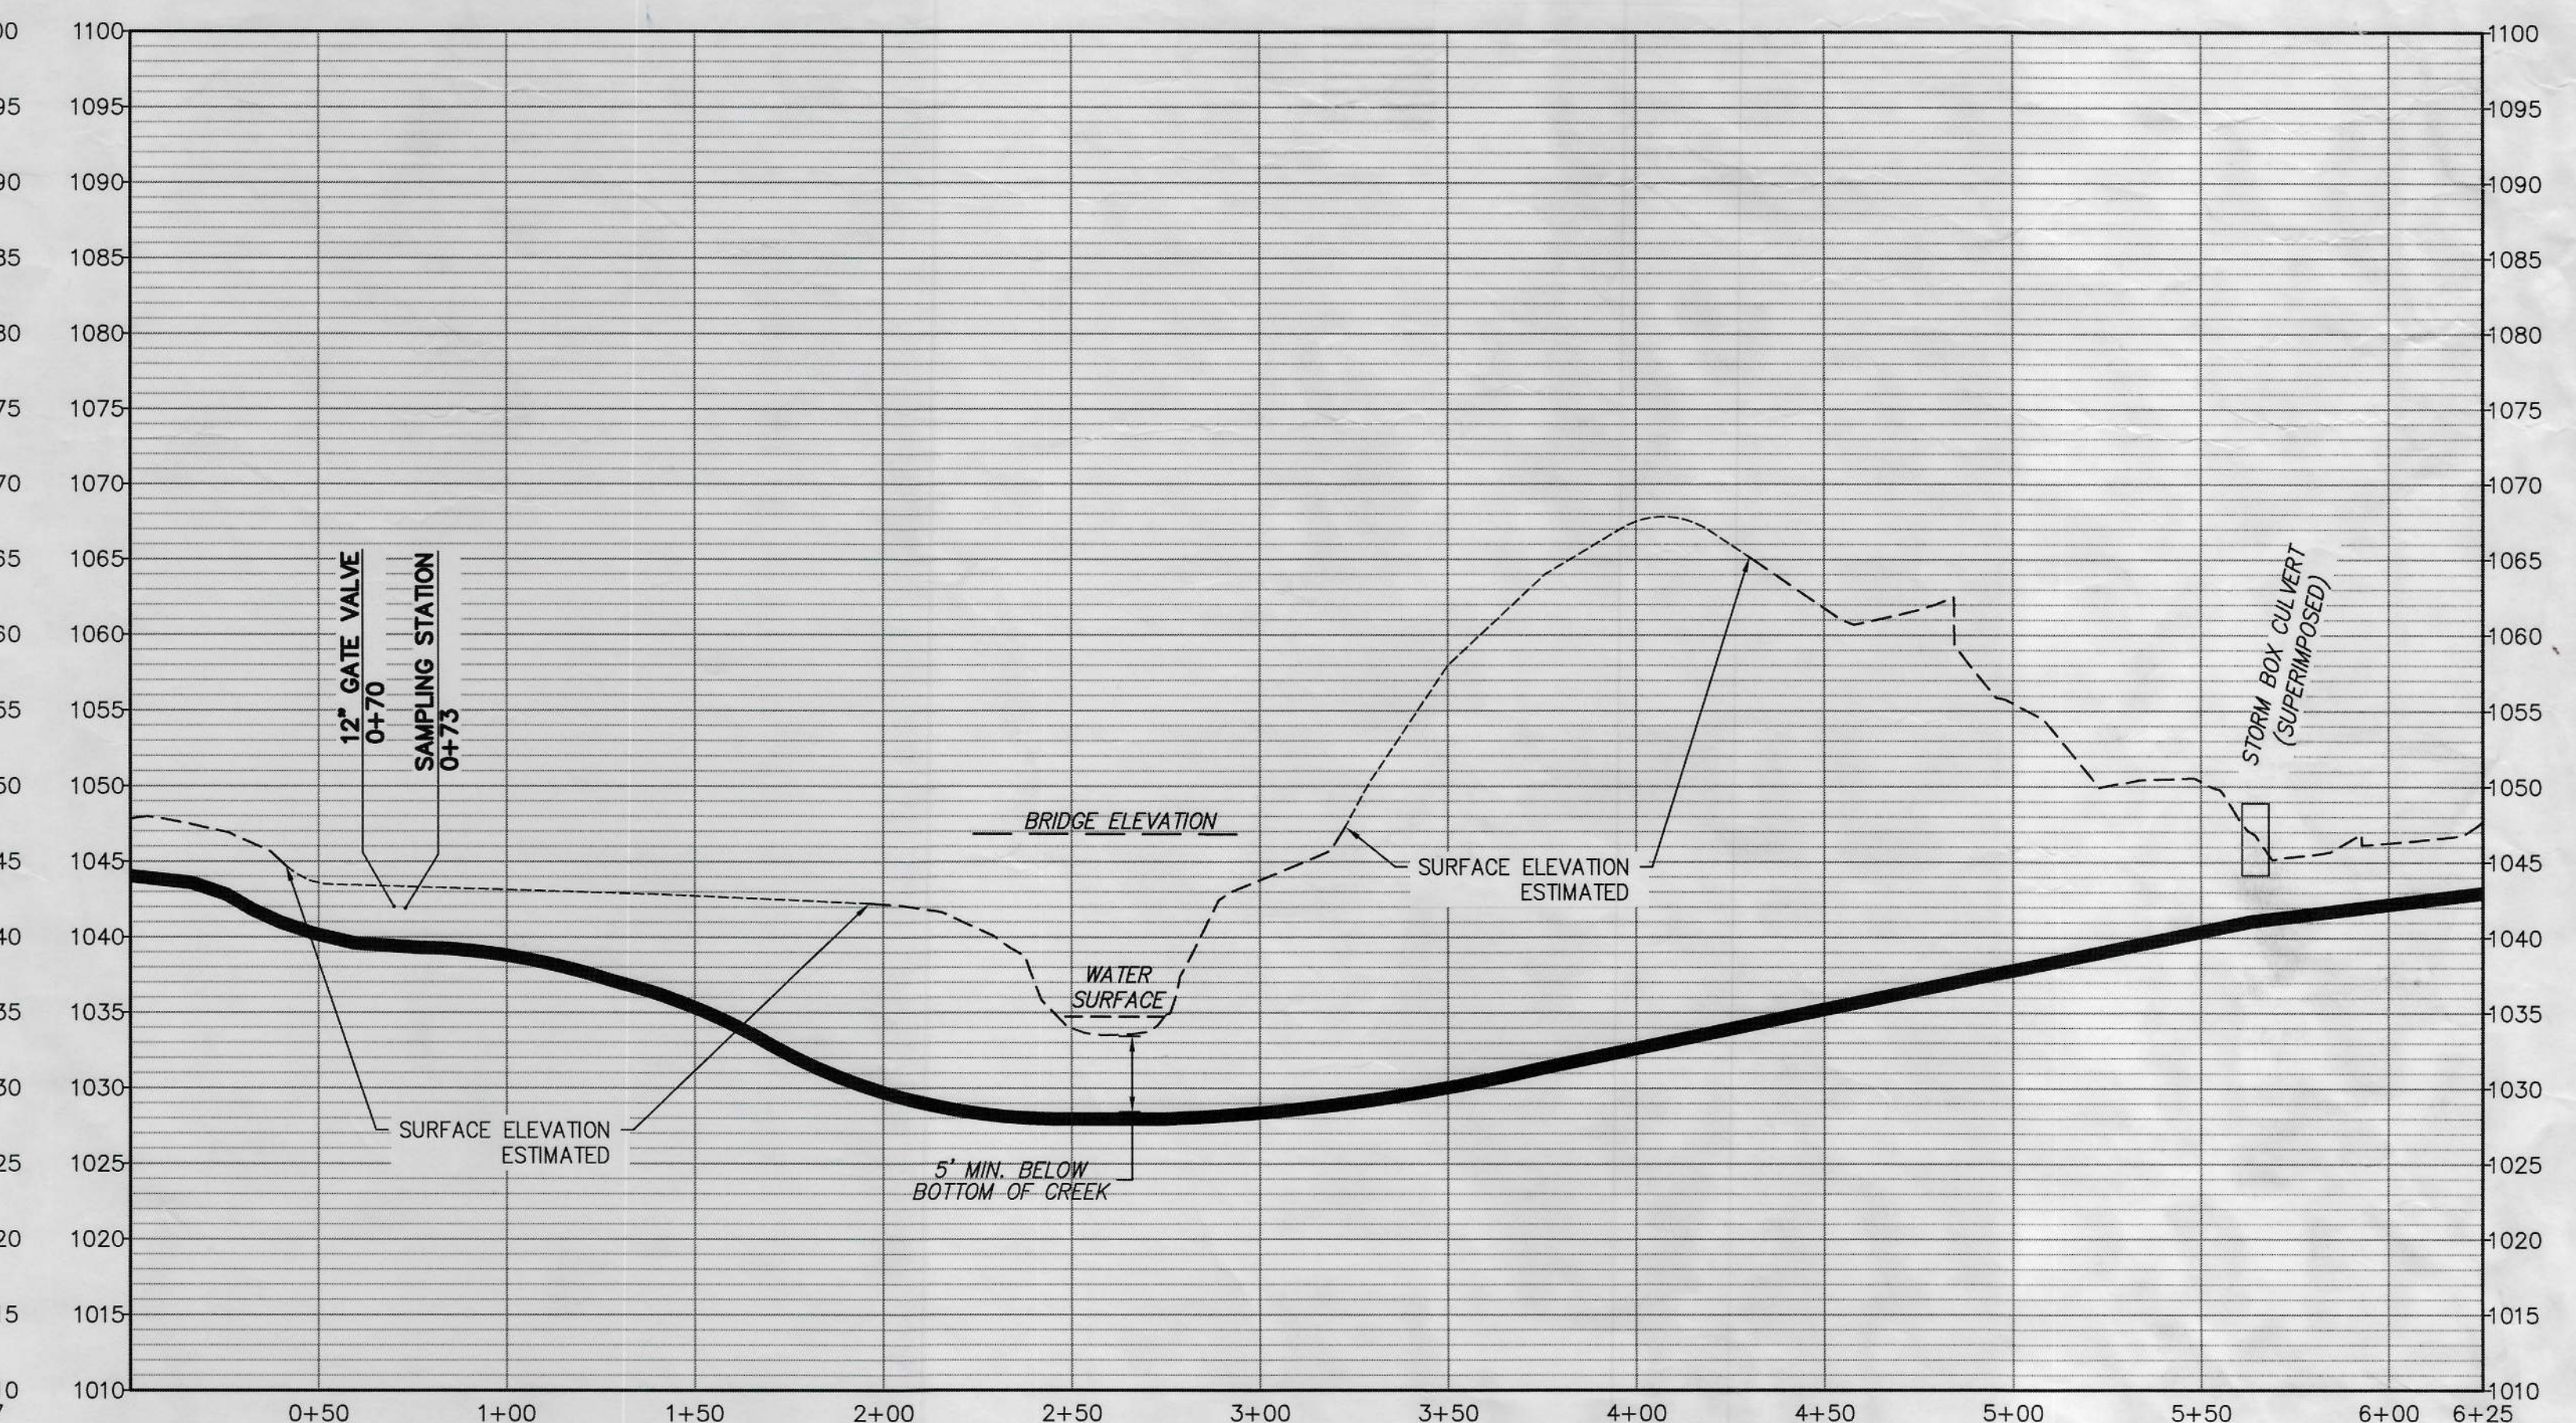
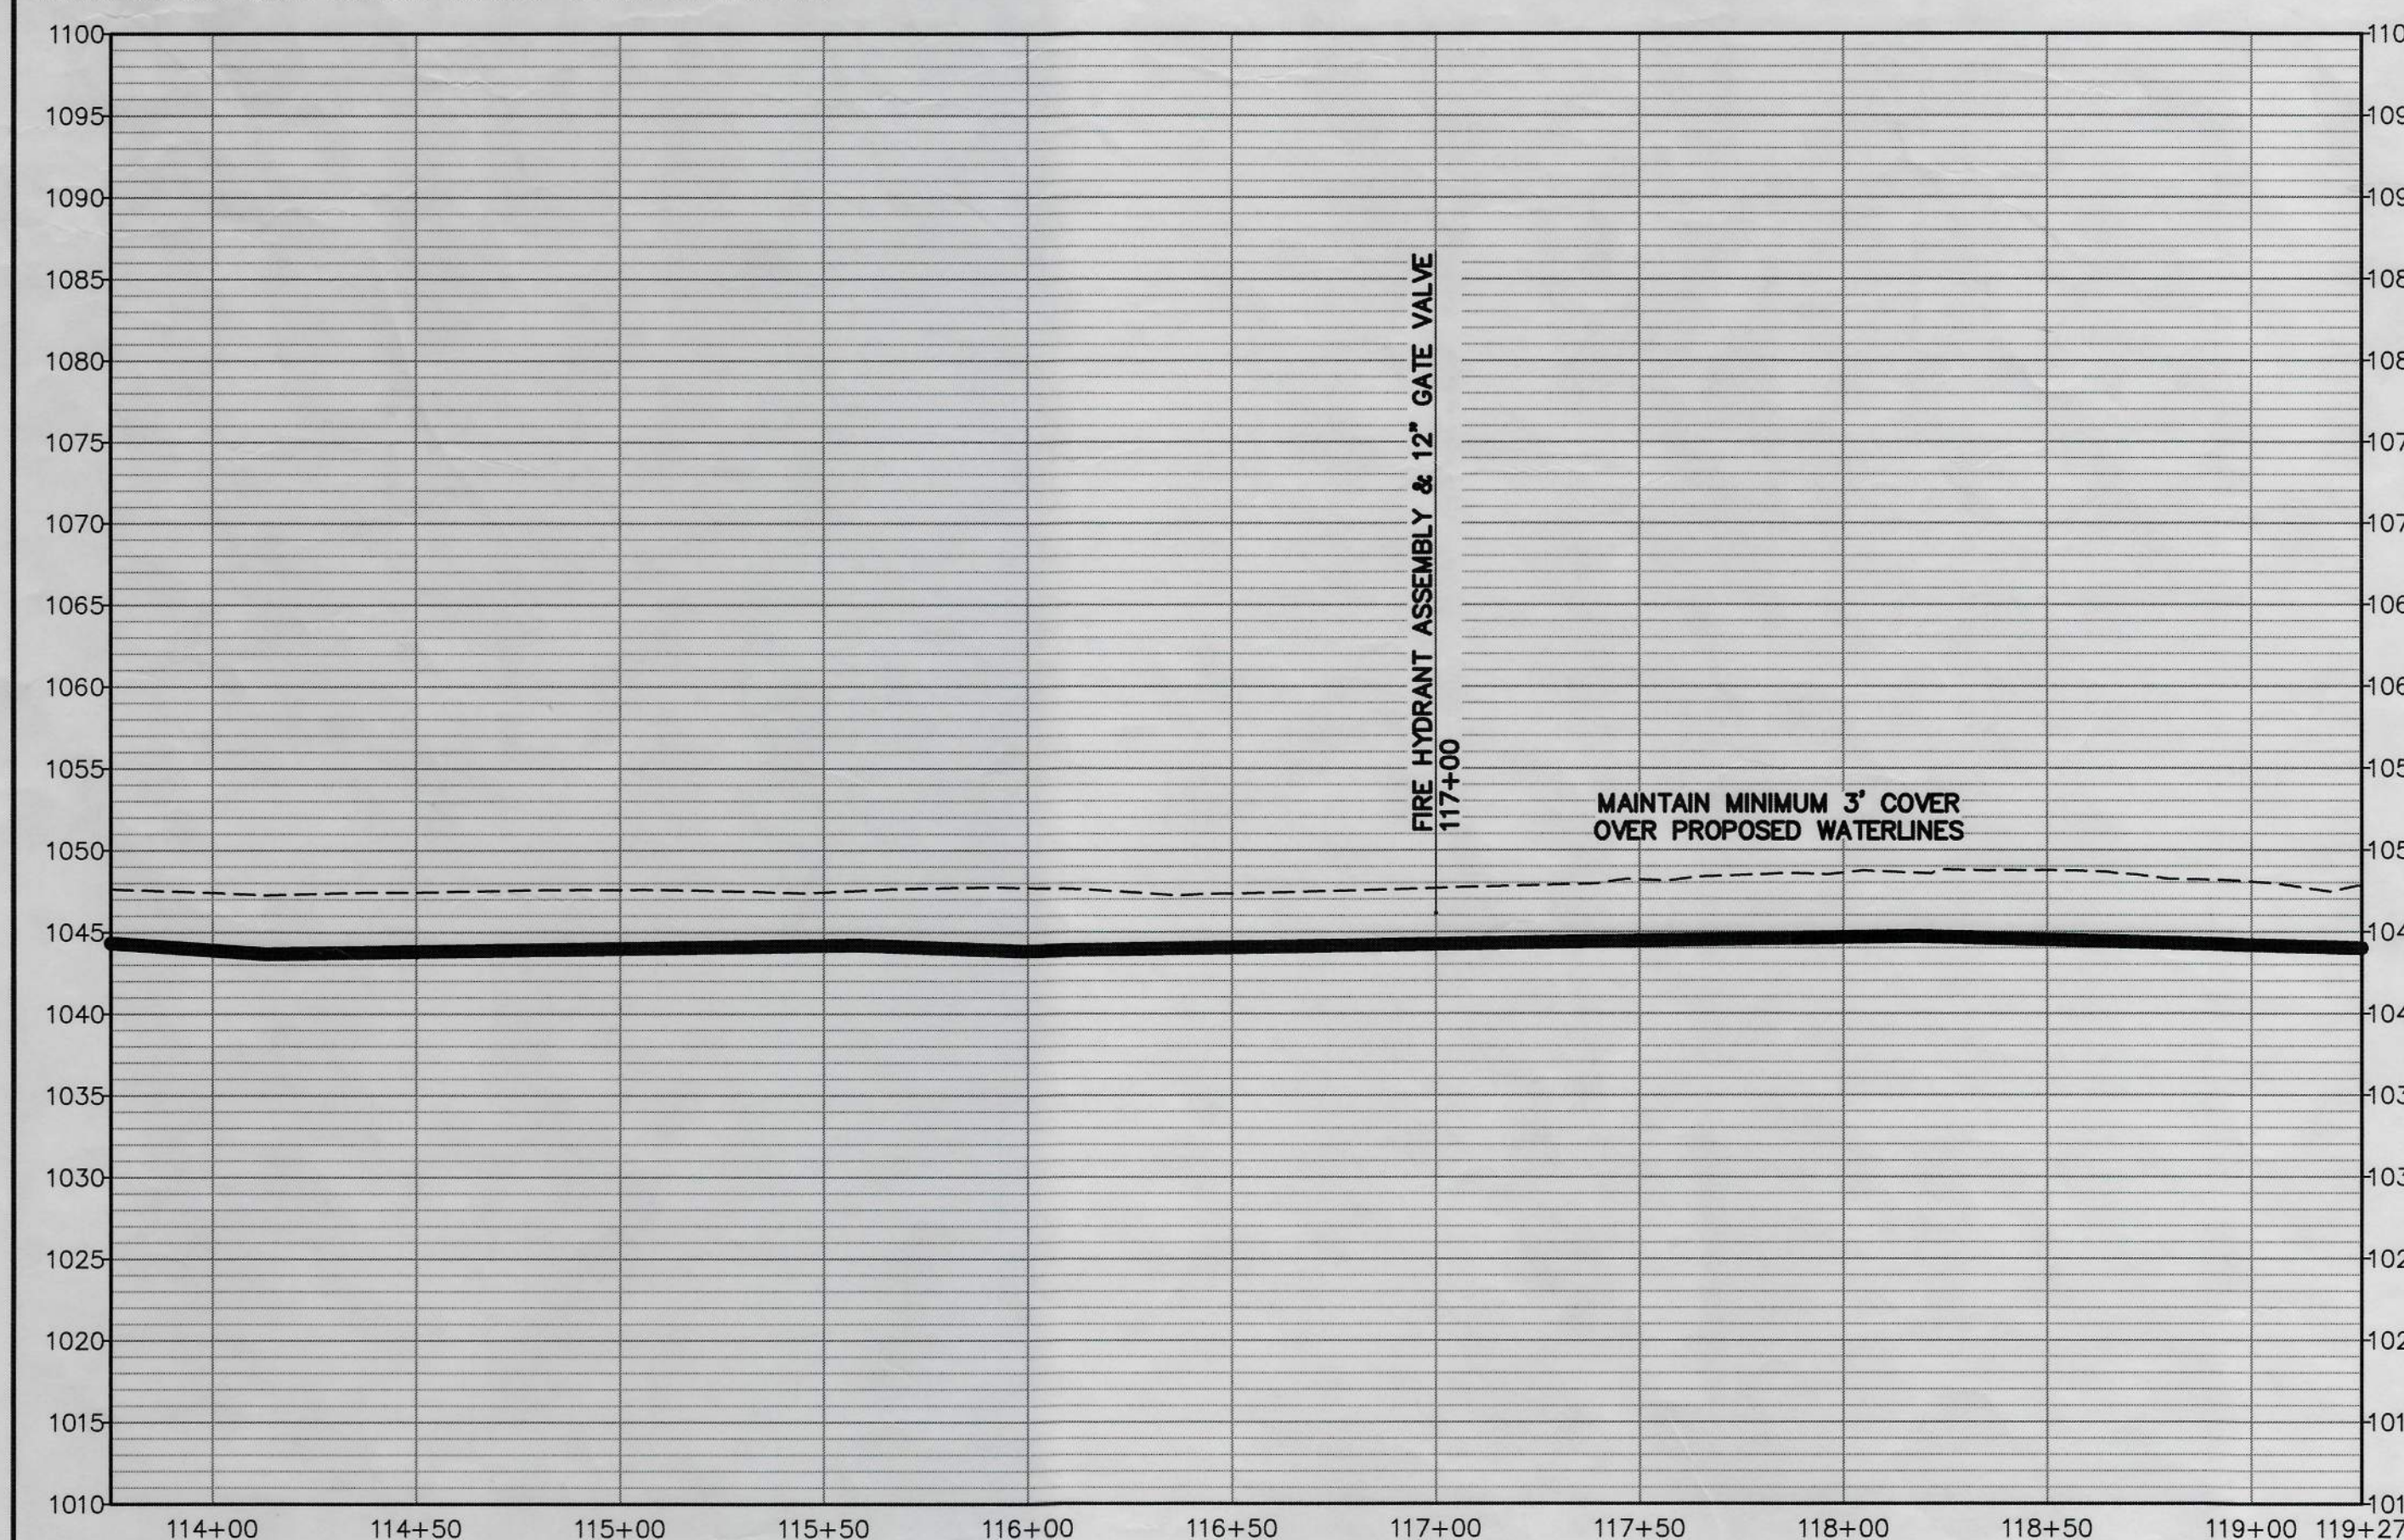


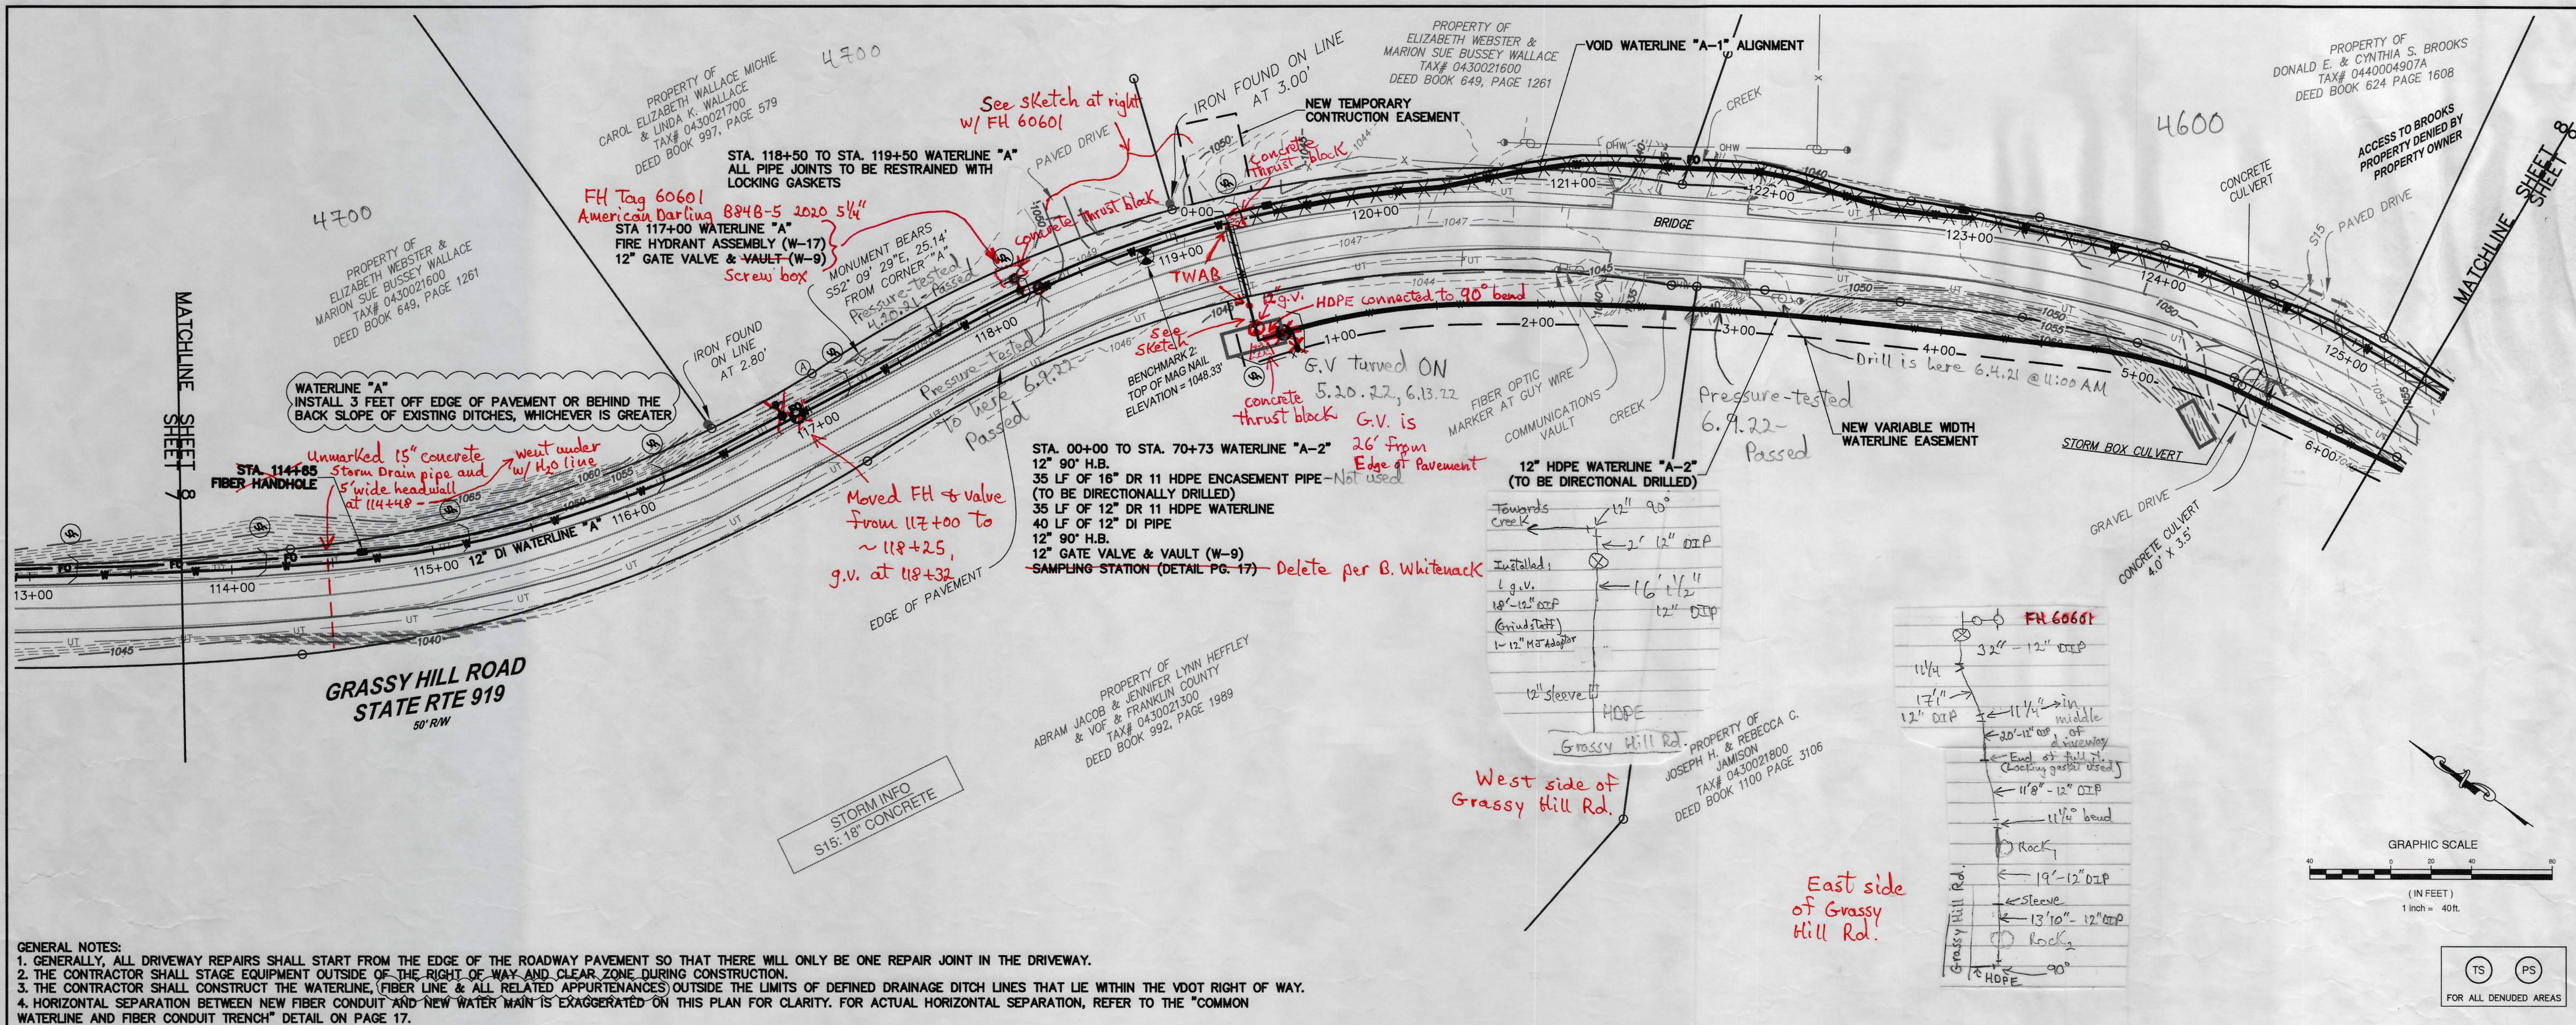

WESTERN VIRGINIA
WATER AUTHORITY

FRANKLIN COUNTY, VIRGINIA

GRASSY HILL ROAD
WATERLINE EXTENSION

REVISIONS

1. ADDRESS 3RD PARTY REVIEW COMMENTS - 3/23/20 - DRJ

2. ADDRESS VDOT REVIEW COMMENTS - 5/11/20 - DRJ

3. SHORTEN HDD BORE LENGTH PER WCB - 5/18/20 - DRJ

4. MORE BORE ALIGNMENT CHANGES - 9/08/20 - DRJ

DESIGNED BY: IAS

DRAWN BY: PDG, DRJ

CHECKED BY: WCB

SCALE: 1" = 40'

DATE: FEB 6 2020

PROJECT NUMBER: WCIP

SHEET TITLE: PLAN AND PROFILE

8

8 OF 19