


PROJECT LOCATION MAP

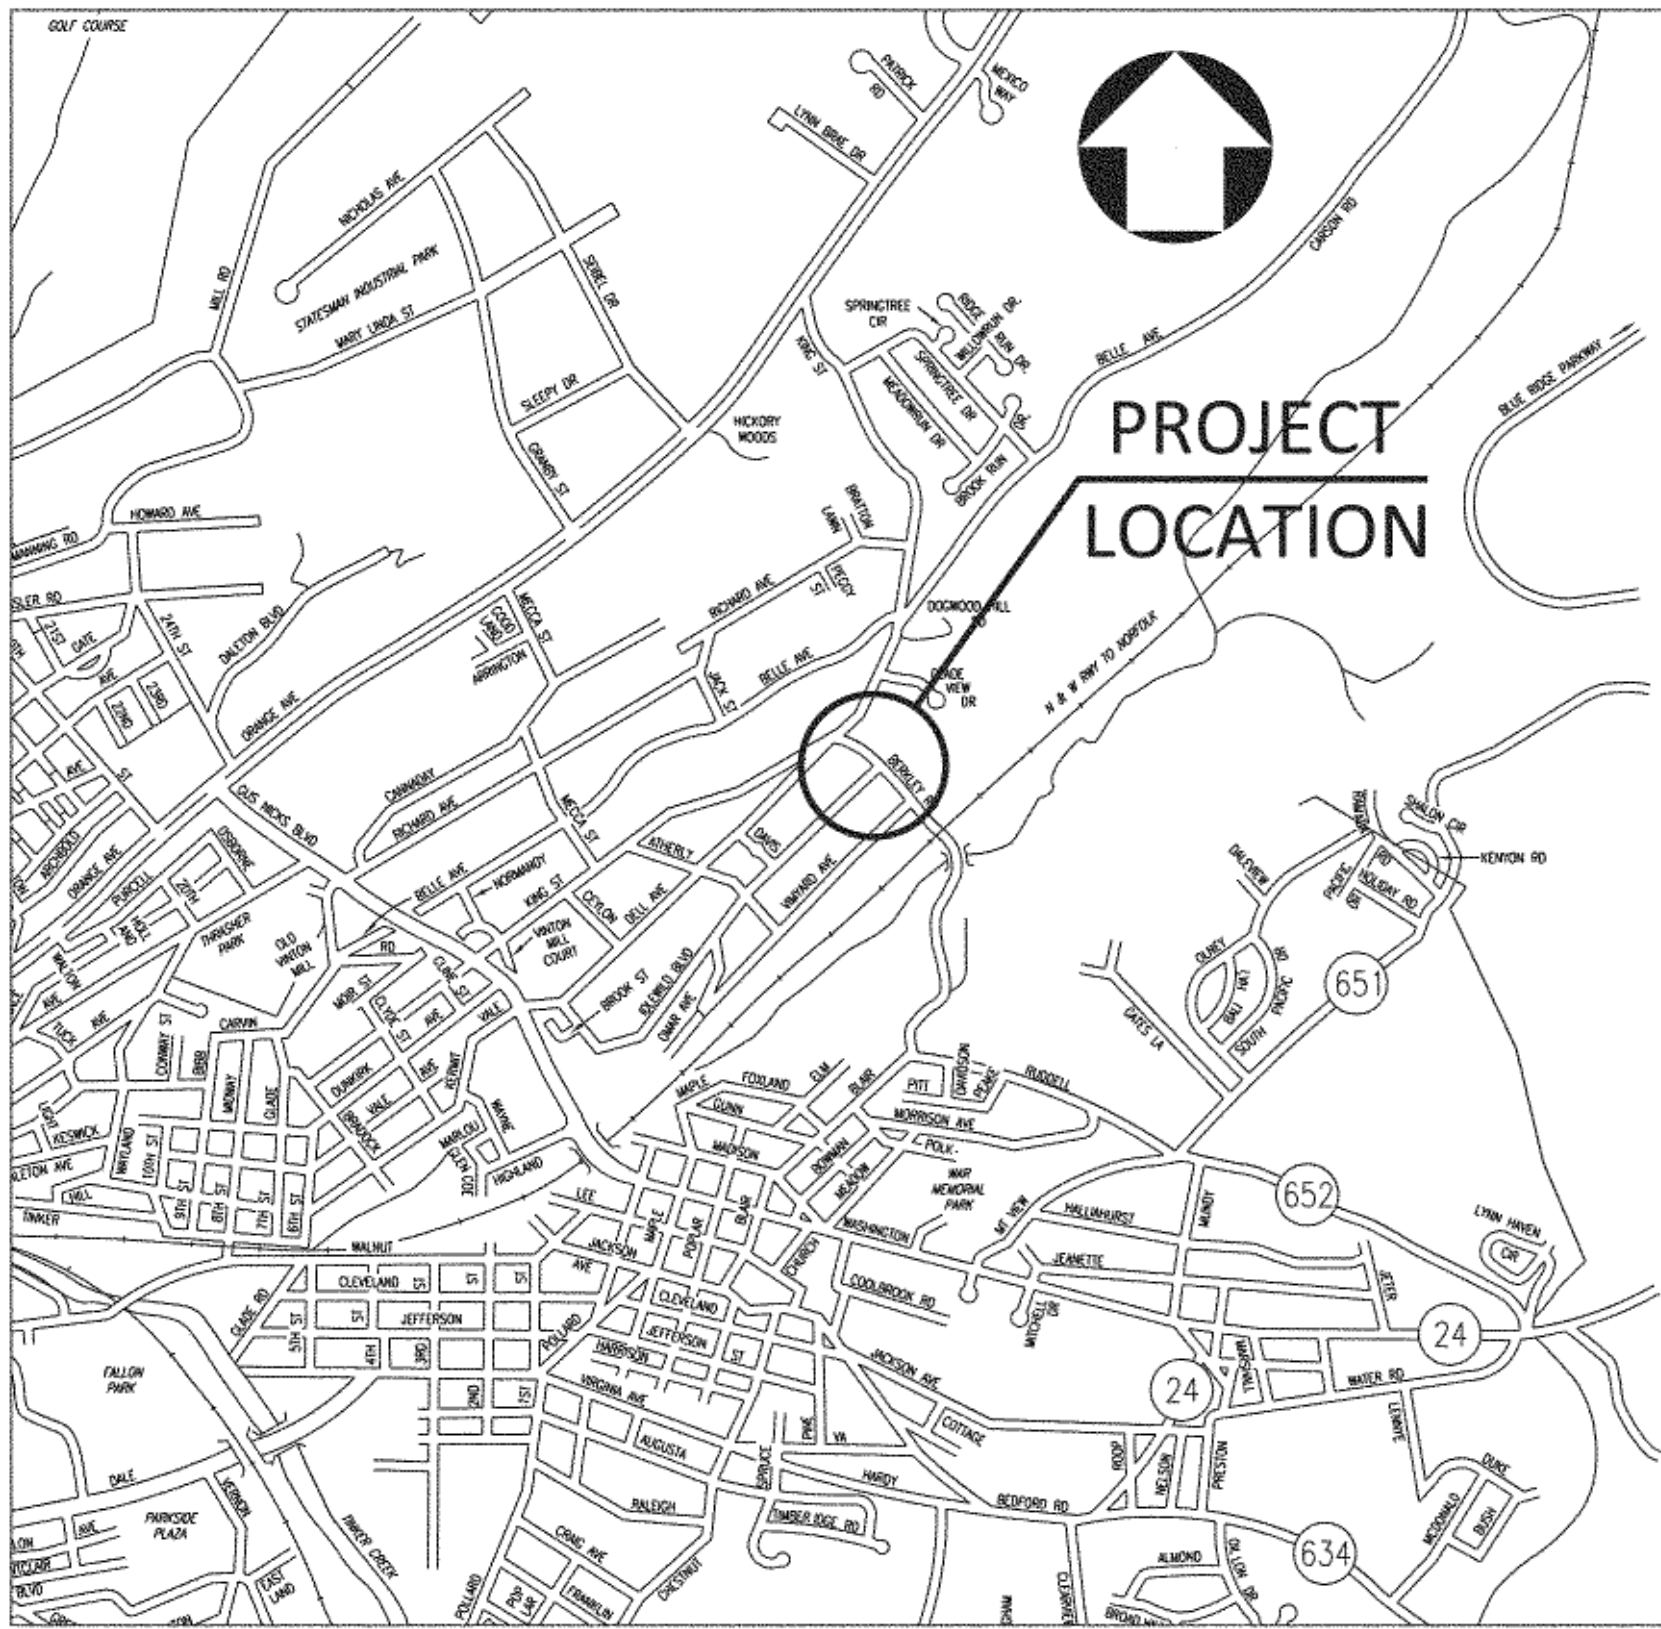

OFFICE OF THE CITY ENGINEER
215 CHURCH AVENUE, SW
ROOM 350
ROANOKE, VIRGINIA 24011-1587
PHONE: (540) 853-2731
FAX: (540) 853-1364
ENGINEER@ROANOKEVA.GOV

INDEX OF SHEETS

- | | |
|-----------|---|
| G-1 | - COVER SHEET |
| G-1A | - GENERAL NOTES |
| C-1 | - SURVEY REFERENCE POINTS, LEGEND, & UTILITY OWNERS |
| C-2 | - TYPICAL SECTION |
| C-2A | - ROW DATA SHEET |
| C-3 | - PLAN: PROPOSED RE-ALIGNMENT |
| C-3A | - PROFILE: PROPOSED RE-ALIGNMENT |
| C-4 | - M.O.T. NOTES |
| C-4A | - PLAN: PROPOSED DETOUR PHASE 1 |
| C-4B | - PLAN: PROPOSED DETOUR PHASE 2 |
| C-4C | - PROFILE: PROPOSED DETOUR RE-ALIGNMENT |
| C-5 | - PAVEMENT MARKING |
| C-6 | - UTILITY RELOCATION PLAN |
| C-6A | - UTILITY RELOCATION PROFILE |
| C-6B | - UTILITY DETAILS |
| C-6C | - UTILITY DETAILS |
| C-7 | - EXISTING CONDITIONS |
| B-(1-20) | - BRIDGE PLANS |
| ES-(1-4) | - E&SC NARRATIVE & MS-19 COMPLIANCE |
| ES-5 | - E&SC PLAN PHASE 1 |
| ES-6 | - E&SC PLAN PHASE 2 |
| ES-(7-10) | - E&SC DETAILS |
| XS-(1-8) | - CROSS SECTIONS: BERKLEY ROAD |

CONSULTING ENGINEERS



Mattern & Craig, Inc.
ENGINEERS SURVEYORS

701 FIRST STREET, S.W.
ROANOKE, VIRGINIA 24016
(540) 345-9342
(540) 345-7691 FAX

COMMISSION NUMBER: 34301



PROJECT NAME

BERKLEY ROAD (OVER GLADE CREEK TRIBUTARY A)
BRIDGE REPLACEMENT

CITY PLAN NUMBER: 6852

AS-BUILT 02/26/2019
SEE SHEET C-6

REVISION BY	DESCRIPTION:	DATE
REVISION BY	DESCRIPTION:	DATE
REVISION BY	DESCRIPTION:	DATE
REVISION BY	DESCRIPTION:	DATE

APPROVED FOR CONSTRUCTION

CITY ENGINEER

DATE

DIRECTOR OF PUBLIC WORKS

DATE

ASSISTANT CITY MANAGER FOR OPERATIONS

DATE

City of Roanoke Planning, Building, & Development	
COMPREHENSIVE DEVELOPMENT PLAN	
APPROVED	
Any changes to this approved plan must be coordinated with the Agent to the Planning Commission and revisions approved prior to construction.	
Agent, Planning Commission	Date
Development Engineer	Date
Zoning Administrator	Date
Planning, Building, & Development reviewed these plans for compliance with City Code and related regulations only and did not review structural plans, details, or schedules.	

TAX PARCEL NUMBER: N/A

SHEET NUMBER: G-1 OF