
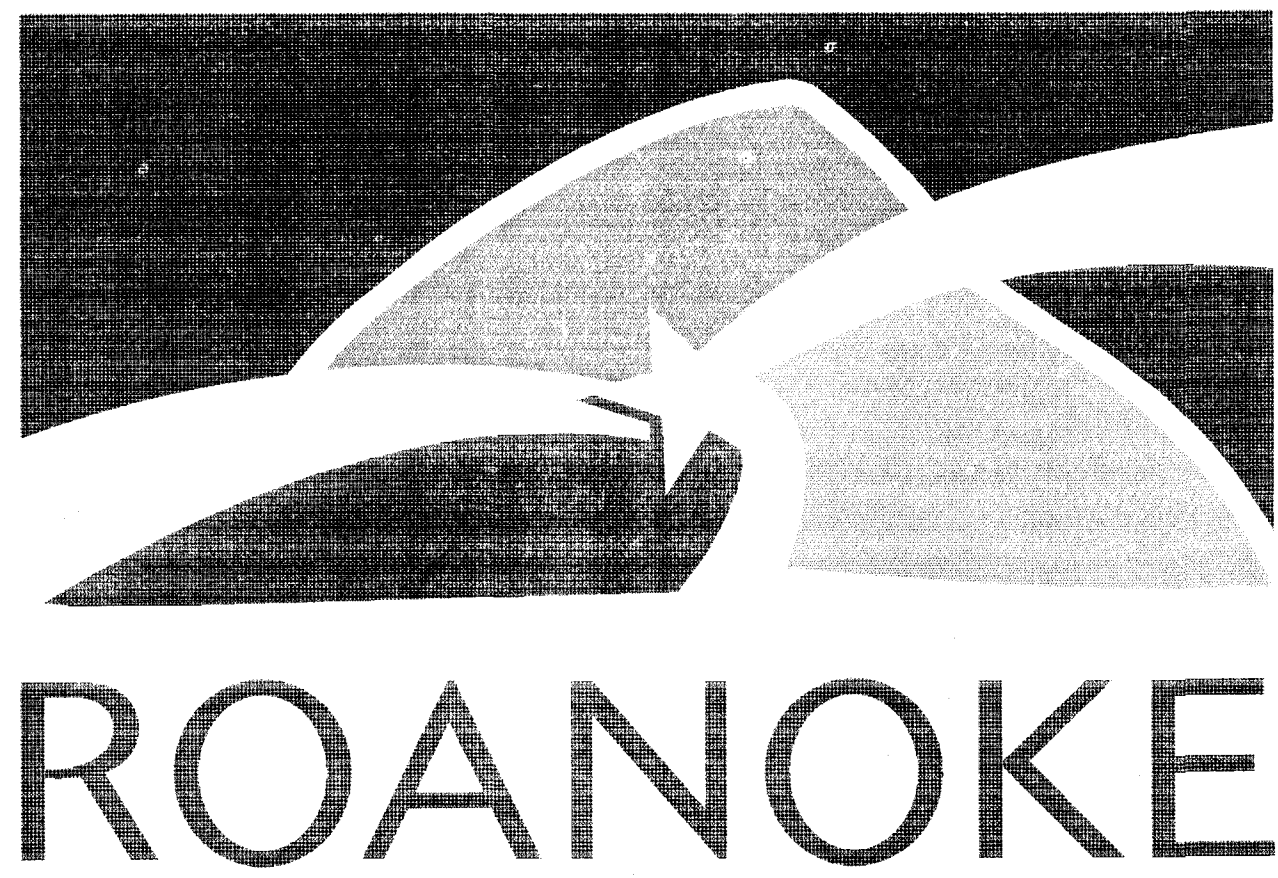


PROJECT LOCATION MAP

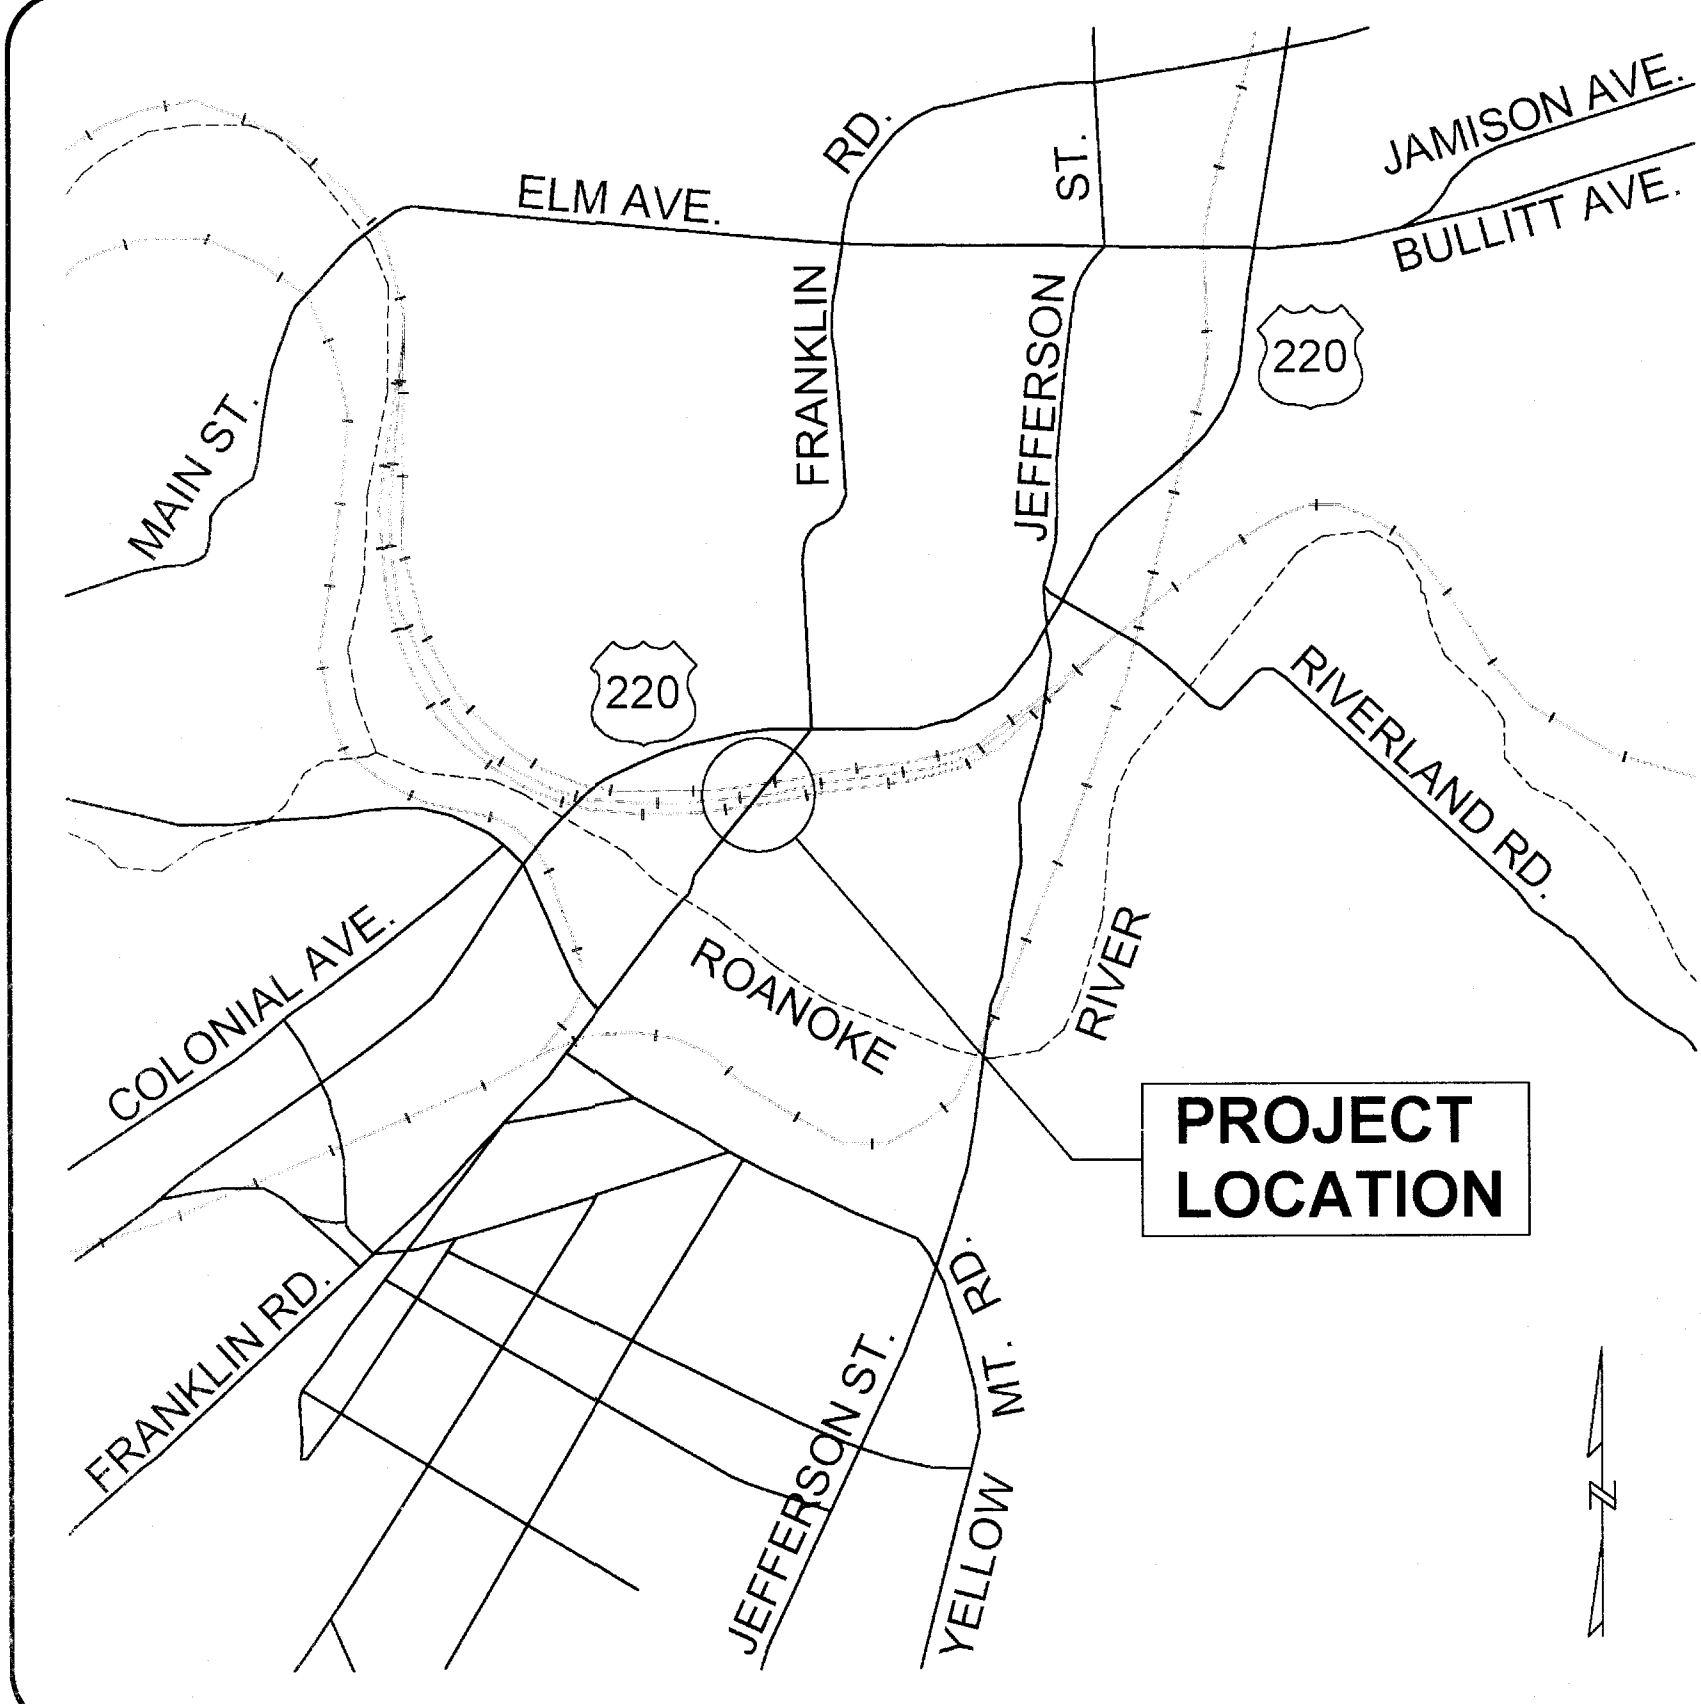

OFFICE OF THE CITY ENGINEER

215 CHURCH AVENUE, SW

ROOM 350

ROANOKE, VIRGINIA 24011-1587

PHONE: (540) 853-2731 FAX: (540) 853-1364

ENGINEER@ROANOKEVA.GOV

CONSTRUCTION PROCEDURE REQUIREMENTS

1. RIGHT-OF-WAY EXCAVATION PERMIT - PRIOR TO COMMENCEMENT OF ANY DIGGING, ALTERATION OR CONSTRUCTION WITHIN THE PUBLIC RIGHT-OF-WAY (STREETS, ALLEYS, PUBLIC EASEMENTS), A RIGHT-OF-WAY EXCAVATION PERMIT SHALL BE APPLIED FOR AND OBTAINED BY THE CONTRACTOR FROM THE CITY OF ROANOKE
2. LAND DISTURBANCE PERMIT - AN APPROVED EROSION AND SEDIMENT CONTROL PLAN FOR ANY BORROW/FILL SITES ASSOCIATED WITH THE PROJECT MUST BE SUBMITTED PRIOR TO THE ISSUANCE OF A LAND DISTURBANCE PERMIT.
3. PLANS AND PERMITS - A COPY OF THE PLANS AS APPROVED BY THE CITY (SIGNED BY THE PROPER CITY OFFICIALS) AND ALL PERMITS ISSUED BY THE CITY SHALL BE AVAILABLE AT THE CONSTRUCTION SITE AT ALL TIMES OF ONGOING CONSTRUCTION.
4. LOCATION OF UTILITIES - THE CONTRACTOR SHALL VERIFY THE LOCATION OF ALL EXISTING UTILITIES PRIOR TO THE COMMENCEMENT OF ANY CONSTRUCTION.
5. CONSTRUCTION ENTRANCE - THE CONTRACTOR SHALL INSTALL AN ADEQUATE CONSTRUCTION ENTRANCE FOR ALL CONSTRUCTION RELATED EGRESS FROM THE SITE. SIZE AND COMPOSITION OF CONSTRUCTION ENTRANCE SHALL BE AS SHOWN ON THE PLANS.
6. STREETS TO REMAIN CLEAN - IT SHALL BE THE RESPONSIBILITY OF THE CONTRACTOR TO INSURE THAT THE PUBLIC STREET ADJACENT TO THE CONSTRUCTION ENTRANCE REMAINS FREE OF MUD, DIRT, DUST, AND/OR ANY TYPE OF CONSTRUCTION MATERIALS OR LITTER AT ALL TIMES.
7. BARRICADES/ DITCHES - THE CONTRACTOR SHALL MAINTAIN THE INTEGRITY OF ALL EXCAVATED DITCHES AND SHALL FURNISH AND ENSURE THAT ALL BARRICADES PROPER AND NECESSARY FOR THE SAFETY OF THE PUBLIC ARE IN PLACE.
8. SEWER AND PAVEMENT REPLACEMENT - CONSTRUCTION OF SANITARY SEWERS AND THE REPLACEMENT OF PAVEMENT SHALL BE IN ACCORDANCE WITH APPROVED STANDARDS AND SPECIFICATIONS OF THE CITY OF ROANOKE AND THE WESTERN VIRGINIA WATER AUTHORITY.
9. APPROVED PLANS/ CONSTRUCTION CHANGES - ANY CHANGE OR VARIATION FROM THE CONSTRUCTION DESIGN AS SHOWN ON THE OFFICIALLY APPROVED PLANS SHALL BE APPROVED BY THE EROSION AND SEDIMENT CONTROL AGENT PRIOR TO SAID CHANGES OR VARIATION IN CONSTRUCTION BEING MADE.
10. FINAL ACCEPTANCE/ CITY - THE OWNER OR DEVELOPER SHALL FURNISH THE CITY OF ROANOKE'S PLANNING BUILDING AND DEVELOPMENT DEPARTMENT WITH A FIELD SURVEY FINAL CORRECT SET OF AS-BUILT PLANS OF THE NEWLY CONSTRUCTED STORM DRAIN AND/OR STORM WATER MANAGEMENT FACILITIES PRIOR TO FINAL ACCEPTANCE AND ISSUANCE OF A CERTIFICATE OF OCCUPANCY BY THE CITY. AS-BUILT PLANS SHALL BE PROVIDED IN THE STATE PLANE VIRGINIA SOUTH COORDINATE SYSTEM, NAD 1983, FIPS 4502 FEET US SURVEY FEET, DATUM NAD 83, IN THE FORM OF 1 PAPER COPY AND 1 DIGITAL AUTOCAD FILE.

CONSULTING ENGINEERS

AECOM
10 SOUTH JEFFERSON STREET
SUITE 1600
ROANOKE, VIRGINIA 24011
PHONE: (540) 857-3100

AECOM PROJECT NO.: 60290893

RECEIVED

SEP 09 2015

PROJECT NAME

FRANKLIN ROAD BRIDGE REPLACMENT
OVER N.S. RAILWAY
STRUCTURE 1817
CITY OF ROANOKE, VIRGINIA

CITY PROJECT NUMBER: 6787

VDOT PROJECT NUMBER: 0220-128-R34 / UPC 104248

NCS FILE: 117-19156 (BR0002281) R.R.M.P. V-243.55 (VIRGINIA)

REVISION BY

DESCRIPTION:

DATE

REVISION BY

DESCRIPTION:

DATE

REVISION BY

DESCRIPTION:

DATE

REVISION BY

DESCRIPTION:

DATE

PRELIMINARY PLANS
NOT FOR
CONSTRUCTION
2015 SEPT. 8

As-Built on sheets 1-2 - Western Virginia Water Authority's
01/31/2018 Separate Plans - See attached plans.

APPROVED FOR CONSTRUCTION

ROANOKE CITY ENGINEER

DATE

DIRECTOR OF PUBLIC WORKS

DATE

ADVERTISED DATE:

SET NUMBER:

SHEET NUMBER: G-001