



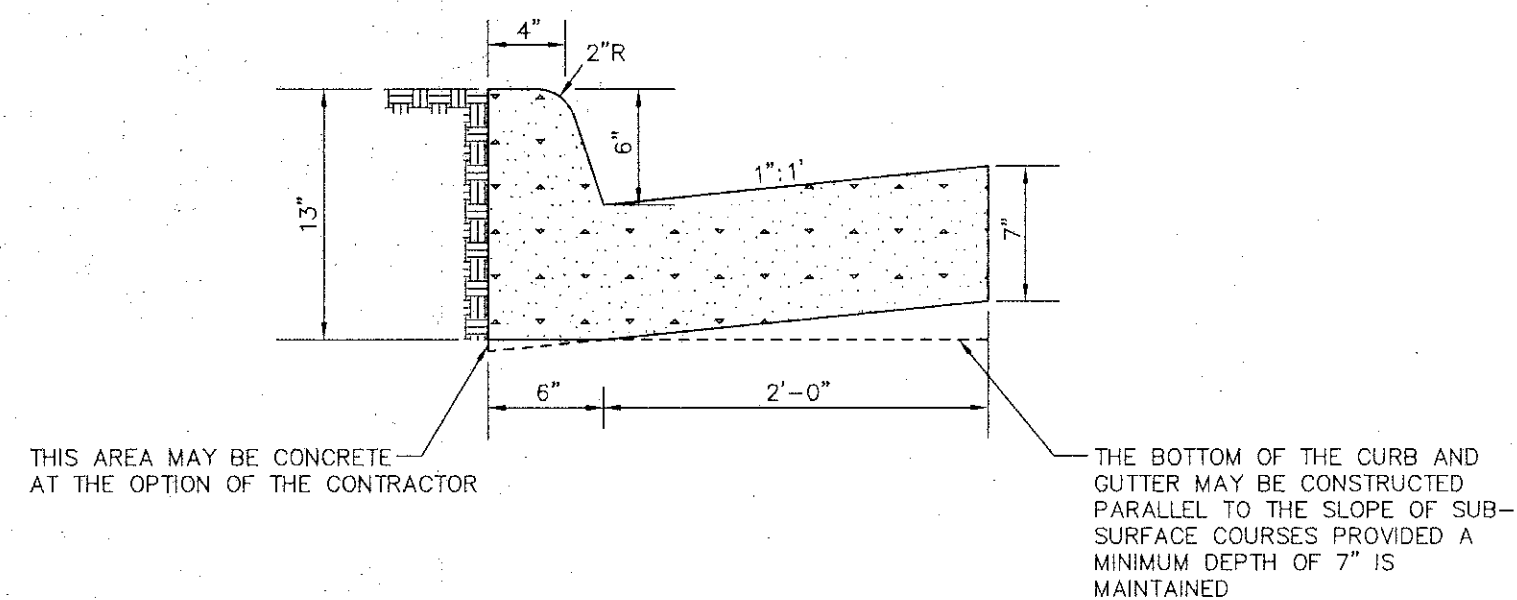


COMBINATION 6" CURB & GUTTER
CG-6
N.T.S.

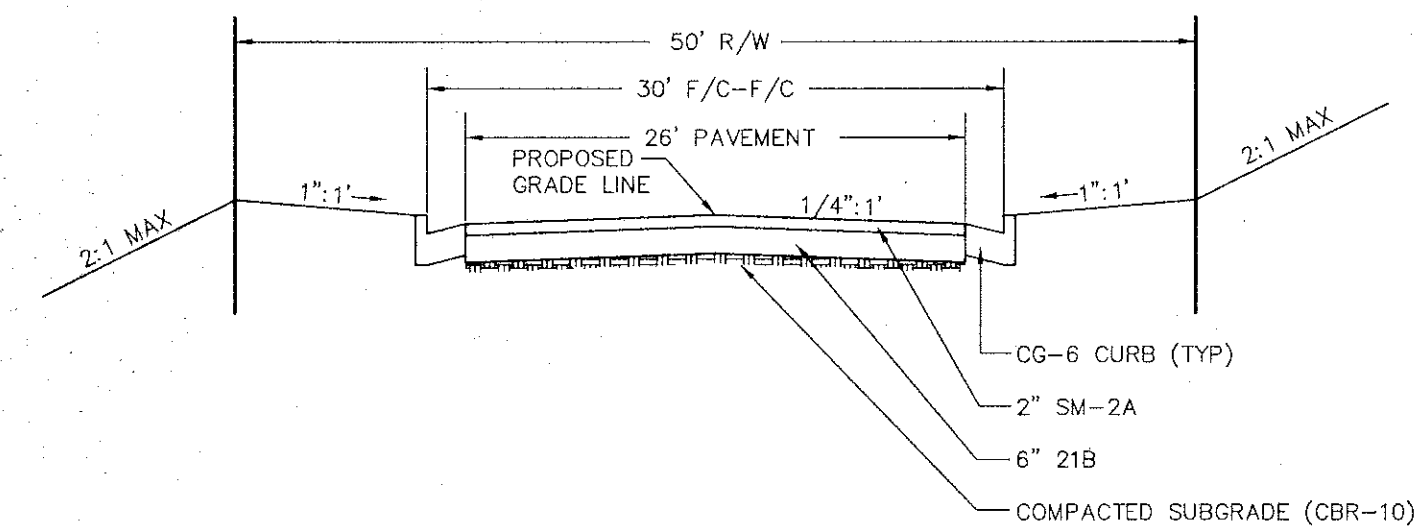


CATEGORY I PAVEMENT
N.T.S.

VALLEY STREAM DRIVE - STA 23+15 TO END
CEDARMEADE DRIVE - STA 21+00 TO END
BONSALL LANE
GLEN ROCK LANE
DELMAR LANE
SMOKE RISE COURT

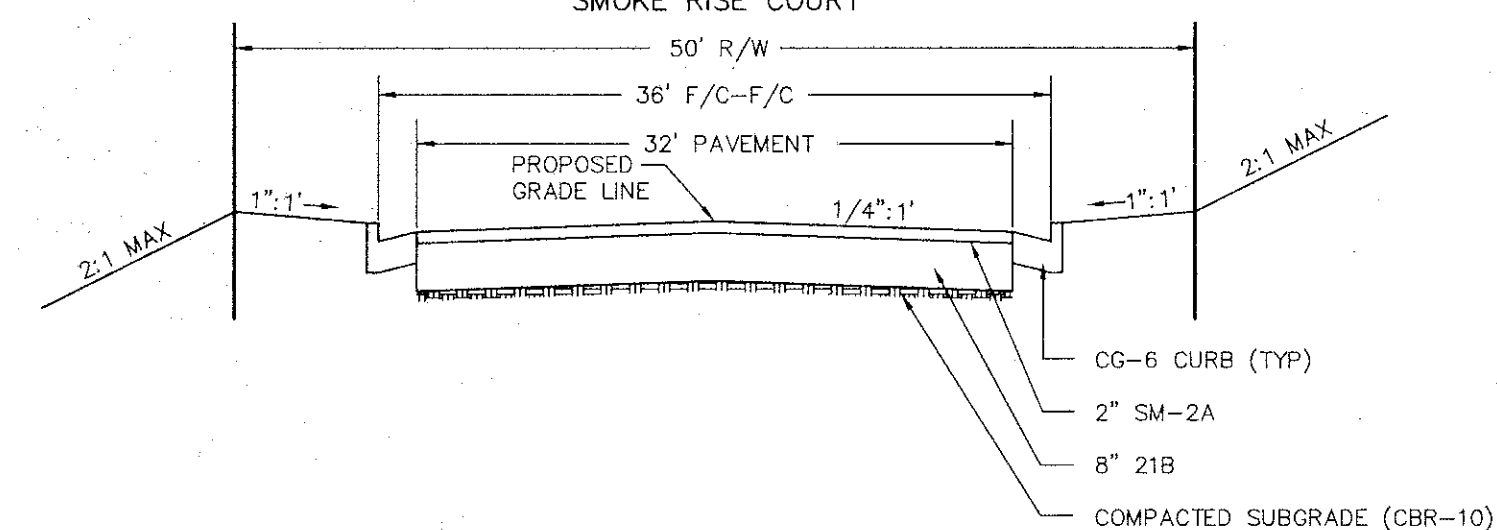


CATEGORY II PAVEMENT
N.T.S.

CEDARMEADE DRIVE - STA 10+00 TO 21+00

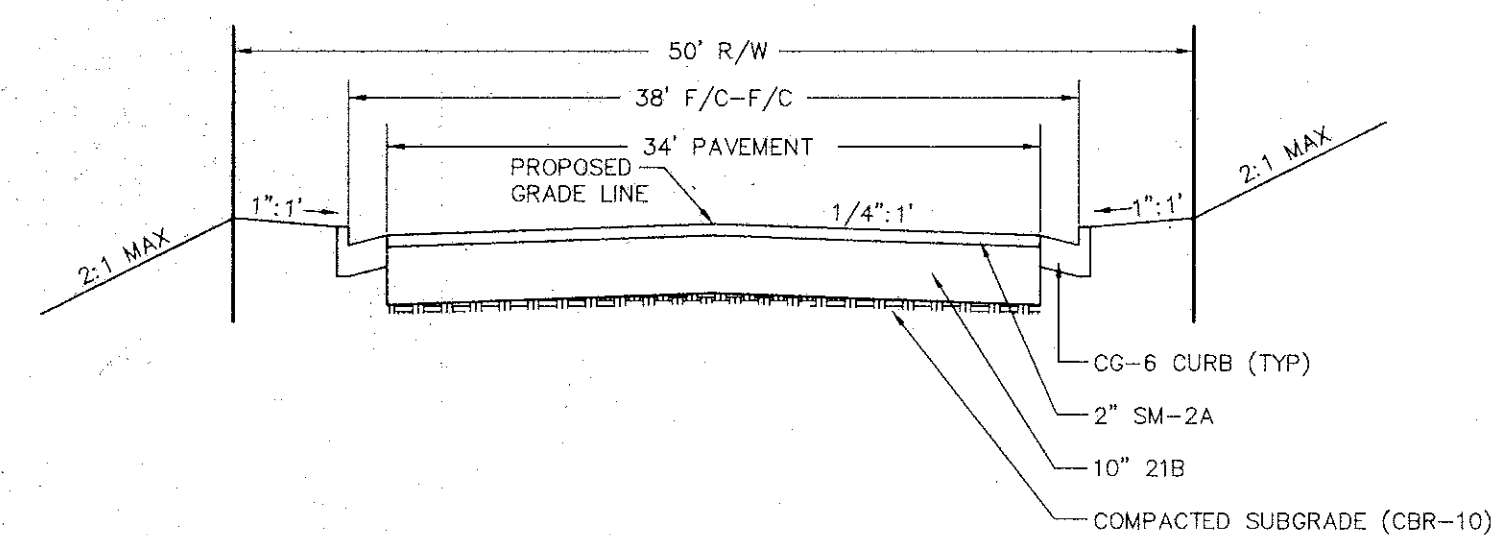

CATEGORY III PAVEMENT
N.T.S.


VALLEY STREAM DRIVE - STA 14+58 TO 23+15

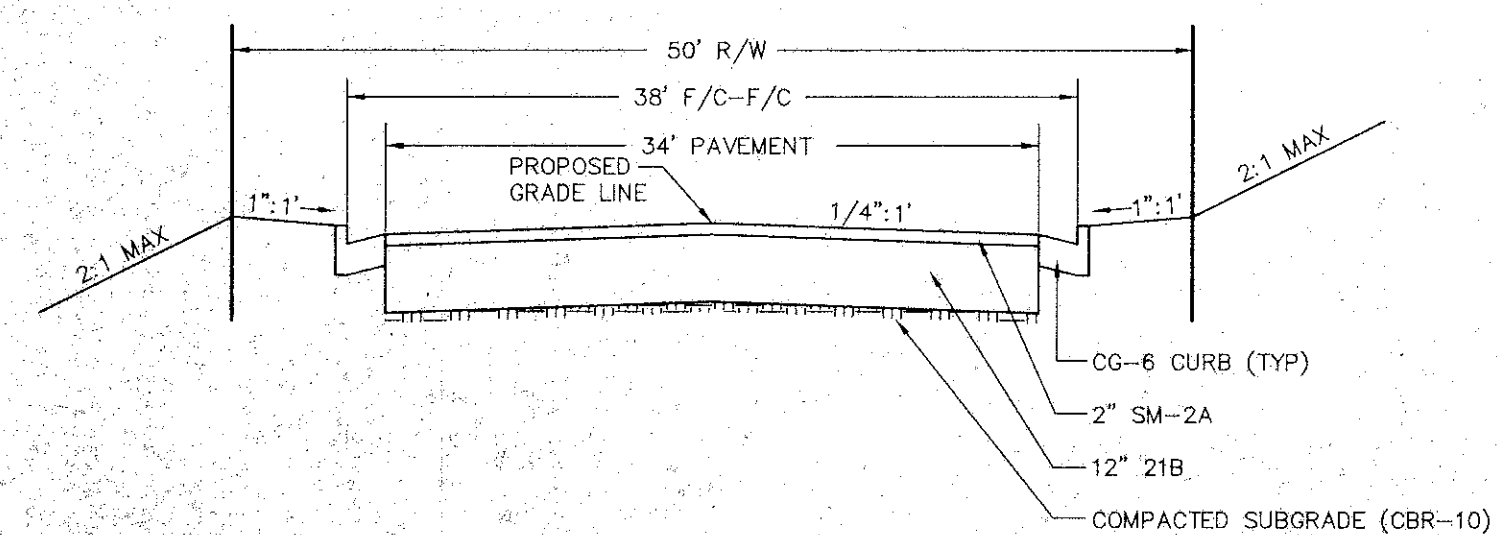


CATEGORY IV PAVEMENT
N.T.S.

VALLEY STREAM DRIVE - STA 10+00 TO 14+58


* THE DEPTH OF CURB MAY BE REDUCED AS MUCH AS 3" (15" DEPTH) OR INCREASED AS MUCH AS 3" (21" DEPTH) IN ORDER THAT THE BOTTOM OF CURB COINCIDE WITH THE TOP OF A COURSE OF THE PAVEMENT SUBSTRUCTURE. OTHERWISE THE DEPTH IS TO BE 18" AS SHOWN.

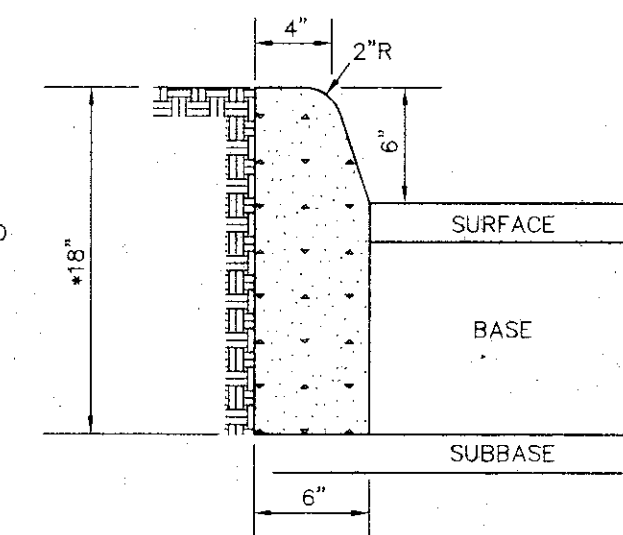


STANDARD 6" CURB
CG-2
N.T.S.

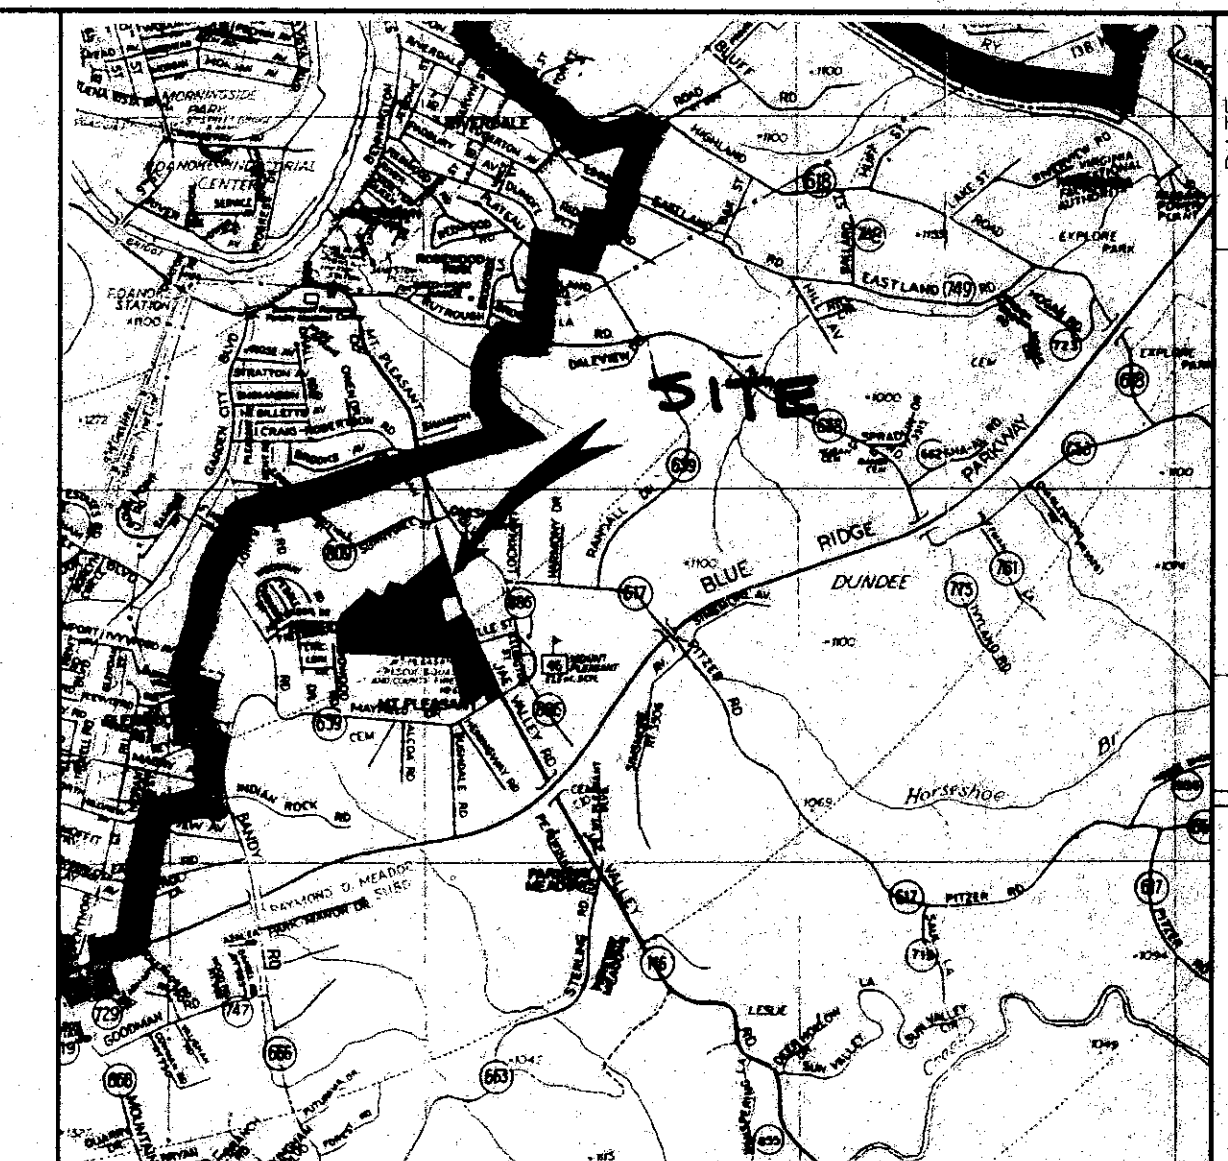

VICINITY MAP

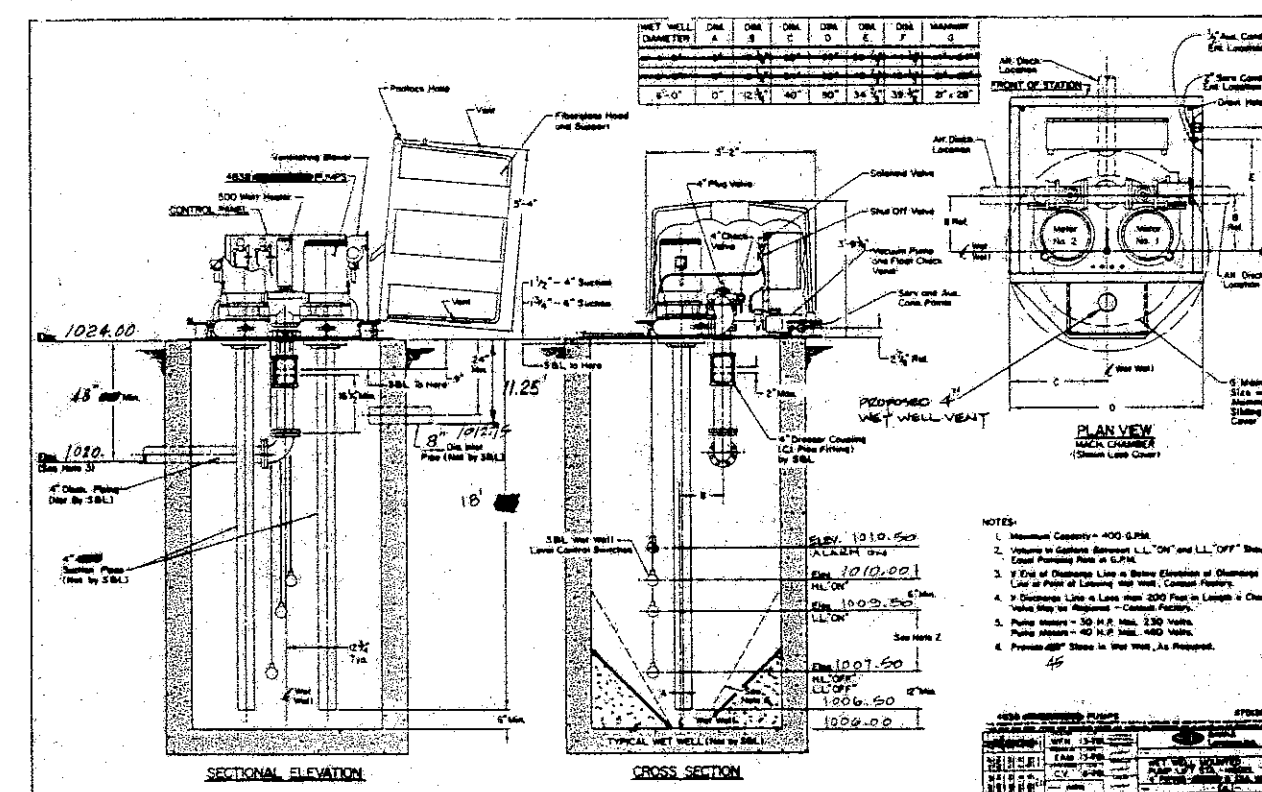


PROPOSED WET WELL
"BROOKFIELD SUBDIVISION ONLY"

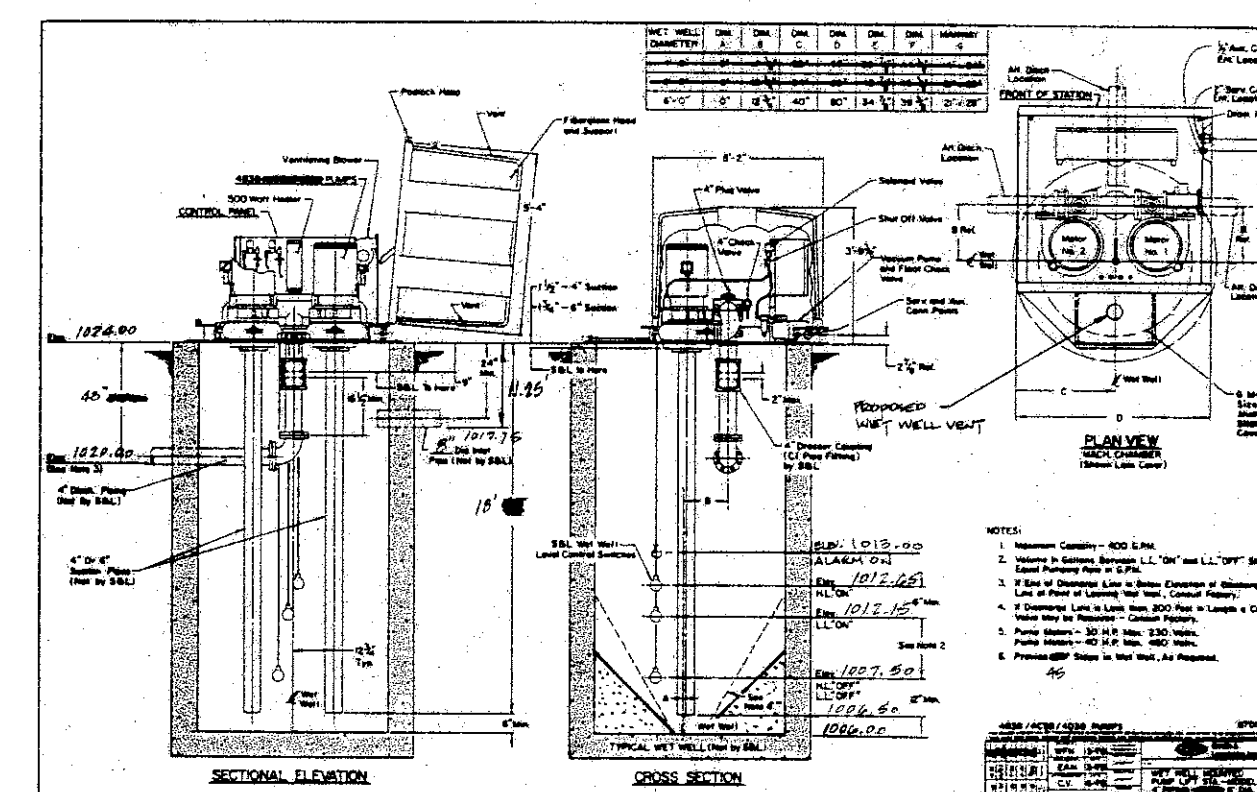


PROPOSED WET WELL
"ULTIMATE DEVELOPMENT"

SMITH & LOVELESS, INC.
WET WELL MOUNTED
PUMP LIFT STATION - MODEL "S"
N.T.S.

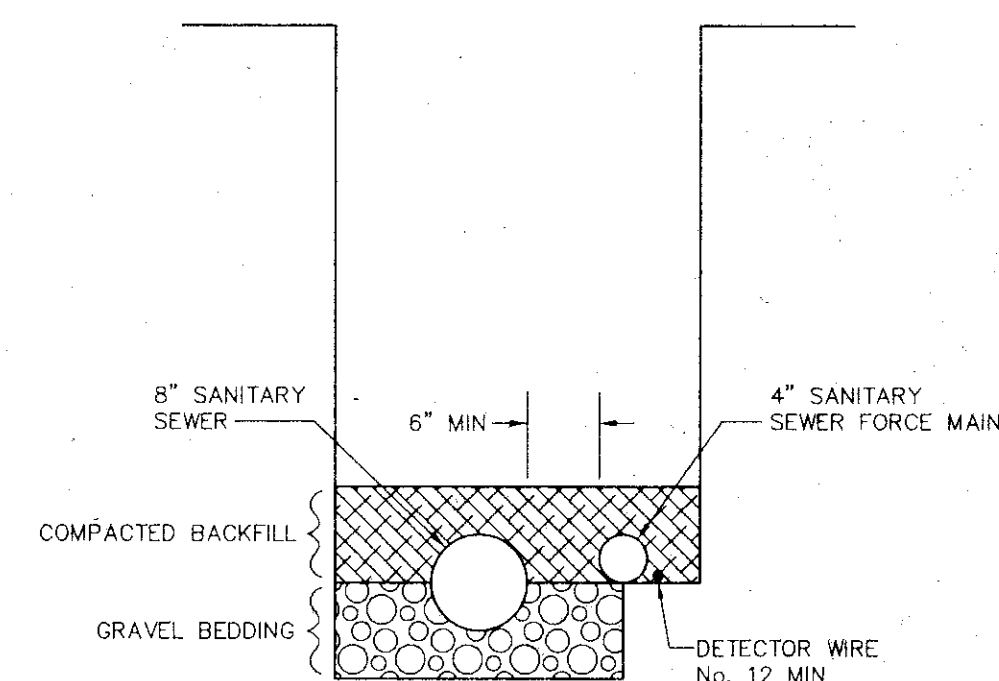


FORCE MAIN
INSTALLATION DETAIL
N.T.S.

DETAIL B - B

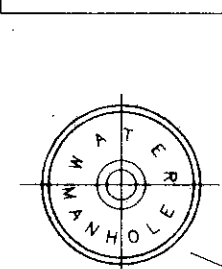

COUNTY OF ROANOKE
WATER FACILITIES
MANHOLE RING & COVER
(DEWEY BROS. MH - RCR - 2001)
N.T.S.

* NOTE *
ALL DIMENSIONS ARE INCHES

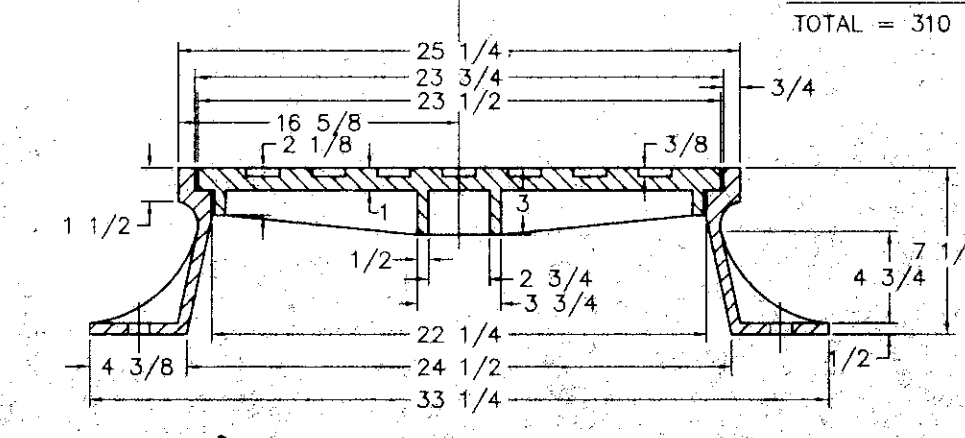

WATER MANHOLE RING AND COVER
N.T.S.

No.	DESCRIPTION	SEC I & II
1	COVER SHEET	X
2	INDEX AND MISCELLANEOUS DETAILS SHEET	X
3	MASTER ENGINEERING PLAN	X
4	MASTER ENGINEERING PLAN	X
5	MASTER ENGINEERING PLAN	X
6	GRADING AND ESC PLAN	
7	GRADING AND ESC PLAN	
8	GRADING AND ESC PLAN	
9	SCOPE OF CONSTRUCTION PLAN	
10	DRAINAGE AREA PLAN	
11	VALLEY STREAM DRIVE ROADWAY PROFILE	X
12	VALLEY STREAM DRIVE ROADWAY PROFILE	X
13	CEDARMEADE DRIVE ROADWAY PROFILE	X
14	CEDARMEADE DRIVE ROADWAY PROFILE	X
15	BONSALL LANE ROADWAY PROFILE	X
16	GLEN ROCK LANE AND DELMAR LANE ROADWAY PROFILES	X
17	SMOKE RISE COURT ROADWAY, WATER A, STORM A PROFILES	X
18	STORM B, STORM C, AND STORM D PROFILES	X
19	SEWER A AND SEWER B PROFILES	X
20	STORM E, STORM F AND STORM G PROFILES	X
21	ROANOKE COUNTY STANDARD SANITARY SEWER DETAILS	
22	ROANOKE COUNTY STANDARD WATER DETAILS	
23	ROANOKE COUNTY STANDARD ESC DETAILS	

"AS-BUILT"
SEC I & II
04/20/98

-LANG-
engineering co.
Consulting Engineers, Land Planners
P.O. BOX 18062 ROANOKE, VA 24014 (703) 772-0077

BROOKFIELD
INDEX AND MISC DETAILS SHEET
VINTON MAGISTERIAL DISTRICT
ROANOKE COUNTY, VIRGINIA

SHEET NO.
23
OF

JOB NO. 980409

RC-6425