


AS-BUILT SEWER LATERAL TABLE


MANHOLE RUN	LATERAL LOT NO.	LATERAL SECTION	C.O. STATION	OFFSET DISTANCE	LATERAL LENGTH	C.O. DEPTH
SMH 10 UPSTATION TO SMH 9	LOT 57	SEC 2	OUT SMH	21.92 LT	22.61	9.75
	LOT 90	SEC 2	OUT SMH	25.63 RT	25.81	9.95
SMH 9 UPSTATION TO SMH 8	LOT 56	SEC 2	OUT SMH	01.79.26	32.62 LT	32.62
	LOT 89	SEC 2	OUT SMH	22.97 RT	23.09	8.10
	LOT 58	SEC 2	OUT SMH	20.16 LT	21.01	8.40
SMH 8 UPSTATION TO SMH 7	LOT 60	SEC 2	OUT SMH	01.68.71	34.03 LT	34.03
	LOT 88	SEC 2	OUT SMH	21.87 RT	24.53	9.35
SMH 7 UPSTATION TO SMH 6	LOT 61	SEC 2	OUT SMH	01.68.65	10.64 RT	10.00
	LOT 82	SEC 2	OUT SMH	5.44 RT	9.00	4.90
SMH 6 UPSTATION TO SMH 5A	LOT 63	SEC 2	OUT SMH	51.90 LT	51.96	9.50
	LOT 65	SEC 2	OUT SMH	23.88 RT	52.65	7.50
SMH 5A UPSTATION TO SMH 5	LOT 76	SEC 2	OUT SMH	01.47.66	25.63 RT	25.63
	LOT 74	SEC 2	OUT SMH	11.31.95	30.33 RT	30.33
	LOT 75	SEC 2	OUT SMH	21.19.31	35.95 RT	35.95
	LOT 76	SEC 2	OUT SMH	21.71.39	7.33 LT	7.33
	LOT 73	SEC 2	OUT SMH	21.95.90	40.24 RT	40.24
	LOT 72	SEC 2	OUT SMH	19.49 RT	22.51	9.50
SMH 5 UPSTATION TO SMH 4	LOT 71	SEC 2	OUT SMH	01.55.75	40.81 RT	40.81
	LOT 67	SEC 2	OUT SMH	52.41 LT	52.41	10.50
	LOT 70	SEC 2	OUT SMH	52.98 RT	53.04	9.00
	LOT 68	SEC 2	OUT SMH	25.87 LT	51.48	12.10
	LOT 69	SEC 2	OUT SMH	26.43 RT	52.42	11.90
SMH 4 UPSTATION TO SMH 3	LOT 77	SEC 2	OUT SMH	01.51.97	24.35 LT	24.35
	LOT 87	SEC 2	OUT SMH	01.55.23	18.17 RT	18.17
	LOT 86	SEC 2	OUT SMH	11.73.21	16.46 RT	16.46
	LOT 78	SEC 2	OUT SMH	11.87.41	25.26 LT	25.26
	LOT 79	SEC 2	OUT SMH	22.35 LT	22.76	11.50
	LOT 85	SEC 2	OUT SMH	22.16 RT	22.17	11.20
SMH 3 UPSTATION TO SMH 2	LOT 84	SEC 2	OUT SMH	01.57.19	17.08 RT	17.08
	LOT 80	SEC 2	OUT SMH	01.57.96	26.20 LT	26.20
SMH 2 UPSTATION TO SMH 1	LOT 81	SEC 1	OUT SMH	01.34.01	22.69 LT	22.69
	LOT 22	SEC 1	OUT SMH	0.04 LT	23.41	15.10
	LOT 23	SEC 1	OUT SMH	38.05 RT	43.13	12.20
SMH 1 UPSTATION TO SMH 0	LOT 21	SEC 1	OUT SMH	01.72.32	24.50 RT	24.50
	LOT 83	SEC 1	OUT SMH	22.98 LT	23.07	14.30
	LOT 83	SEC 1	OUT SMH	25.04 LT	82.63	10.40
SMH 0 UPSTATION TO SMH 3	LOT 1	SEC 1	OUT SMH	01.58.77	20.56 LT	20.56
	LOT 2	SEC 1	OUT SMH	11.79.72	20.34 LT	20.34
	LOT 20	SEC 1	OUT SMH	24.15.38	24.21 RT	24.21
	LOT 18	SEC 1	OUT SMH	21.72.81	23.32 LT	23.32
	LOT 19	SEC 1	OUT SMH	31.35.62	24.06 RT	24.06
	LOT 4	SEC 1	OUT SMH	31.63.13	22.43 LT	22.43

"AS-BUILT"
SEC I & II
04/20/98

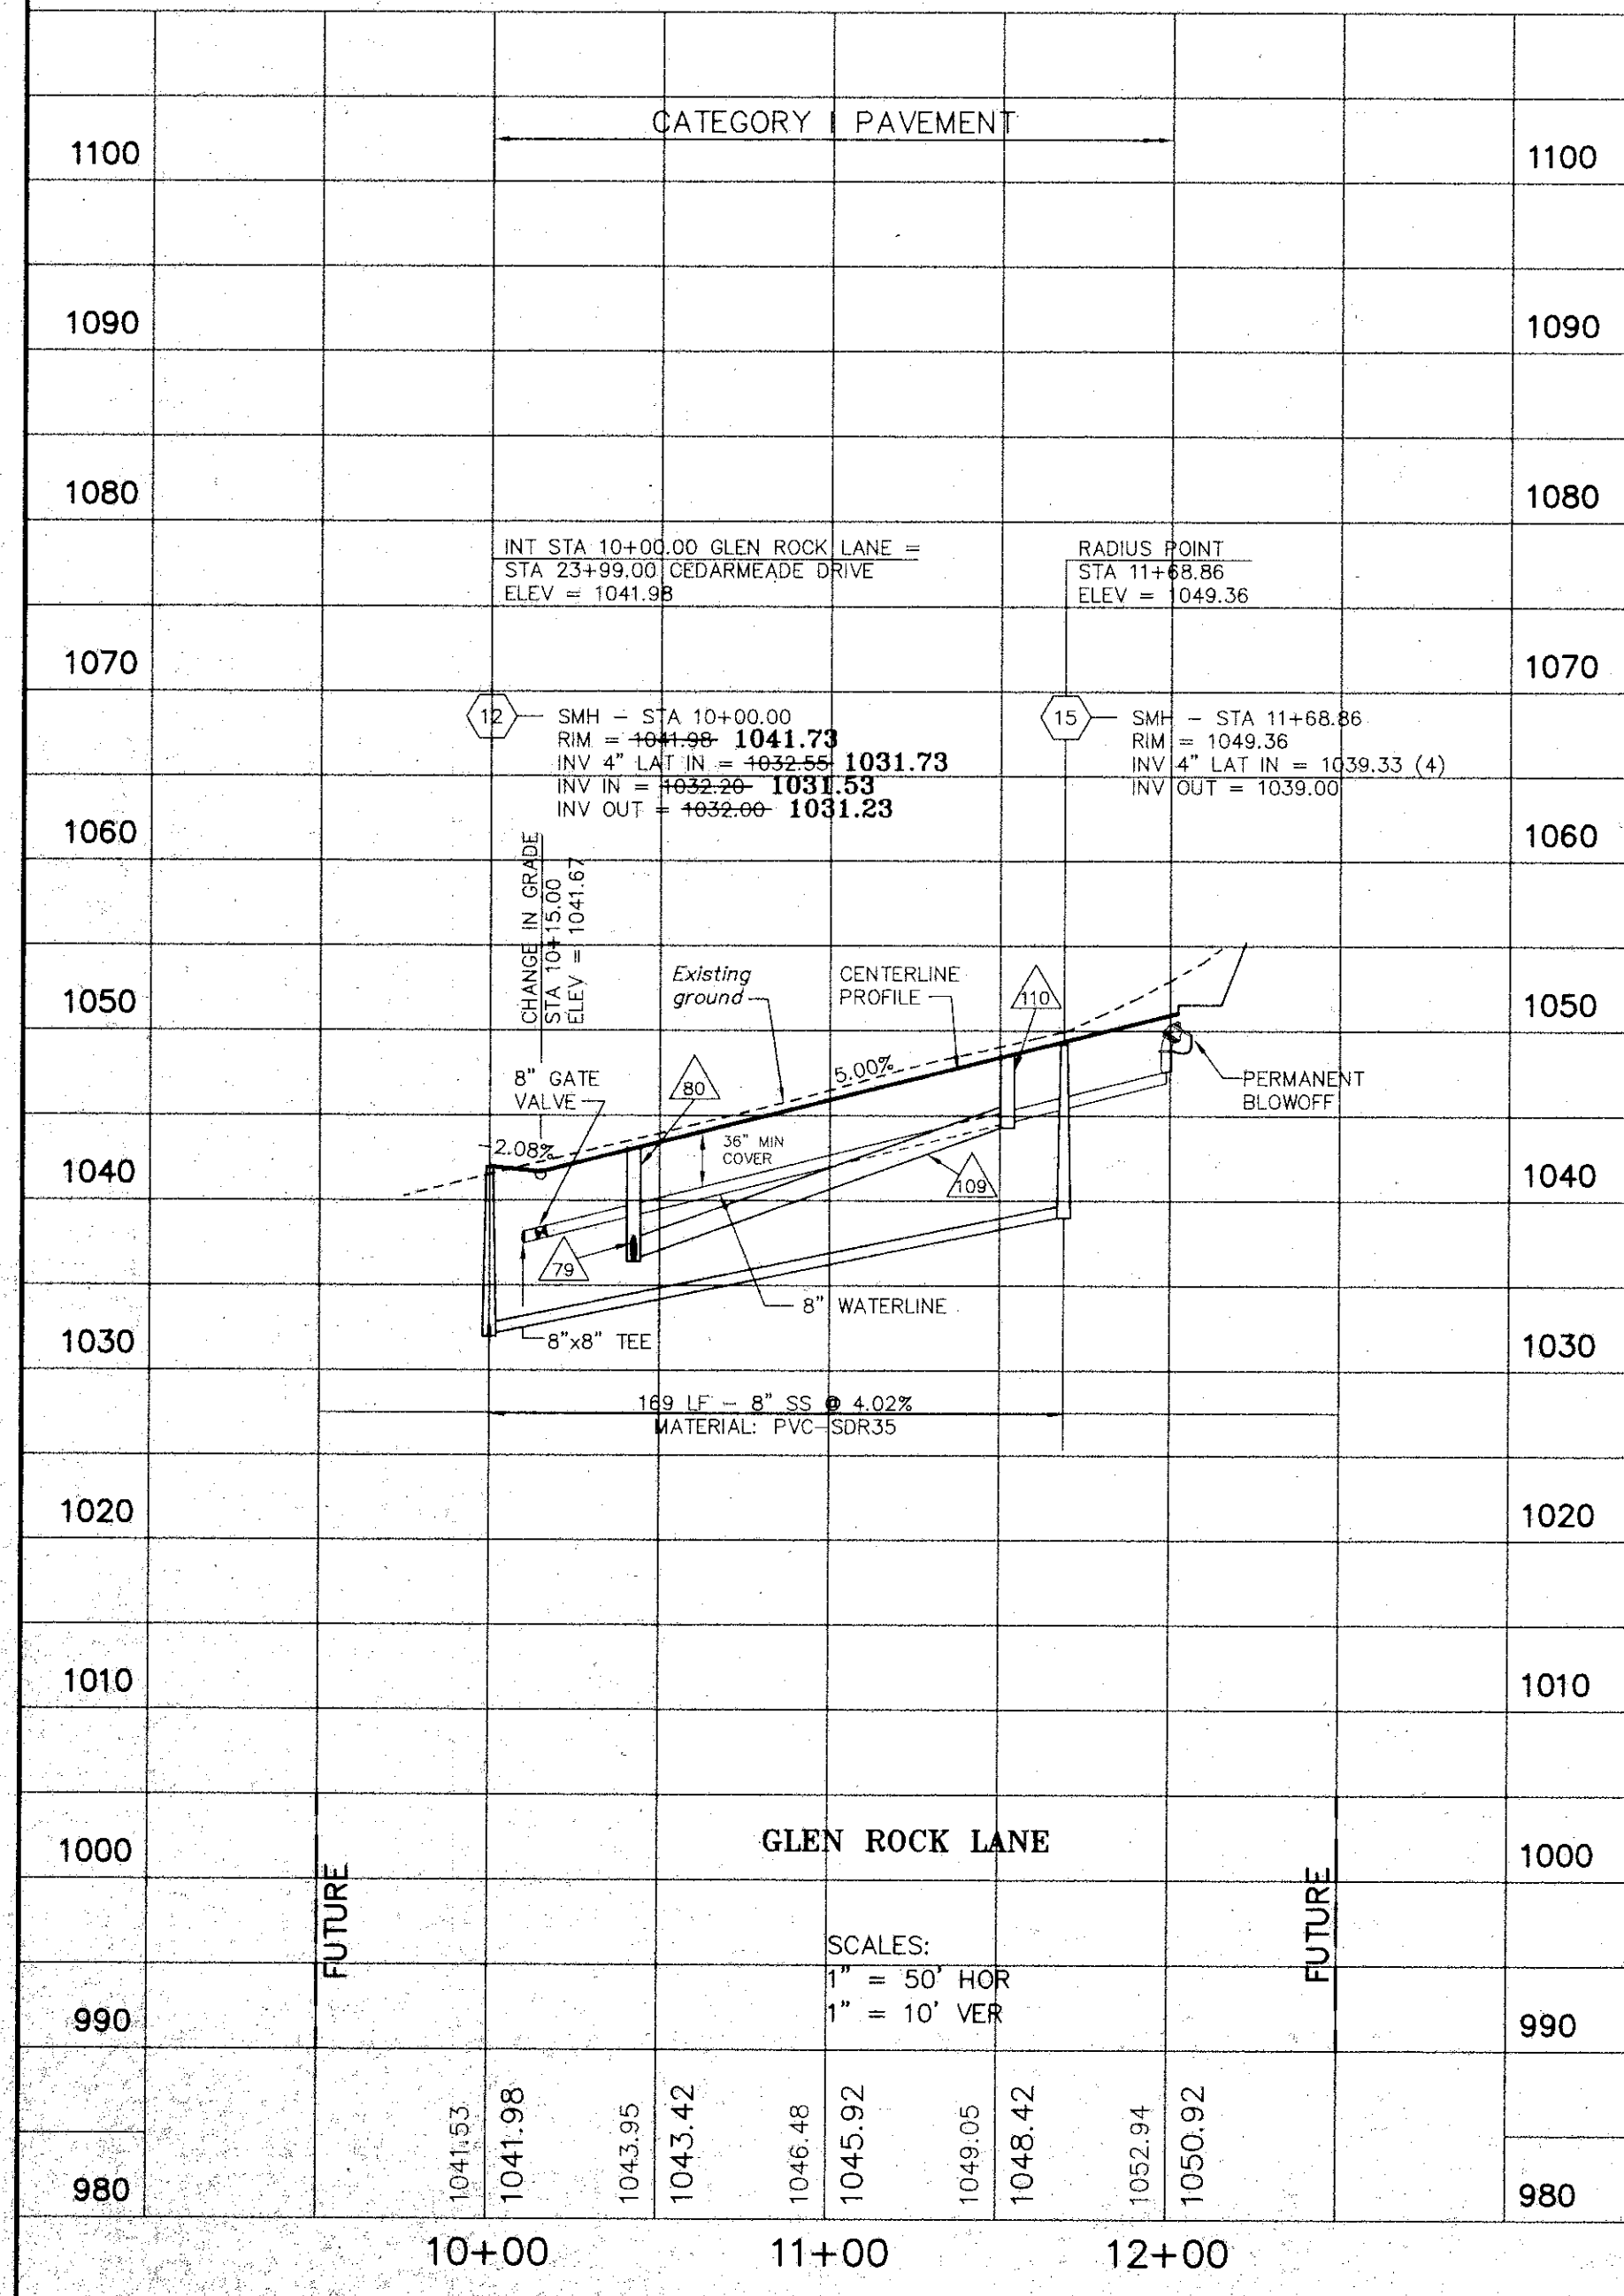

AS-BUILT STORM SEWER TABLE

MANHOLE RUN	LATERAL LOT NO.	LATERAL SECTION	C.O. STATION	OFFSET DISTANCE	LATERAL LENGTH	C.O. DEPTH
SMH 3 UPSTATION TO SMH 2	LOT 18	SEC 1	OUT SMH	01.36.74	26.69 RT	26.69
	LOT 9	SEC 1	OUT SMH	01.43.91	19.45 LT	19.45
	LOT 6	SEC 1	OUT SMH	11.24.11	16.59 LT	16.59
	LOT 17	SEC 1	OUT SMH	11.50.27	30.72 RT	30.72
	LOT 7	SEC 1	OUT SMH	21.04.88	13.26 LT	13.26
	LOT 16	SEC 1	OUT SMH	21.34.00	35.69 RT	35.69
	LOT 15	SEC 1	OUT SMH	21.08 RT	23.84	10.10
SMH 2 UPSTATION TO SMH 1	LOT 8	SEC 1	OUT SMH	01.52.61	10.46 RT	10.46
	LOT 14	SEC 1	OUT SMH	01.71.67	39.12 RT	39.12
	LOT 9	SEC 1	OUT SMH	11.42.35	11.83 LT	11.83
	LOT 13	SEC 1	OUT SMH	11.62.22	31.64 RT	31.64
	LOT 10	SEC 1	OUT SMH	46.88 LT	52.59	11.30
	LOT 12	SEC 1	OUT SMH	42.16 RT	55.25	10.50
	LOT 11	SEC 1	OUT SMH	4.50 LT	53.16	11.00
SMH 11 UPSTATION TO SMH 12	LOT 48	FUTURE	OUT SMH	21.25.13	19.41 RT	19.41
	LOT 33	FUTURE	OUT SMH	21.59.89	27.47 LT	27.47
	LOT 47	FUTURE	OUT SMH	25.31 RT	25.40	7.75
SMH 12 UPSTATION TO SMH 13	LOT 38	FUTURE	OUT SMH	01.74.04	36.91 LT	36.91
	LOT 46	FUTURE	OUT SMH	24.17 RT	24.28	8.15
	LOT 39	FUTURE	OUT SMH	23.14 LT	25.56	8.50
SMH 13 UPSTATION TO SMH 14	LOT 40	FUTURE	OUT SMH	01.88.47	25.88 LT	25.88
	LOT 41	FUTURE	OUT SMH	11.71.18	24.28 LT	24.28
	LOT 45	FUTURE	OUT SMH	11.74.46	72.90 RT	72.90
	LOT 44	FUTURE	OUT SMH	13.28 LT	76.86	9.30
	LOT 42	FUTURE	OUT SMH	73.21 RT	76.87	7.90
	LOT 43	FUTURE	OUT SMH	33.15 RT	60.65	7.70

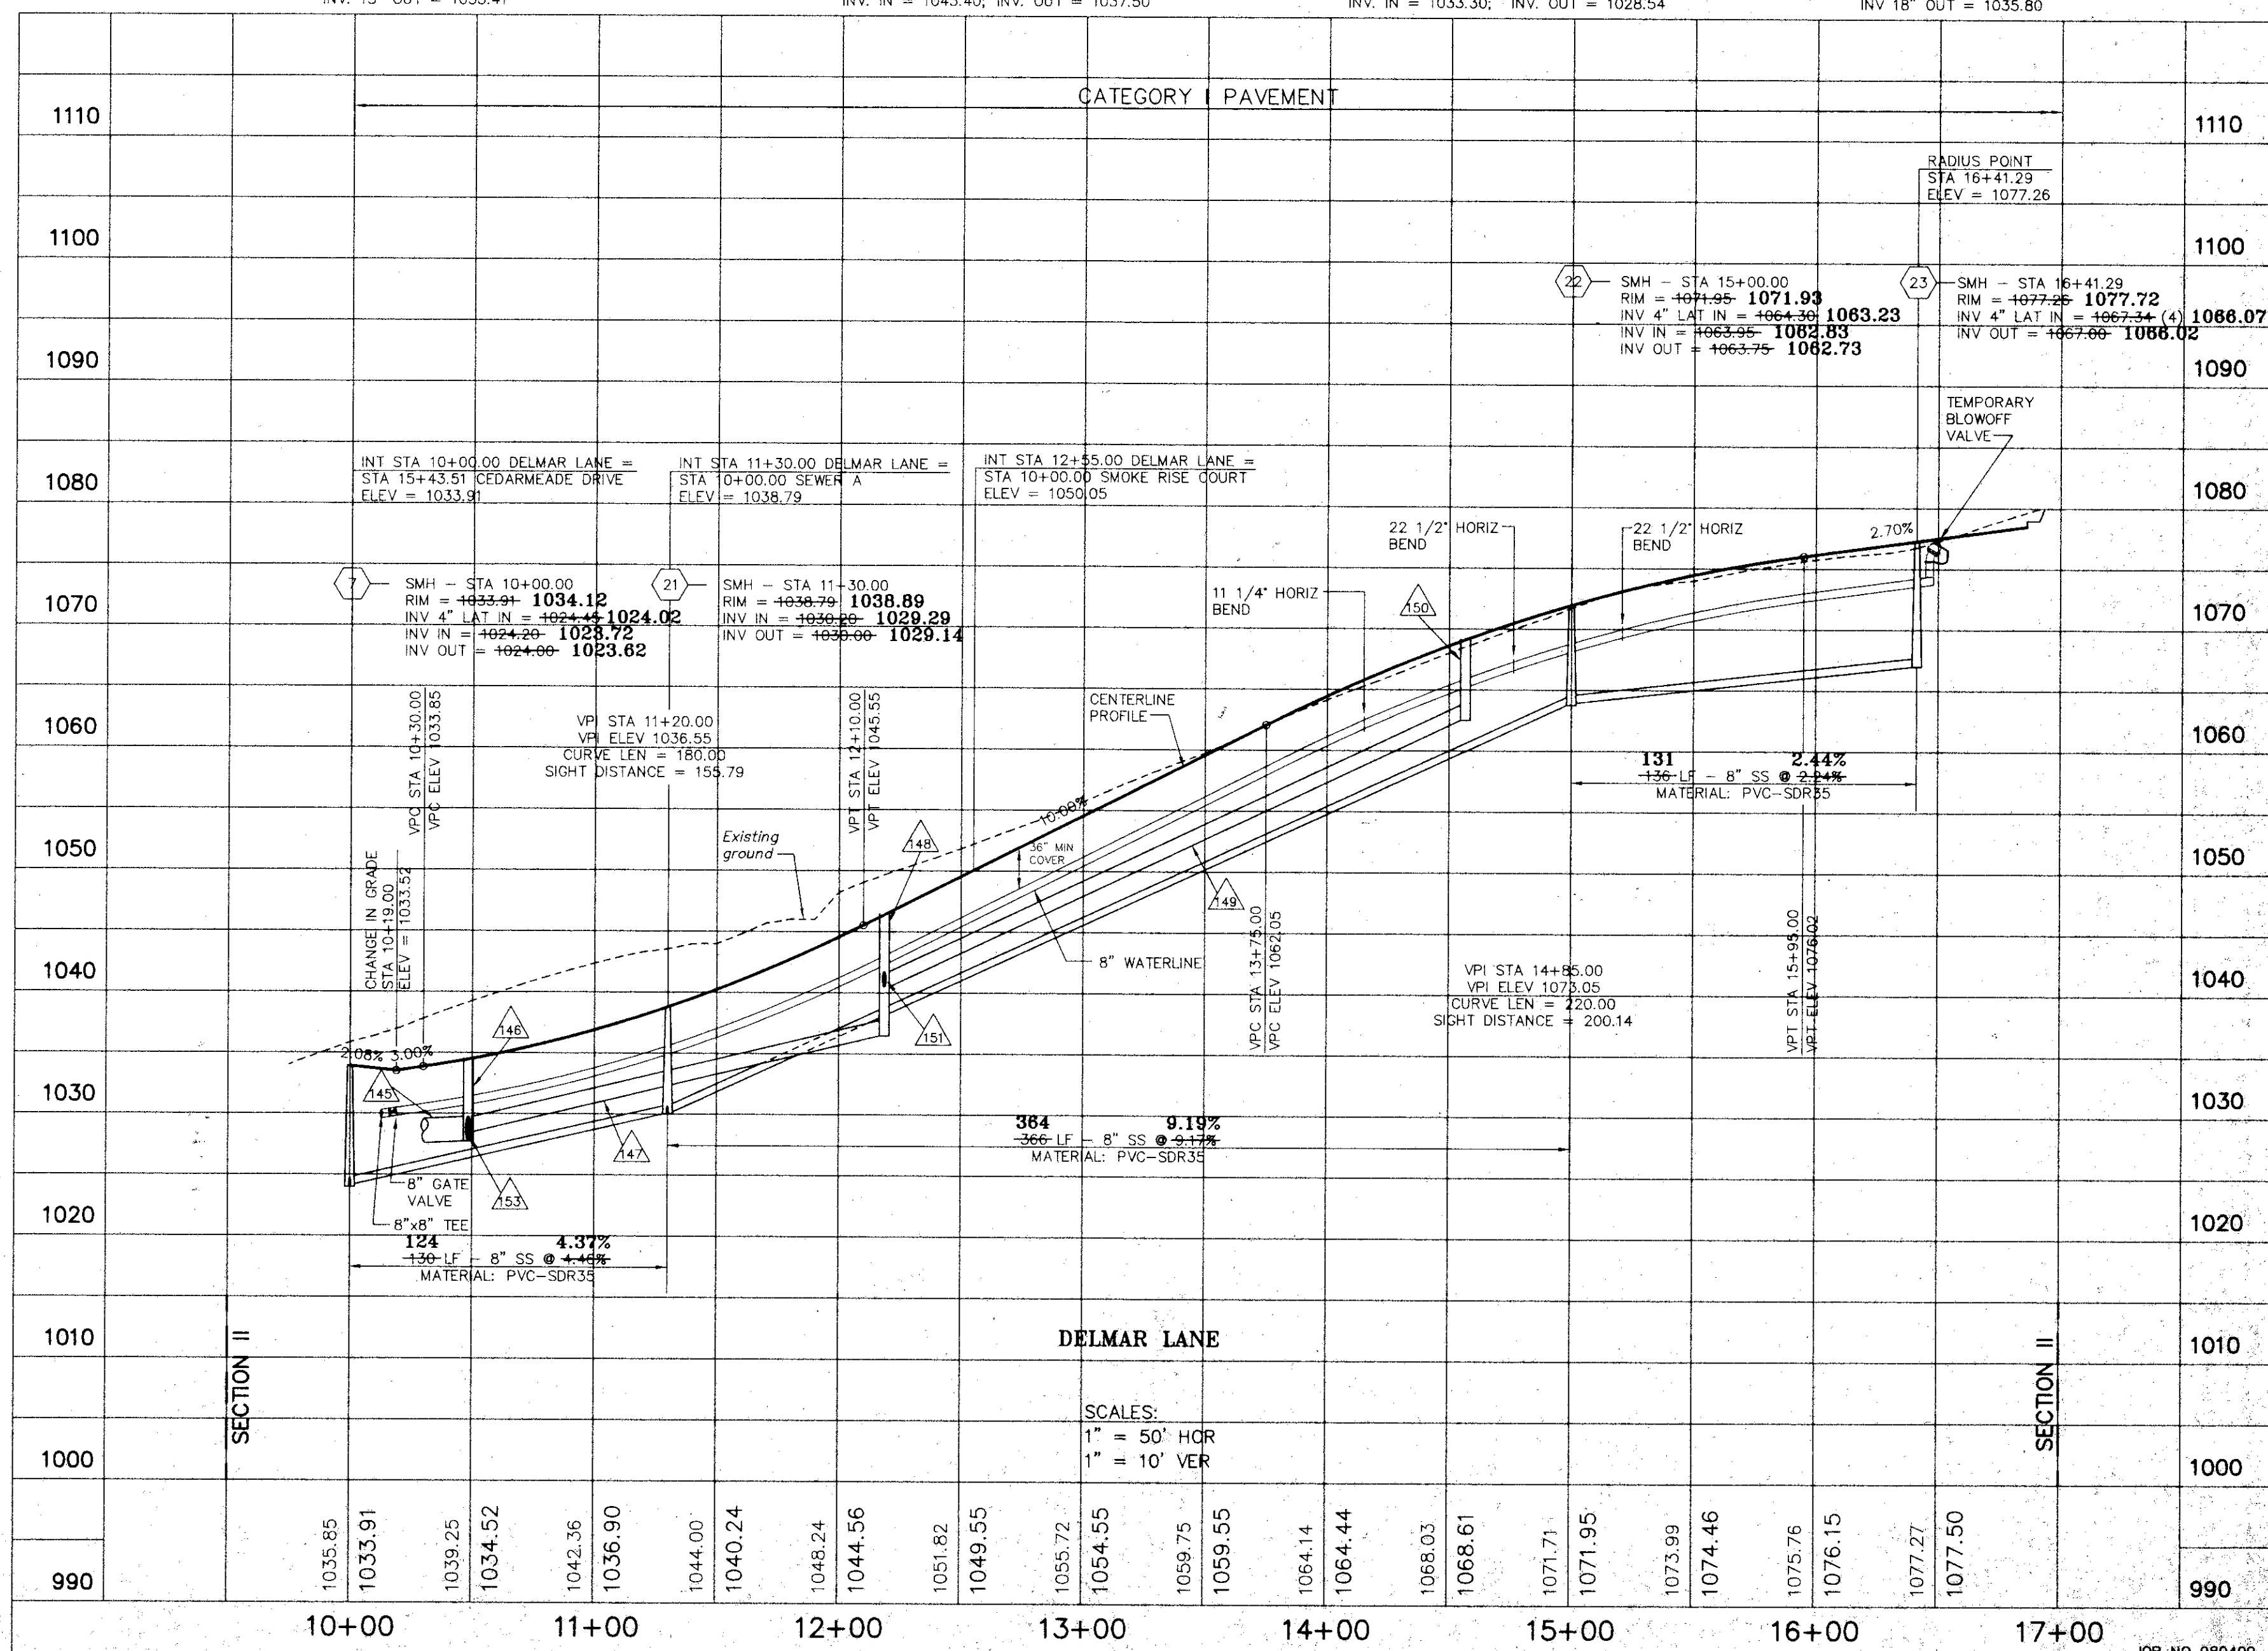

STORM SEWER TABLE

MANHOLE RUN	LATERAL LOT NO.	LATERAL SECTION	C.O. STATION	OFFSET DISTANCE	LATERAL LENGTH	C.O. DEPTH
SMH 3 UPSTATION TO SMH 2	LOT 18	SEC 1	OUT SMH	01.36.74	26.69 RT	26.69
	LOT 9	SEC 1	OUT SMH	01.43.91	19.45 LT	19.45
	LOT 6	SEC 1	OUT SMH	11.24.11	16.59 LT	16.59
	LOT 17	SEC 1	OUT SMH	11.50.27	30.72 RT	30.72
	LOT 7	SEC 1	OUT SMH	21.04.88	13.26 LT	13.26
	LOT 16	SEC 1	OUT SMH	21.34.00	35.69 RT	35.69
	LOT 15	SEC 1	OUT SMH	21.08 RT	23.84	10.10
SMH 2 UPSTATION TO SMH 1	LOT 8	SEC 1	OUT SMH	01.52.61	10.46 RT	10.46
	LOT 14	SEC 1	OUT SMH	01.71.67	39.12 RT	39.12
	LOT 9	SEC 1	OUT SMH	11.42.35	11.83 LT	11.83
	LOT 13	SEC 1	OUT SMH	11.62.22	31.64 RT	31.64
	LOT 10	SEC 1	OUT SMH	46.88 LT	52.59	11.30
	LOT 12	SEC 1	OUT SMH	42.16 RT	55.25	10.50
	LOT 11	SEC 1	OUT SMH	4.50 LT	53.16	11.00
SMH 11 UPSTATION TO SMH 12	LOT 48	FUTURE	OUT SMH	21.25.13	19.41 RT	19.41
	LOT 33	FUTURE	OUT SMH	21.59.89	27.47 LT	27.47
	LOT 47	FUTURE	OUT SMH	25.31 RT	25.40	7.75
SMH 12 UPSTATION TO SMH 13	LOT 38	FUTURE	OUT SMH	01.74.04	36.91 LT	36.91
	LOT 46	FUTURE	OUT SMH	24.17 RT	24.28	8.15
	LOT 39	FUTURE	OUT SMH	23.14 LT	25.56	8.50
SMH 13 UPSTATION TO SMH 14	LOT 40	FUTURE	OUT SMH	01.88.47	25.88 LT	25.88
	LOT 41	FUTURE	OUT SMH	11.71.18	24.28 LT	24.28
	LOT 45	FUTURE	OUT SMH	11.74.46	72.90 RT	72.90
	LOT 44	FUTURE	OUT SMH	13.28 LT	76.86	9.30
	LOT 42	FUTURE	OUT SMH	73.21 RT	76.87	7.90
	LOT 43	FUTURE	OUT SMH	33.15 RT	60.65	7.70

	128.	D1=3B, L = 18.0'; TOP ELEV. = 1039.40
	129.	INV 15' OUT = 1033.30
	132.	15' EW-IPC; INV. OUT = 1031.04
	133.	8B LF - 15' RCP, CL III; SLOPE = 1.00%
		INV. IN = 1031.92; INV. OUT = 1031.04
	134.	D1=3C, L = 4.0'; TOP ELEV. = 1038.71
		INV. 15' IN = 1032.12; INV. 15' OUT = 10
	135.	3B LF - 15' RCP, CL III; SLOPE = 1.00%
		INV. IN = 1032.50; INV. OUT = 1032.12
	136.	D1=3C, L = 12.0'; TOP ELEV. = 1038.71
		INV 15' OUT = 1032.50
(SHAPING)	140.	24" EW-IPC; INV. OUT = 1025.63
	141.	92 LF - 24" RCP, CL III; SLOPE = 1.00%
		INV. IN = 1028.55; INV. OUT = 1025.63
	142.	D1=3B, L = 8.0'; TOP ELEV. = 1035.34
		INV 24" IN = 1027.31; INV. 24" OUT = 102
	143.	36 LF - 24" RCP, CL III; SLOPE = 1.00%
		INV. IN = 1027.11; INV. OUT = 1026.75
	144.	D1=3B, L = 12.0'; TOP ELEV. = 1035.34
		INV 24" IN = 1027.31; INV. 24" OUT = 102
	145.	44 LF - 24" RCP, CL III; SLOPE = 1.00%
		INV. IN = 1027.75; INV. OUT = 1027.31
	146.	D1=3B, L = 12.0'; TOP ELEV. = 1034.53
		INV 15' IN = 1028.50; INV 24" OUT = 102
	147.	166 LF - 15" RCP, CL III; SLOPE = 4.82%
		INV. IN = 1036.50; INV. OUT = 1028.50
	148.	D1=3B, L = 10.0'; TOP ELEV. = 1046.47
		INV 15' IN = 1040.50; INV 15' OUT = 103
	149.	238 LF - 15" RCP, CL III; SLOPE = 9.24%
		INV. IN = 1062.50; INV. OUT = 1040.50
	150.	D1=3B, L = 16.0'; TOP ELEV. = 1069.16
		INV 15' OUT = 1062.50
	151.	77 LF - 15" RCP, CL III; SLOPE = 5.84%
		INV. IN = 1045.00; INV. OUT = 1040.50
	152.	D1=3B, L = 15.0'; TOP ELEV. = 1050.96
		INV 15' OUT = 1045.00
	153.	150 LF - 15" RCP, CL III; SLOPE = 1.00%
		INV. IN = 1028.80; INV. OUT = 1028.50
	154.	D1=3B, L = 10.0'; TOP ELEV. = 1034.63
		INV 15' OUT = 1028.80
	156.	30' EW-IPC; INV. OUT = 1027.85
	157.	15B LF - 36" RCP, CL III; SLOPE = 2.50%
		INV. IN = 1031.30; INV. OUT = 1027.85
	158.	D1=3B, L = 12.0'; TOP ELEV. = 1038.41
		INV 24" IN = 1031.80; INV 30" OUT = 103
	159.	140 LF - 24" RCP, CL III; SLOPE = 0.30%
		INV. IN = 1044.40; INV. OUT = 1031.80
160.	YARD INLET	
		TRIPLE D1=7, TYPE III GRATE; TOP ELEV. =
		INV 24" OUT = 1027.85
	161.	184 LF - 15" RCP, CL III; SLOPE = 1.40%
		INV. IN = 1020.00; INV. OUT = 1017.41
	162.	D1=3B, L = 10.0'; TOP ELEV. = 1027.41
		INV 15' OUT = 1020.00
	167.	65 LF - 36" RCP, CL III; SLOPE = 1.50%
		INV. IN = 1031.47; INV. OUT = 1030.64
	168.	D1=36B, L = 14.0'; TOP ELEV. = 1040.66
		INV. 36" IN = 1031.67; INV. 36" OUT = 10
	169.	85 LF - 36" RCP, CL III; SLOPE = 1.50%
		INV. IN = 1032.95; INV. OUT = 1031.67
	170.	36" EW-IPC; INV. OUT = 1032.95
	179.	180 LF - 18" RCP, CL III; SLOPE = 0.50%
		INV. IN = 1035.80; INV. OUT = 1033.10
180.	YARD INLET	
		D1=7, TYPE III GRATE; TOP ELEV. = 1033.10