

BOARD OF COUNTY SUPERVISORS

ROANOKE COUNTY, VIRGINIA


PROJECT NO. 81-11-W

SCHEDULE OF DRAWING'S

SHEET	TITLE	STATIONS
1	COVER SHEET	
2	PLAN SHEET	0+00 - 14+20
2A	DETAILS	
3	PLAN SHEET	14+20 - 22+00
3A	DETAILS	
4	WATER DETAILS	

LEGEND

	PROPERTY LINE
	RIGHT OF WAY LINE
	PAVEMENT
	MANHOLE
	SANITARY SEWER
	WATER MAIN
	GAS LINE
	ELECTRIC CABLE OR CONDUIT
	TELEPHONE CABLE OR CONDUIT
	TELEVISION CABLE OR CONDUIT
	STORM SEWER
	RAILROAD TRACKS
	DITCH
	STREAM
	FENCE
	FIRE HYDRANT
	EXISTING GROUND
	ROCK OR STONE WALL
	VALVE
	WATER METER
	UTILITY POLE WITH GUY AND ANCHOR
	TREE
	SHRUB
	HEDGE
	CLEAN-OUT
	PROP. WATER MAIN
	PROP. GATE VALVE
	PROP. FIRE HYDRANT ASSEMBLY
	PROP. BLOW-OFF ASSEMBLY
	PROP. AIR RELEASE ASSEMBLY
	SINGLE WATER SERVICE CONNECTION
	DOUBLE WATER SERVICE CONNECTION

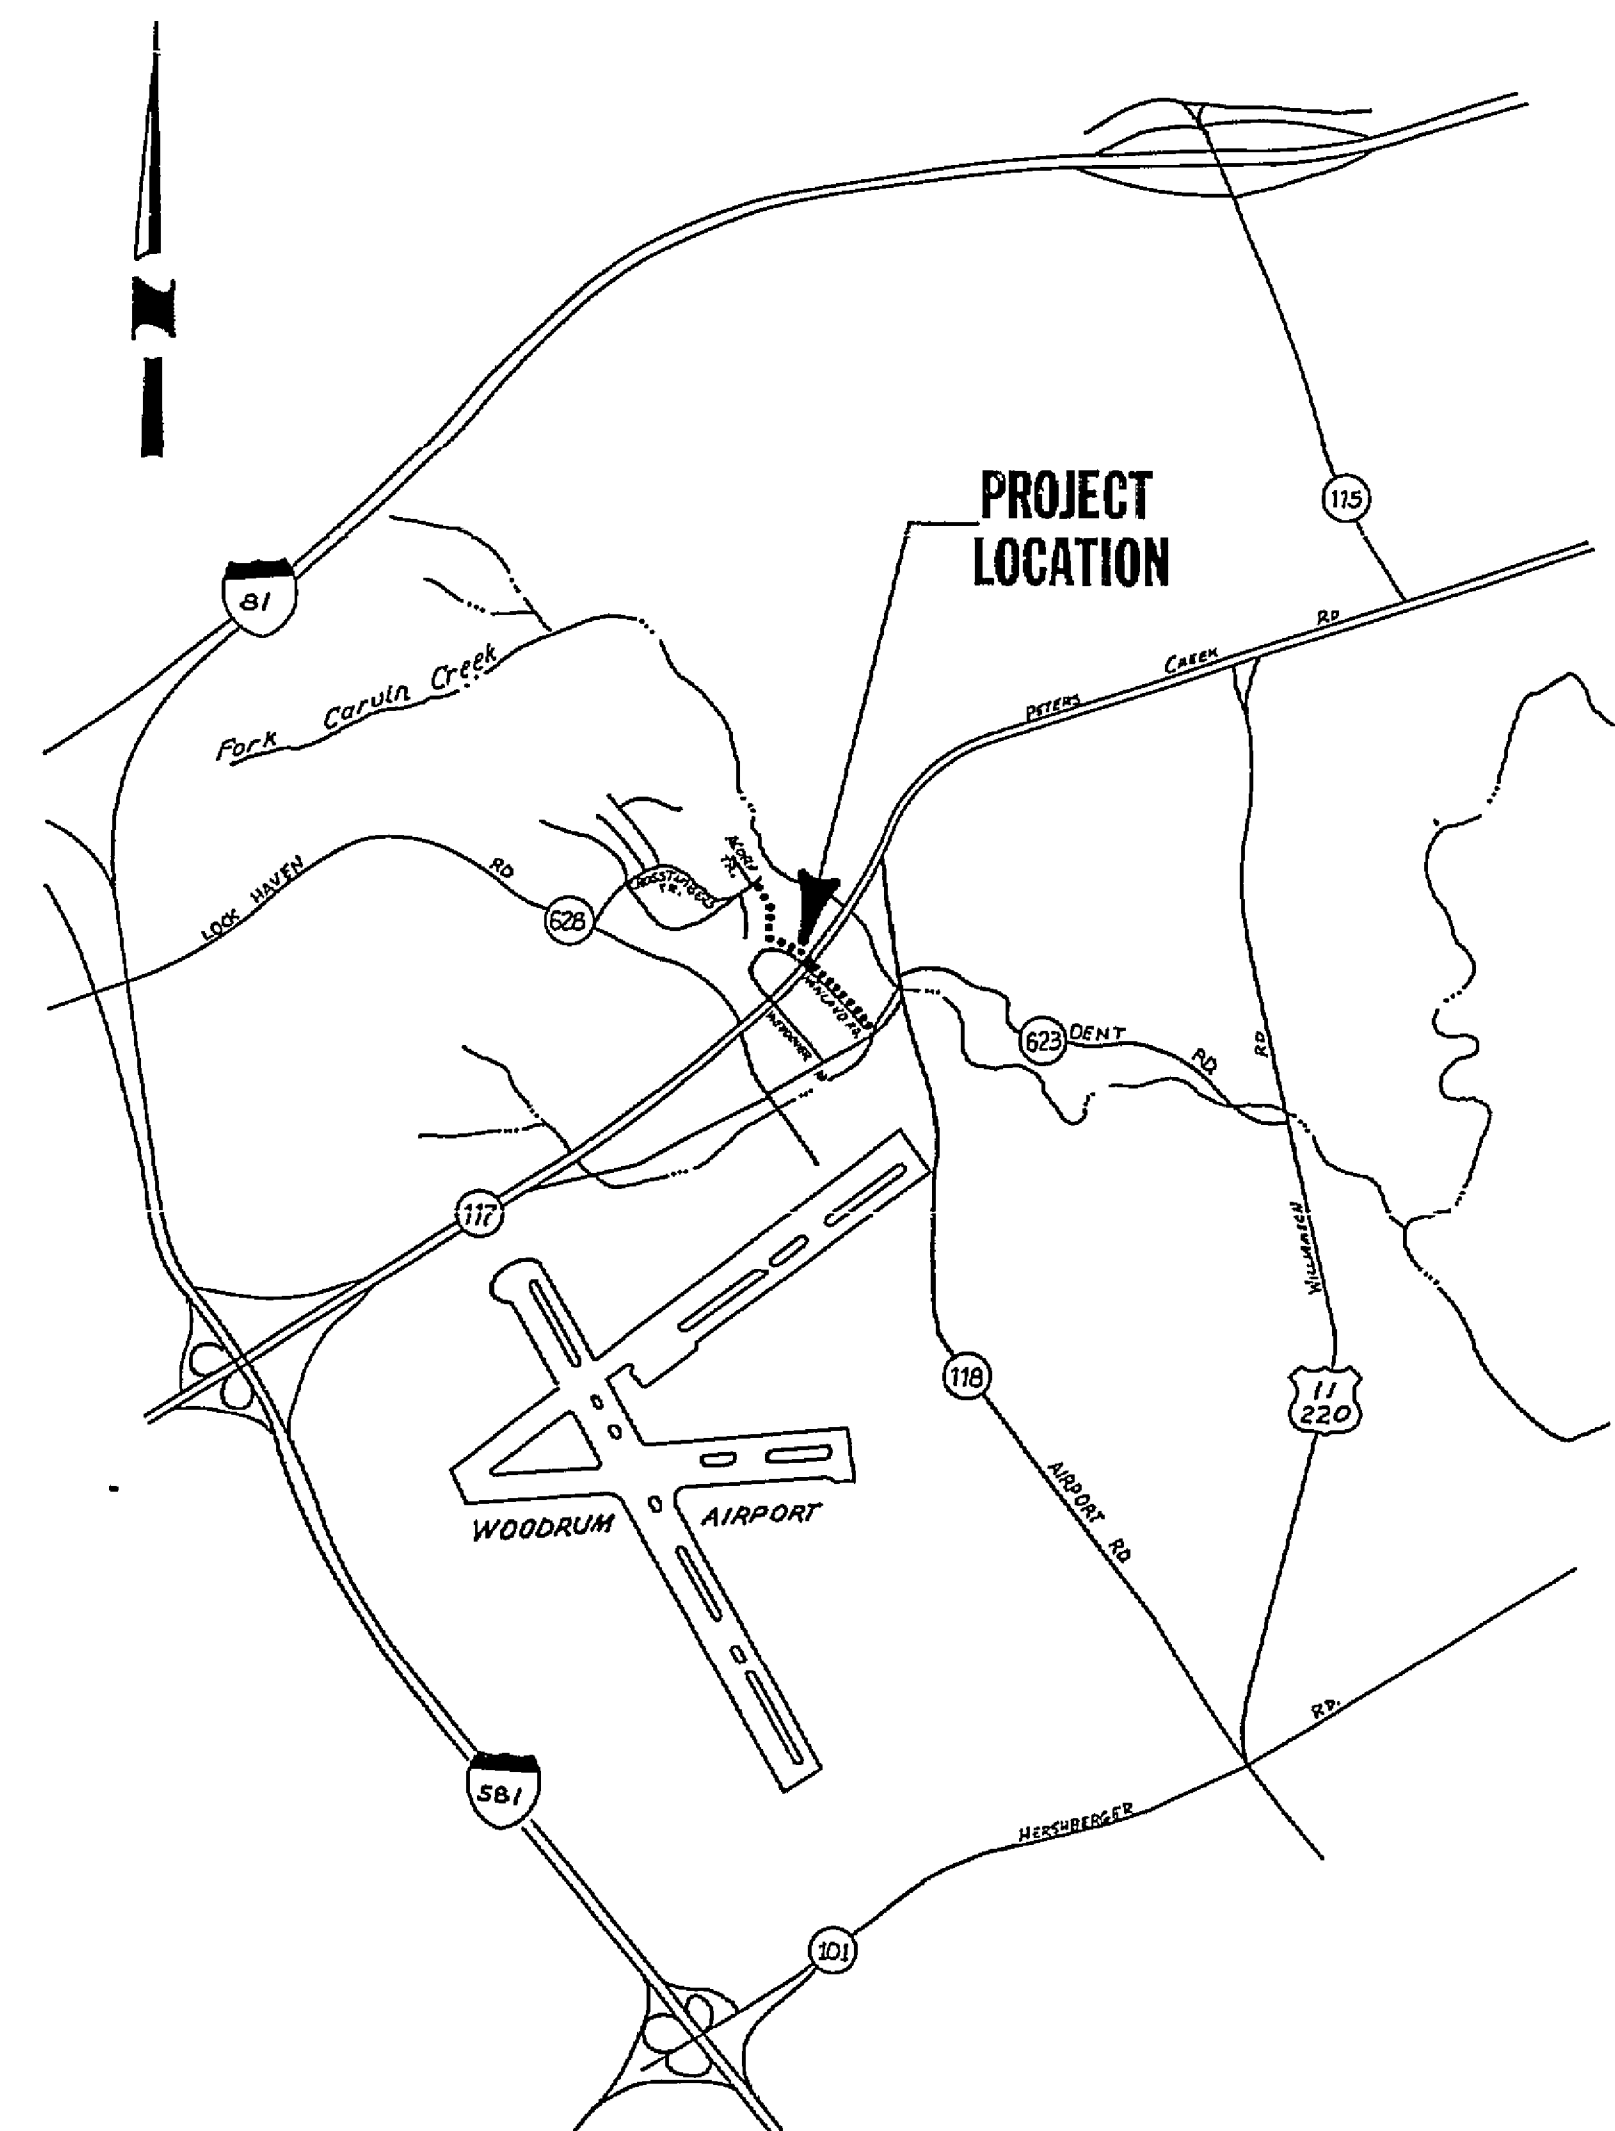

AS-BUILT
WATER FACILITY IMPROVEMENT

BROOKLAWN REPLACEMENT

BOARD MEMBERS

MAY W. JOHNSON
ATHENA E. BURTON
ROBERT E. MYERS
GARY J. MINTER
HARRY C. NICKENS

MARCH 1983