


BEGIN PROJECT
STA. 0+00


6" TAPPING SLEEVE
6" VALVE
8" x 6" RED.

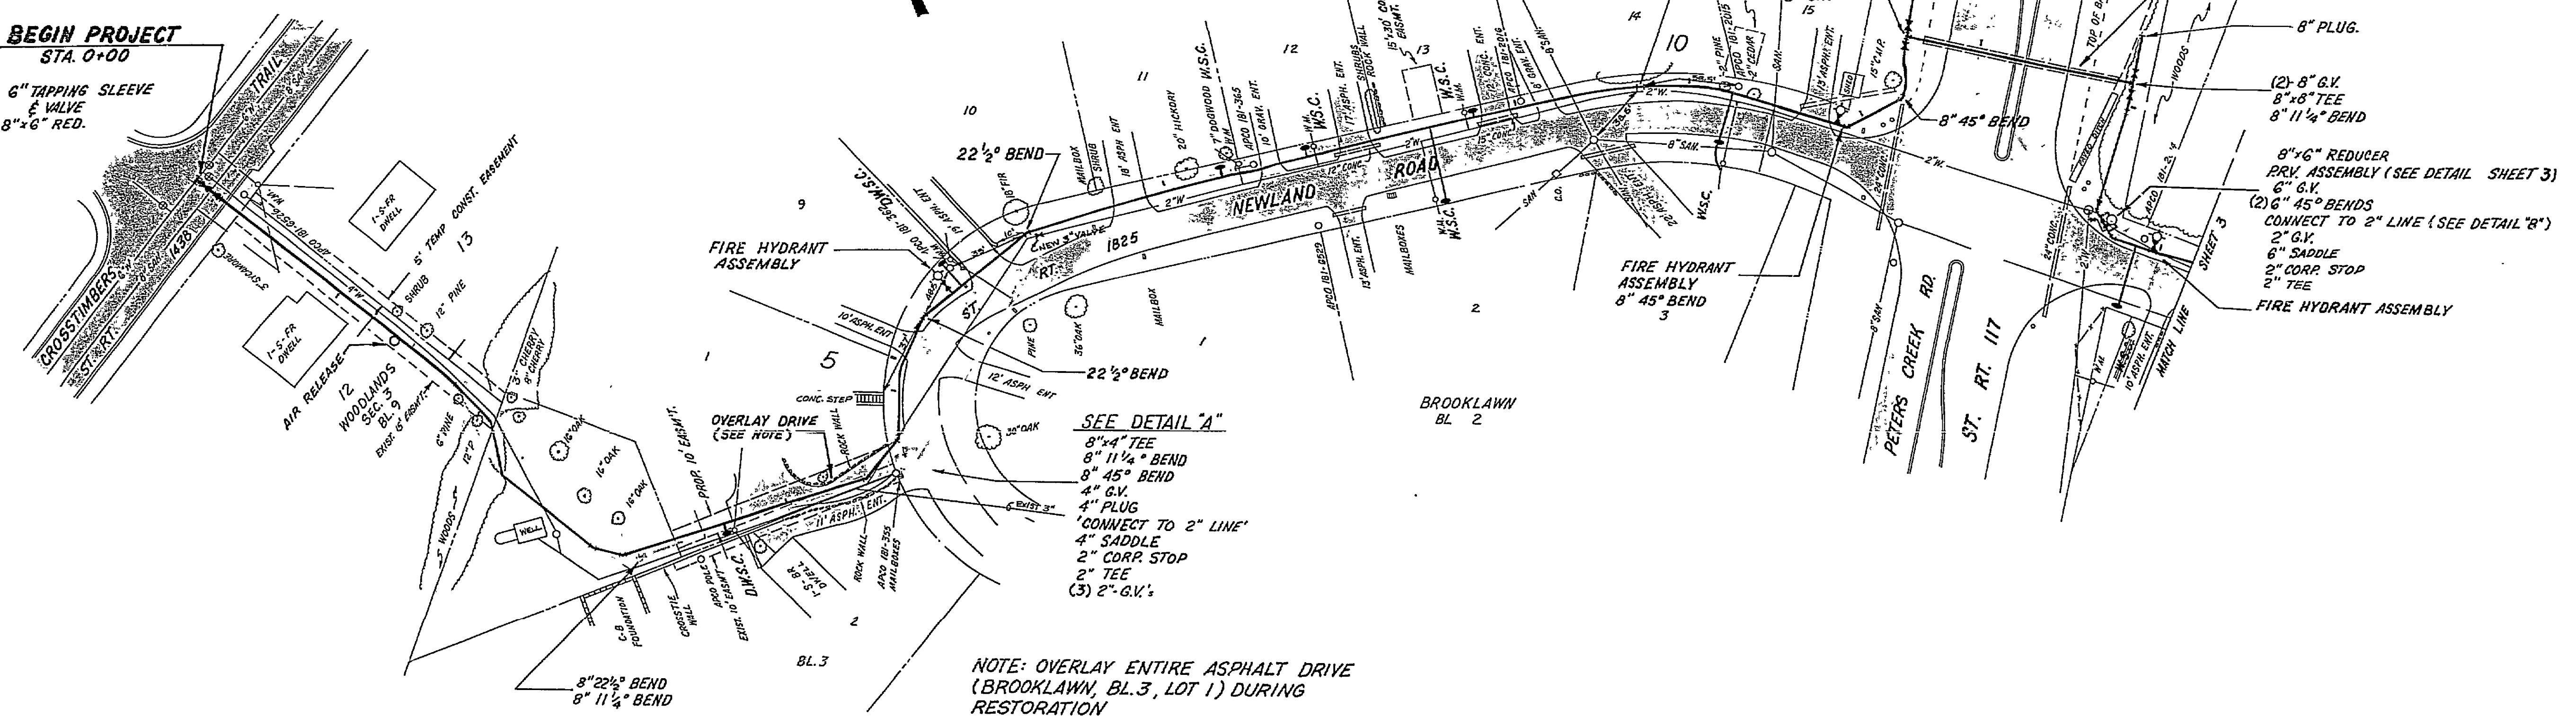

NOTE: OVERLAY ENTIRE ASPHALT DRIVE
(BROOKLAWN, BL.3, LOT 1) DURING
RESTORATION

SCALE: 1" = 50'

AS-BUILT

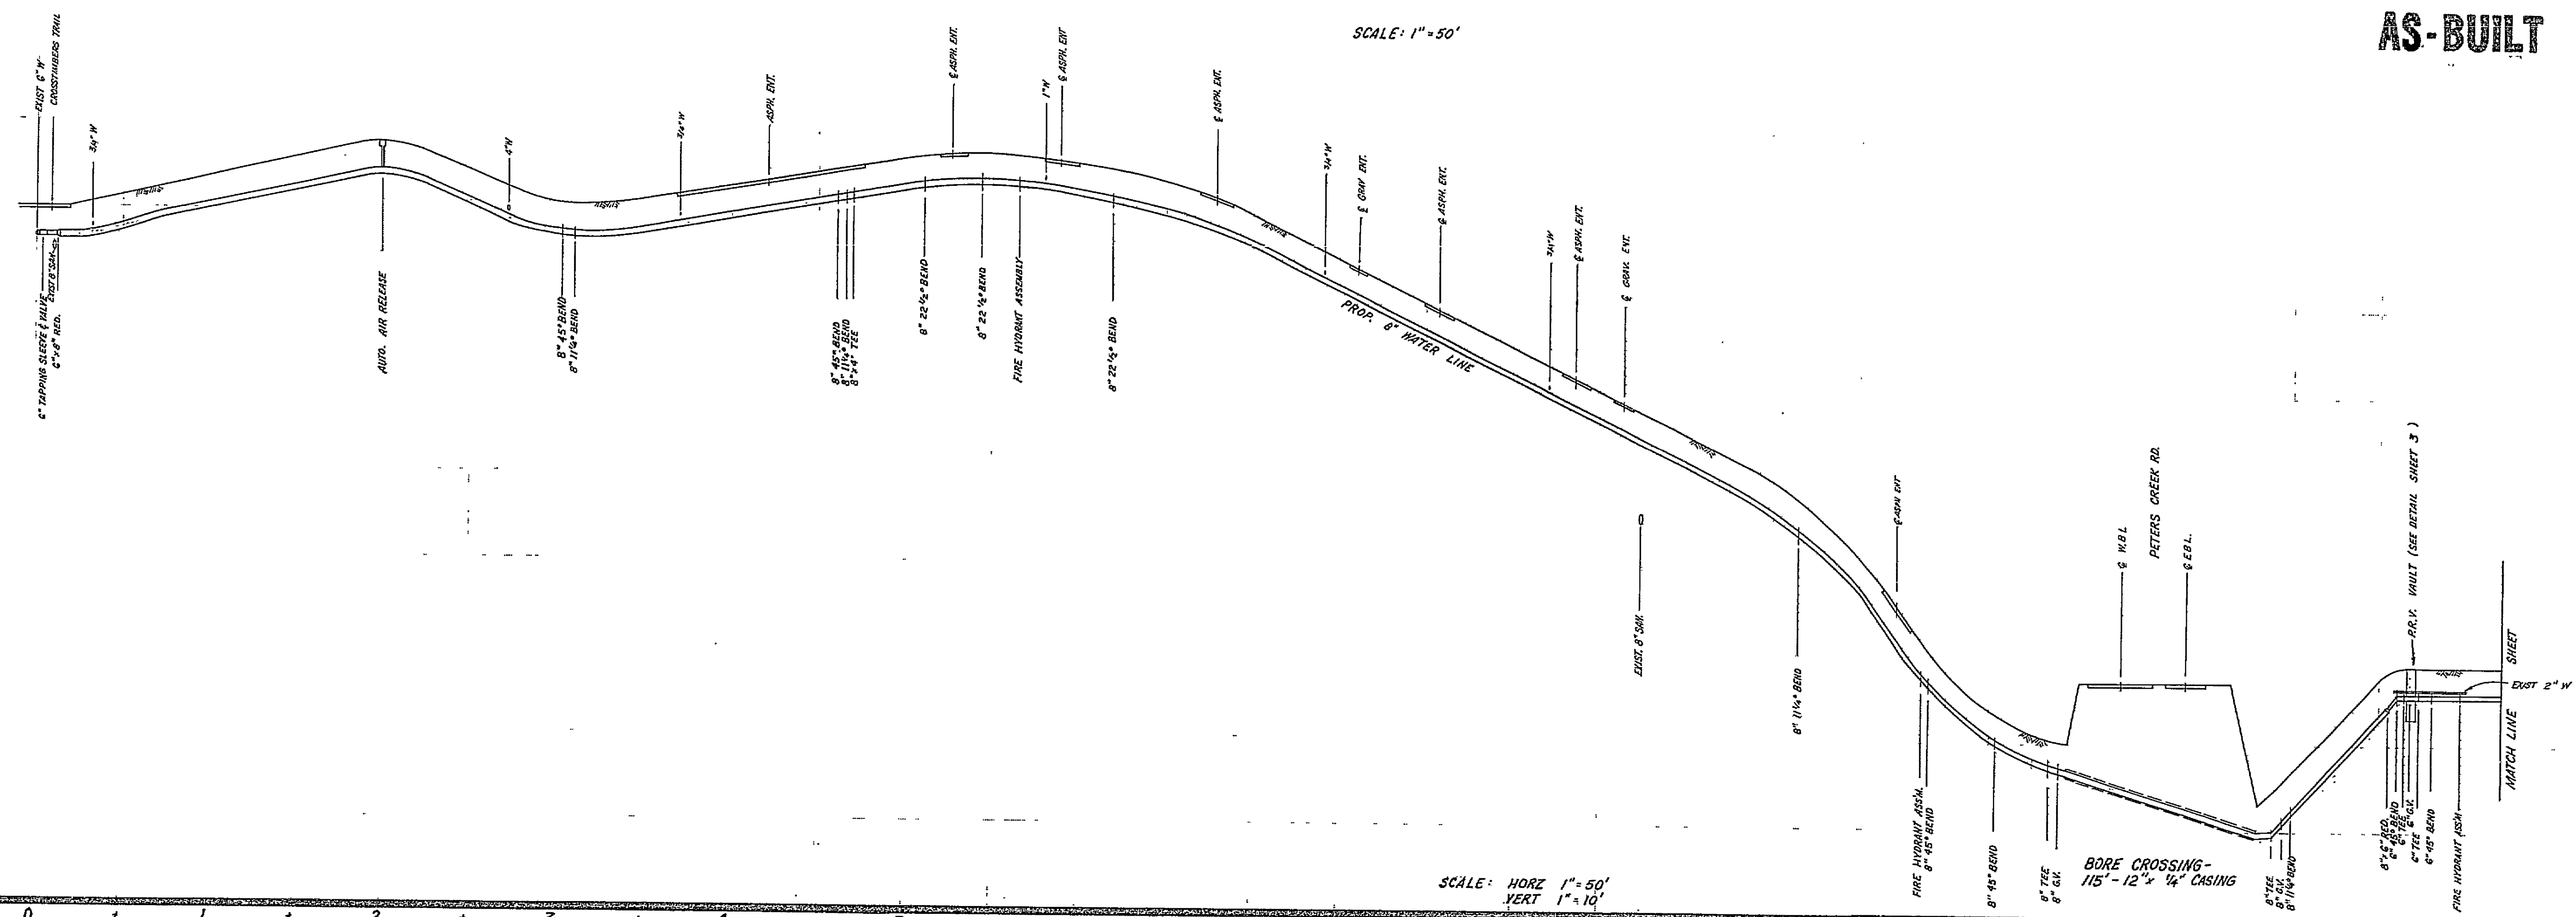

SCALE: HORIZ. 1" = 50'
VERT. 1" = 10'

ROANOKE COUNTY
UTILITY DEPARTMENT

NO.	REVISIONS	DATE

BROOKLAWN REPLACEMENT

DATE: JAN 6, 1983
SCALE: HORIZ. 1" = 50' VERT. 1" = 10'
DRAWING BY: M.A.G.
DESIGNED BY: M.S.W.
APPROVED BY:

PROJECT
81-11-W

SHEET
2
OF
4