




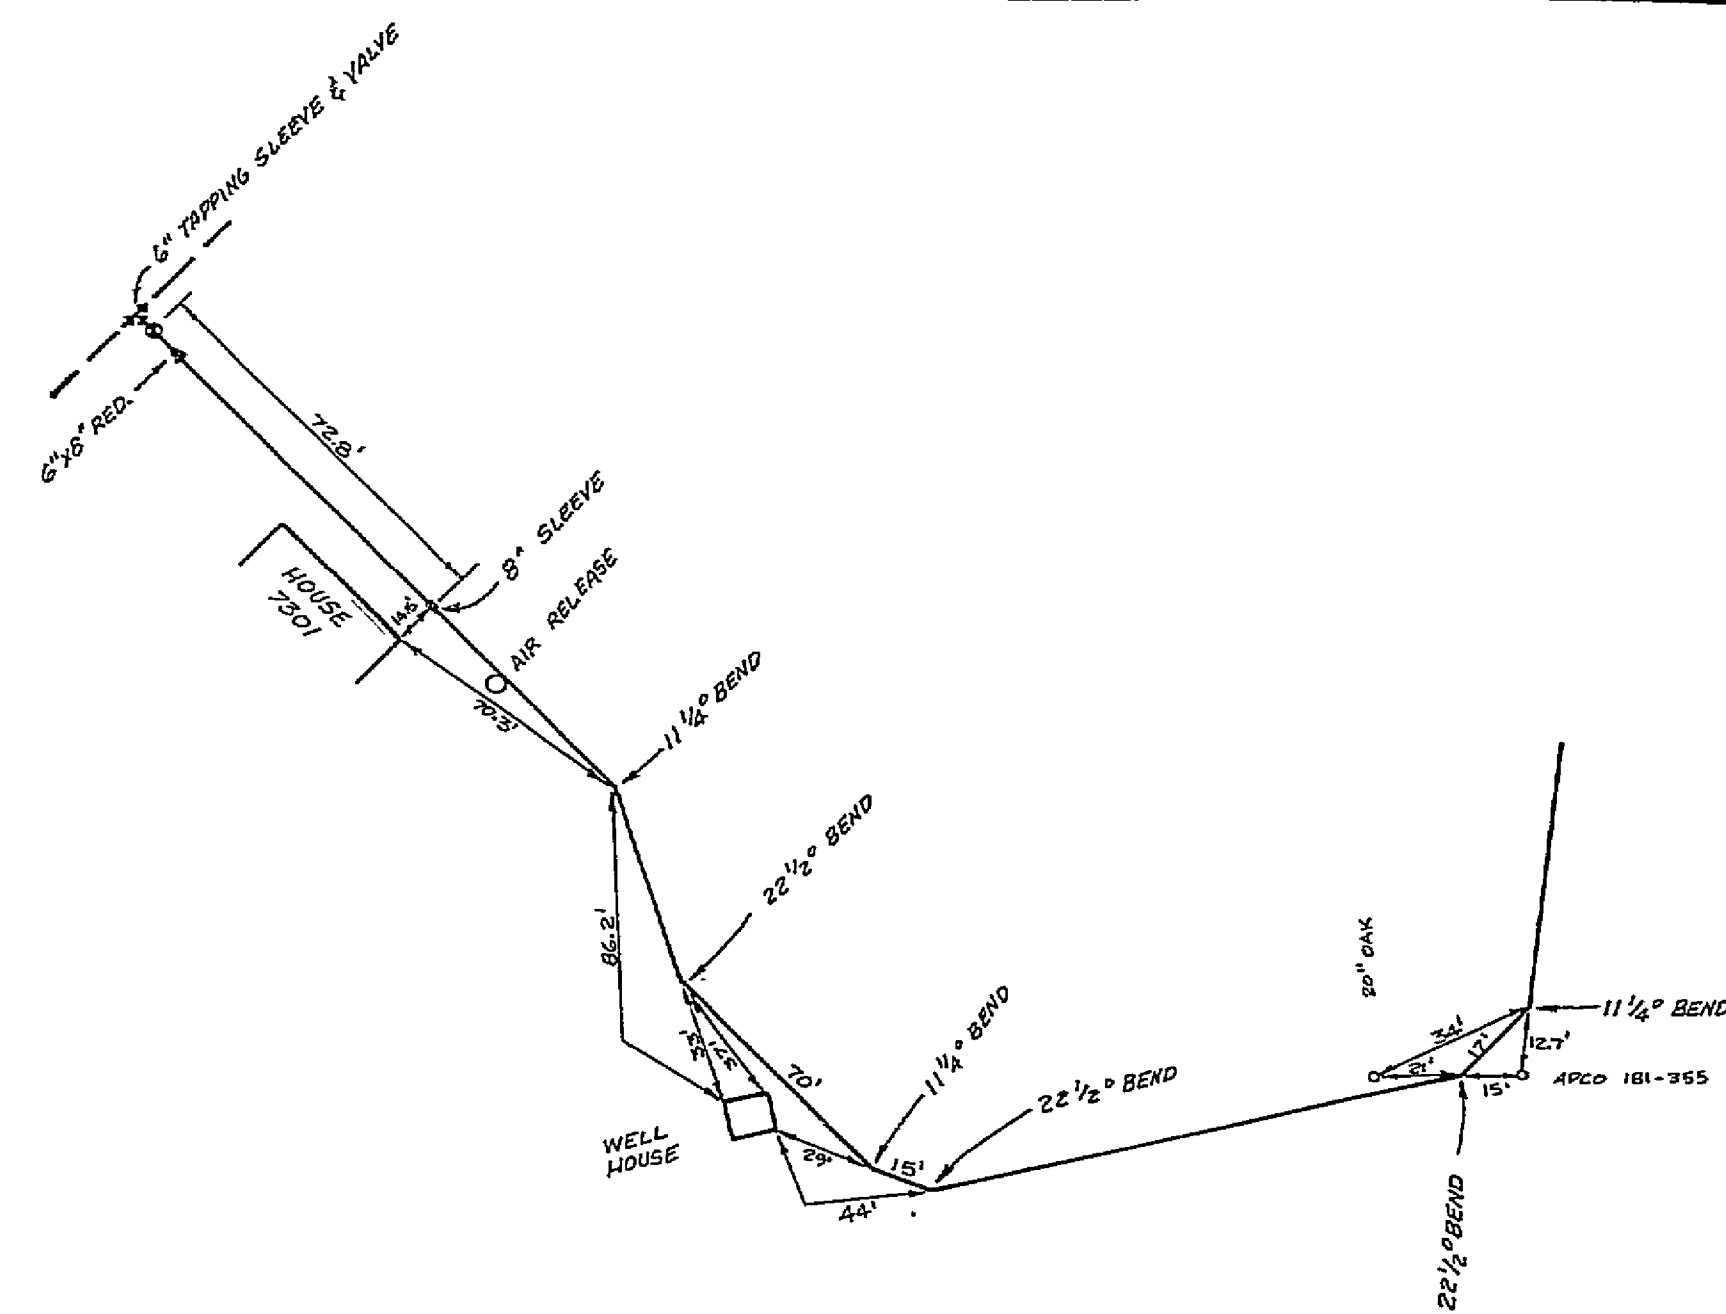


STA. 0+00 TO STA. 5+00
NOT TO SCALE

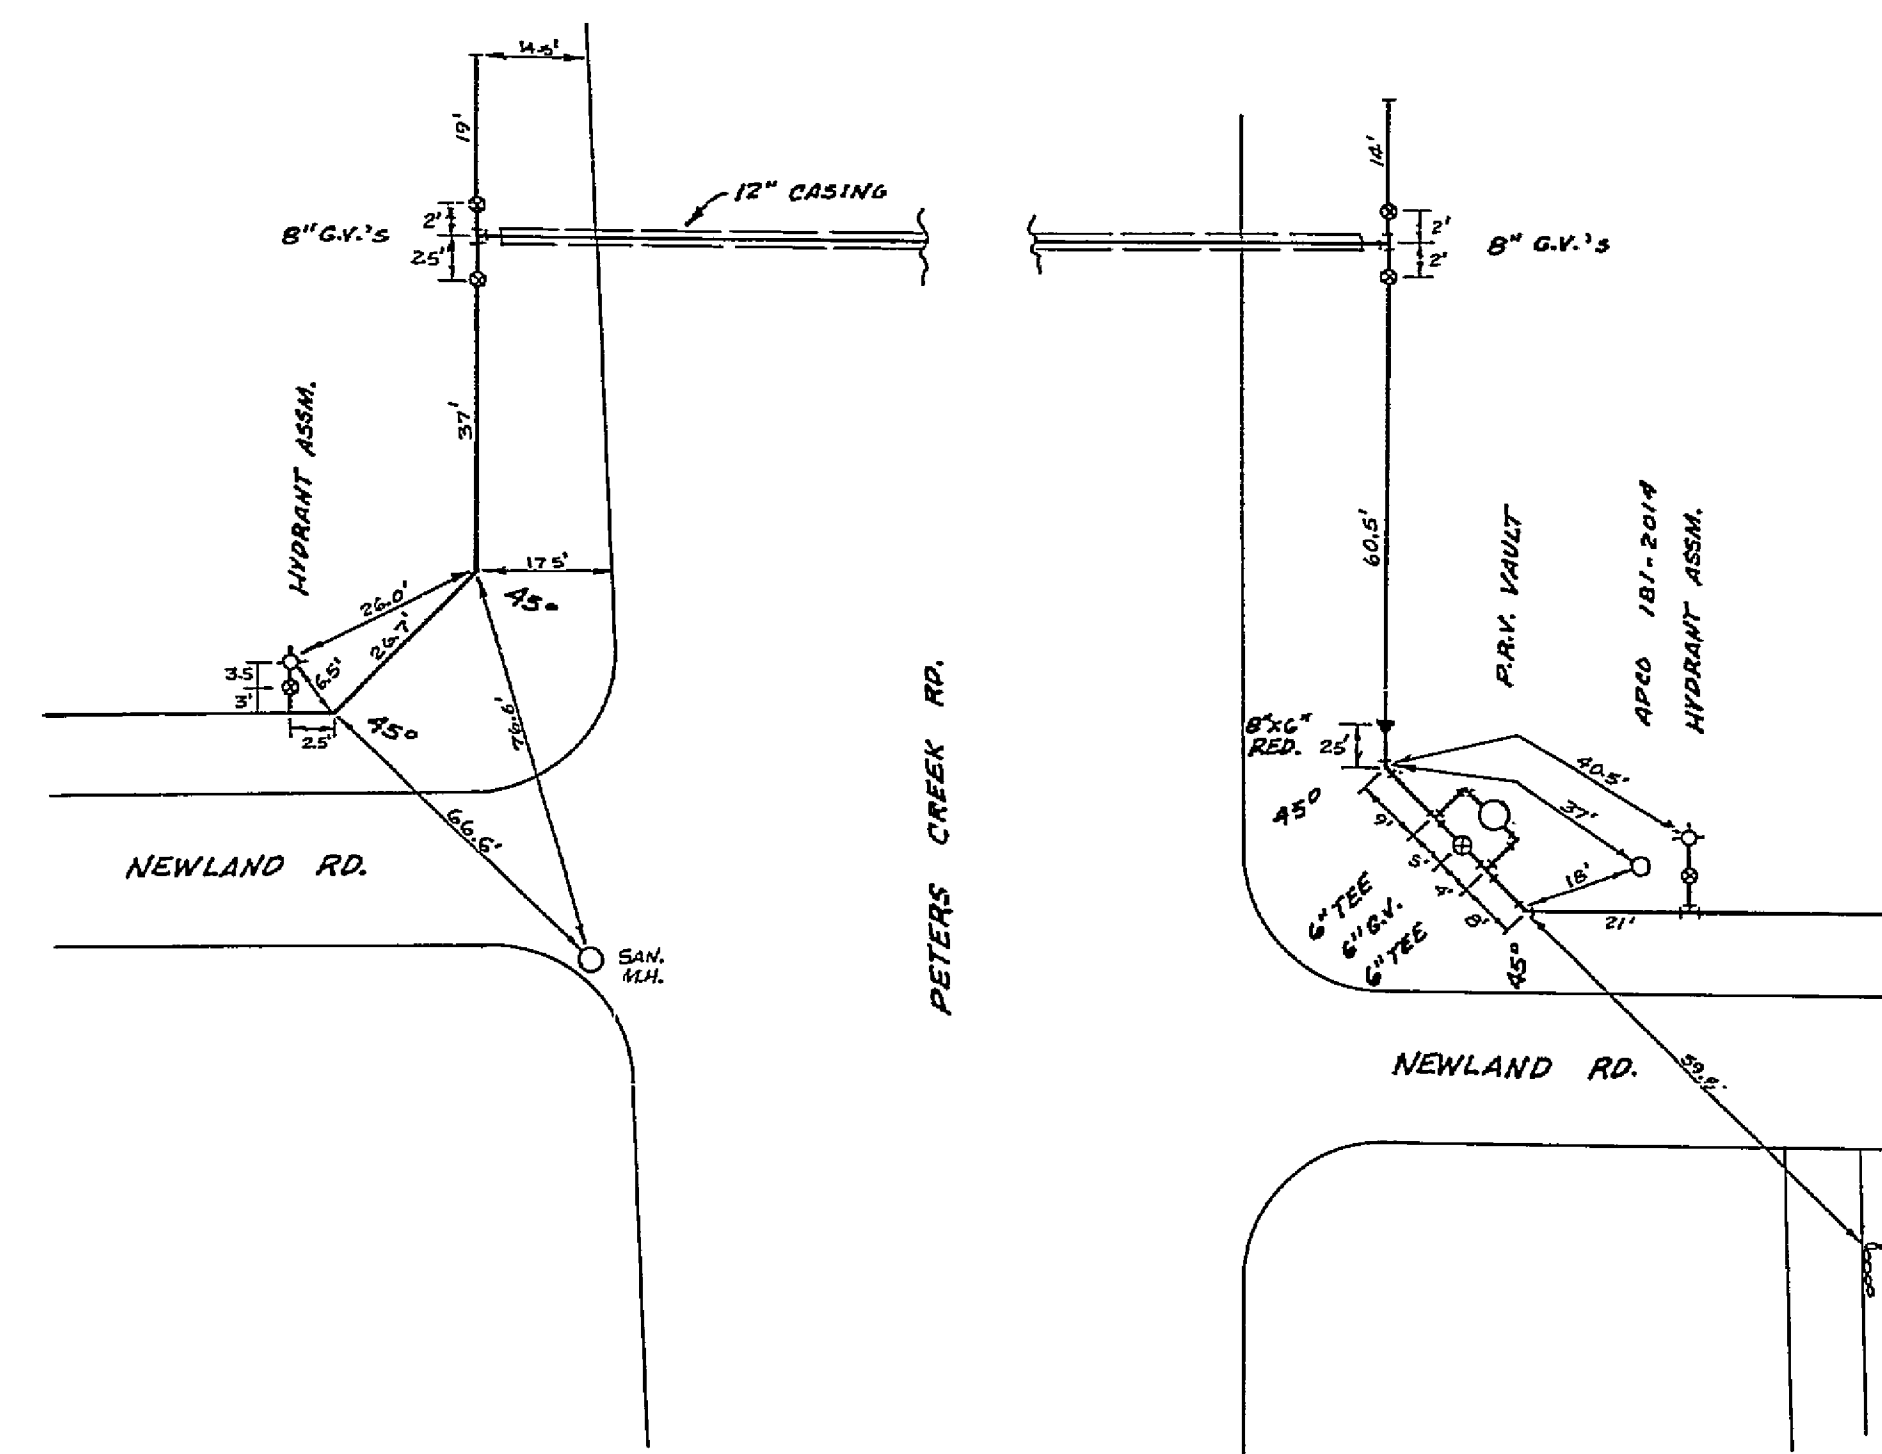

RT. 117 CROSSING
NOT TO SCALE

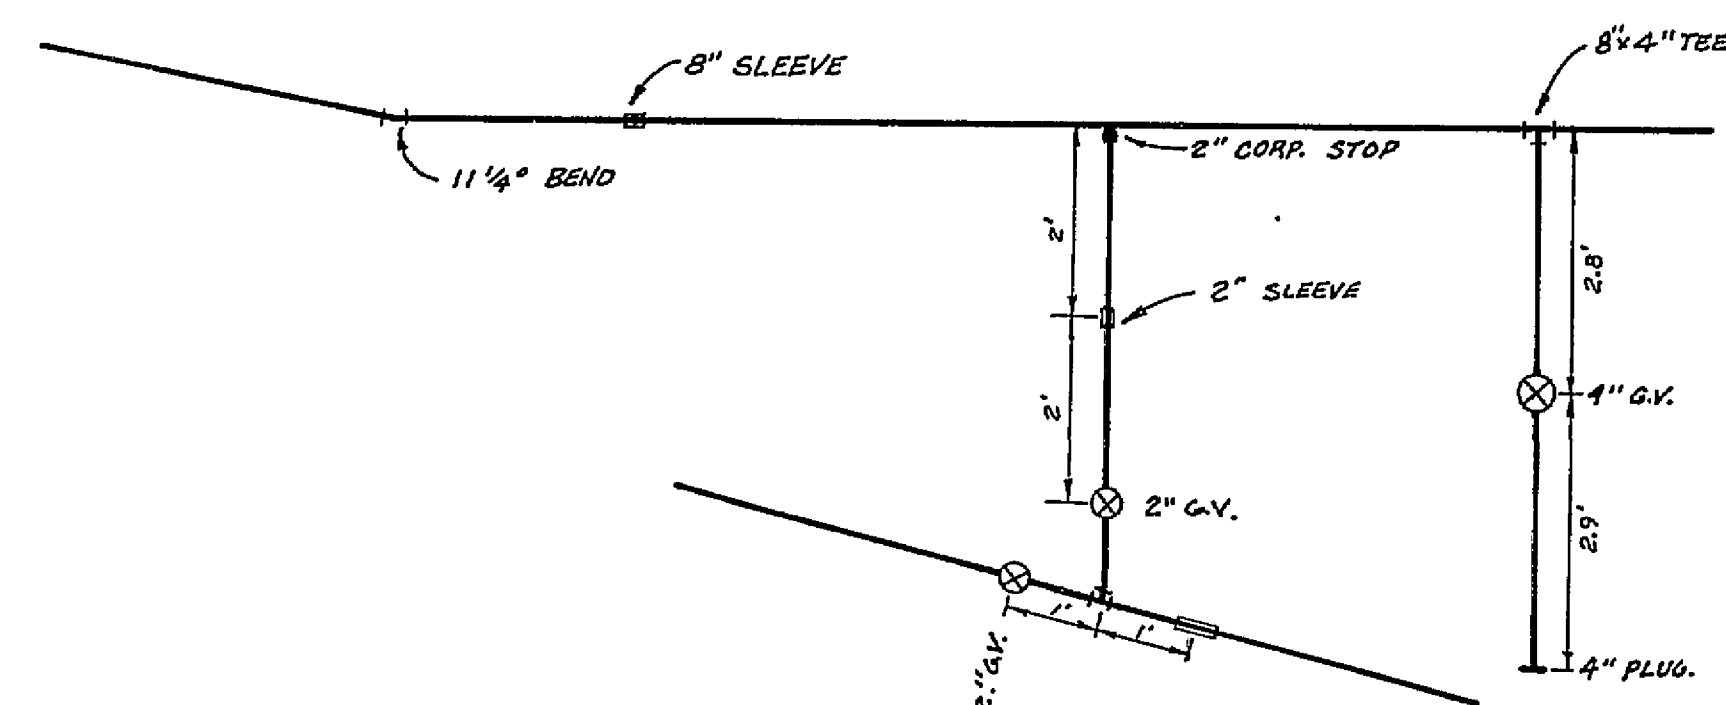

DETAIL "A"
NOT TO SCALE

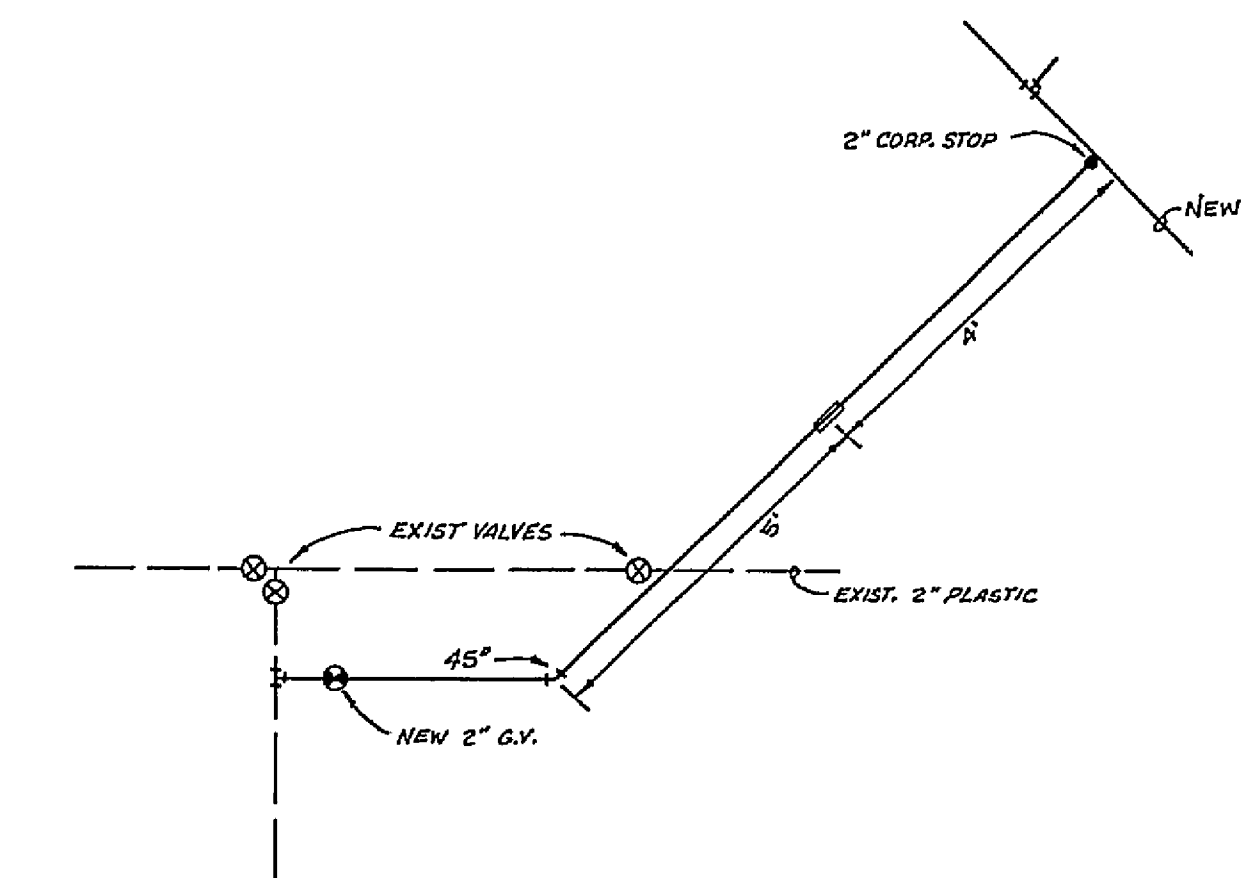

DETAIL "B"
NOT TO SCALE

AS-BUILT

 ROANOKE COUNTY UTILITY DEPARTMENT	<table border="1"> <tr> <th>NO.</th> <th>REVISIONS</th> <th>DATE</th> </tr> <tr> <td> </td> <td> </td> <td> </td> </tr> <tr> <td> </td> <td> </td> <td> </td> </tr> <tr> <td> </td> <td> </td> <td> </td> </tr> </table>		NO.	REVISIONS	DATE										BROOKLAWN REPLACEMENT		DATE: MARCH 29, 1984 SCALE: AS SHOWN DRAWING BY: M.A.G. DESIGNED BY: APPROVED BY:	PROJECT 81-11-W	SHEET 2A OF 4
	NO.	REVISIONS	DATE																