

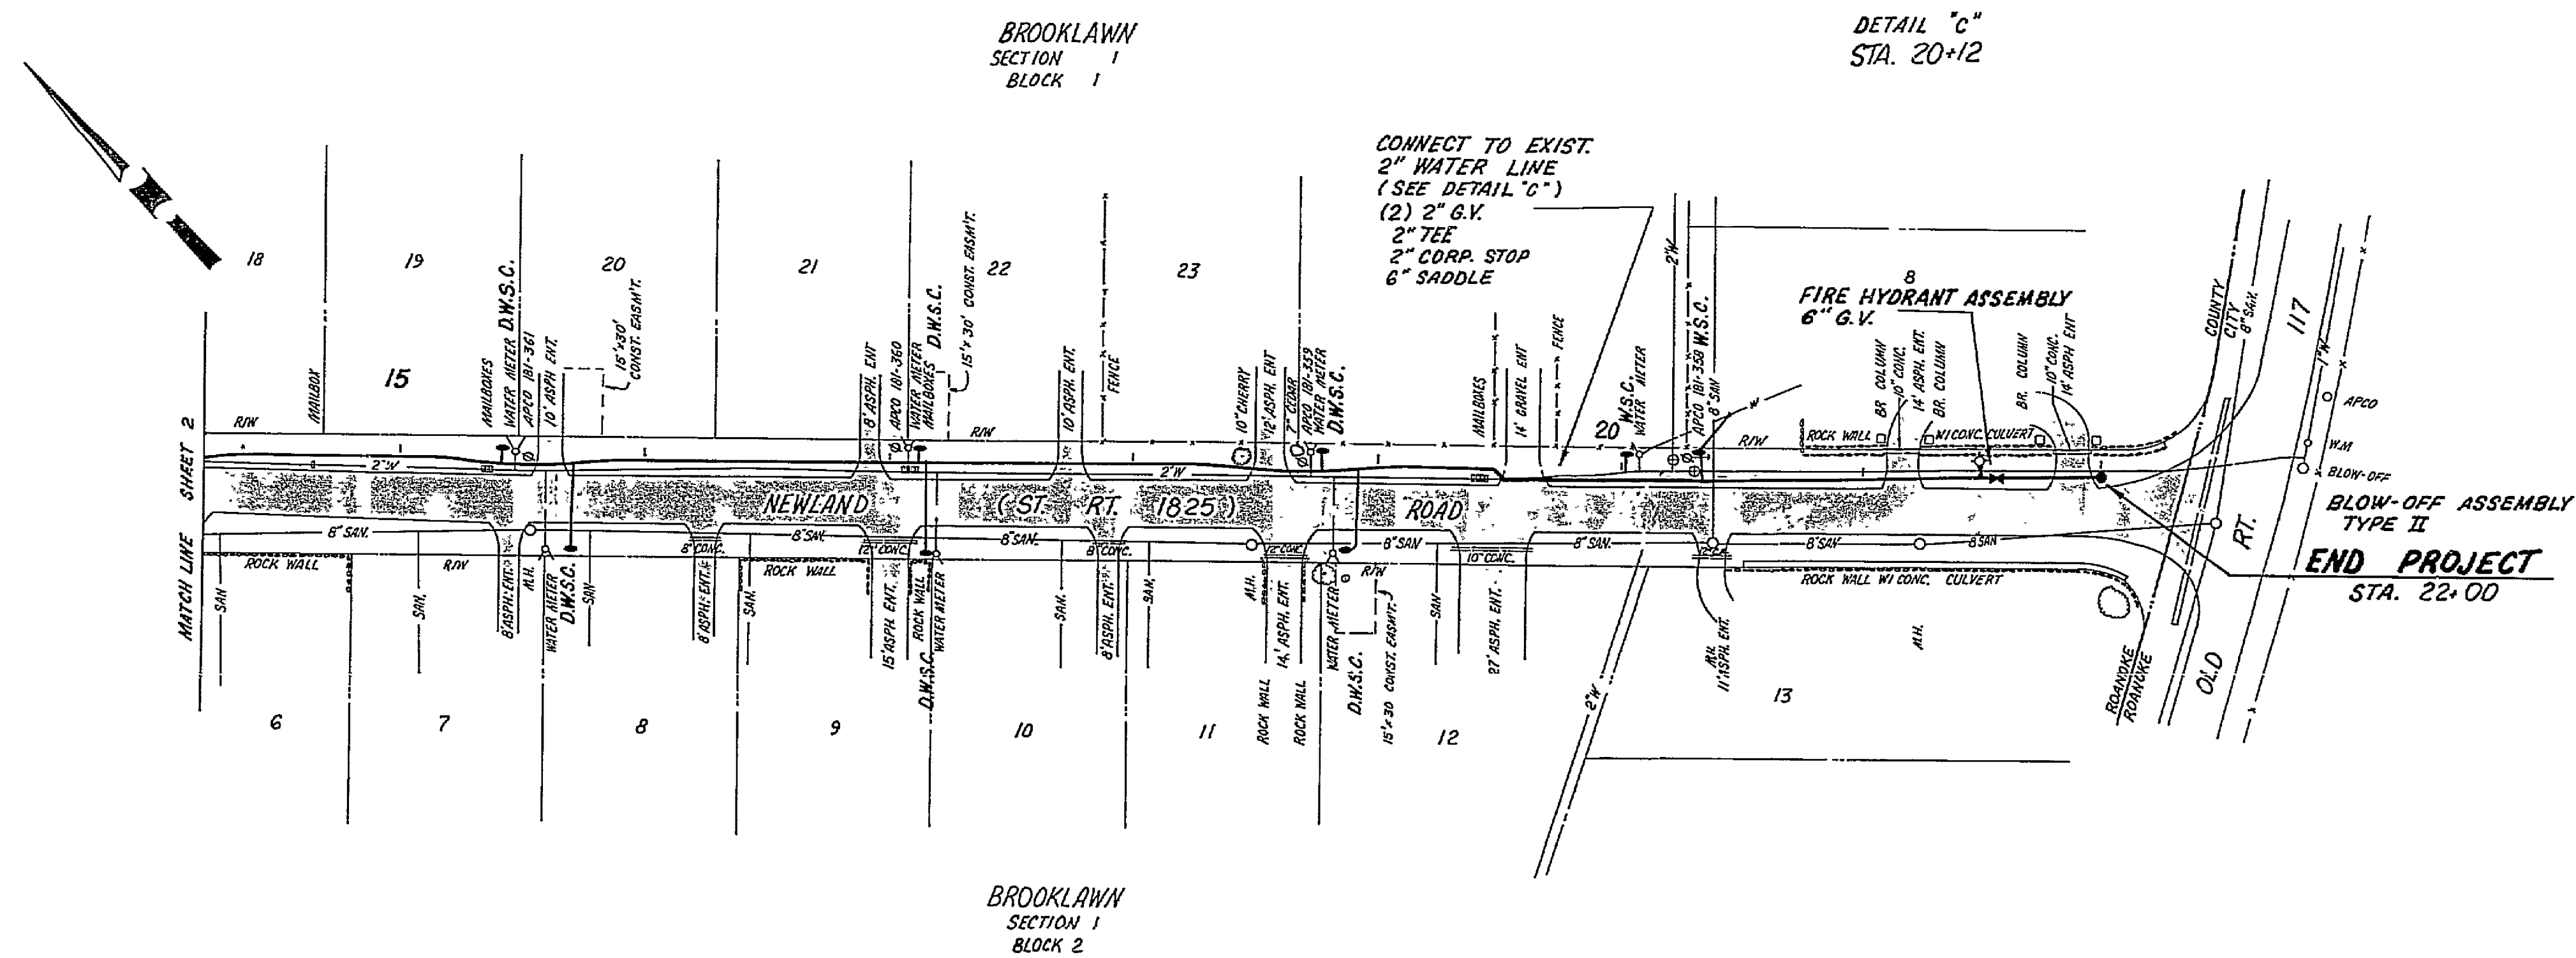


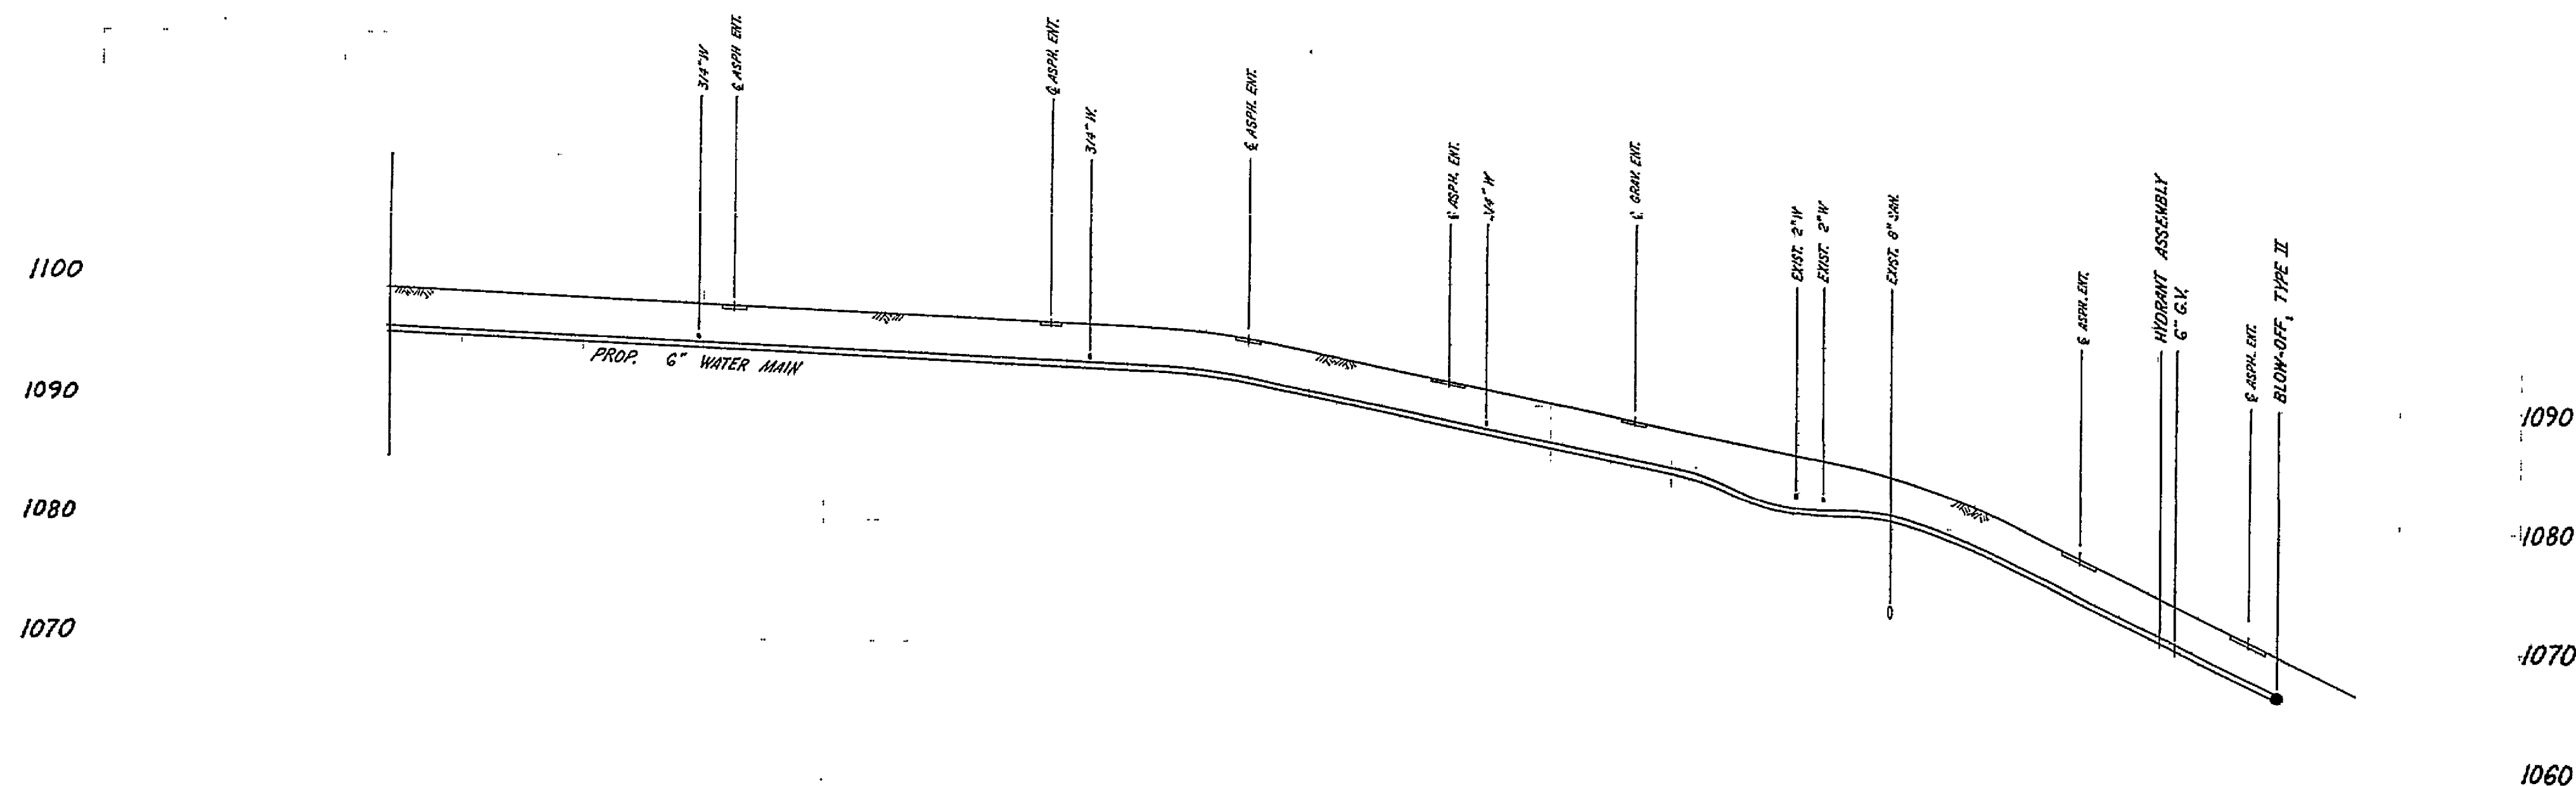


SCALE: 1"=50'

AS-BUILT

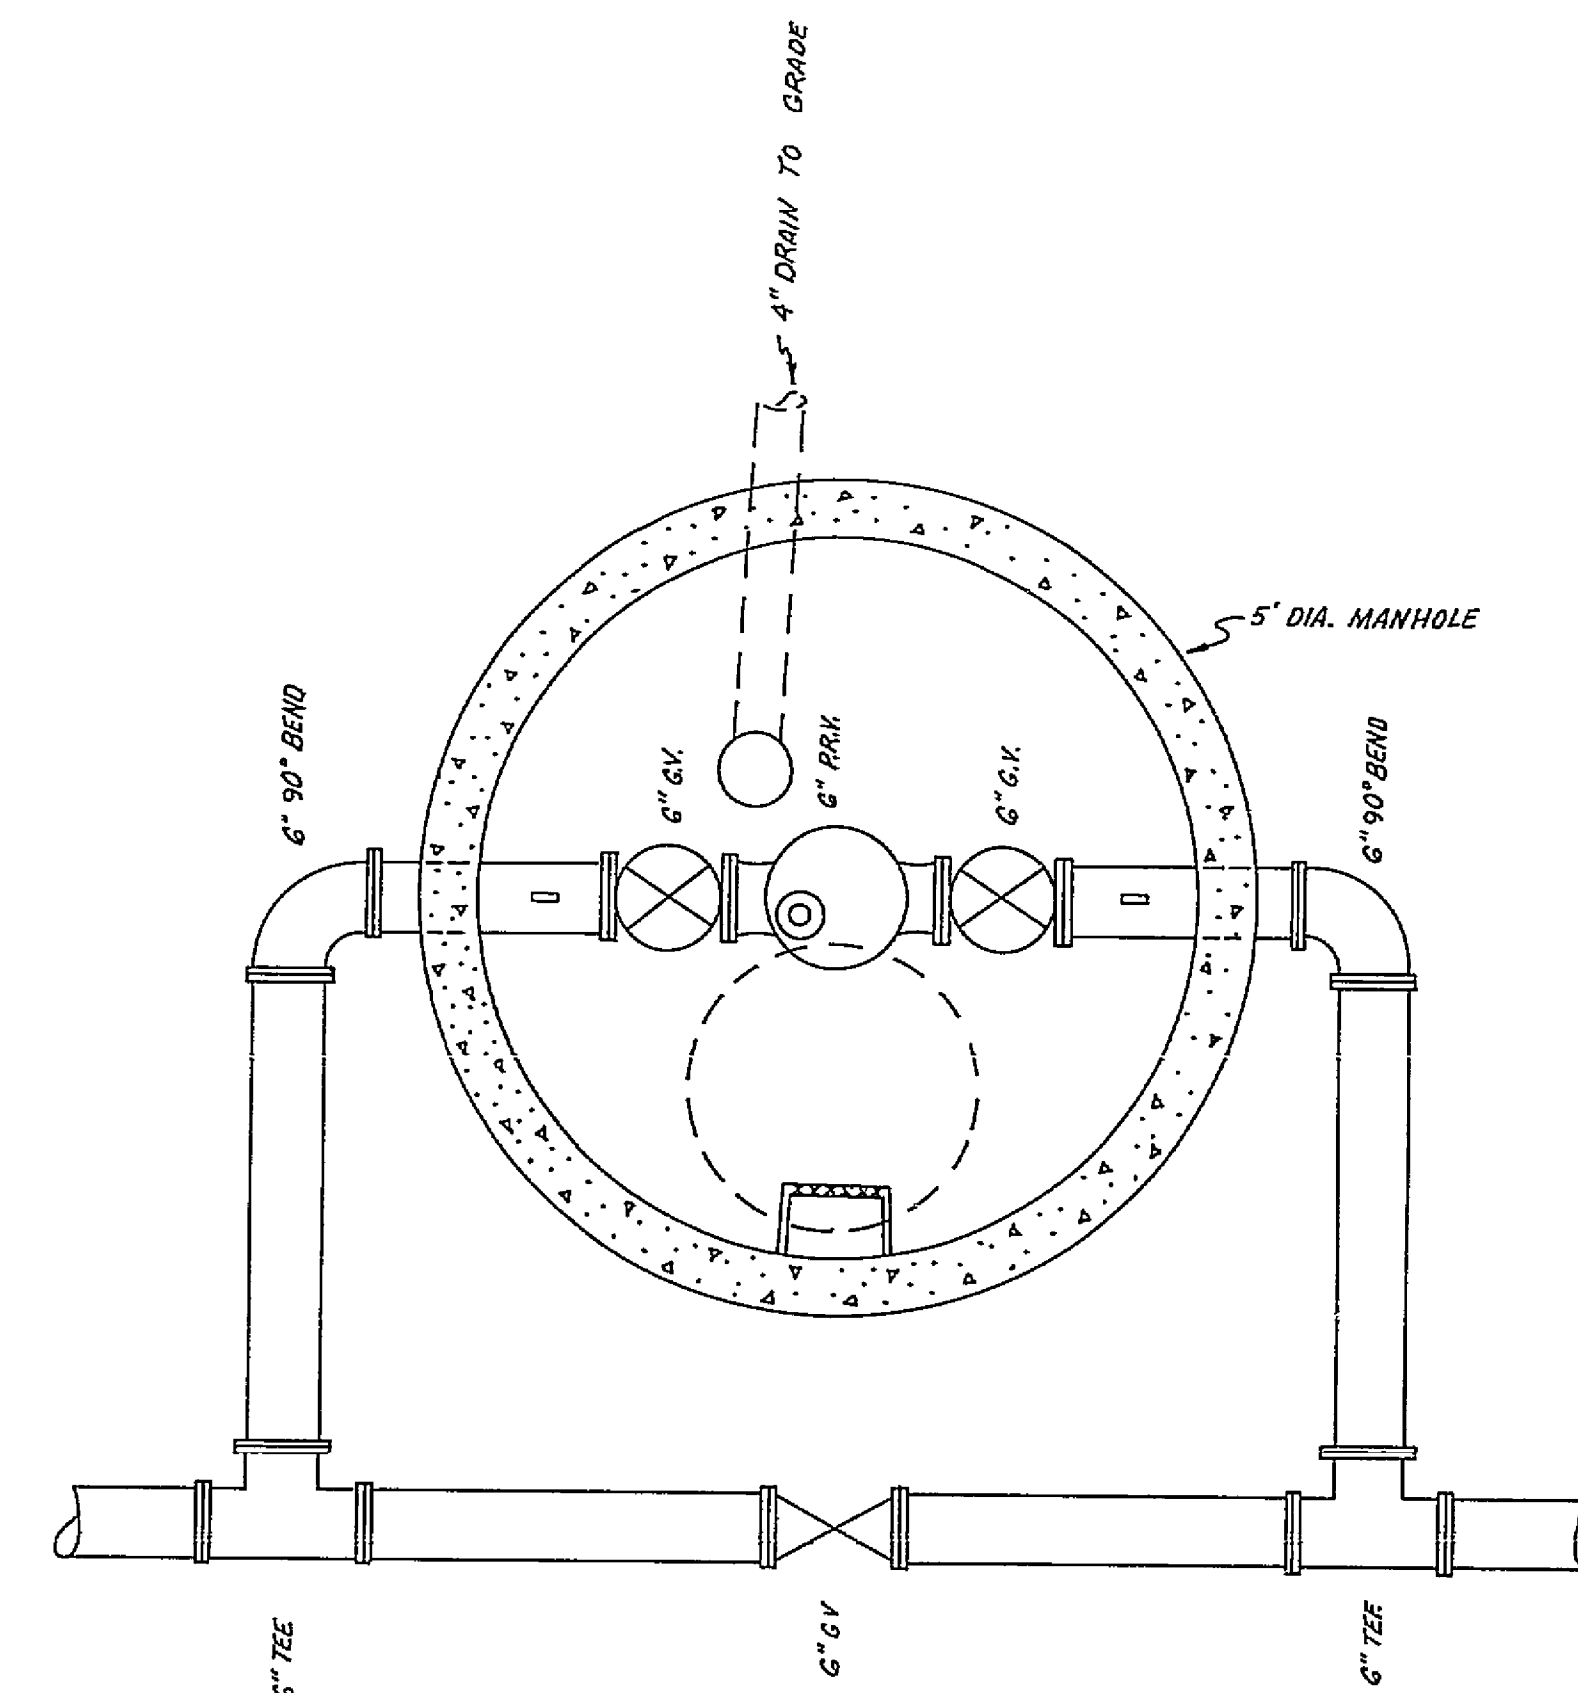

SCALE: HORZ. 1"=50' VERT. 1"=10'

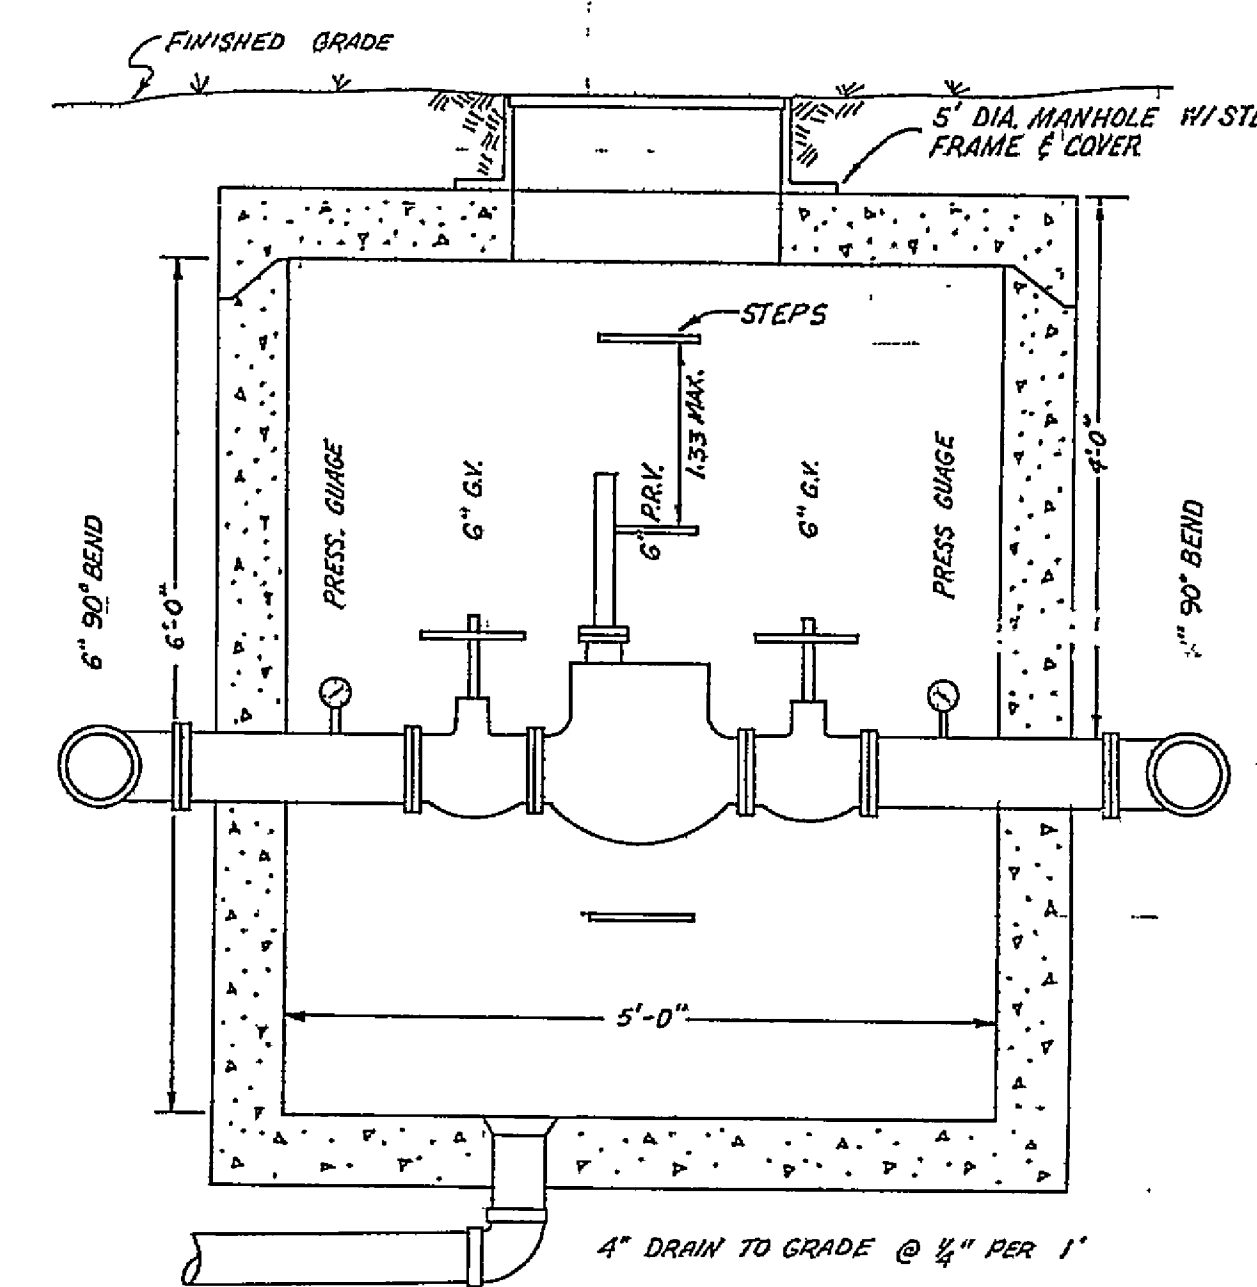

P.V. DETAIL
SCALE: 3/4"=1'-0"

ROANOKE COUNTY
UTILITY DEPARTMENT

NO.	REVISIONS	DATE

BROOKLAWN REPLACEMENT

DATE: JAN. 6, 1983
 SCALE: HORZ. 1"=50' VERT. 1"=10'
 DRAWING BY: M.A.G.
 DESIGNED BY: M.S.W.
 APPROVED BY:

PROJECT
81-11-W

SHEET
3
OF
4