




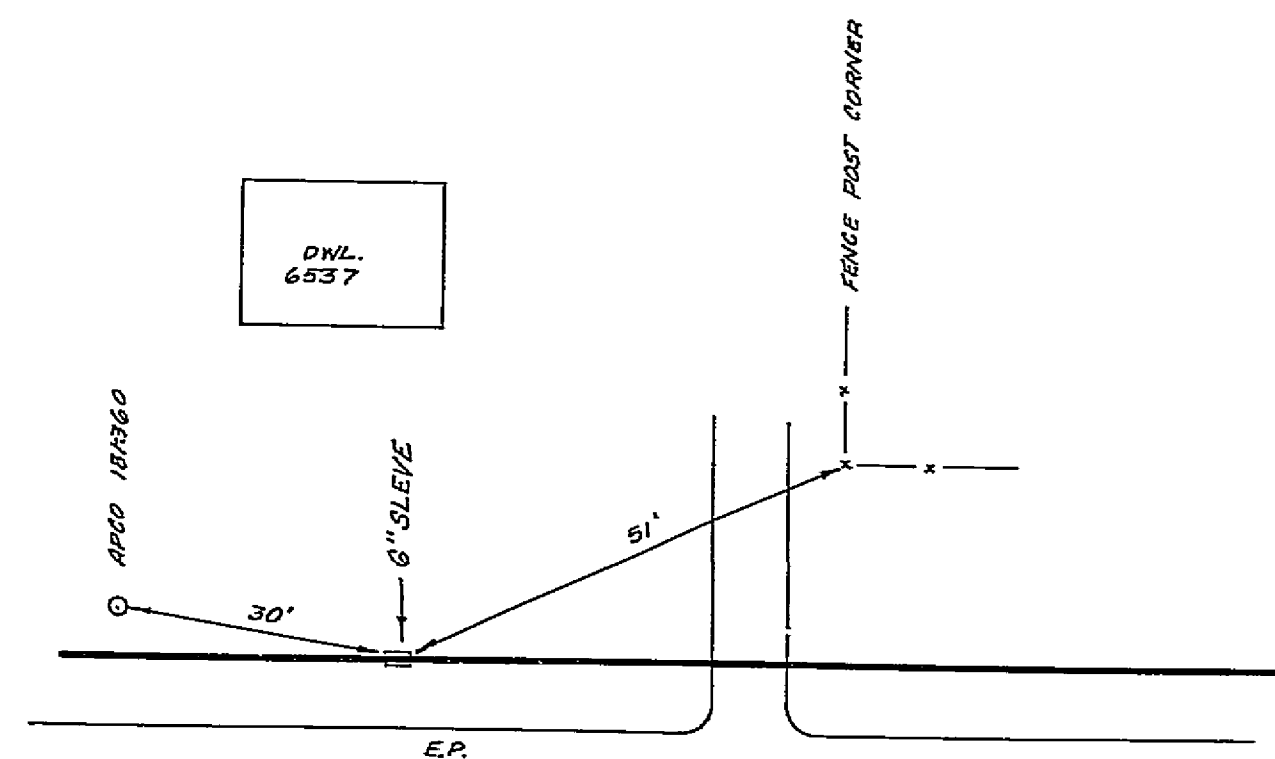


STA. 17+35
NOT TO SCALE

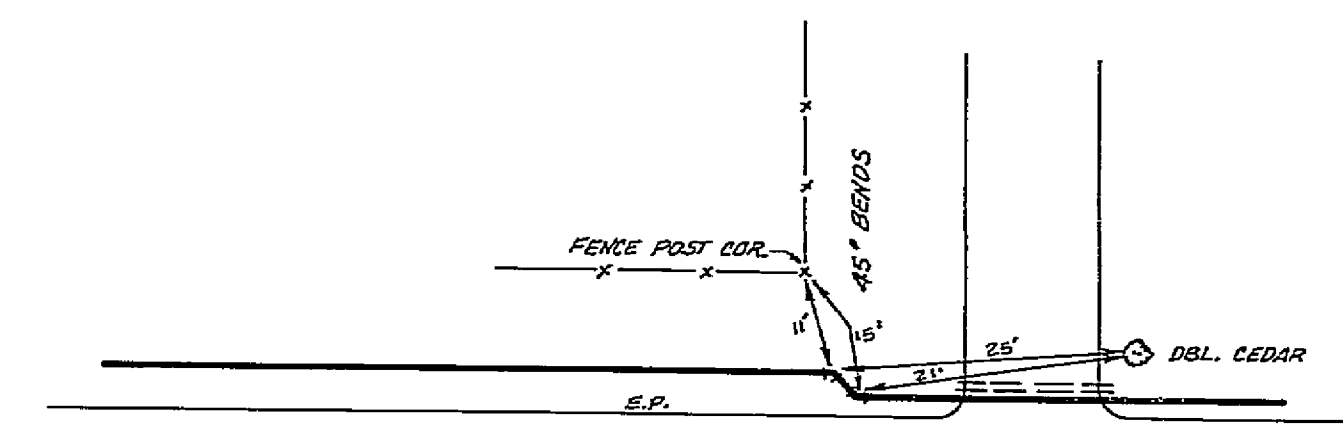


STA. 19+50
NOT TO SCALE

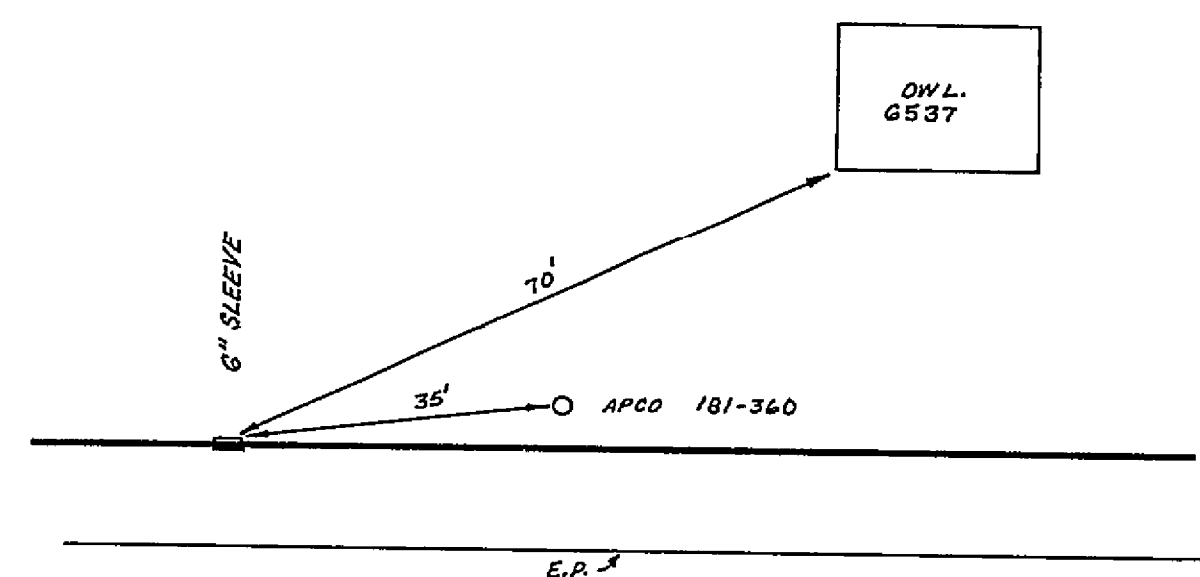


STA. 18+70
NOT TO SCALE

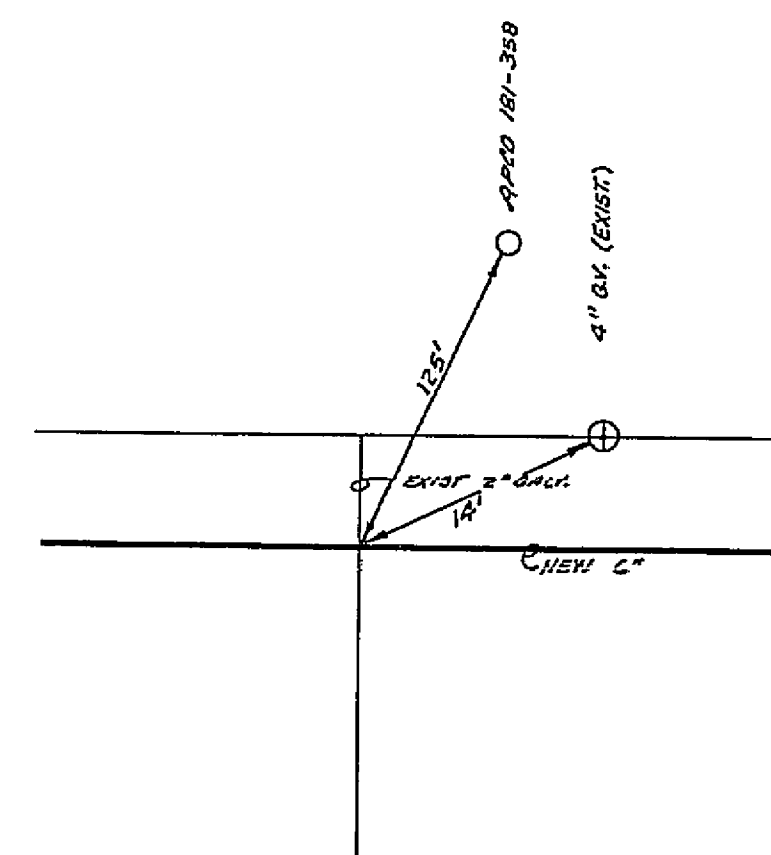


STA. 20+10
NOT TO SCALE

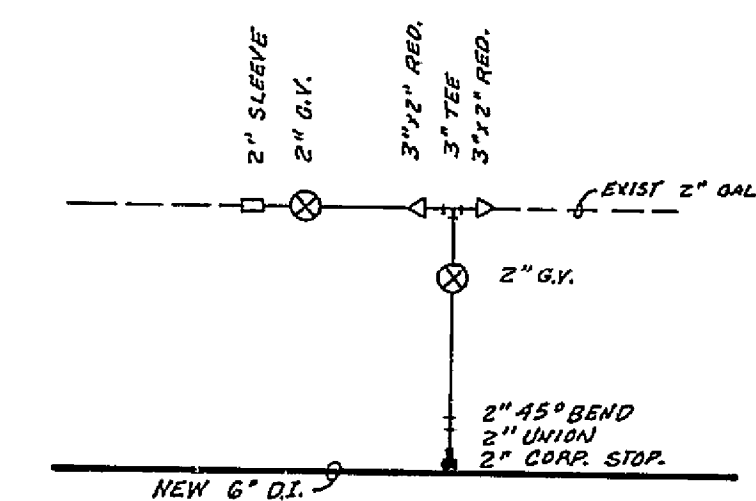

DETAIL "C"
NOT TO SCALE

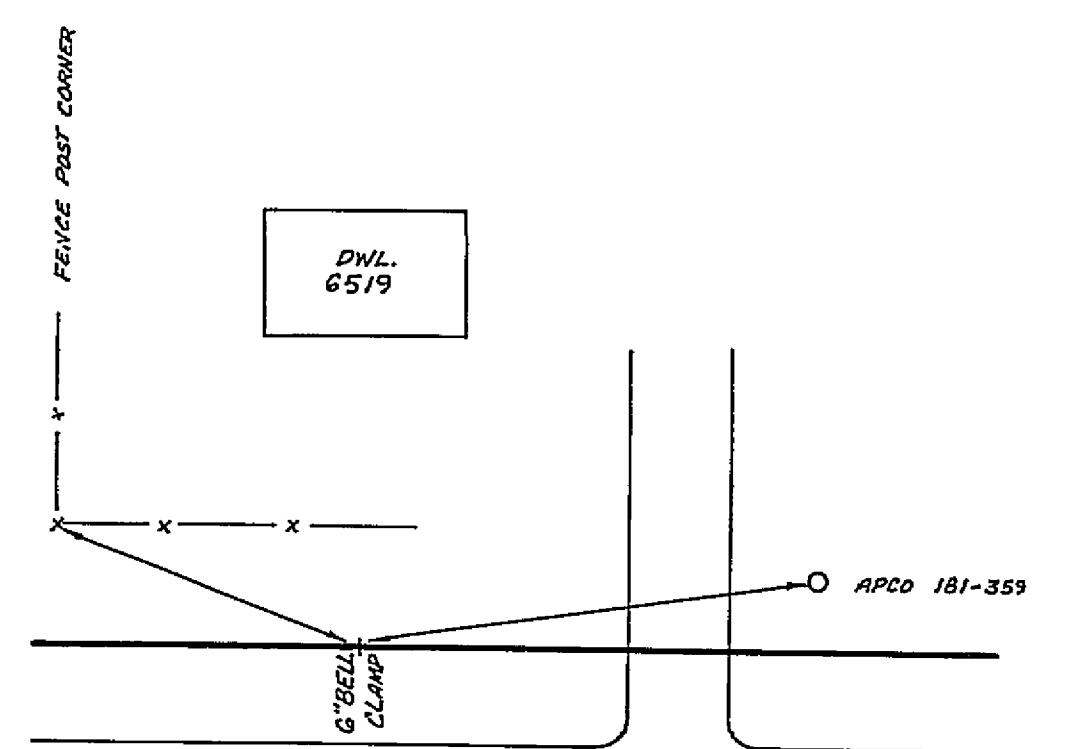

STA. 18+20
NOT TO SCALE

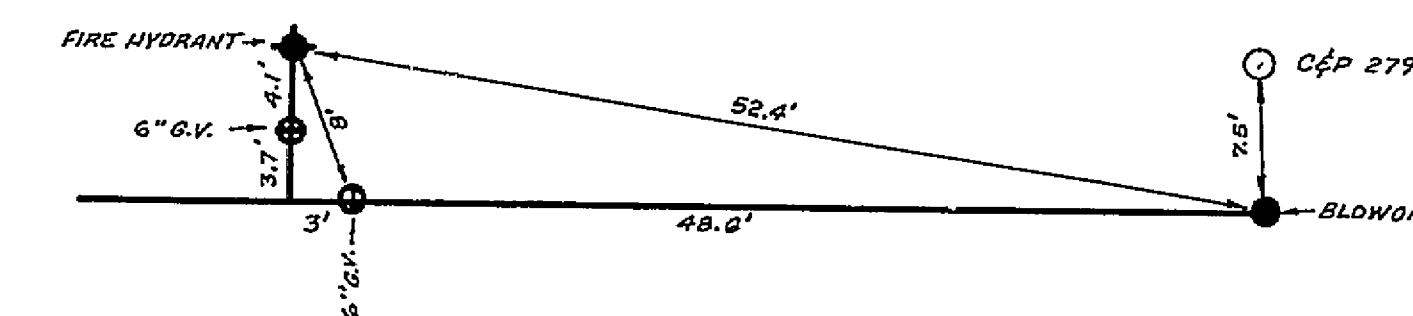

HYDRANT DETAIL
NOT TO SCALE

AS-BUILT

 ROANOKE COUNTY UTILITY DEPARTMENT	<table border="1"> <tr> <th>NO.</th> <th>REVISIONS</th> <th>DATE</th> </tr> <tr> <td> </td> <td> </td> <td> </td> </tr> </table>		NO.	REVISIONS	DATE				BROOKLAWN REPLACEMENT	DATE: APRIL 2, 1984 SCALE: AS SHOWN DRAWING BY: M.A.G. DESIGNED BY: APPROVED BY:	PROJECT 81-11-W	SHEET 34 OF 4
	NO.	REVISIONS	DATE									