


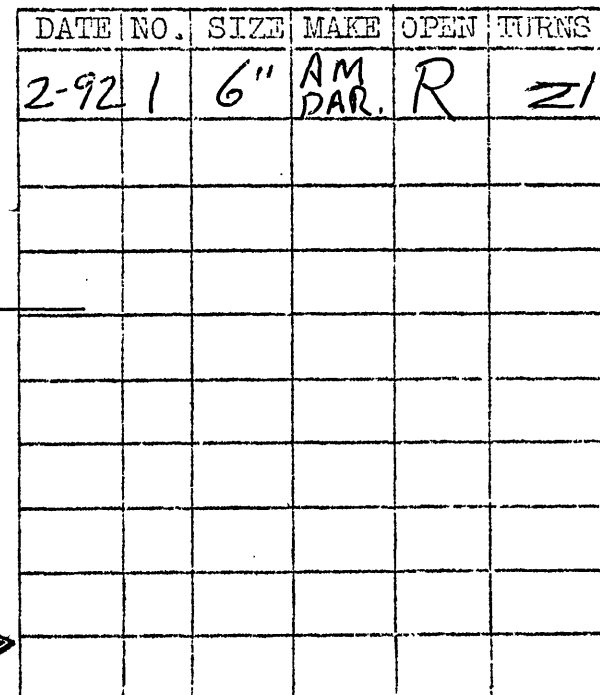

Done

BROOKS AVE (SE)

Page No.