


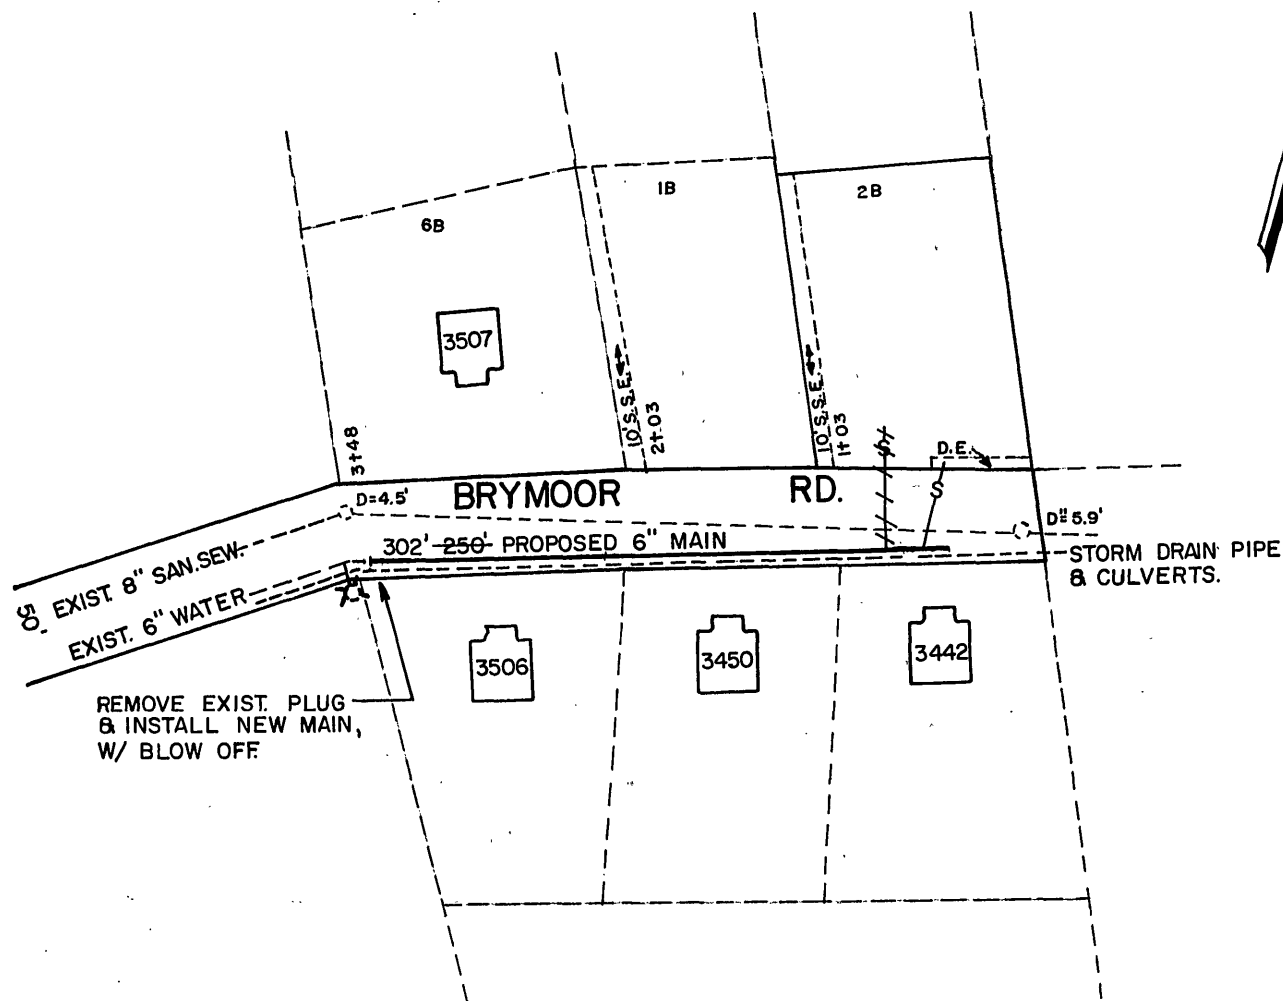

NOTE: ALL EXIST. UTILITIES SHALL
BE ASCERTAINED IN THE FIELD
PRIOR TO CONSTRUCTION.

AS-BUILT

DATE: 8-25-89				
DATE: 9-1-89				
FEET: 302'	SIZE: 6"	VALVE: 0	VAULT: 0	BOX: 0
S.H. COMP. 0				
S.H. STUB ONLY 0				
SERV. INS. BY: CALVIN O. DAME				
MAIN INS. BY: C.O.D.				
NO. 1/2" SERV. INS. 1				
CITY OR CO. CITY				
DEPT. INSP. U.L.S.				

WATER DEPARTMENT

ROANOKE

VIRGINIA

BRYMOOR ROAD, S.W.

SCALE: 1"=100'

DATE: 5/30/89

DIST. MAP: 505,507

PLAN NO.: 89-02

But B. Li 6/8/89
DIRECTOR UTILITIES & OPERATIONS DATE

W. M. McCall
DIRECTOR OF PUBLIC WORKS DATE

Jesse H. [Signature]
MANAGER UTILITY LINE SERVICES