
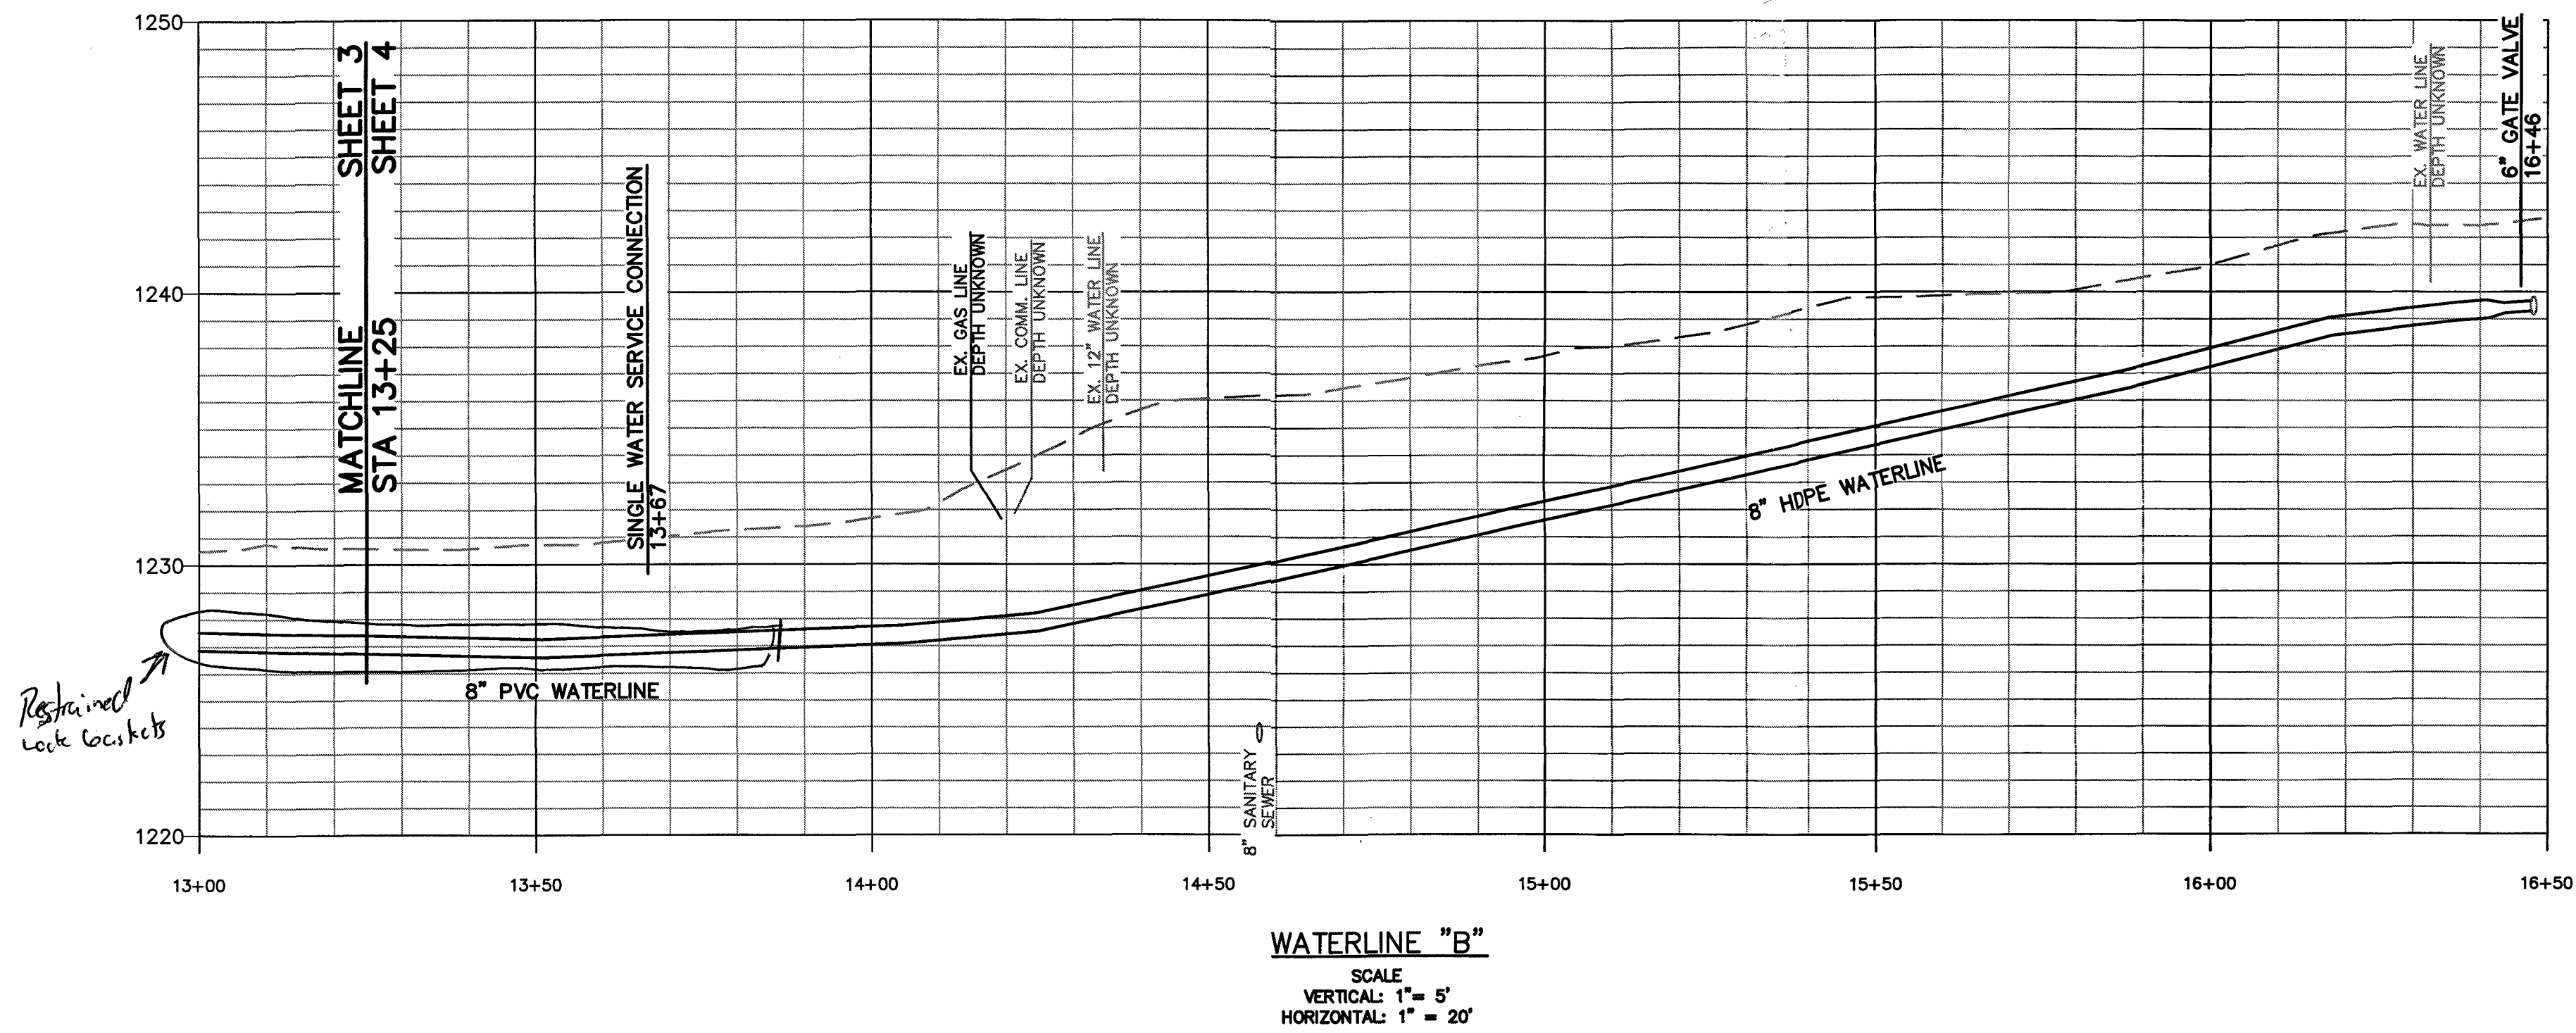


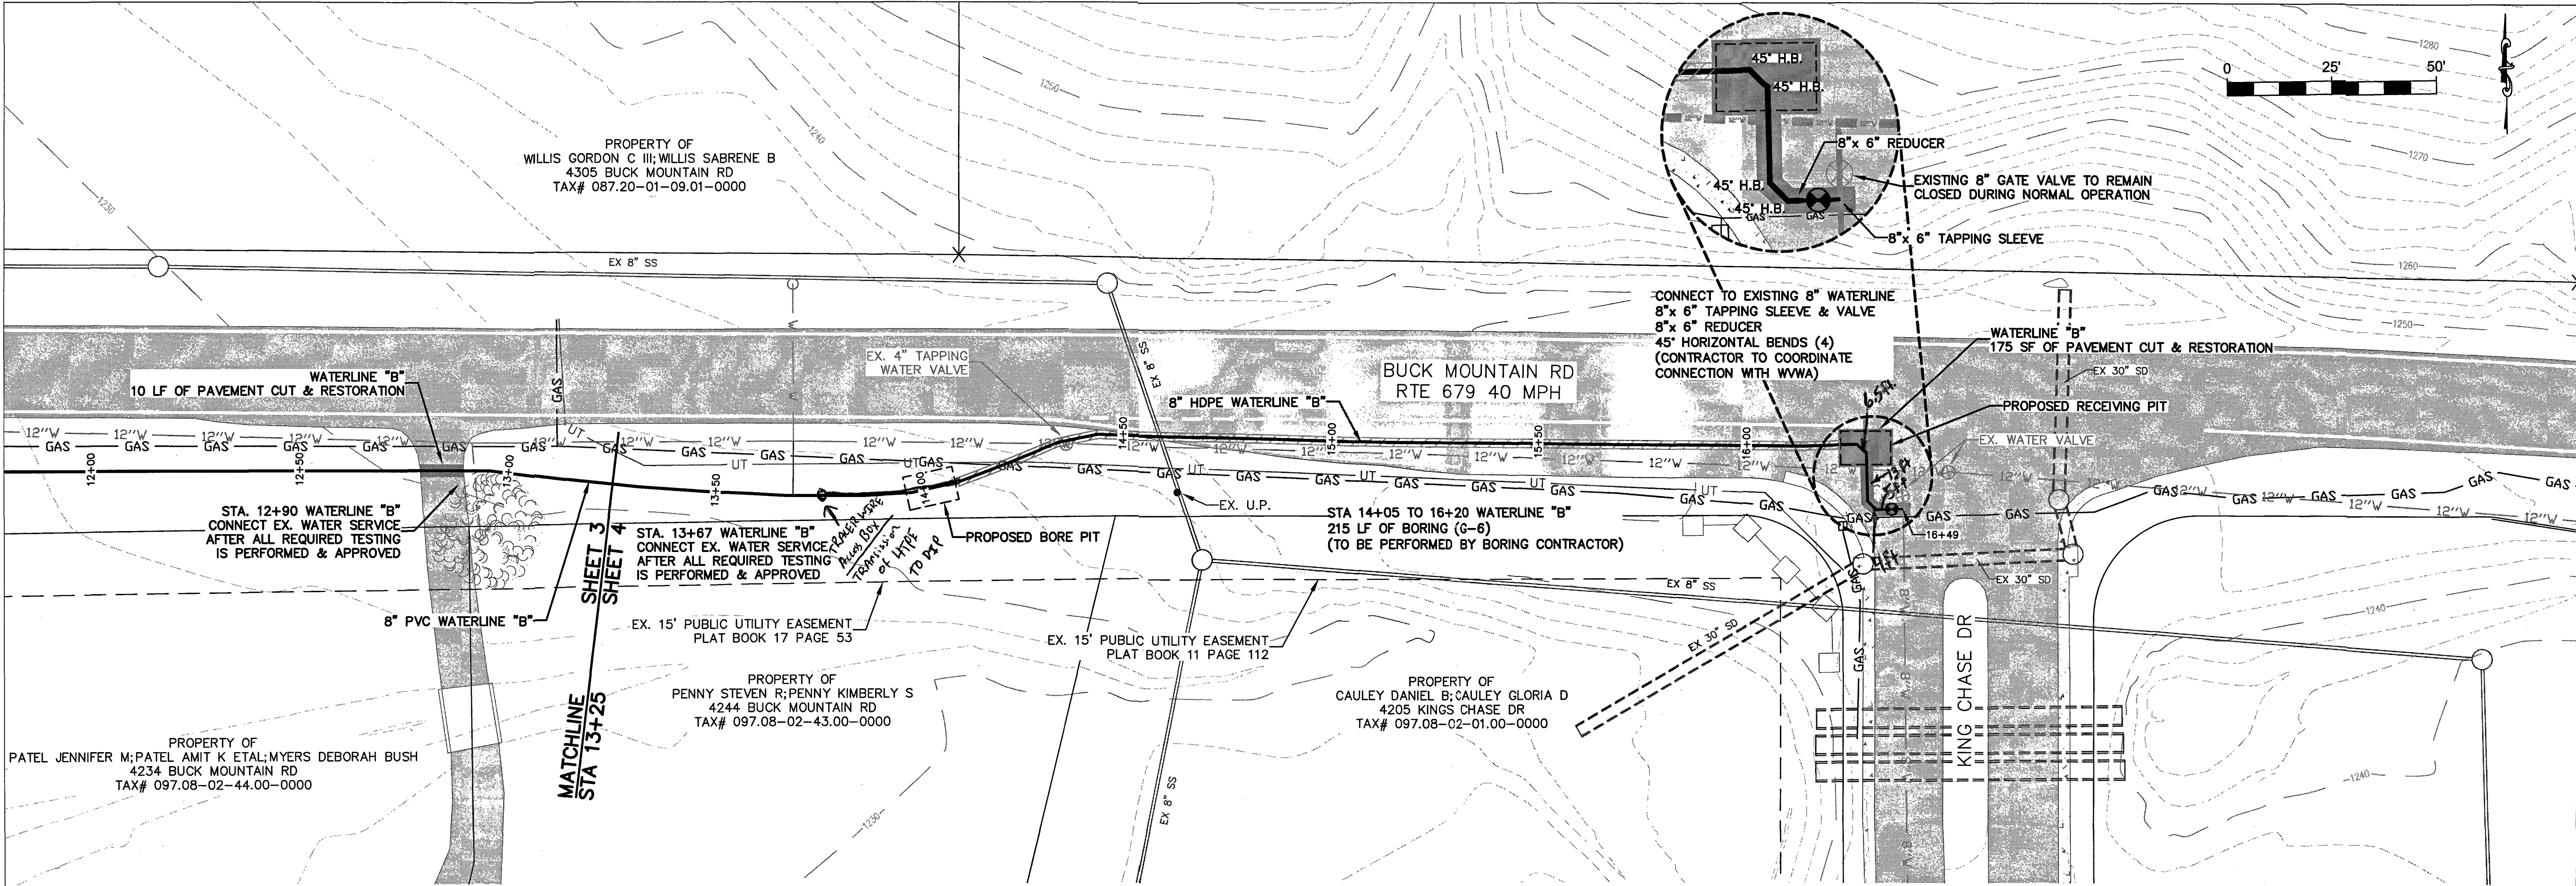

WESTERN VIRGINIA

WATER AUTHORITY

ENGINEERING SERVICES

601 S JEFFERSON ST, SUITE 300

ROANOKE, VA 24011

540-853-5641 or 540-853-5770

BUCK MOUNTAIN ROAD WATER

HGL ZONE CONNECTIONS

PLAN & PROFILE

Rev	Description	Date	By
1	REVISED PER VDOT COMMENTS 08/10/16 DRJ	08/10/16	DRJ
2	REVISED PER WNR REDLINES 09/27/16 DRJ	09/27/16	DRJ

Designed:

Drawn: DRJ

Checked: AAS

Approved:

Date: 07/13/16

Project:

4

Sheet 4 of 8