


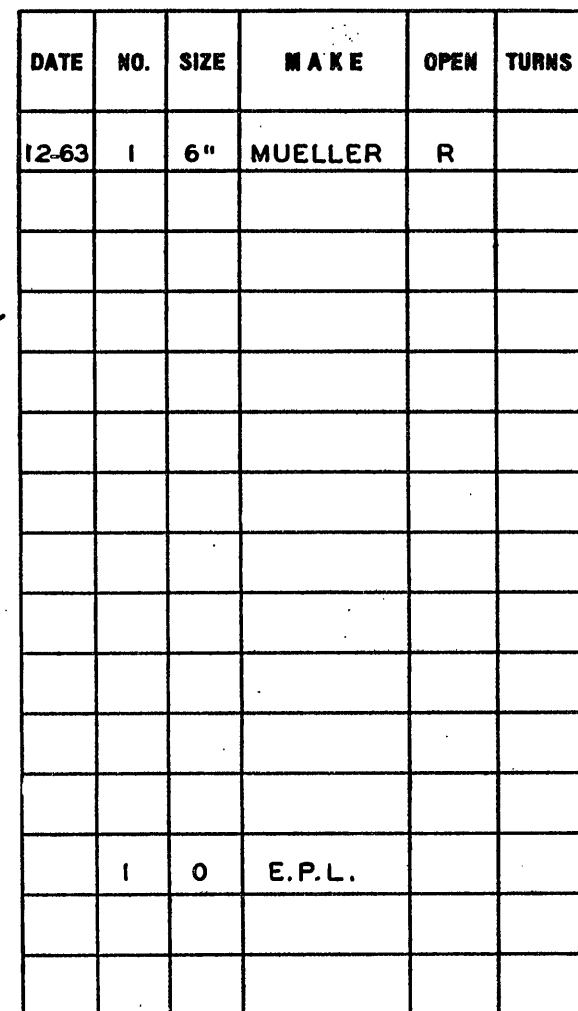

**PAGE NO.**