








REVISIONS

(540) 966-3027 TEL
(540) 966-5906 FAX
e-mail: rp1erson@rbnet.com

GRADING SHEET

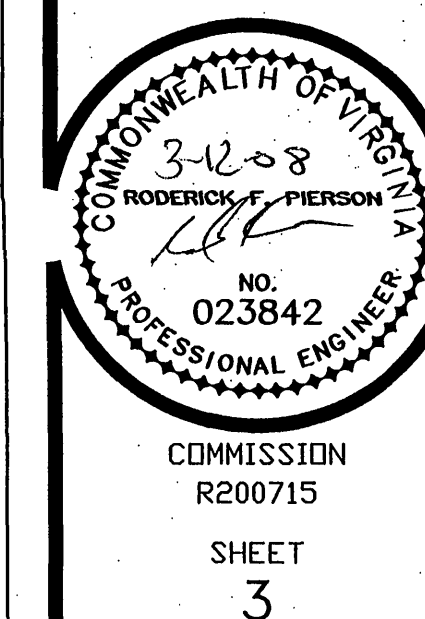


COURSE	BEARING	DISTANCE
L1	N 11°23'41"W	19.68'
L2	N 37°00'14"W	24.73'

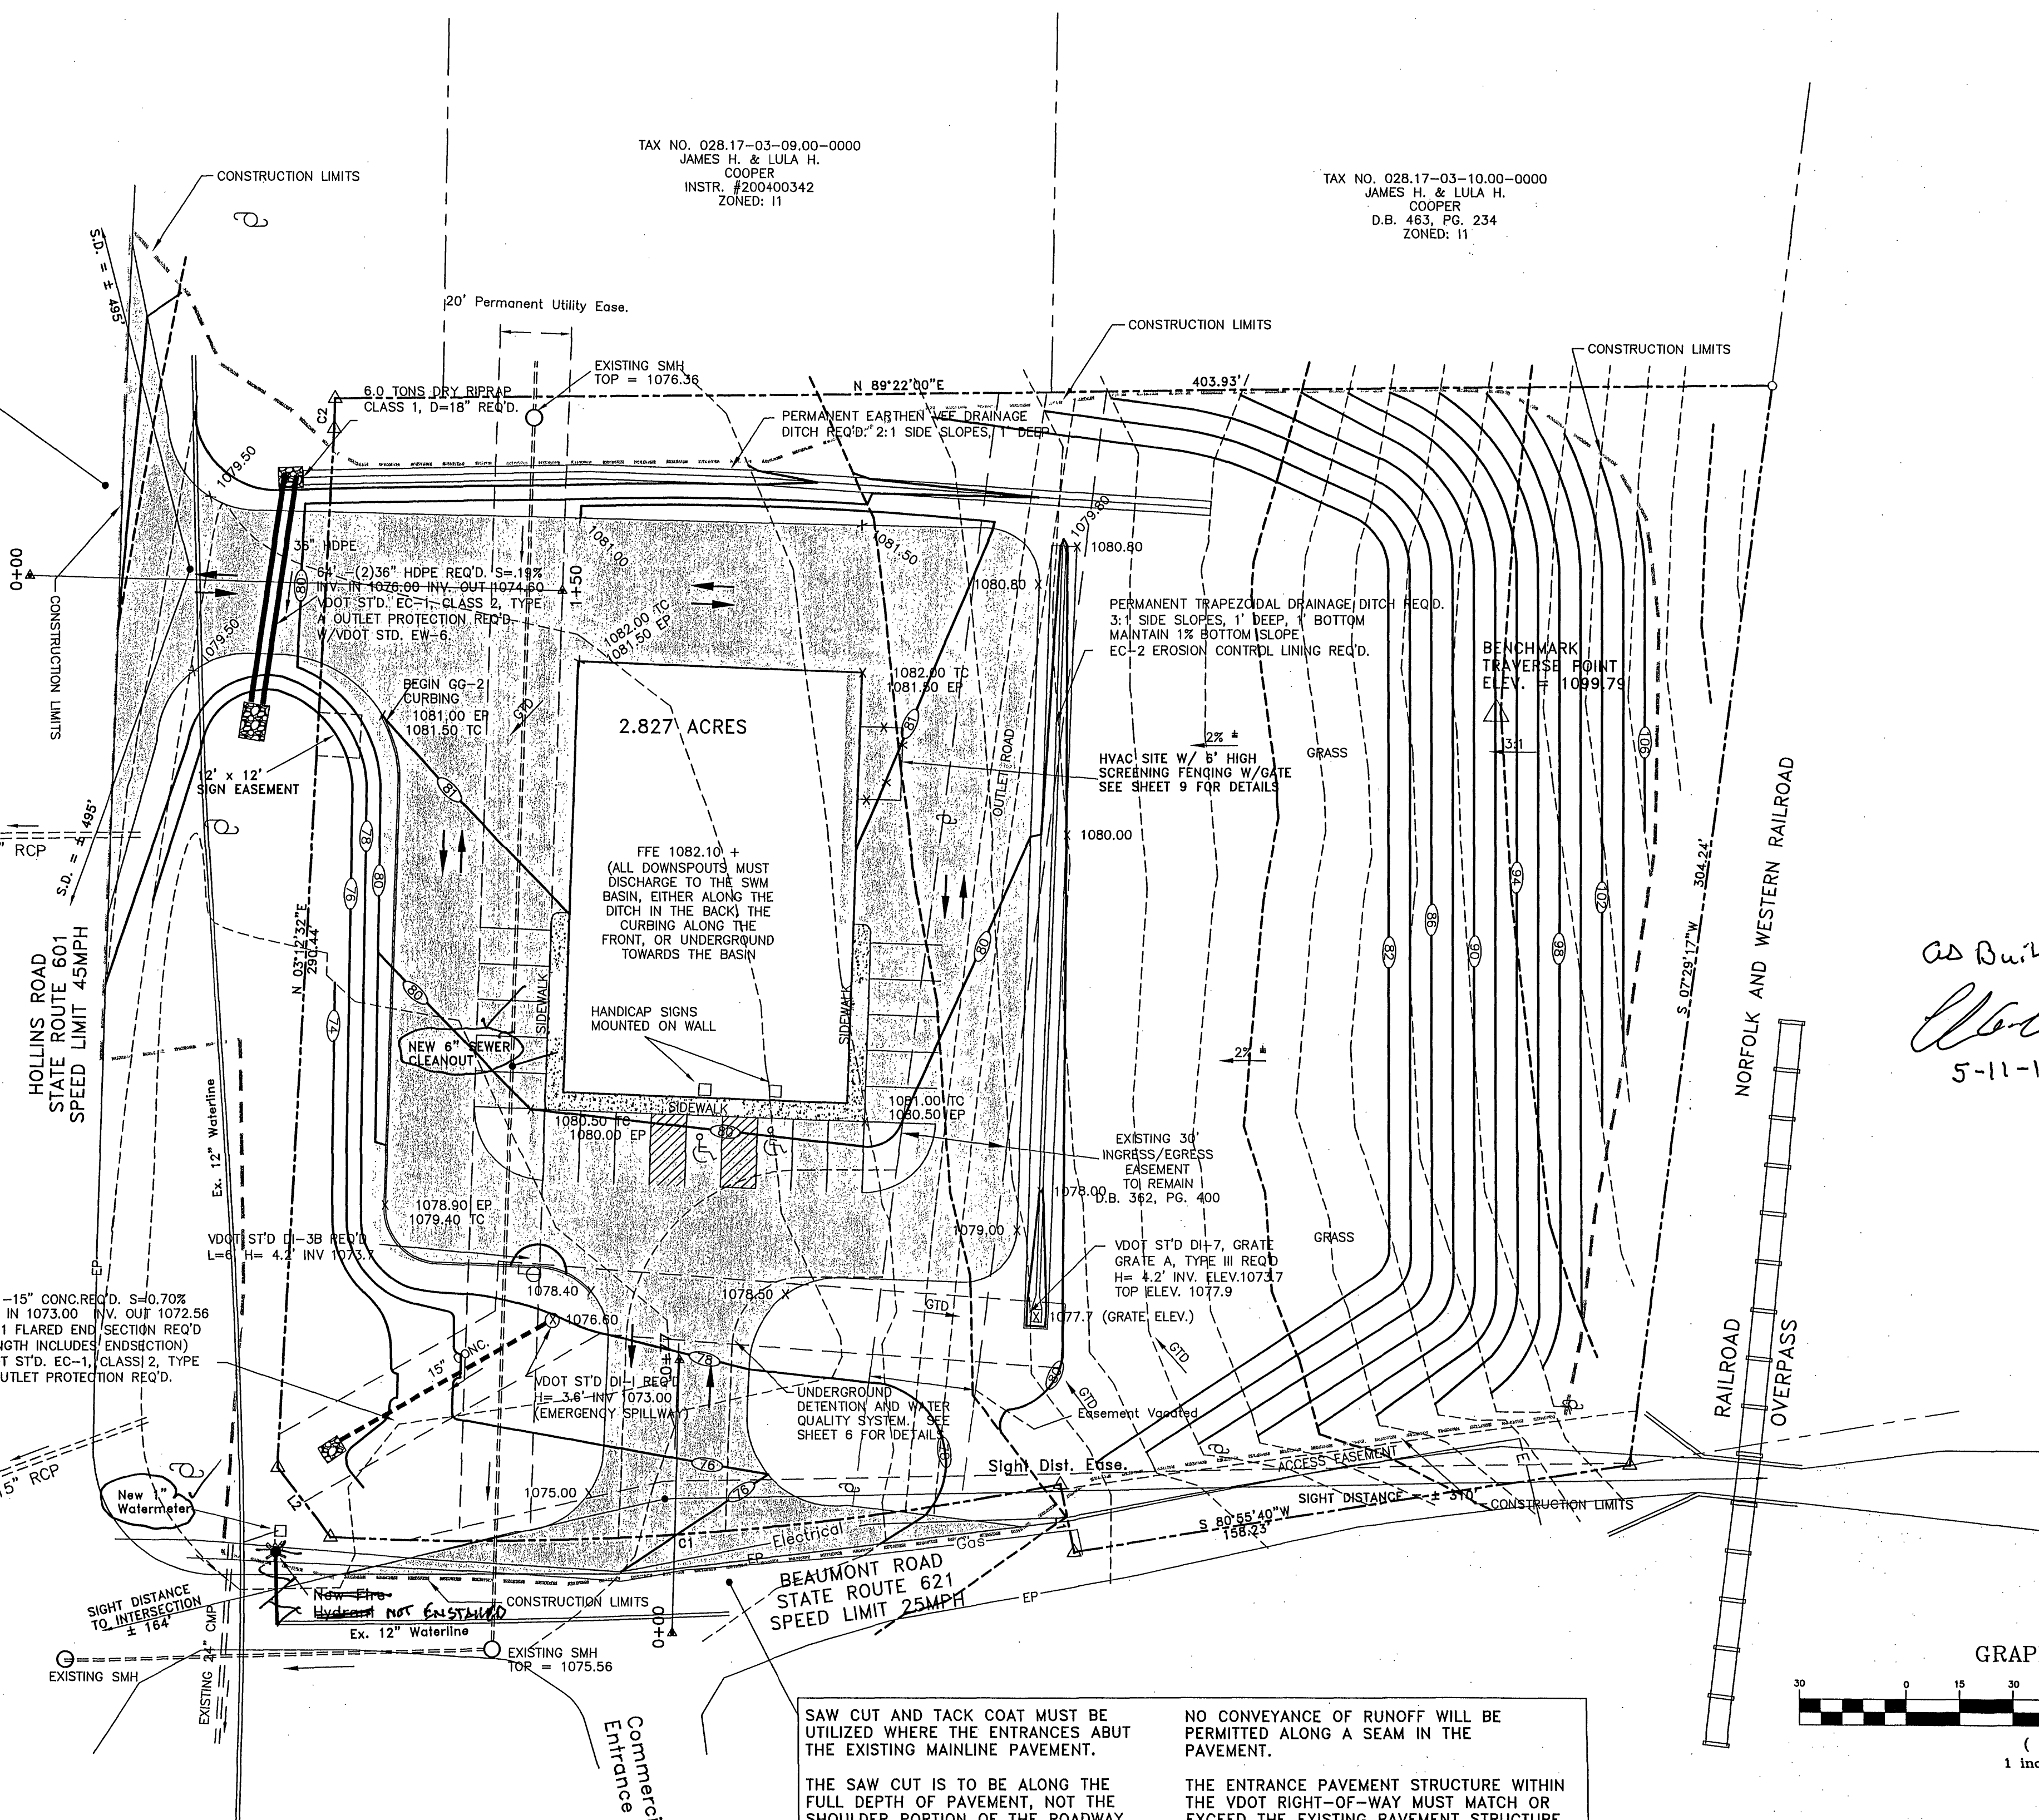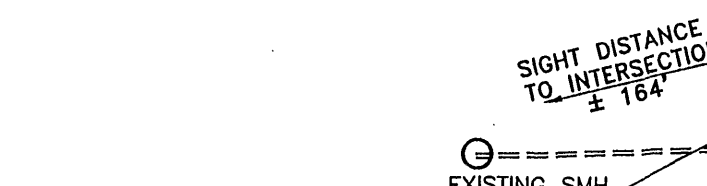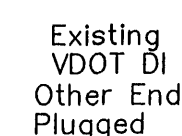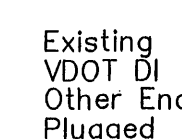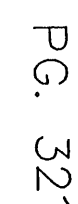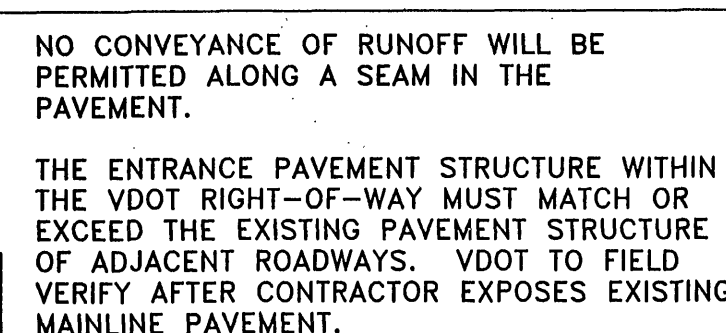

As Built
[Signature]
5-11-12

APPROVED

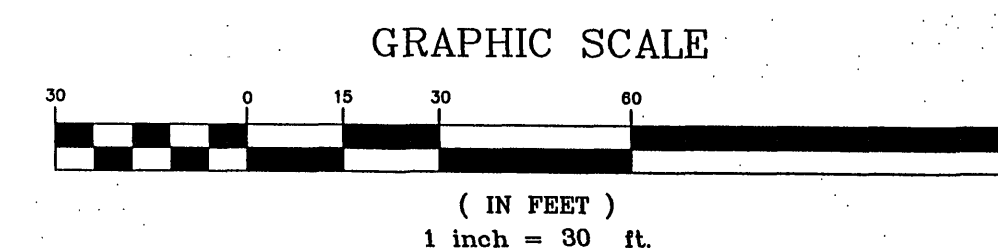

NO CONVEYANCE OF RUNOFF WILL BE PERMITTED ALONG A SEAM IN THE PAVEMENT.

THE ENTRANCE PAVEMENT STRUCTURE WITHIN THE VDOT RIGHT-OF-WAY MUST MATCH OR EXCEED THE EXISTING PAVEMENT STRUCTURE OF ADJACENT ROADWAYS. VDOT TO FIELD VERIFY AFTER CONTRACTOR EXPOSES EXISTING MAINLINE PAVEMENT.