




1. THE HORIZONTAL AND VERTICAL DATUM SHOWN ON THIS PLAT WERE TAKEN FROM AND ARE ORIENTED TO A PLAN BY KIMLEY-HORN AND ASSOCIATES, INC.
2. THIS PLAT IS NOT FOR RECORDEDATION.
3. THIS PLAT SHOWS THE AS-BUILT LOCATIONS AND ELEVATIONS OF FORM SEWER STRUCTURES. ALL OTHER IMPROVEMENTS SHOWN ARE NOT CERTIFIED TO BY THIS SURVEYOR AND ARE SHOWN FOR INFORMATIONAL PURPOSES ONLY.
4. THE INVERT OUT ELEVATION ON THE FILTERRA UNIT COULD NOT BE DETERMINED BECAUSE THE FILTER MATERIAL HAS ALREADY BEEN INSTALLED IN THE UNIT.
5. THE INVERT ELEVATIONS ON THE PIPES ENTERING THE RAIN TANK COULD NOT BE DETERMINED THIS DATE. IN ORDER TO DETERMINE THE ELEVATIONS THE PARKING LOT ABOVE THE EXISTING PIPES WILL NEED TO BE EXCAVATED.
6. THE WATERLINE SHOWN ON THIS AS BUILT PLAT WAS SCALED FROM SHEET CU-01 OF THE SITE CONSTRUCTION PLANS. NO WATERLINE FEATURES WERE LOCATED IN THE FIELD BY ACRES OF VIRGINIA, INC. AND NO CERTIFICATION IS MADE BY THIS SURVEYOR TO THE LOCATION OF THE WATERLINE SHOWN ON THIS AS BUILT PLAT.

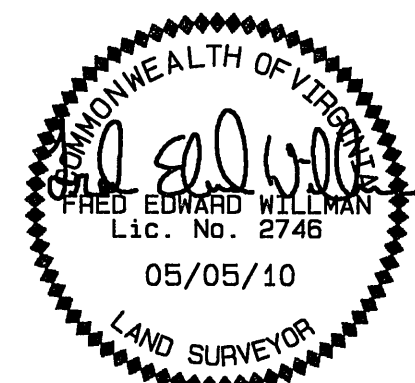

ENGINEERS~SURVEYORS~PLANNERS
ENVIRONMENTAL~SOIL CONSULTANTS~GEOTECHNICAL
email: Serca2@aol.com
www.acresofvirginia.com

LYNCHBURG OFFICE:
404 CLAY STREET
LYNCHBURG, VA. 24504
OFFICE (434) 528-4674
FAX (434) 845-1048



AMHERST OFFICE:
SURVEYING AND PLANNING
357 SOUTH MAIN STREET
AMHERST, VA. 24521
OFFICE (434) 946-5544

TO DATE AS-BUILT LOCATIONS AND ELEVATIONS
OF STORM SEWER STRUCTURES AND

CVS

COUNTY OF ROANOKE, VIRGINIA

SCALE: 1"=20' DATE: APRIL 12, 2010 REV: APRIL 15, 2010
COMM. NO. 09960/A9960ASBULT-SERVER-NEWJ0852009 REV: APRIL 29, 2010
COPYRIGHT© REV: MAY 5, 2010