


COORDINATE TABLE			
POINT #	NORTHING	EASTING	ELEVATION
W1	3616657.84	11057968.48	992.32
W2	3616647.65	11057971.91	992.40
W3	3616653.21	11057979.50	992.32
W4	3616606.48	11057926.94	992.29
W5	3616942.51	11057839.26	992.64
W6	3616948.22	11057839.41	992.60
W7	3617076.64	11057598.29	993.43
W8	3617074.17	11057593.67	993.35
W9	3616645.40	11057979.24	993.45

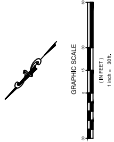

MISCELLANEOUS SITE NOTES

7. THE ACCESS POINTS SHALL BE INSTALLED TO PROVIDE CONNECTIVITY TO ALL RAIL LINE AND TRANSFER STATIONS.
8. THE ACCESS POINTS SHALL BE INSTALLED TO PROVIDE CONNECTIVITY TO ALL RAIL LINE AND TRANSFER STATIONS.
9. THE ACCESS POINTS SHALL BE INSTALLED TO PROVIDE CONNECTIVITY TO ALL RAIL LINE AND TRANSFER STATIONS.
10. THE ACCESS POINTS SHALL BE INSTALLED TO PROVIDE CONNECTIVITY TO ALL RAIL LINE AND TRANSFER STATIONS.
11. THE ACCESS POINTS SHALL BE INSTALLED TO PROVIDE CONNECTIVITY TO ALL RAIL LINE AND TRANSFER STATIONS.
12. THE ACCESS POINTS SHALL BE INSTALLED TO PROVIDE CONNECTIVITY TO ALL RAIL LINE AND TRANSFER STATIONS.
13. THE ACCESS POINTS SHALL BE INSTALLED TO PROVIDE CONNECTIVITY TO ALL RAIL LINE AND TRANSFER STATIONS.
14. THE ACCESS POINTS SHALL BE INSTALLED TO PROVIDE CONNECTIVITY TO ALL RAIL LINE AND TRANSFER STATIONS.
15. THE ACCESS POINTS SHALL BE INSTALLED TO PROVIDE CONNECTIVITY TO ALL RAIL LINE AND TRANSFER STATIONS.

FIRE MARSHALL REQUIREMENTS

- [illegible]

UTILITY CONNECTION NOTES

- NO NEW SANITARY CONNECTIONS SHOULD BE CUT INTO EXISTING LATERALS TO REMAIN.
- EXISTING INCH-TO-METER AND DOMESTIC SERVICE TO REMAIN. EXISTING INTAKE RETURNS UNCHANGED.
- EXISTING CONNECTIONS SHALL CONNECT WATER AT ITS OFFICE IN MAIN DRAIN.
- ANY CUTTING WATER ON SEWER CONNECTIONS SERVING THE PROPERTY NOT UTILIZED FOR THE DEVELOPMENT SHALL BE ABANDONED AT THE MAIN BY THE DEVELOPER.
- ANY EXISTING SUMP PUMP CONNECTIONS OR OTHER SOURCES OF GROUNDWATER COLLECTION NEED SUBJECT TO THE SANITARY ENGINEER'S REVIEW SHALL BE DISCONNECTED.
- SEWAGE AND WASTEWATER OUTSIDE THE HIGHWAY ARE PUBLIC UTILITIES OUTSIDE THE HIGHWAY ARE PRIVATE.

WATERLINE LEGEND:

- [illegible]

STRIPPING & STORAGE LEGEND

STR	4" WHITE STRIPING, (TYP.)
ADA	HANDICAP STRIPING, (TYP.)
HC	"VAN ACCESSIBLE" ADA ACCESSIBLE 12" W/ WALL MOUNTED.



parker
DESIGN GROUP
INTEGRATED DESIGN SERVICES
ARCHITECTS • ENGINEERS • INTERIORS

2122 Carolyn Ave. SW
Reno, NV 24014
(540)-385-1153

1915-B W. Cary Street
Richmond, VA 23220
(804)-359-2947

www.parkergroup.com

These documents are the property of Parker Design Group (PDG) and may not be reproduced without the express written consent of PDG. Any reuse of these documents without the authorization of PDG is strictly prohibited and is subject to legal action and damages.

SELF-STORAGE
CLIN ROAD, SW.
WEA AS-BUILTS

REVISIONS	STATIONED BY	JDE
	DRAWN BY	KBM
	CHECKED BY	JDE
	SCALE	1" = 30'
	DATE	APRIL 17, 2023
	PROJECT NUMBER	21-0225
	SHEET TITLE	AS-BUILT PLANS

AB1

