


AVE.

FRANTZ ST. PERM. VACATED
- PER ORD. N° 28235, 7/28/86
D.B. 1569, PG. 1782

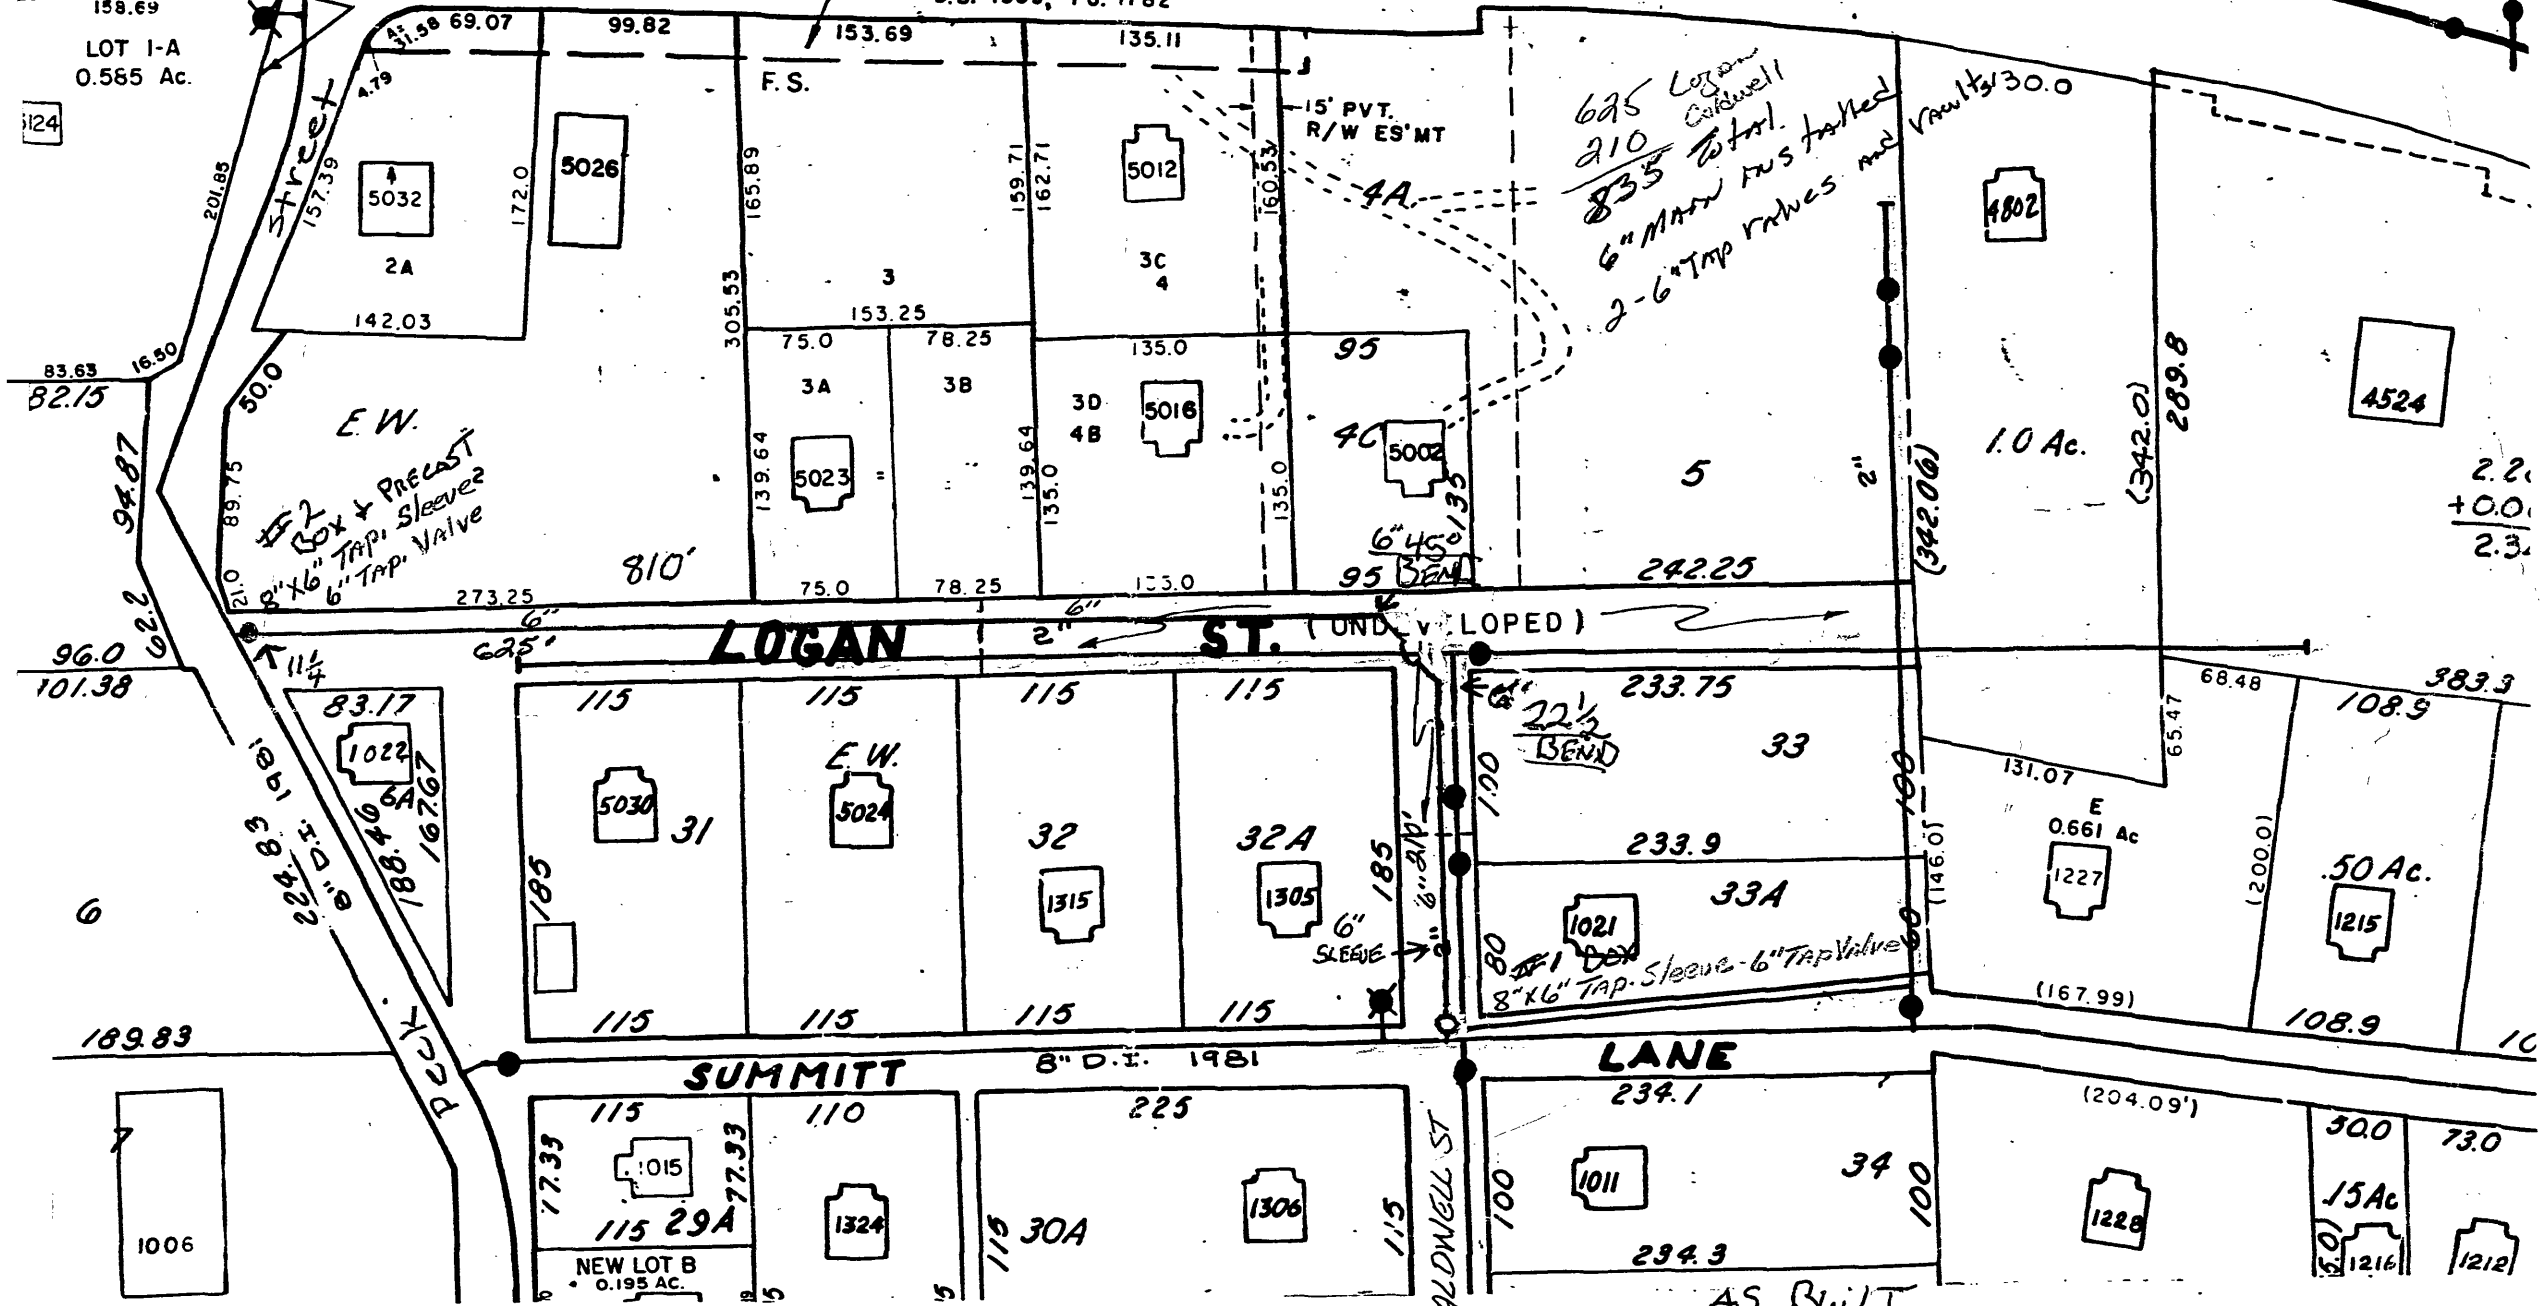

AS BUILT
9-8-95

Water Dept # 95-07