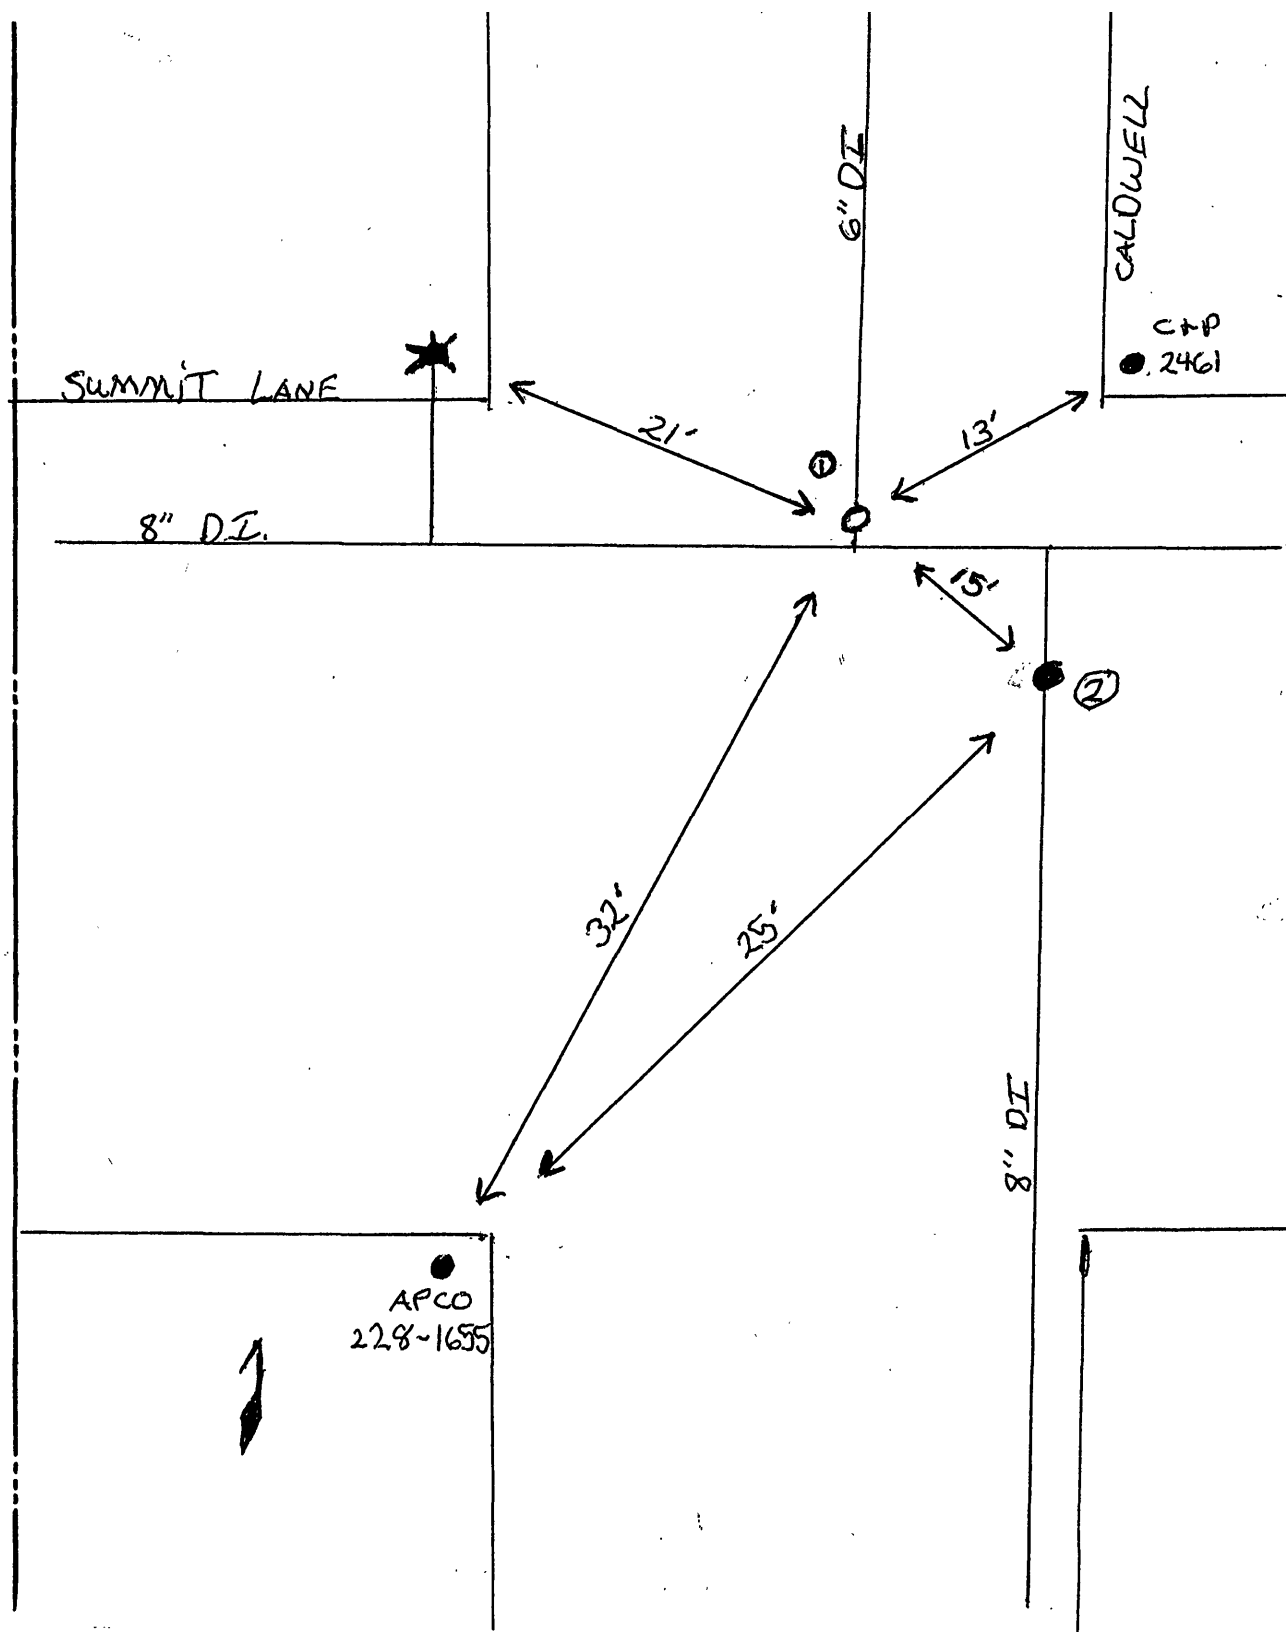


[illegible]

CITY OF ROANOKE—WATER DEPT	
VALVE DIAGRAM	
CALDWELL & SUMMIT LA.	
NW	
SEC. MAP	609
DATE	PAGE NO.