


- ### VAULT & WATER STANDARDS FOR CONSTRUCTION



- APPROVED
JAN 19 2010

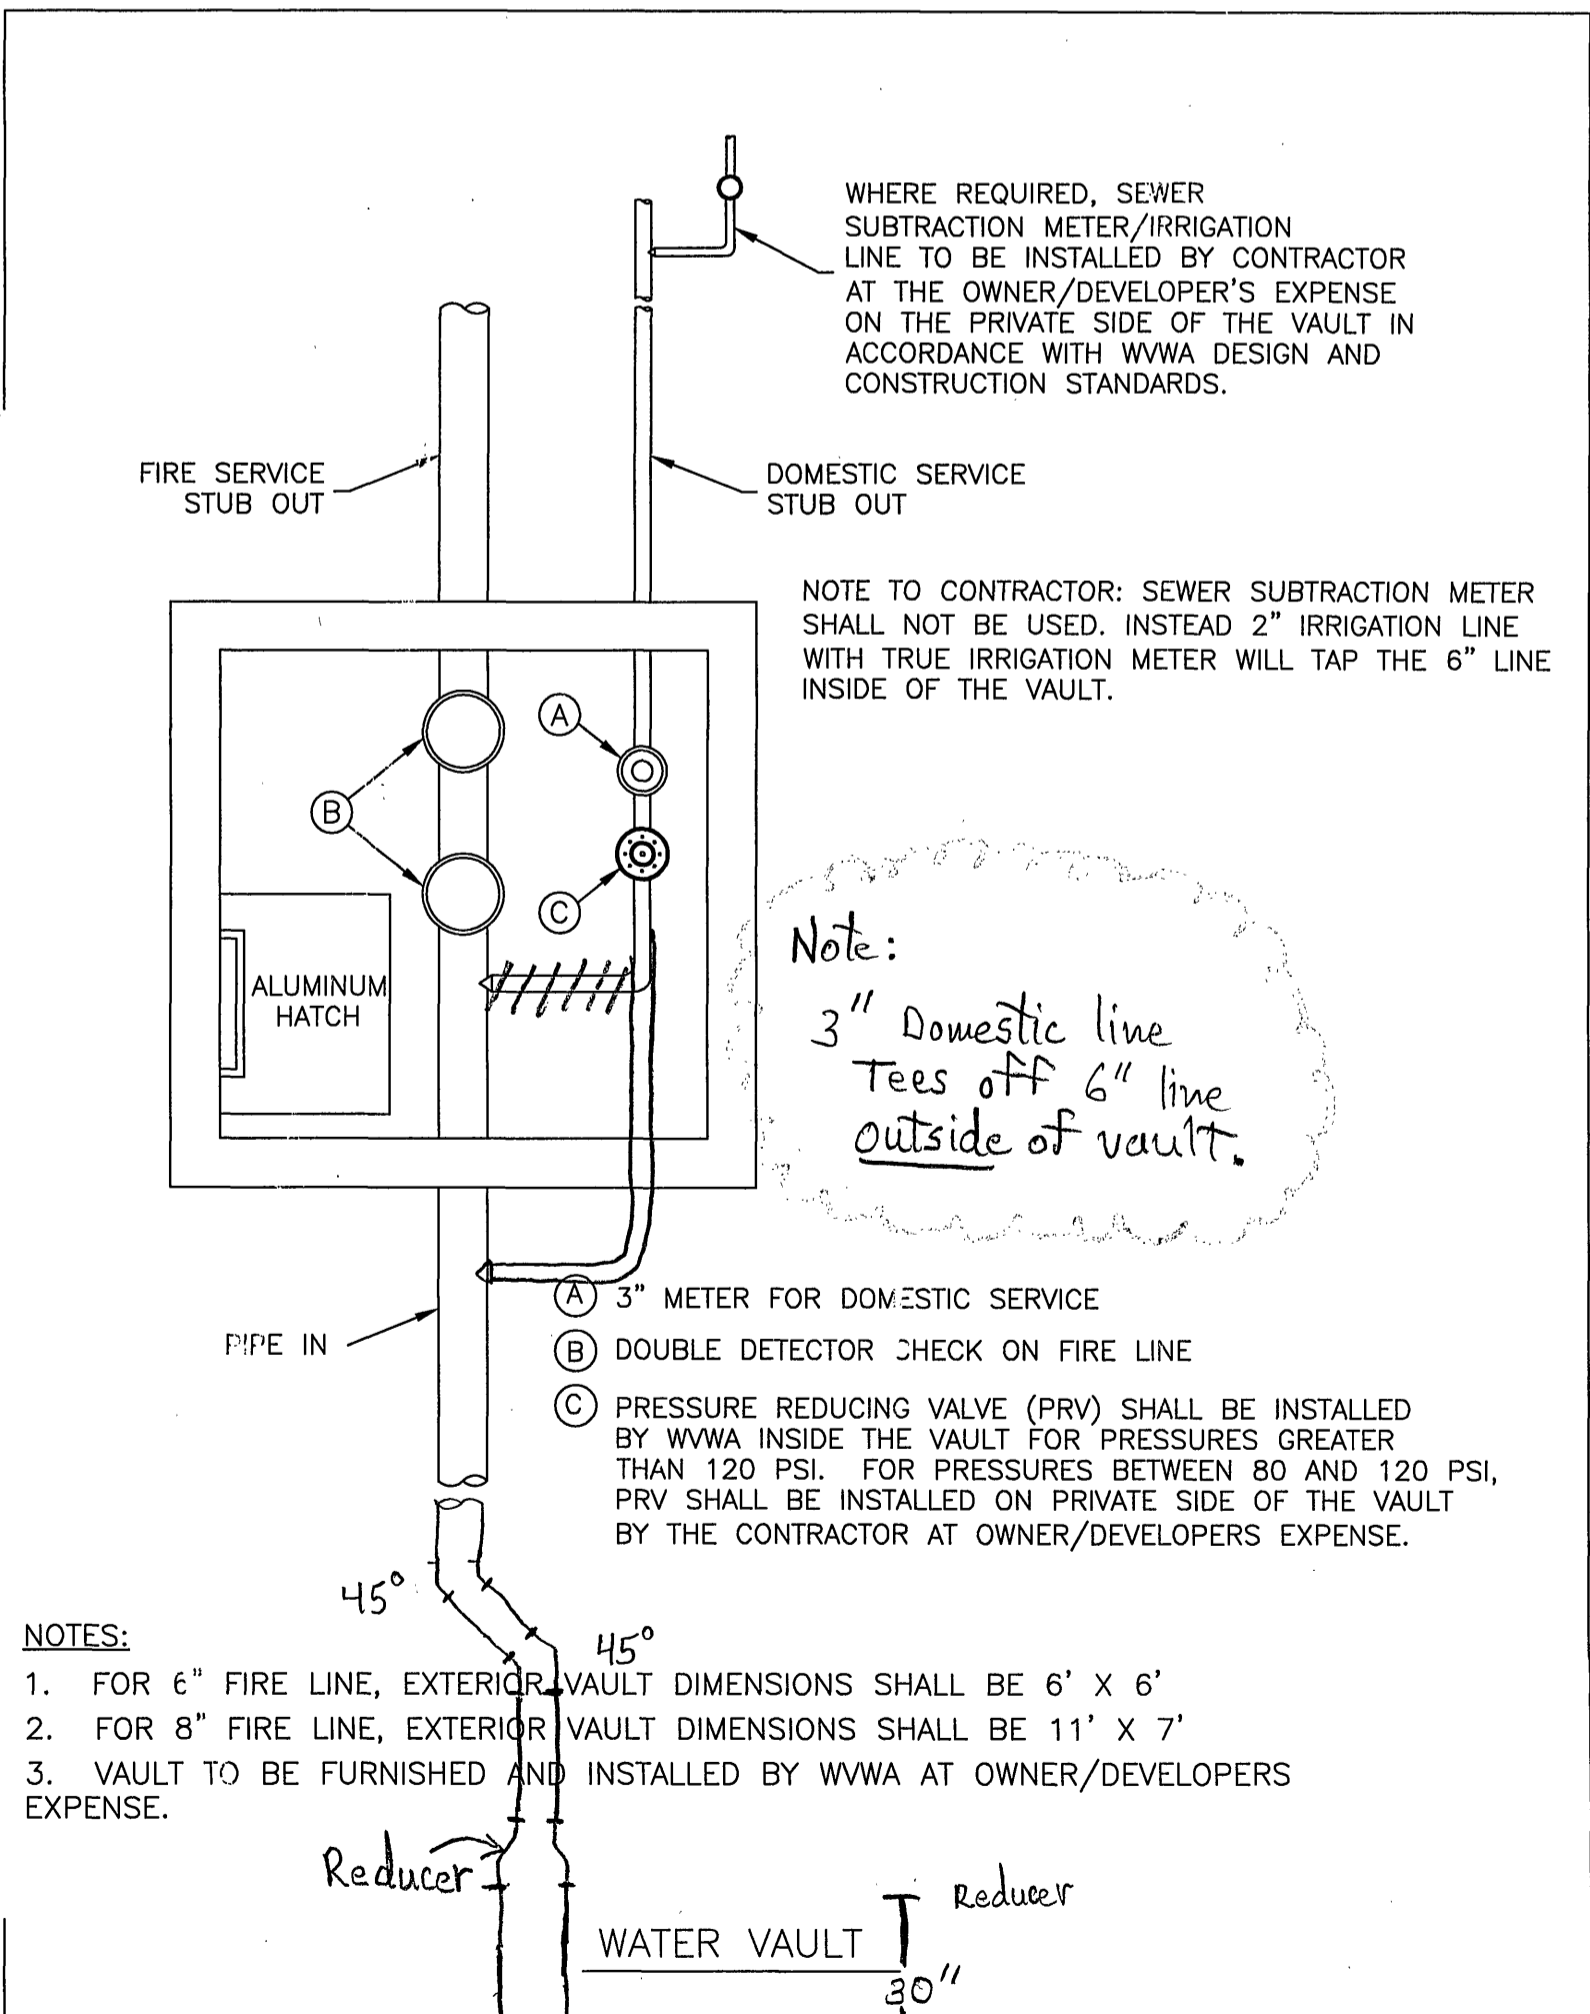