

117 CAMPBELL AVE

S.W.


T#1011025

Lot 33

as BUILT

Ch. ll

8-30-07

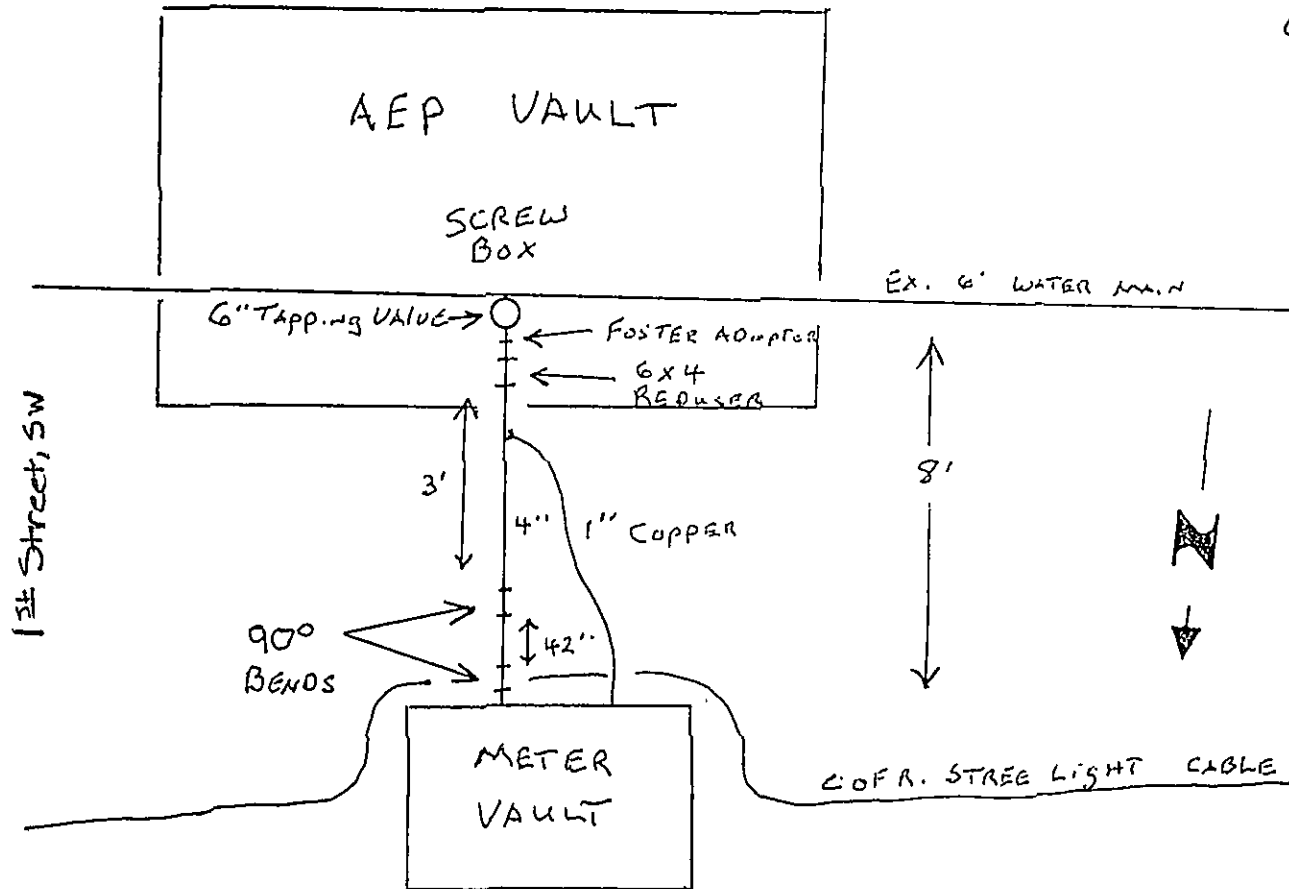

* ALL BENDS AND FITTINGS
ARE MEGA LUGGED

Campbell Avenue, SW.