


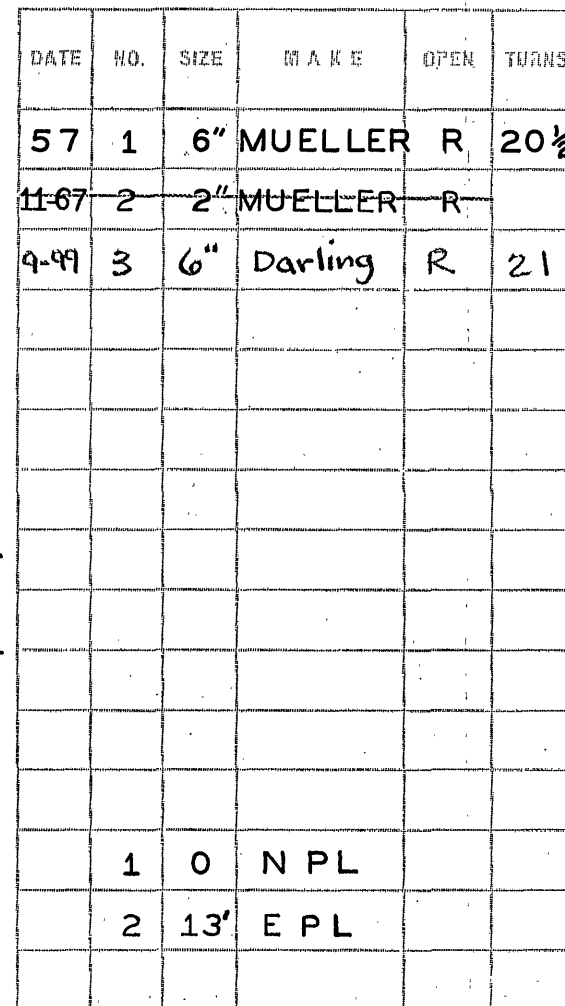

CITY OF ROANOKE—WATER DEPT	
VALVE DIAGRAM	
CANNADAY RD. &	
MECCA ST. N. E.	
NORTH INTERSECTION	
SEC. MAP	707, 708
DATE	PAGE NO.