


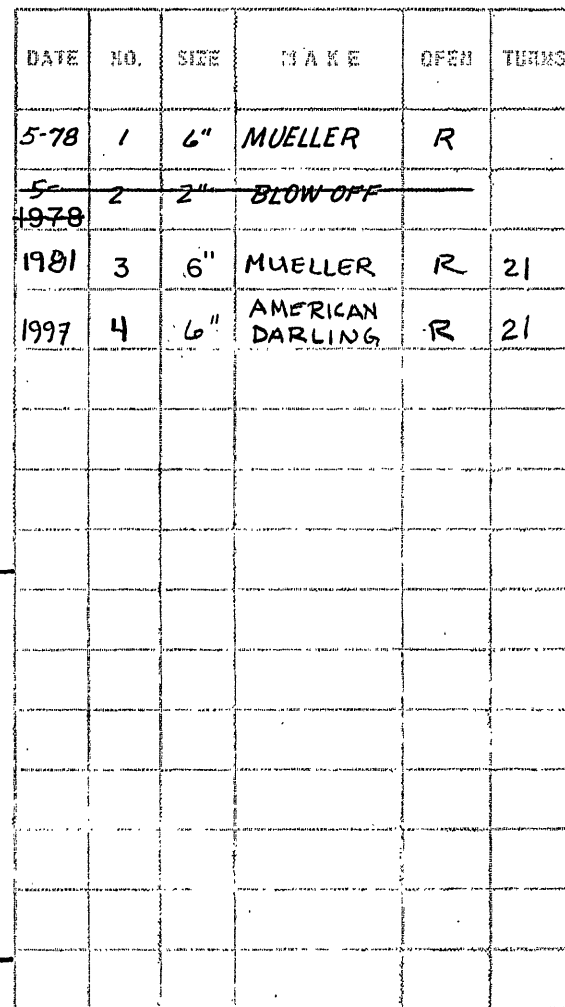

CITY OF HOANONG--WATER DEPT
VALVE DIAGRAM
CANNADAY DR. AND
RICHARD AVE.
M.E.
SEC. MAP 707
DATE PAGE NO.

9/2000 JH