


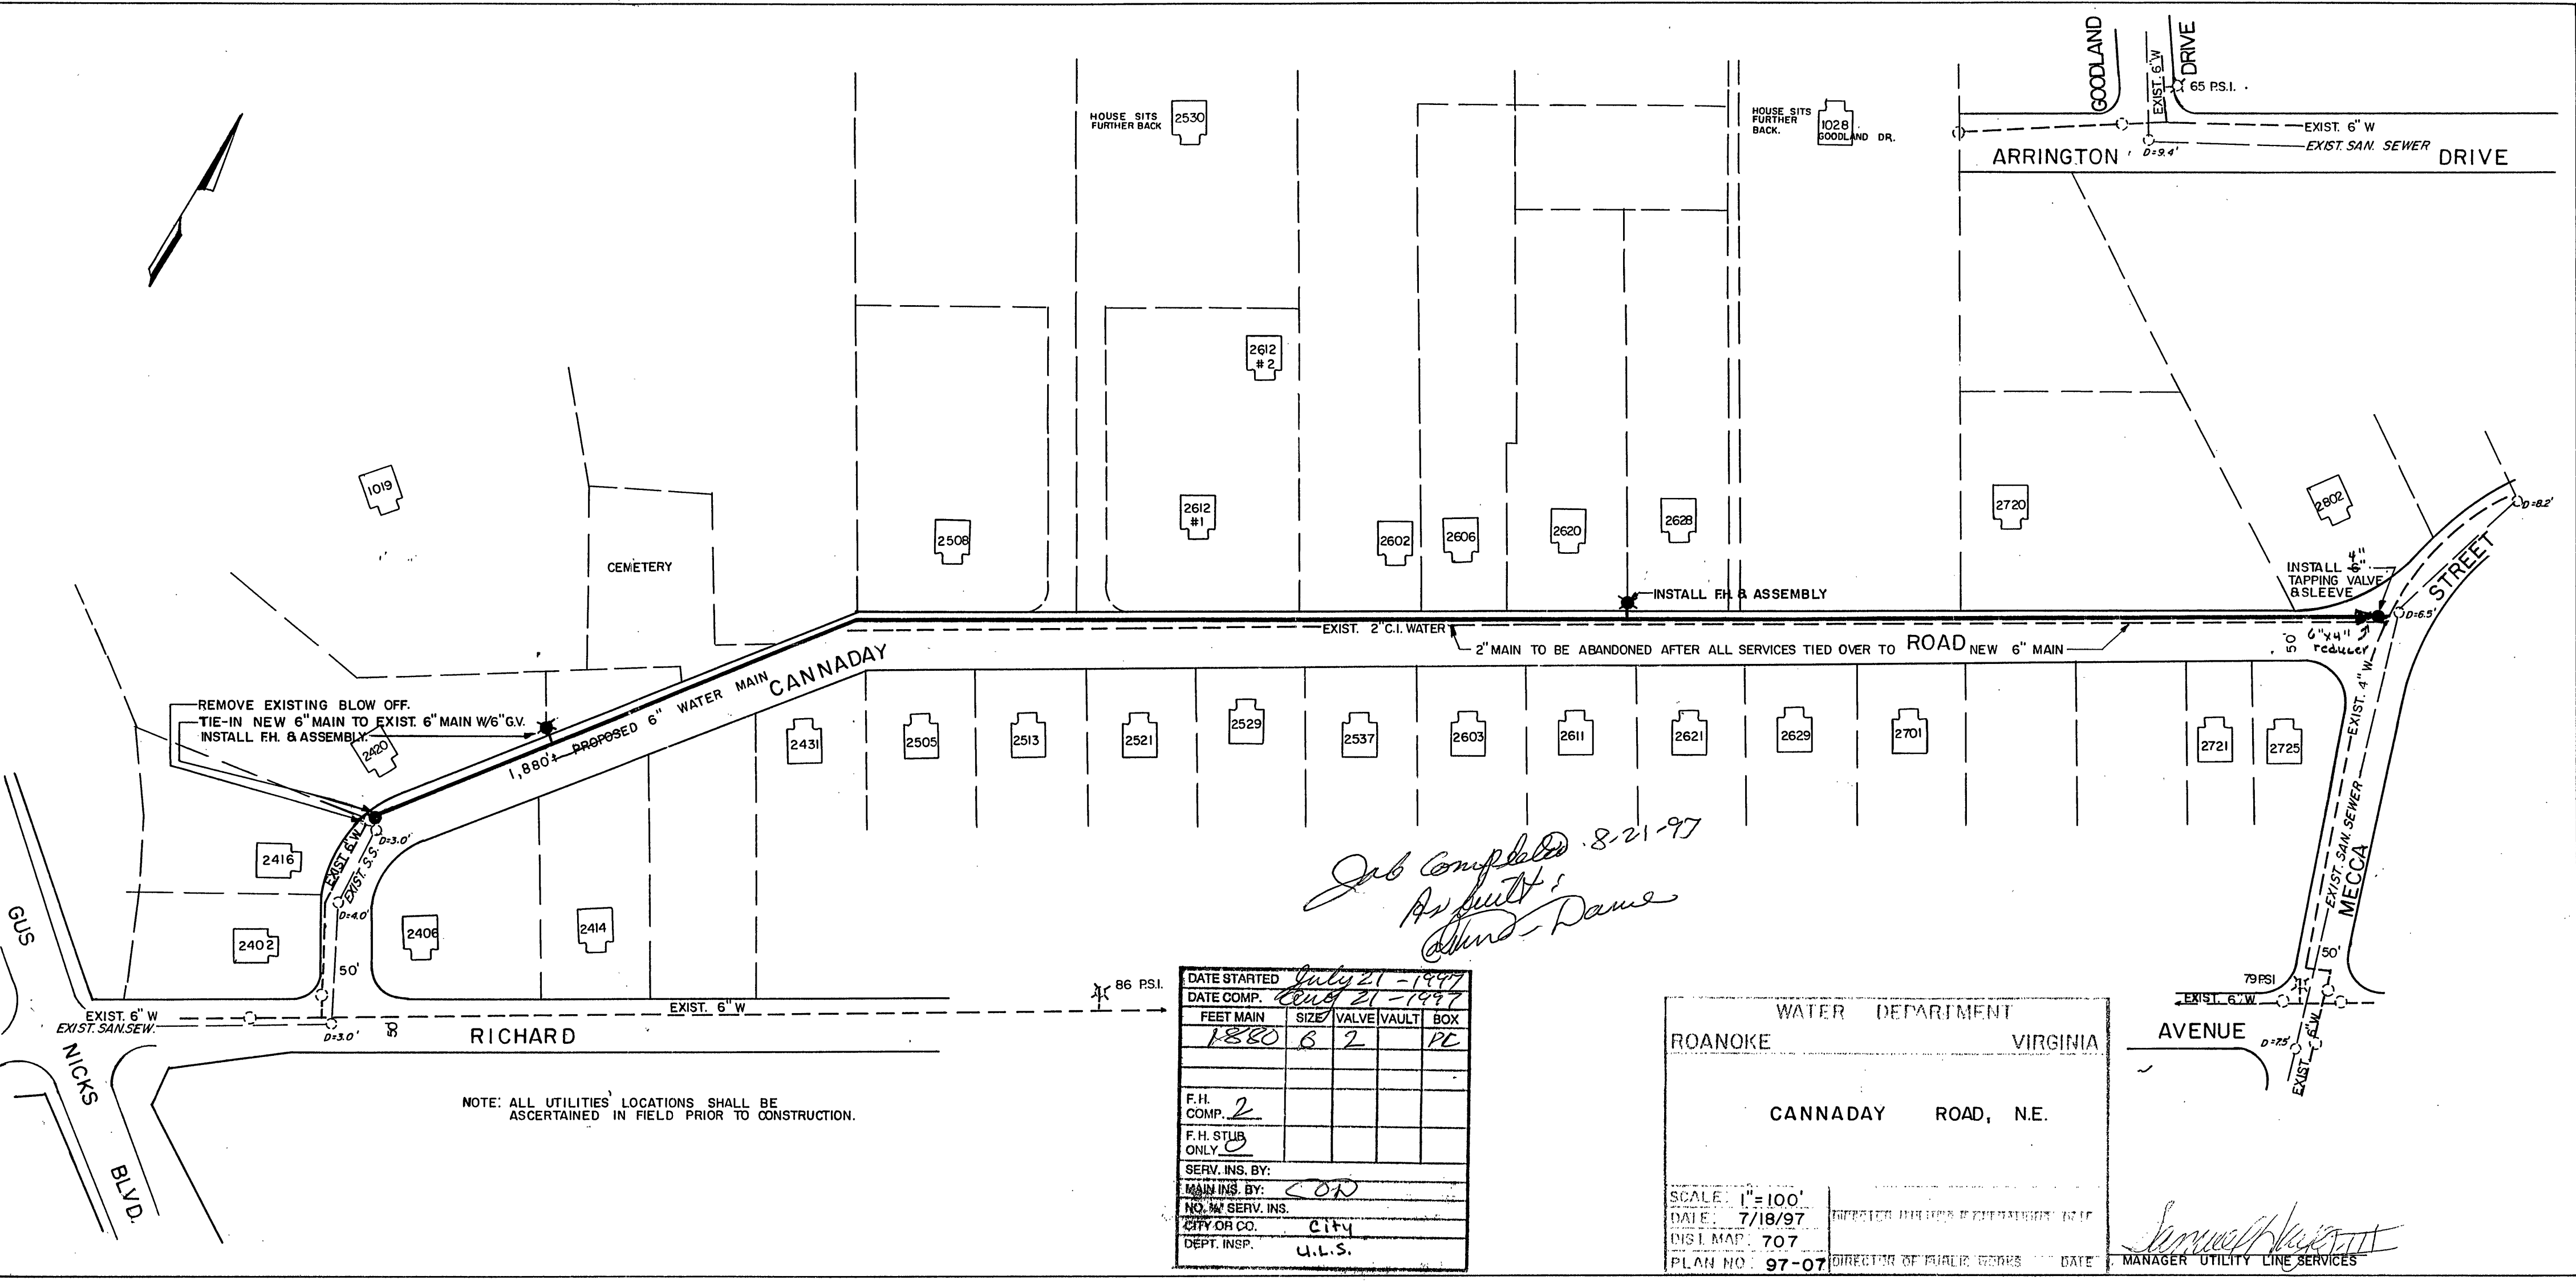

NOTE: ALL UTILITIES' LOCATIONS SHALL BE ASCERTAINED IN FIELD PRIOR TO CONSTRUCTION.

*Job Completed 8-21-97
As built:
Dund-Rame*

DATE STARTED	July 21 - 1997				
DATE COMP.	Aug 21 - 1997				
FEET MAIN	1880	SIZE	6	VALVE	2
				VAULT	PC
F.H. COMP.	2				
F.H. STUB ONLY					
SERV. INS. BY:					
MAIN INS. BY:	CON				
NO. W. SERV. INS.					
CITY OR CO.	City				
DEPT. INSP.	U.L.S.				

WATER DEPARTMENT	
ROANOKE VIRGINIA	
CANNADAY ROAD, N.E.	
SCALE: 1"=100'	DIRECTOR OF PUBLIC WORKS
DATE: 7/18/97	DATE
DIST. MAP: 707	MANAGER UTILITY LINE SERVICES
PLAN NO: 97-07	

Samuel H. [Signature]