
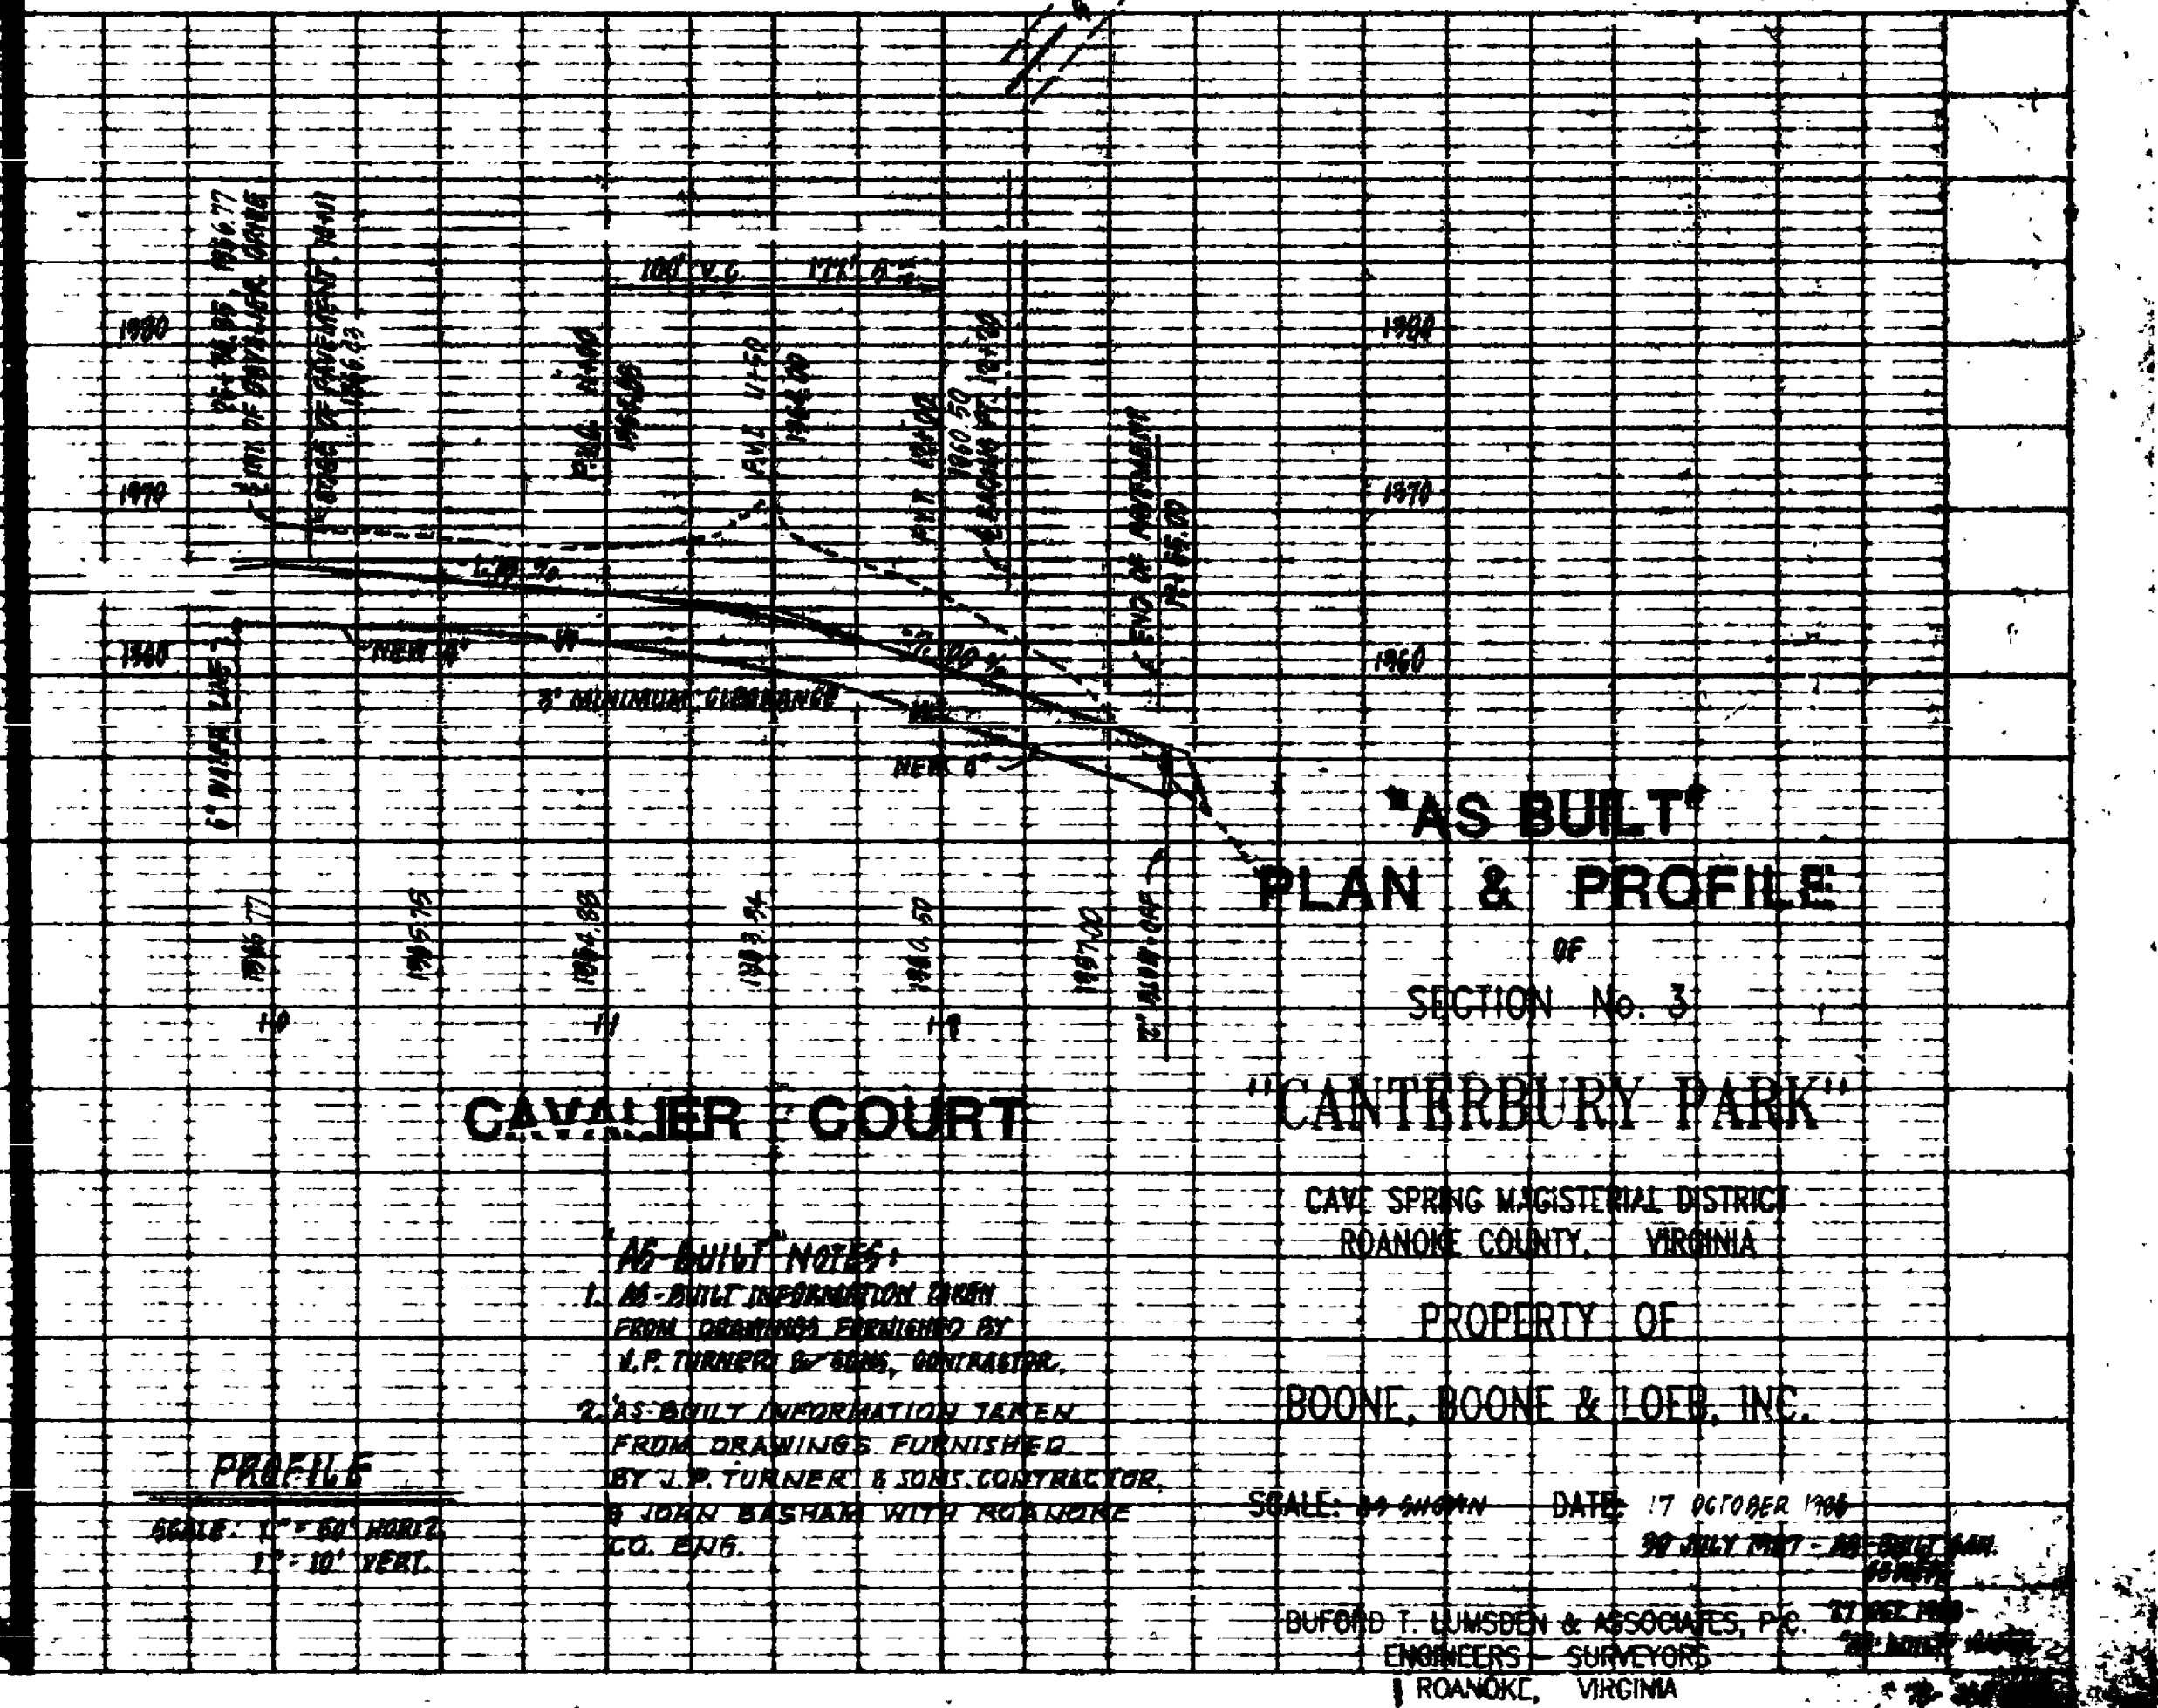
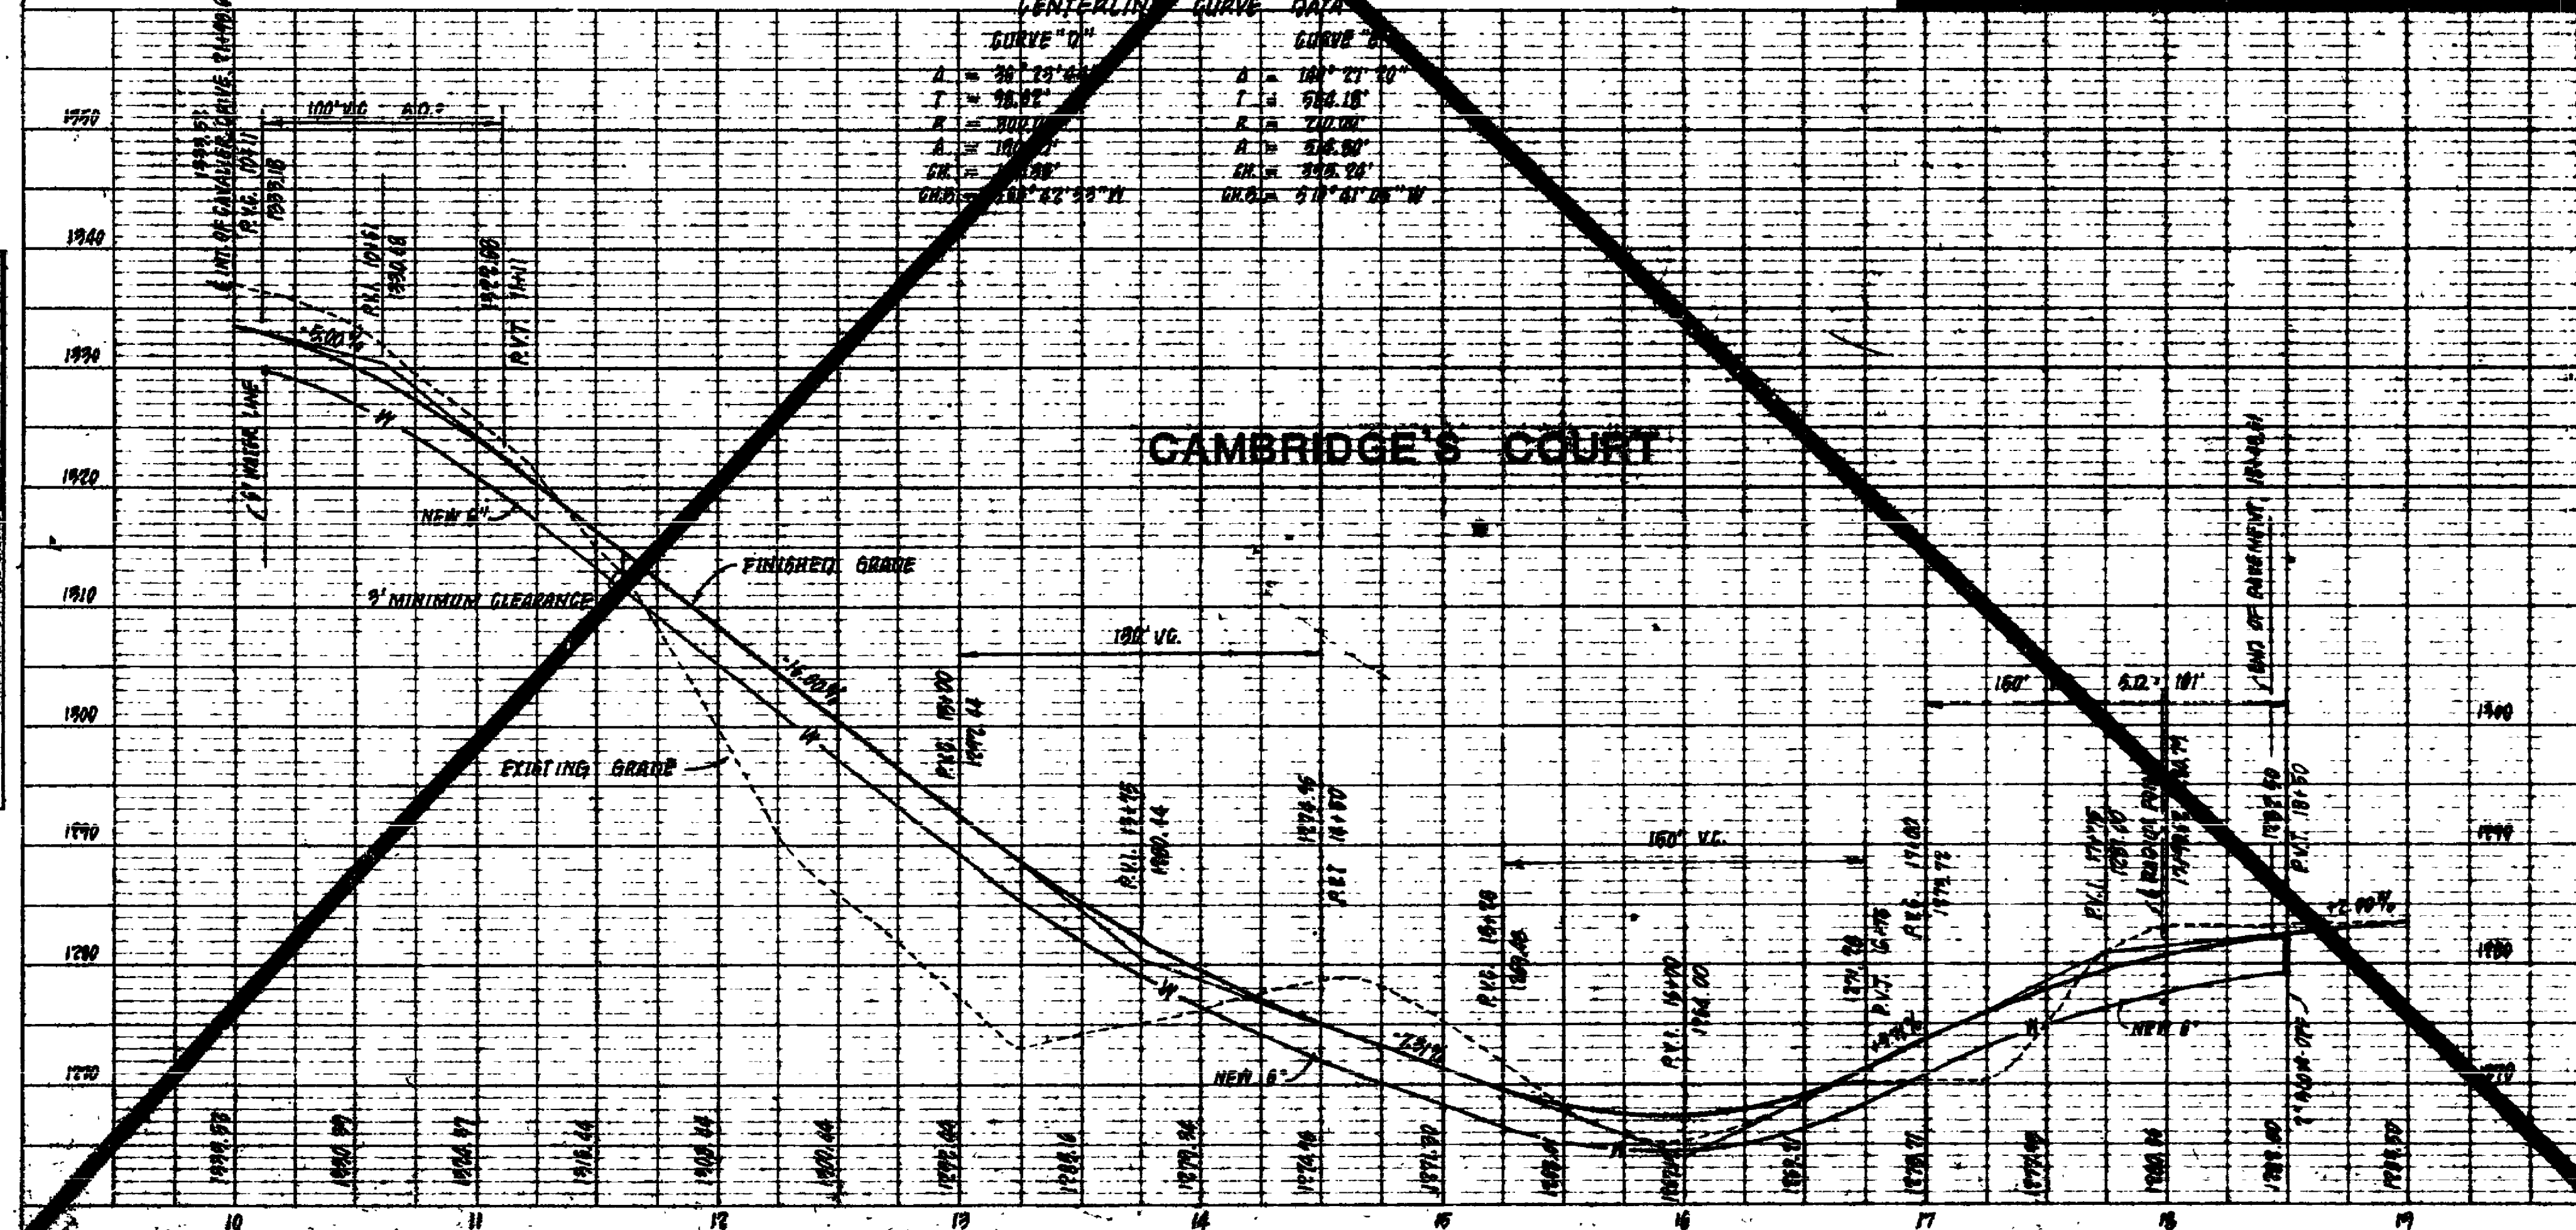
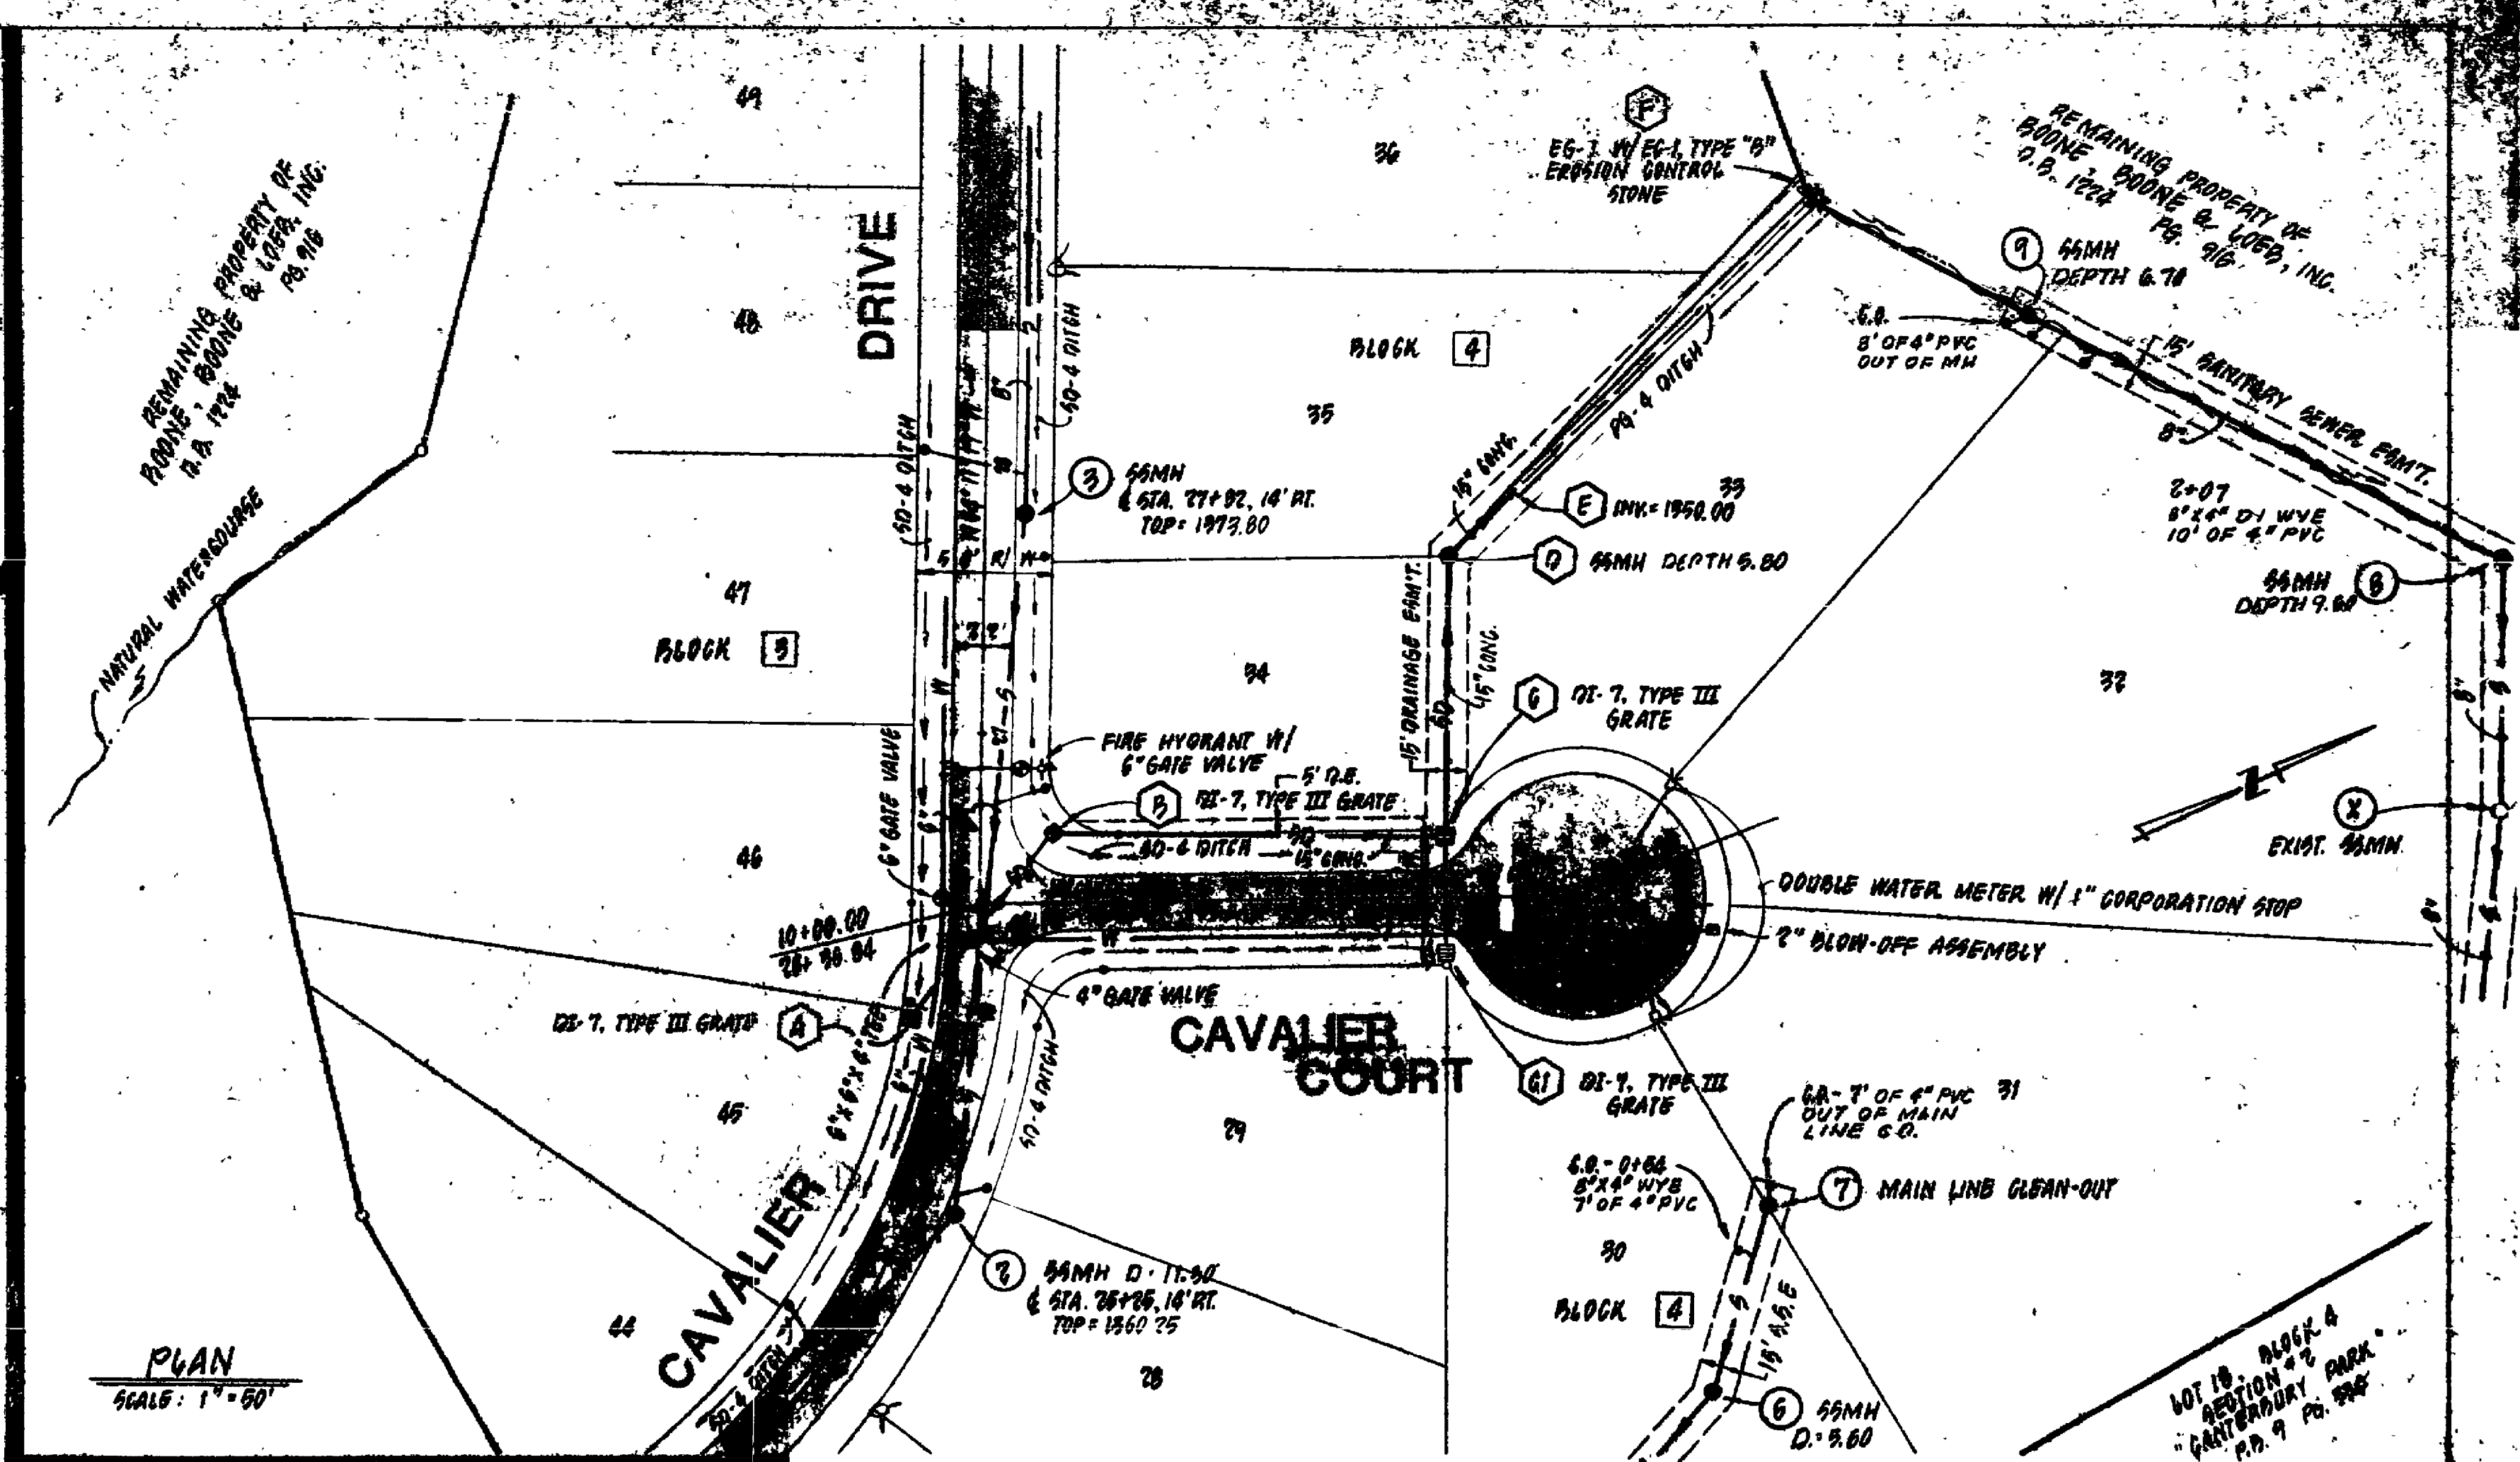


PLAN
NOTE BOOK
NO. 100

PROFILE
NOTE BOOK
NO. 100

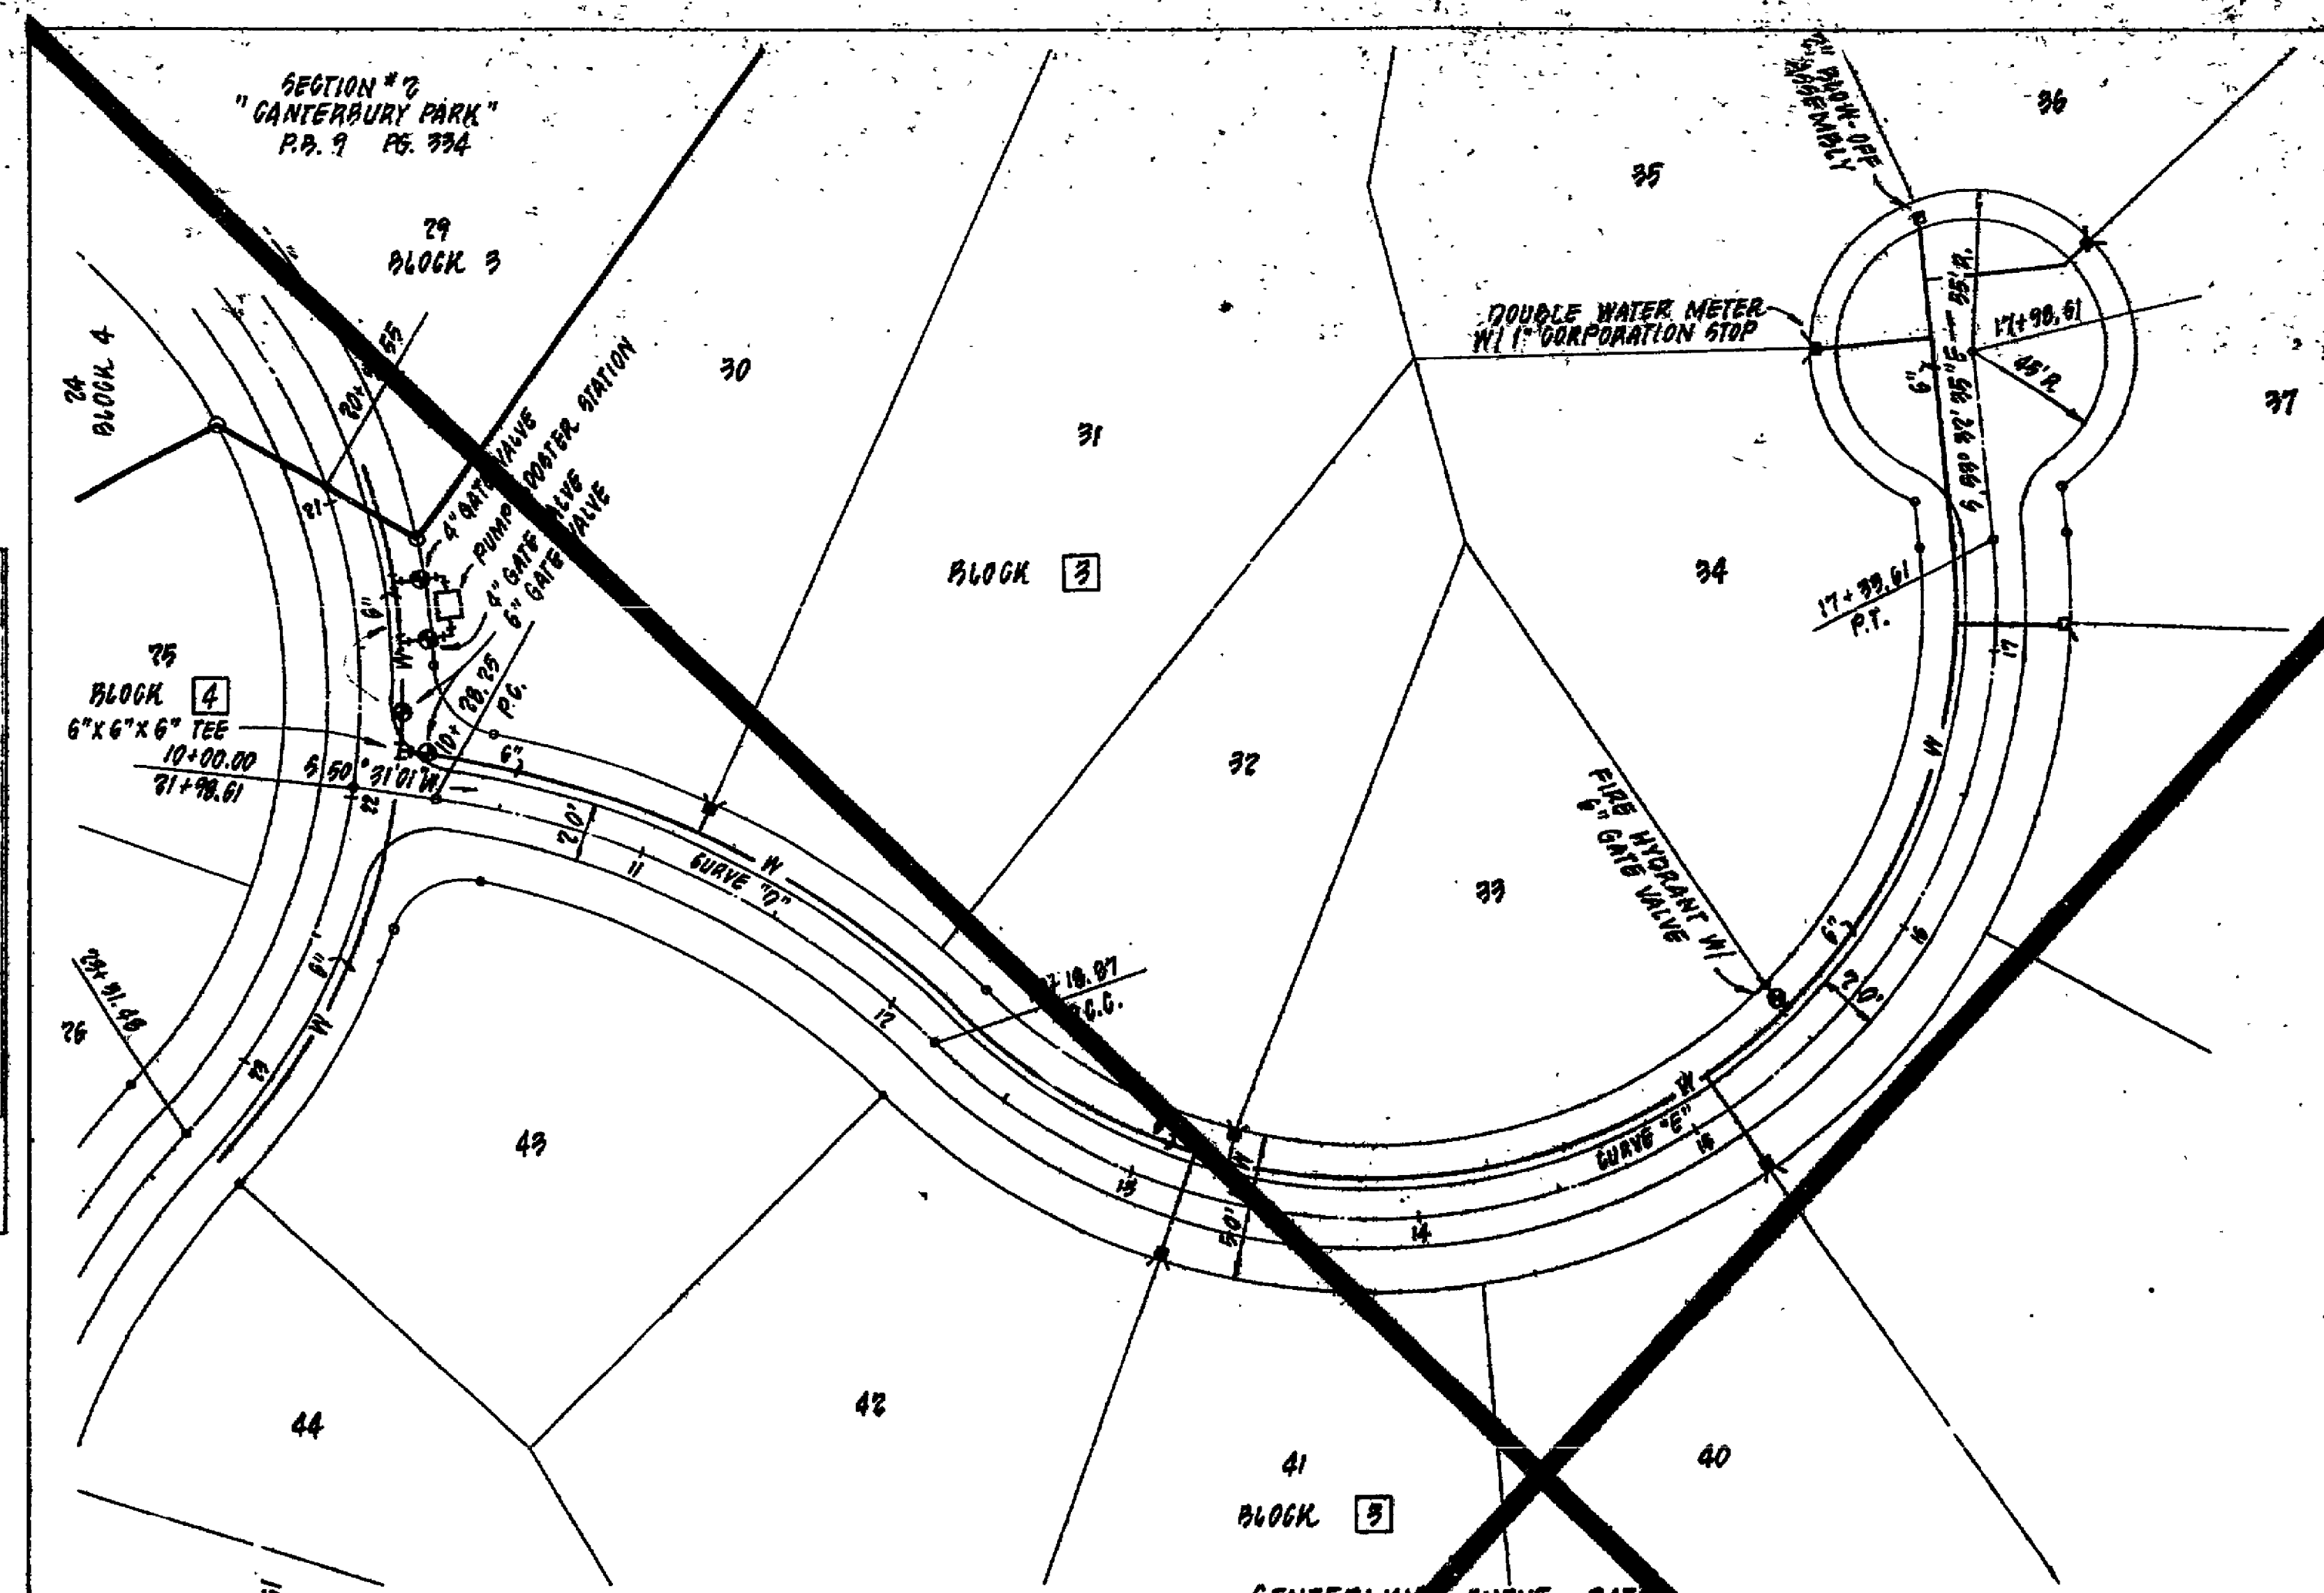

AS-BUILT NOTES:
1. AS-BUILT INFORMATION FROM
FROM DRAWINGS FURNISHED BY
J.P. TURNER & SONS, CONTRACTOR.
2. AS-BUILT INFORMATION TAKEN
FROM DRAWINGS FURNISHED
BY J.P. TURNER & SONS, CONTRACTOR.
3. JOHN BASHAM WITH HOLDING
CO. INC.

"AS BUILT" PLAN & PROFILE

SECTION No. 3
"CAMBERBURY PARK"

CANY SPRING MAGISTRIAL DISTRICT
ROANOKE COUNTY, VIRGINIA
PROPERTY OF
BOONE, BOONE & LOEB, INC.

SCALE: 1" = 40' HORIZ. DATE: 17 OCTOBER 1988
30 JULY 1987 - AS-BUILT PLAN
BUDFORD T. LAMSDEN & ASSOCIATES, P.C. 2700 N. 10TH ST.
ENGINEERS - SURVEYORS 2400 N. 10TH ST.
ROANOKE, VIRGINIA 2400 N. 10TH ST.

RC-1247 SHEET 9 OF 12