
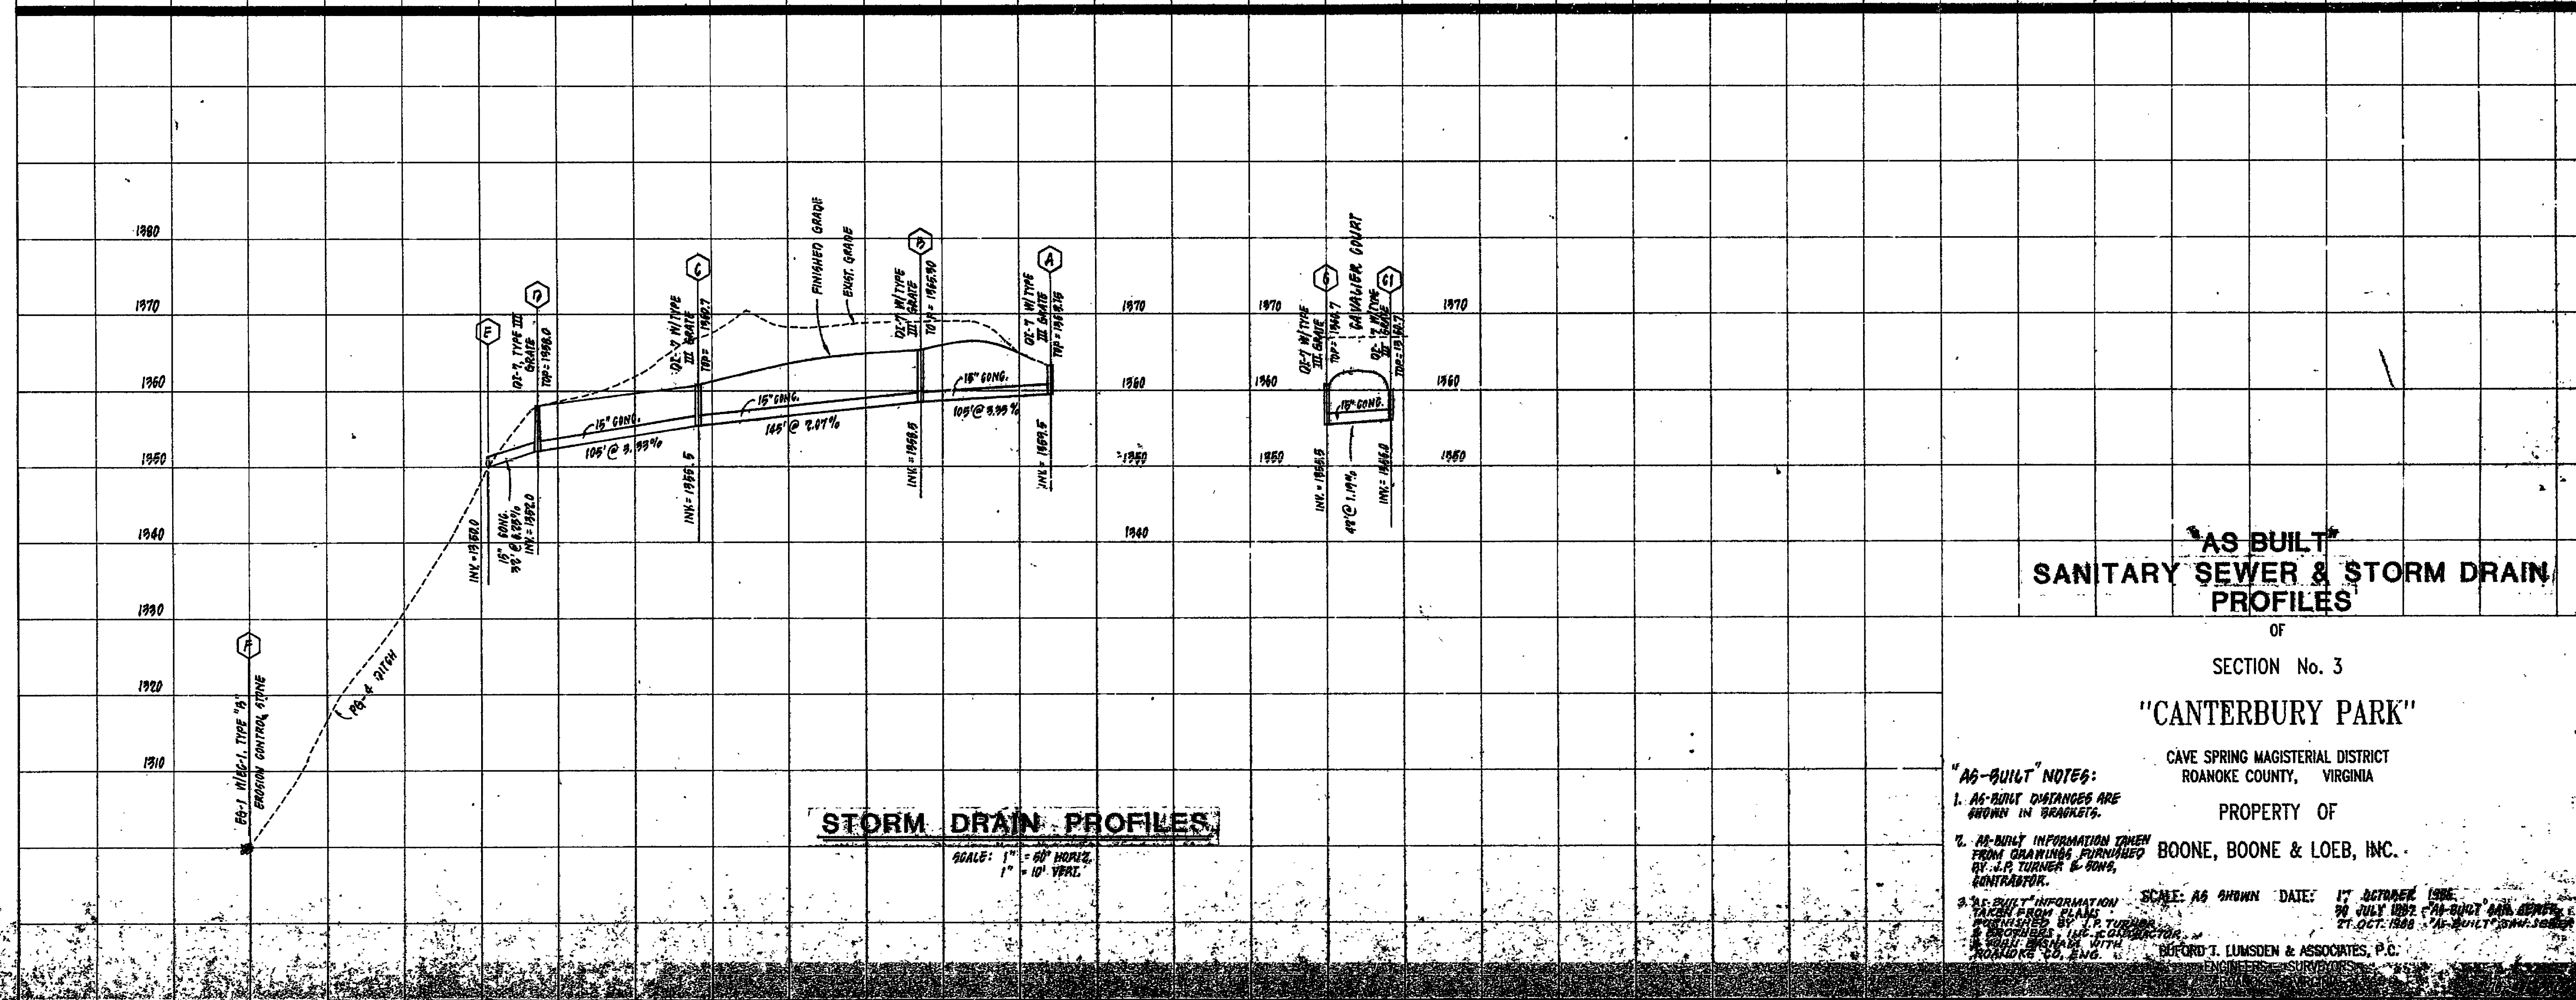


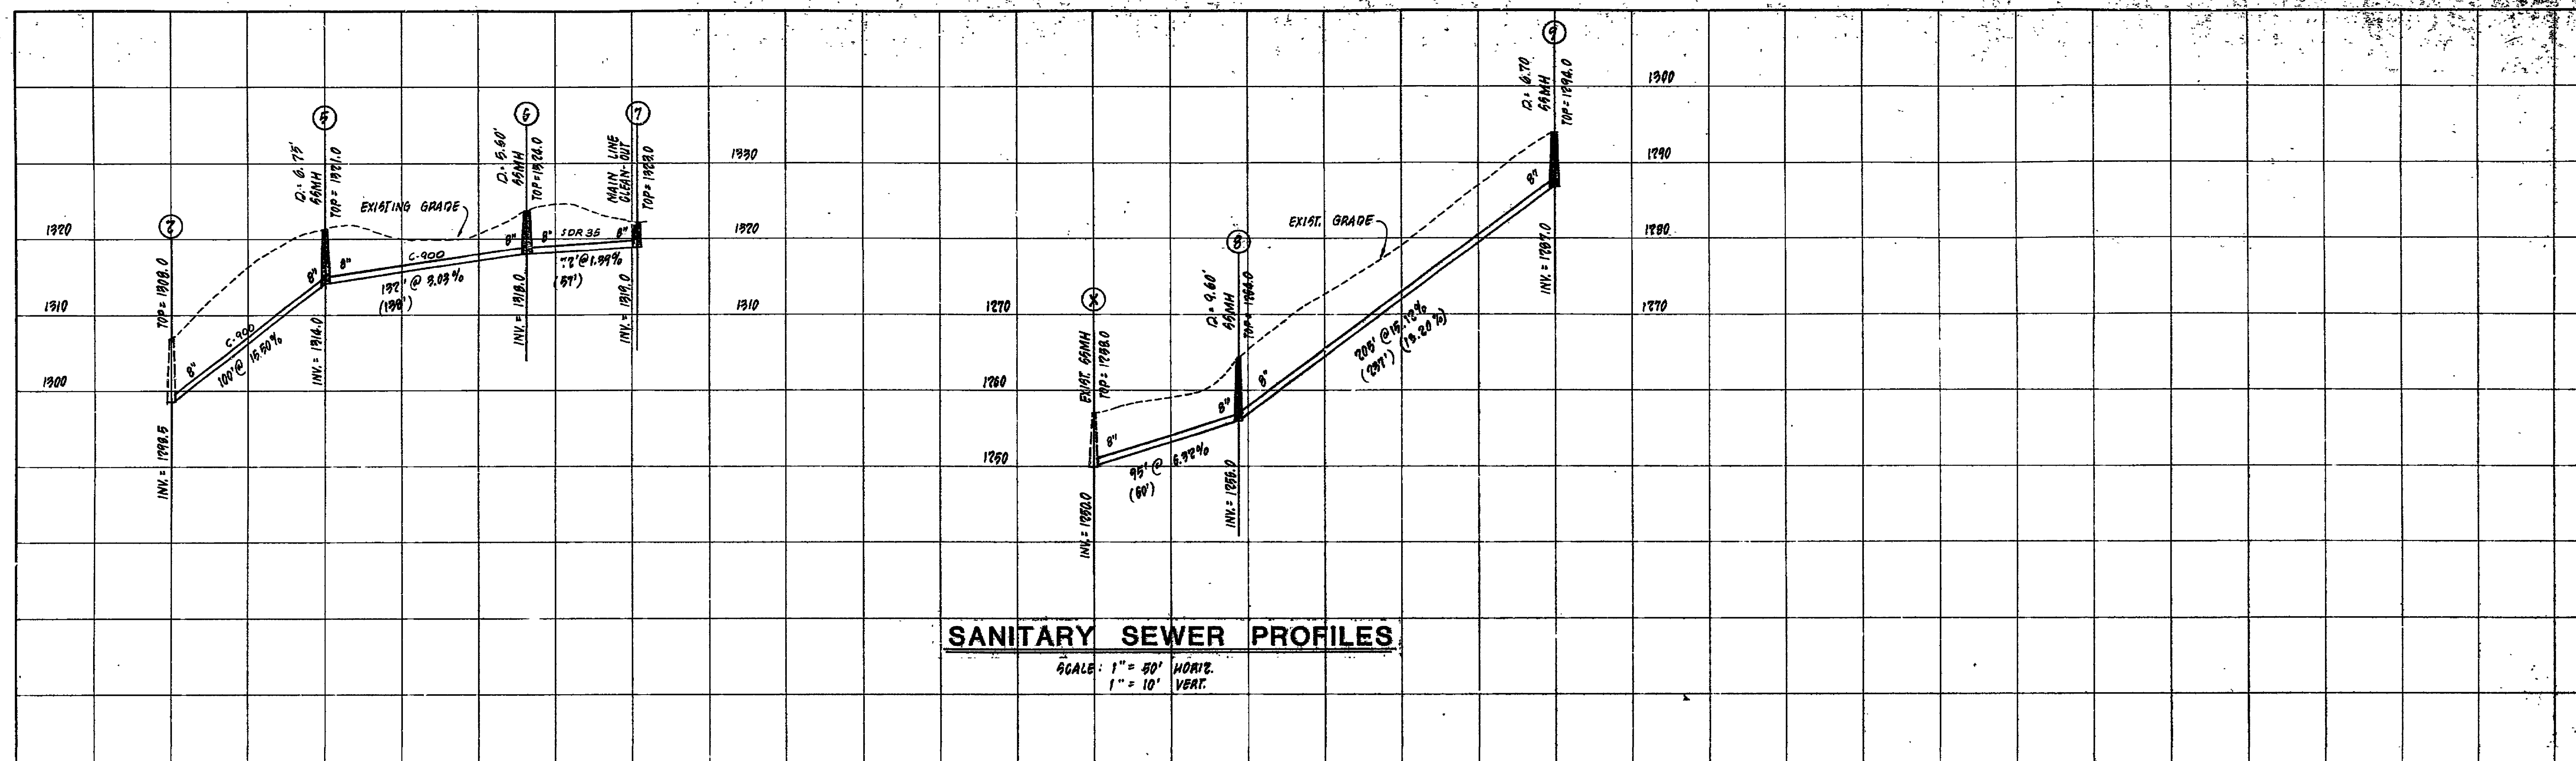

"AS BUILT" SANITARY SEWER & STORM DRAIN PROFILES

OF SECTION No. 3
"CANTERBURY PARK"

CAVE SPRING MAGISTERIAL DISTRICT
ROANOKE COUNTY, VIRGINIA
PROPERTY OF
BOONE, BOONE & LOEB, INC.

"AS-BUILT" NOTES:
1. AS-BUILT DISTANCES ARE SHOWN IN BRACKETS.
2. AS-BUILT INFORMATION TAKEN FROM DRAWINGS FURNISHED BY J.P. TURNER & SONS, CONTRACTOR.
3. AS-BUILT INFORMATION TAKEN FROM PLANS FURNISHED BY J.P. TURNER & SONS, CONTRACTOR.
SCALE: AS SHOWN DATE: 17 OCTOBER 1988
20 JULY 1992 (24-0007) BOB BOONE
27 OCT. 1990 (16-0007) BOB BOONE
BOONE, BOONE & LOEB, INC.
BOONE, BOONE & LOEB, INC.
BOONE, BOONE & LOEB, INC.

