



A circular professional engineer seal for the Commonwealth of Virginia. The outer ring contains the text "COMMONWEALTH OF VIRGINIA" at the top and "PROFESSIONAL ENGINEER" at the bottom. Inside the ring, the name "STEWART W. HUBBELL" is printed. To the left of the name is the date "3/1/04". To the right is the number "No. 07420". A handwritten signature, "Stewart W. Hubbell", is written across the center of the seal.

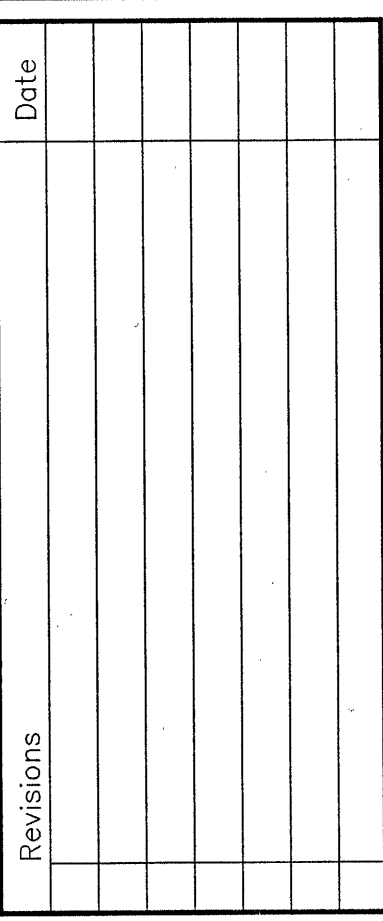

Issue Date: DEC.,2003	Drawn By: ARB Designed By: HAY	Checked By: SWH Date: 12/22/03
--------------------------	-----------------------------------	-----------------------------------

- MA** **Mattem & Craig**
CONSULTING ENGINEERS • SURVEYORS
- 701 FIRST STREET, S.W.
ROANOKE, VIRGINIA 24015
(540) 345-9342
FAX (540) 345-7691

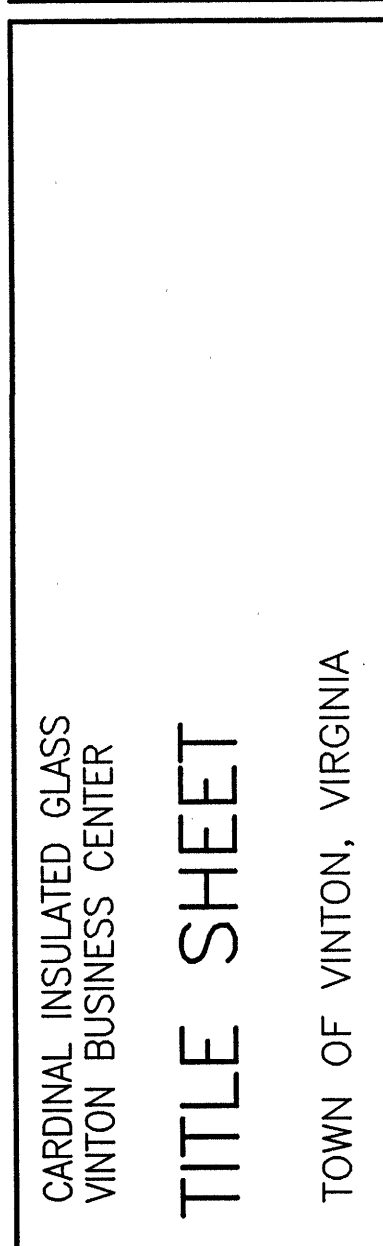

FACILITY MUTUAL INSURANCE COMPANY

**PLANS ACCEPTED SUBJECT TO COMMENTS AND CHANGES
INDICATED BY TRANSMITTAL LETTER**

Installation as required by facility drawings. See Transmittal. Installation should conform to FM Utilization Manual for Facility Mutual Insurance Company.

Approved Equipment:

- Plan review and field notes required for insurance underwriting.
- No guarantees will be given until receipt of satisfactory facility Mutual Insurance Company's policies.

Plan Review by: *[Signature]* Date: *3-15-04*

Referenced to Facility Mutual Insurance Company or Facility Mutual Insurance Subscribers and related companies, including FM Insurance Company, LTD.
(FEMA - Federal Emergency Management Corporation) (FMIS)

Used per FM Utilization ref 29 2004

Vertical Scale: N/A
Horizontal Scale: N/A
Commission Number: 2207-A
Sheet No.: 1