


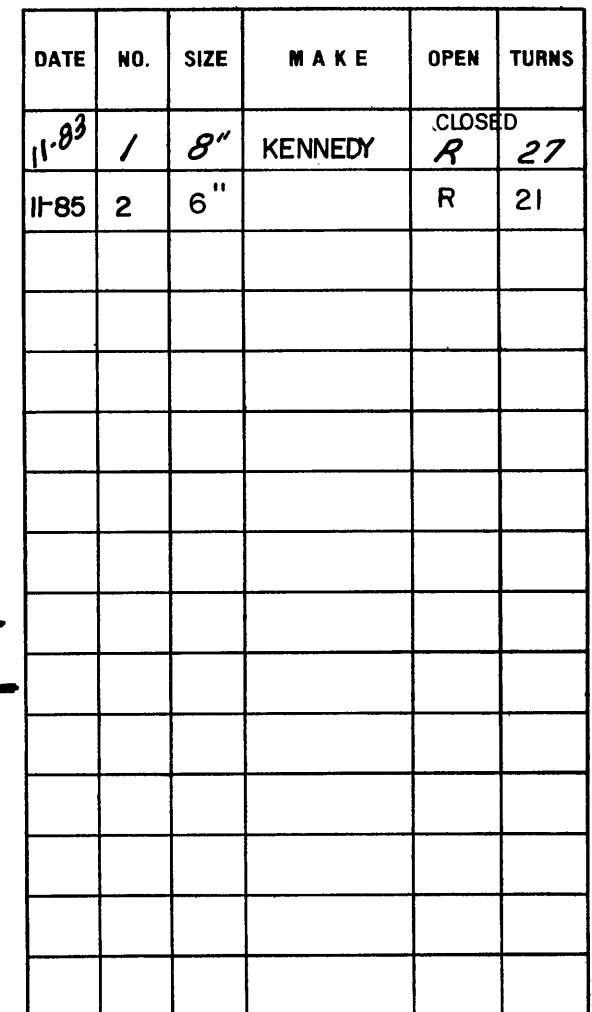

CITY OF ROANOKE—WATER DEP'T	
VALVE DIAGRAM	
CAREFREE LANE	
F BENT ROAD	
N.W. (I)	
SEC. MAP	COUNTY # 3, 700
DATE 7-9-84	PAGE NO.