



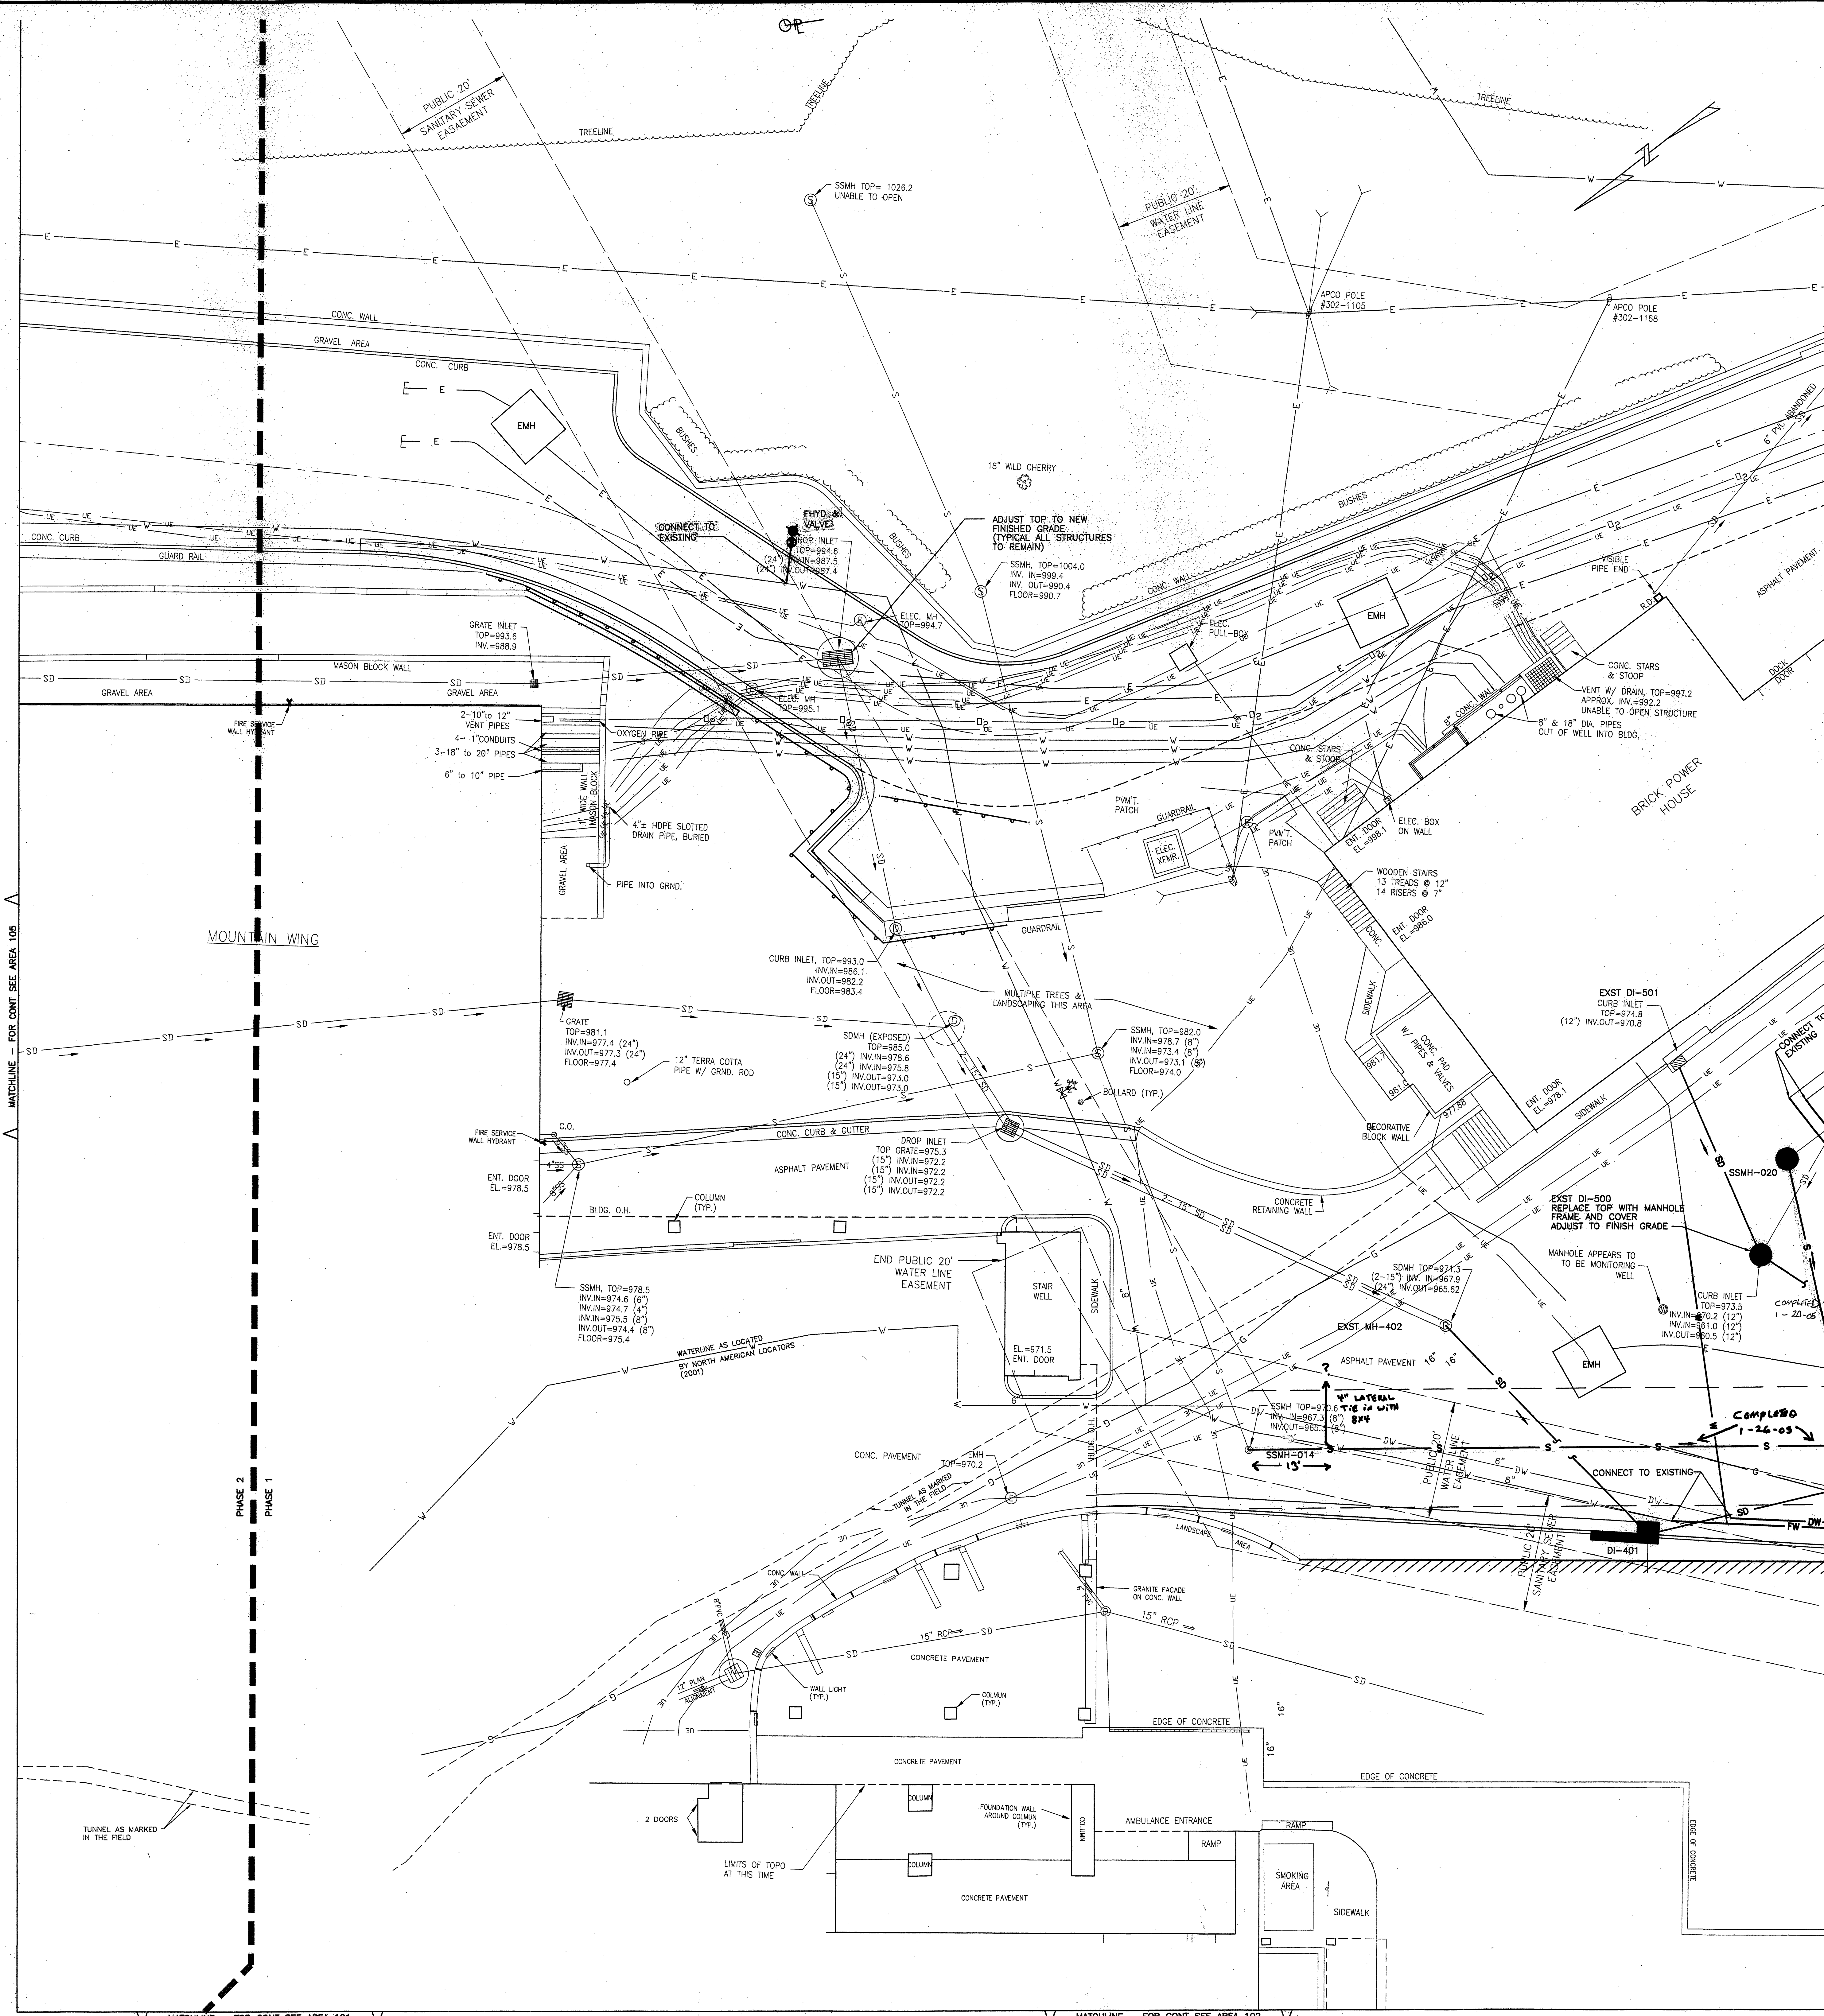

- ## GENERAL UTILITIES NOTES:
1. CONTRACTOR SHALL MAINTAIN TWO-WAY TRAFFIC WHEN PRACTICAL, WHEN WORKING WITHIN EXISTING STREETS. THE CONTRACTOR SHALL MAINTAIN TRAFFIC SIGNALS, BARRICADES, CONE TRAFFIC CONTROL, AND FLAGMEN TO DIRECT TRAFFIC IN ACCORDANCE WITH THE WORK AREA TRAFFIC CONTROL HANDBOOK.
 2. ALL PAYMENT, CURBS, AND GUTTERS DISTURBED FOR INSTALLATION OF UTILITIES AND/OR EXISTING BARRICADES SHALL BE RESTORED TO ORIGINAL CONDITION, INCLUDING PAYMENT MARKINGS, IMMEDIATELY FOLLOWING THE INSTALLATION.
 3. THE CITY OF ROANOKE'S UTILITY LINE SERVICES WILL MAKE THE CONNECTION TO THE SEWER MAIN FOLLOWING EXCAVATION AND SHORING PER OSHA REGULATIONS BY THE CONTRACTOR. A SEWER MAIN TAP WILL BE REQUIRED TO BE MADE TO THE SEWER MAIN OR MANHOLE, CONTACT UTILITY LINES SERVICES AT 540-863-2792. TWO (2) DAYS PRIOR TO THE ANTICIPATED DATE THE MANHOLE TAP IS NEEDED, SEWER FEES SHOULD BE PAID AT LEAST ONE WEEK PRIOR TO THE DATE SEWER HOOKUP IS NEEDED.
 4. THE WATER CONNECTION IS TO BE DONE BY THE CITY OF ROANOKE. A CONNECTION FEE WILL BE CHARGED WHICH WILL INCLUDE THE PUBLIC SERVICE, LINE, AND WATER MAIN. THE CONTRACTOR SHALL LOCATE THE WATER MAIN AT THE PROPERTY LINE. PLEASE CONTACT THE CITY OF ROANOKE'S BUILDING DEPARTMENT AT 540-863-6818 AND 540-863-6818 TO COORDINATE PAYMENT OF THE ABOVE REFERENCED WATER AND SEWER FEES. WATER FEES SHOULD BE PAID APPROXIMATELY EIGHT WEEKS PRIOR TO THE DATE OF WATER IS NEEDED.
 5. CONTRACTOR SHALL ADHERE TO WESTERN VIRGINIA WATER AUTHORITY REGULATIONS AND CONSTRUCTION GUIDELINES AND REGULATIONS.

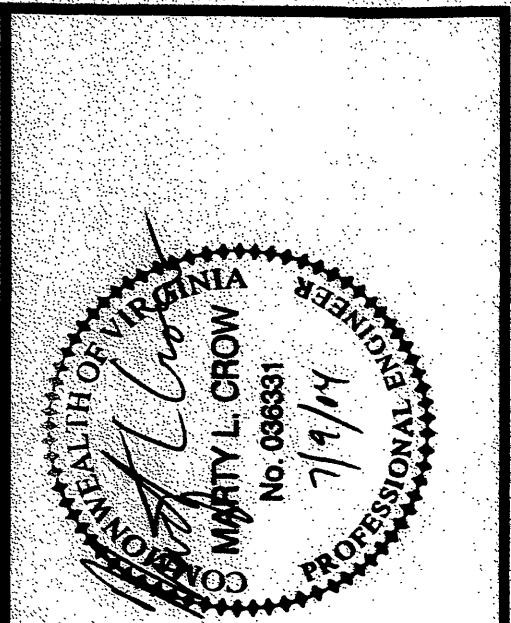

SEALS

CONSULTANT



HELLMUTH, OBATA + KASSABAUM, INC.
ARCHITECTURE, INTERIORS, PLANNING, INTERIORS, GRAPHICS CONSULTING
St. Louis, Missouri 63102 USA

CARILION
Health System
CMC CONSOLIDATION
CARILION ROANOKE MEMORIAL HOSPITAL
ROANOKE, VIRGINIA

HSM

ARCHITECTS ENGINEERS PLANNERS
HAYES, SEAY, MATTERN & MATTERN, INC.
1315 FRANKLIN ROAD
ROANOKE, VA 24016
(540) 857-3100 WWW.HSM.COM

[illegible]