


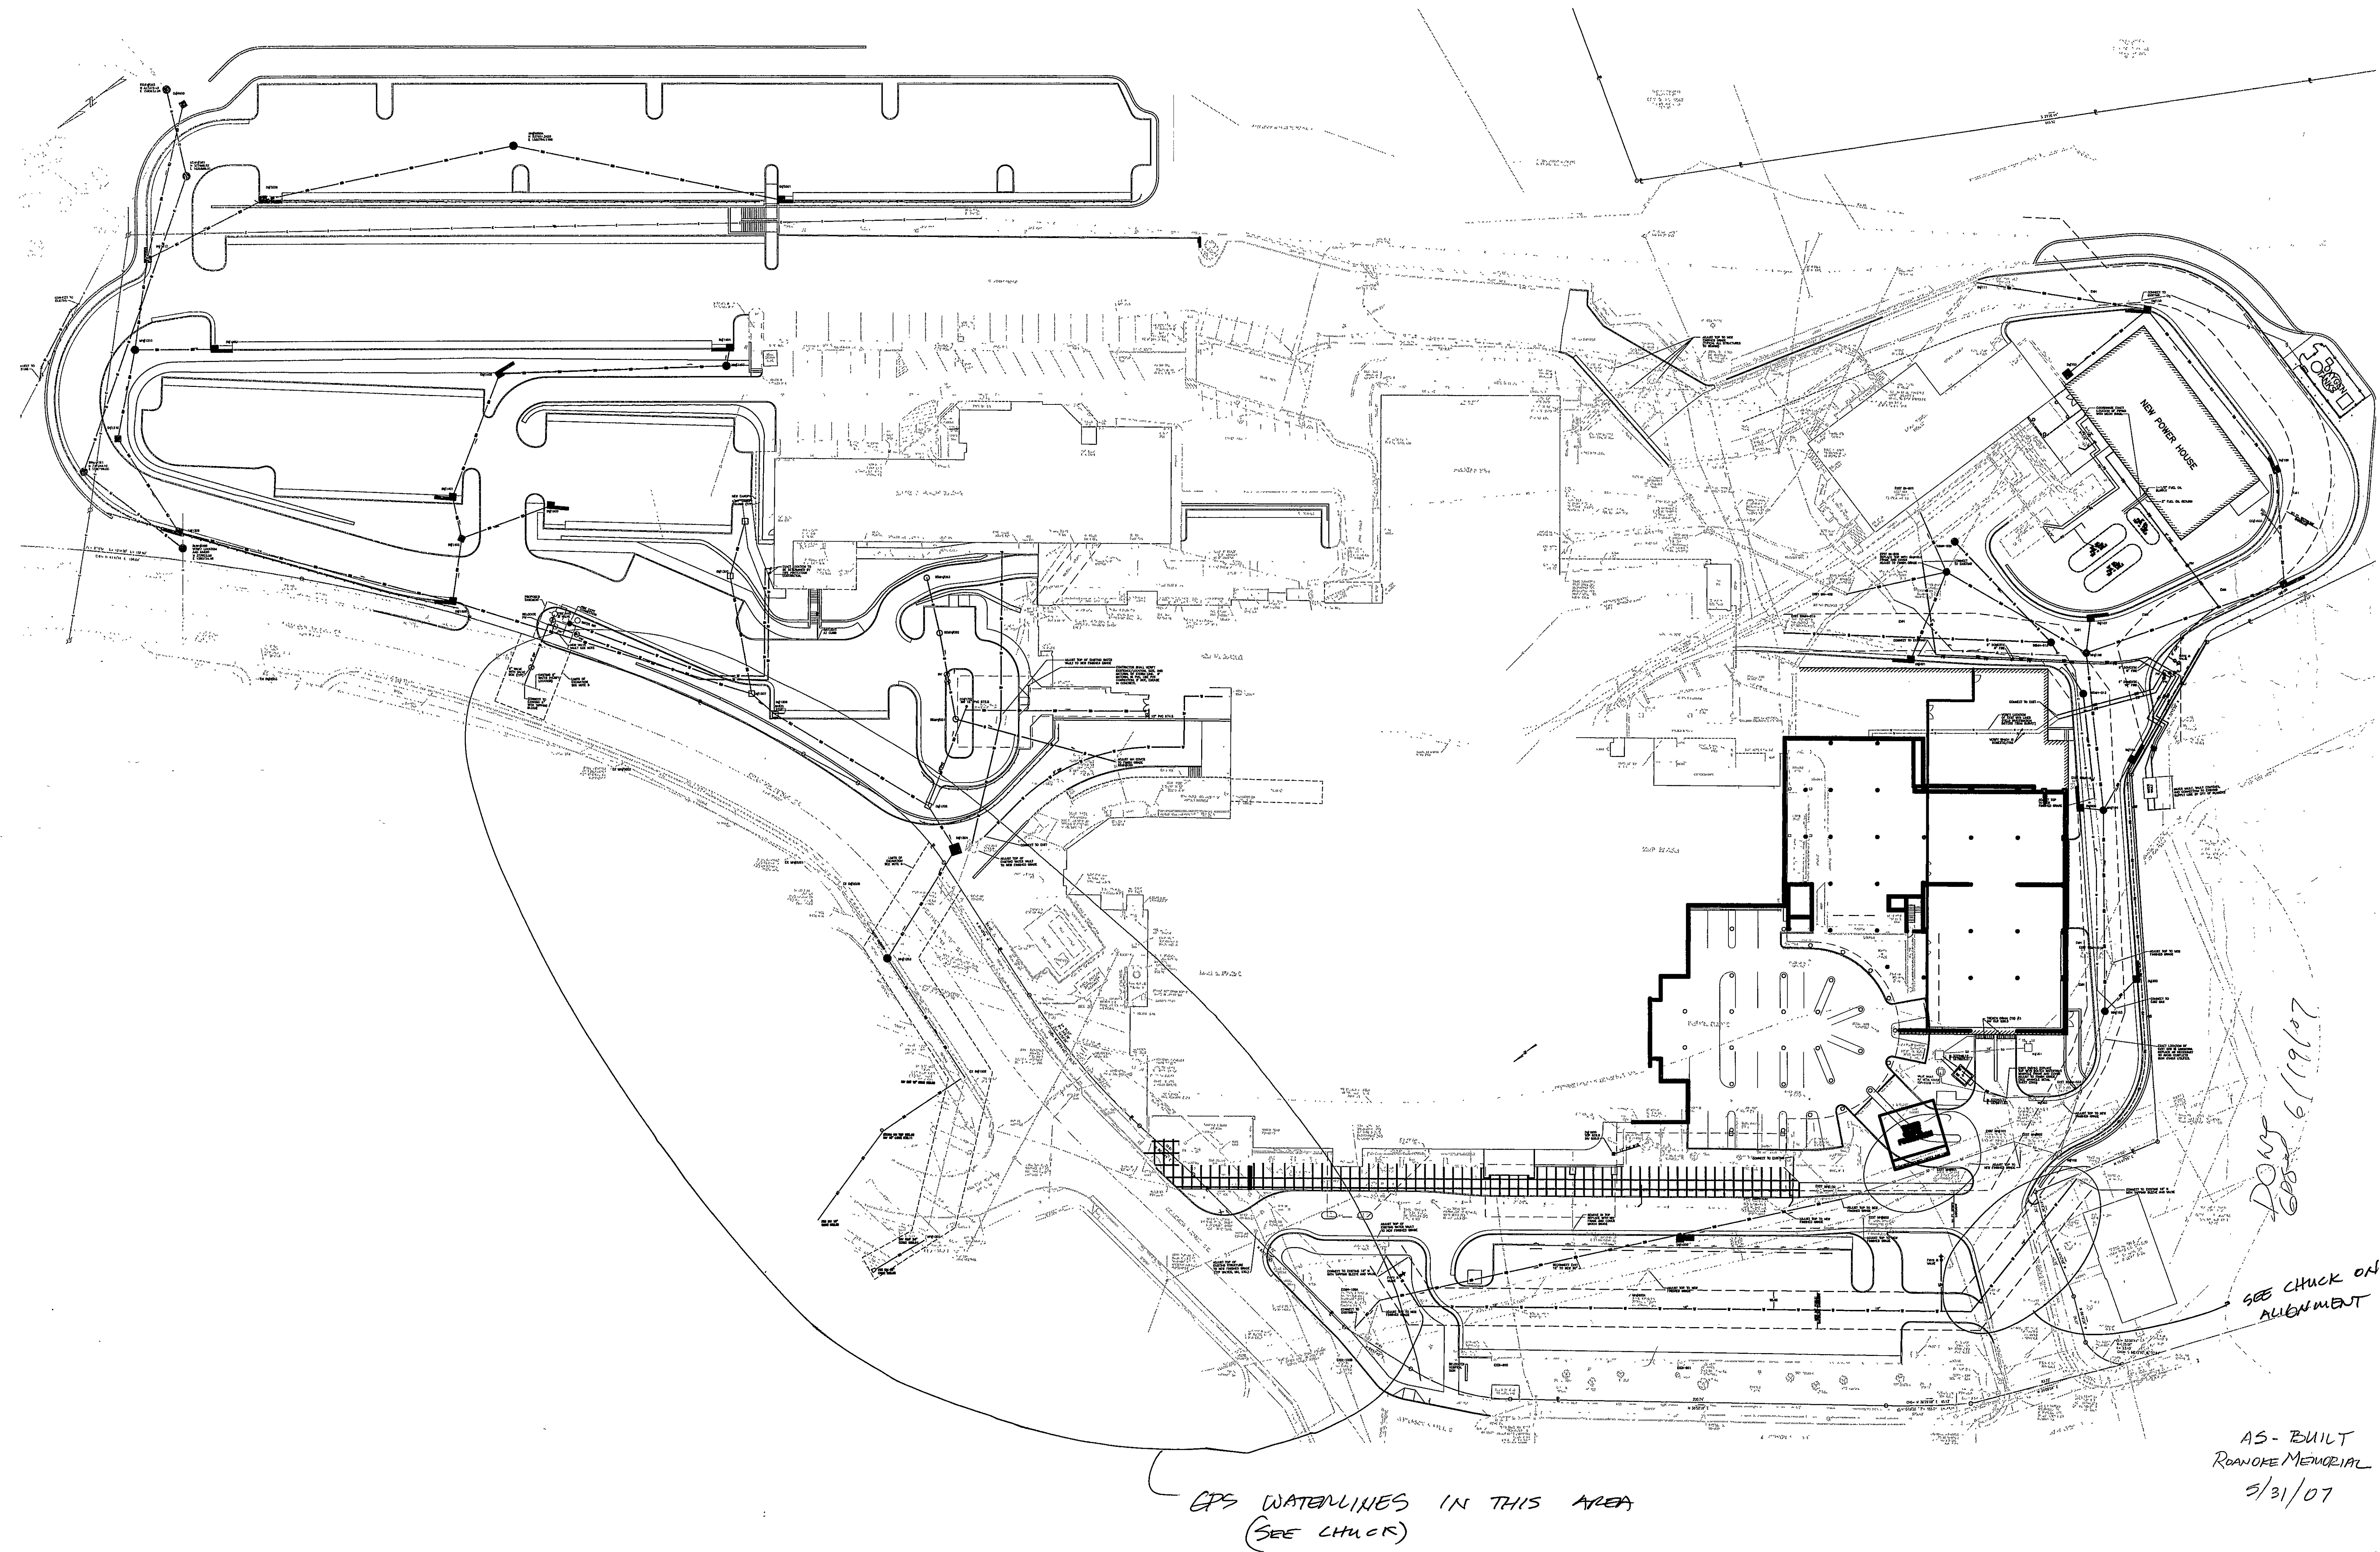

GPS WATERLINES IN THIS AREA
(SEE CHUCK)

Done
6/19/07

SEE CHUCK ON
ALIGNMENT

AS-BUILT
ROANOKE MEMORIAL
5/31/07