


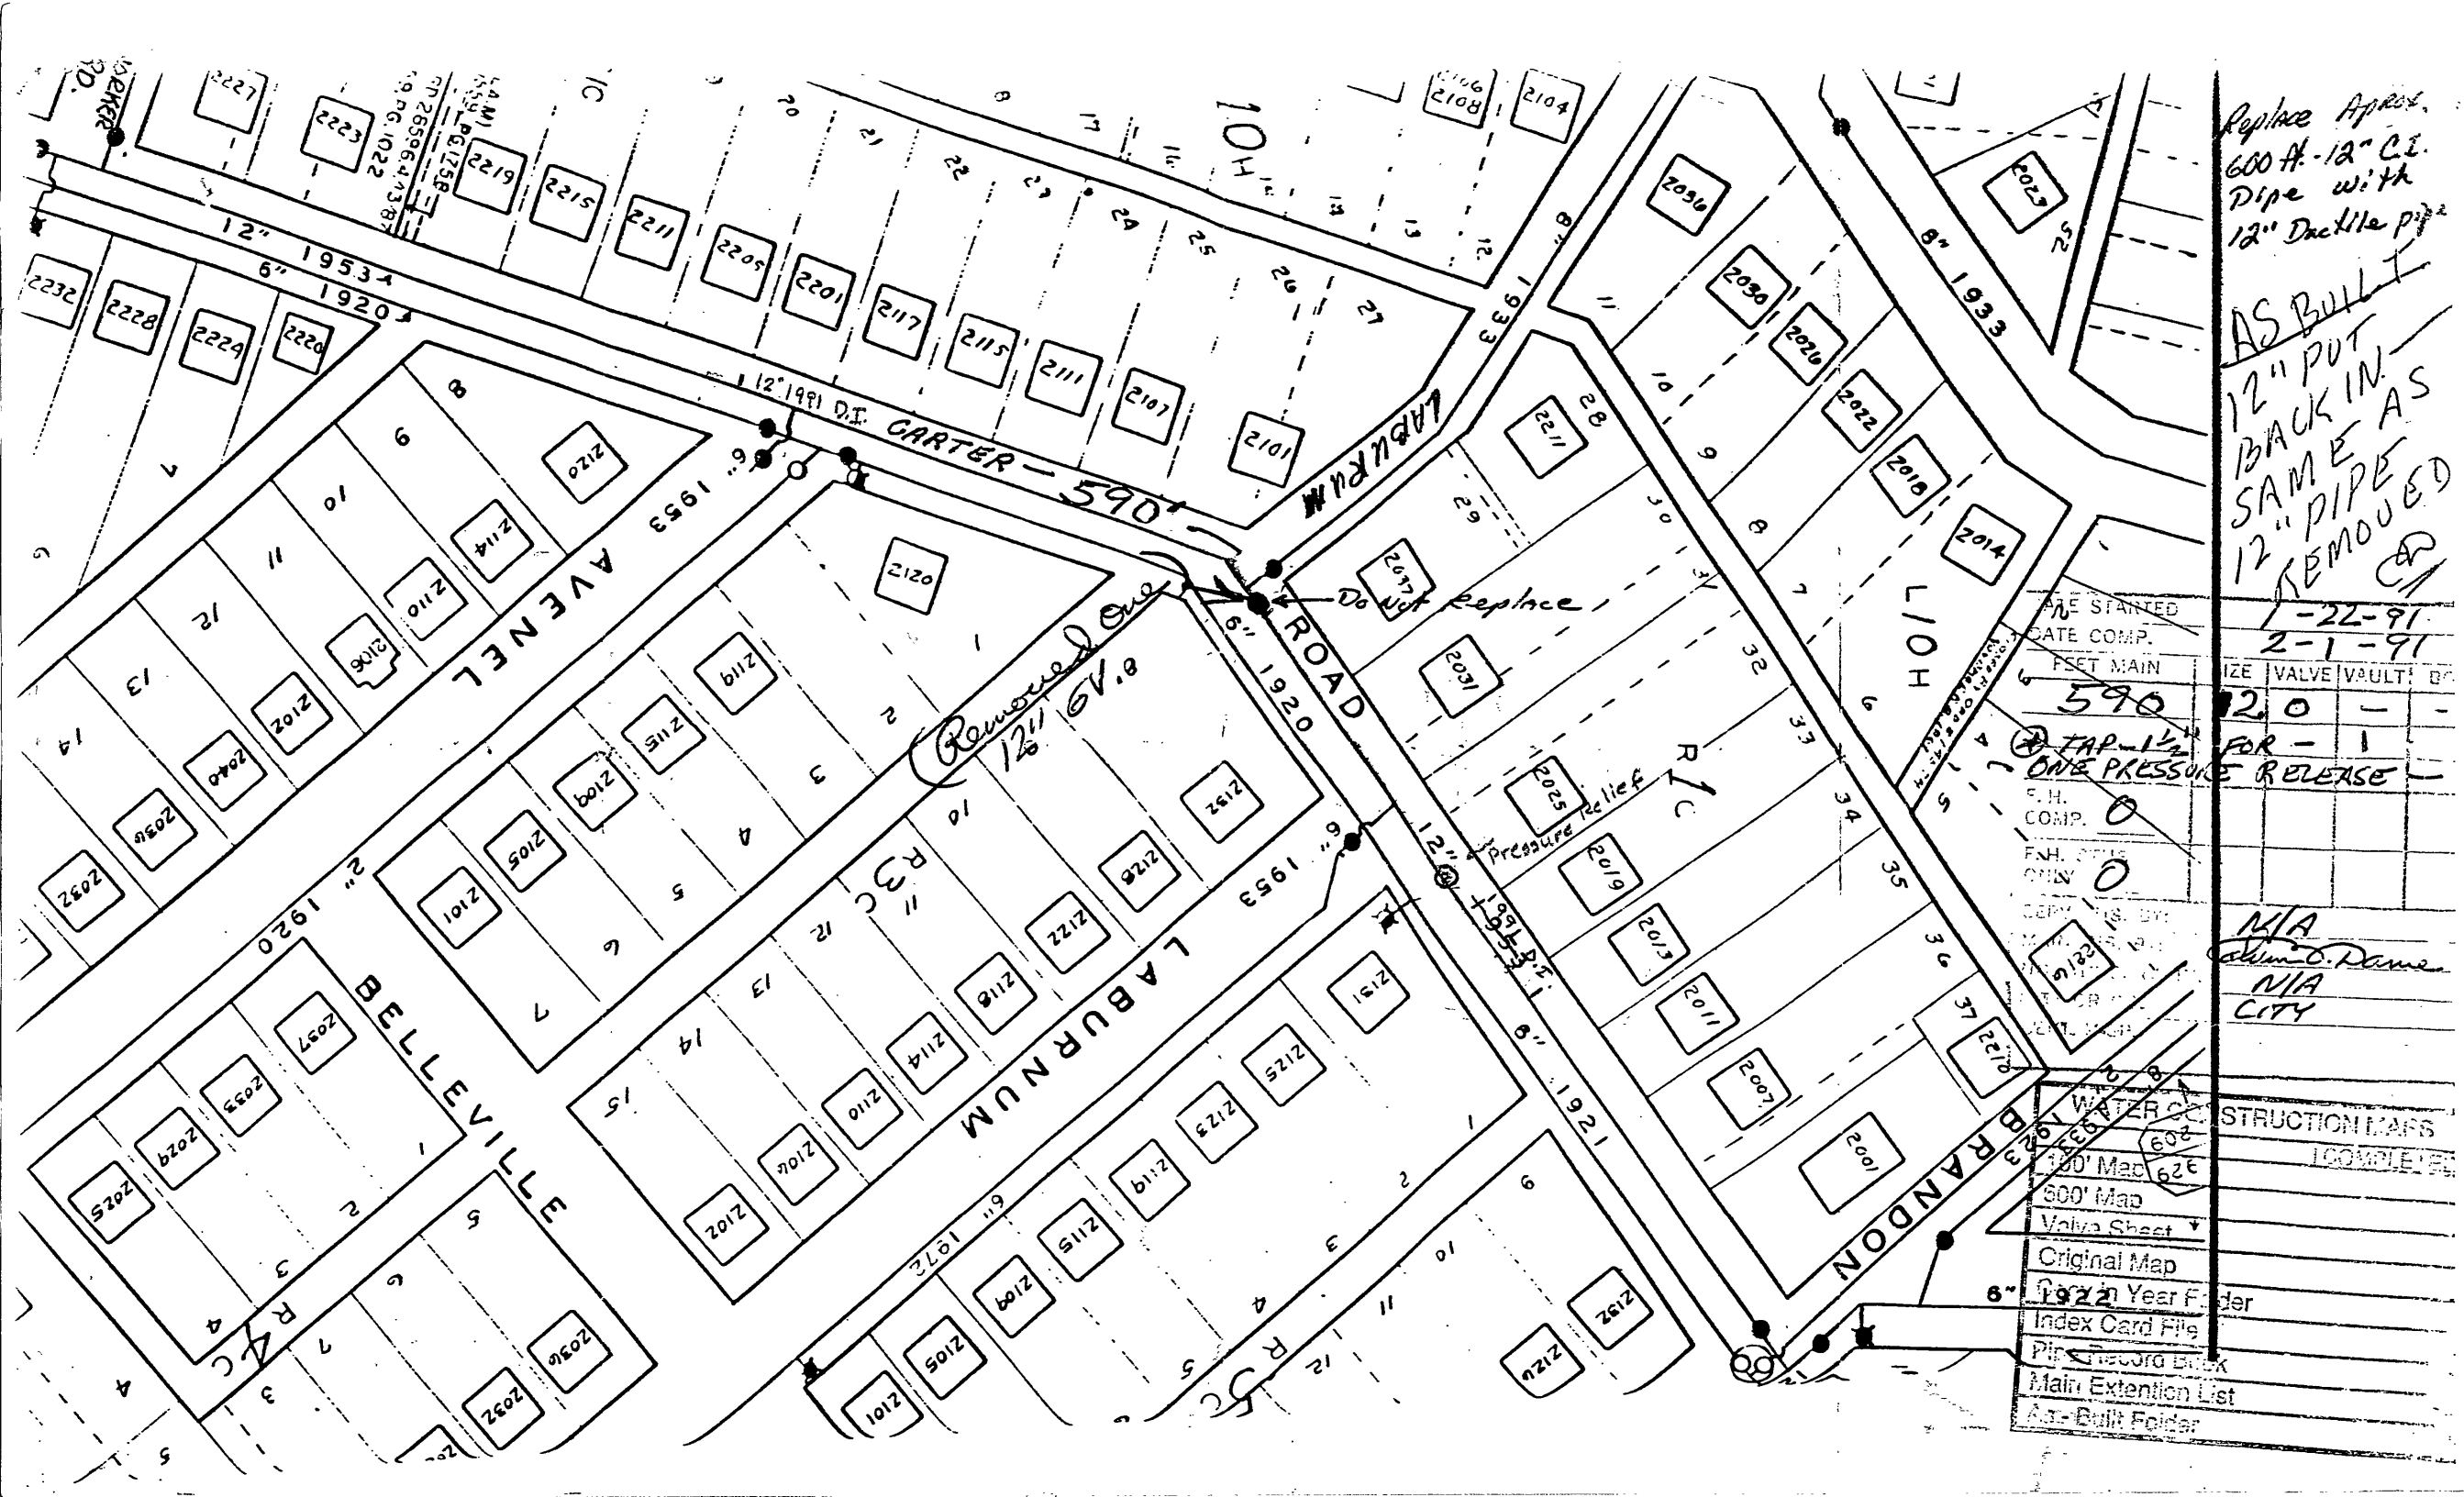

Replace Approx.
600 ft. 12" C.I.
Pipe with
12" Ductile pipe
AS BUILT
12" PUT
BACK IN
SAME AS
12" PIPE
REMOVED

DATE STARTED	DATE COMP.	FEET MAIN	SIZE	VALVE	VAULT	BY
1-22-91	2-1-91	590	12.0	-	-	-
TAP-12" FOR - 1						
ONE PRESSURE RELEASE						
F.H. COMP. 0						
F.H. ONLY 0						
SERV. INS. BY						
N/A						
N/A						
N/A						
CITY						

WATER CO.	CONSTRUCTION MAPS
100' Map	100' Map
300' Map	300' Map
Valve Sheet	Valve Sheet
Original Map	Original Map
1922 Year Folder	1922 Year Folder
Index Card File	Index Card File
Pipe Record Book	Pipe Record Book
Main Extension List	Main Extension List
As-Built Folder	As-Built Folder