
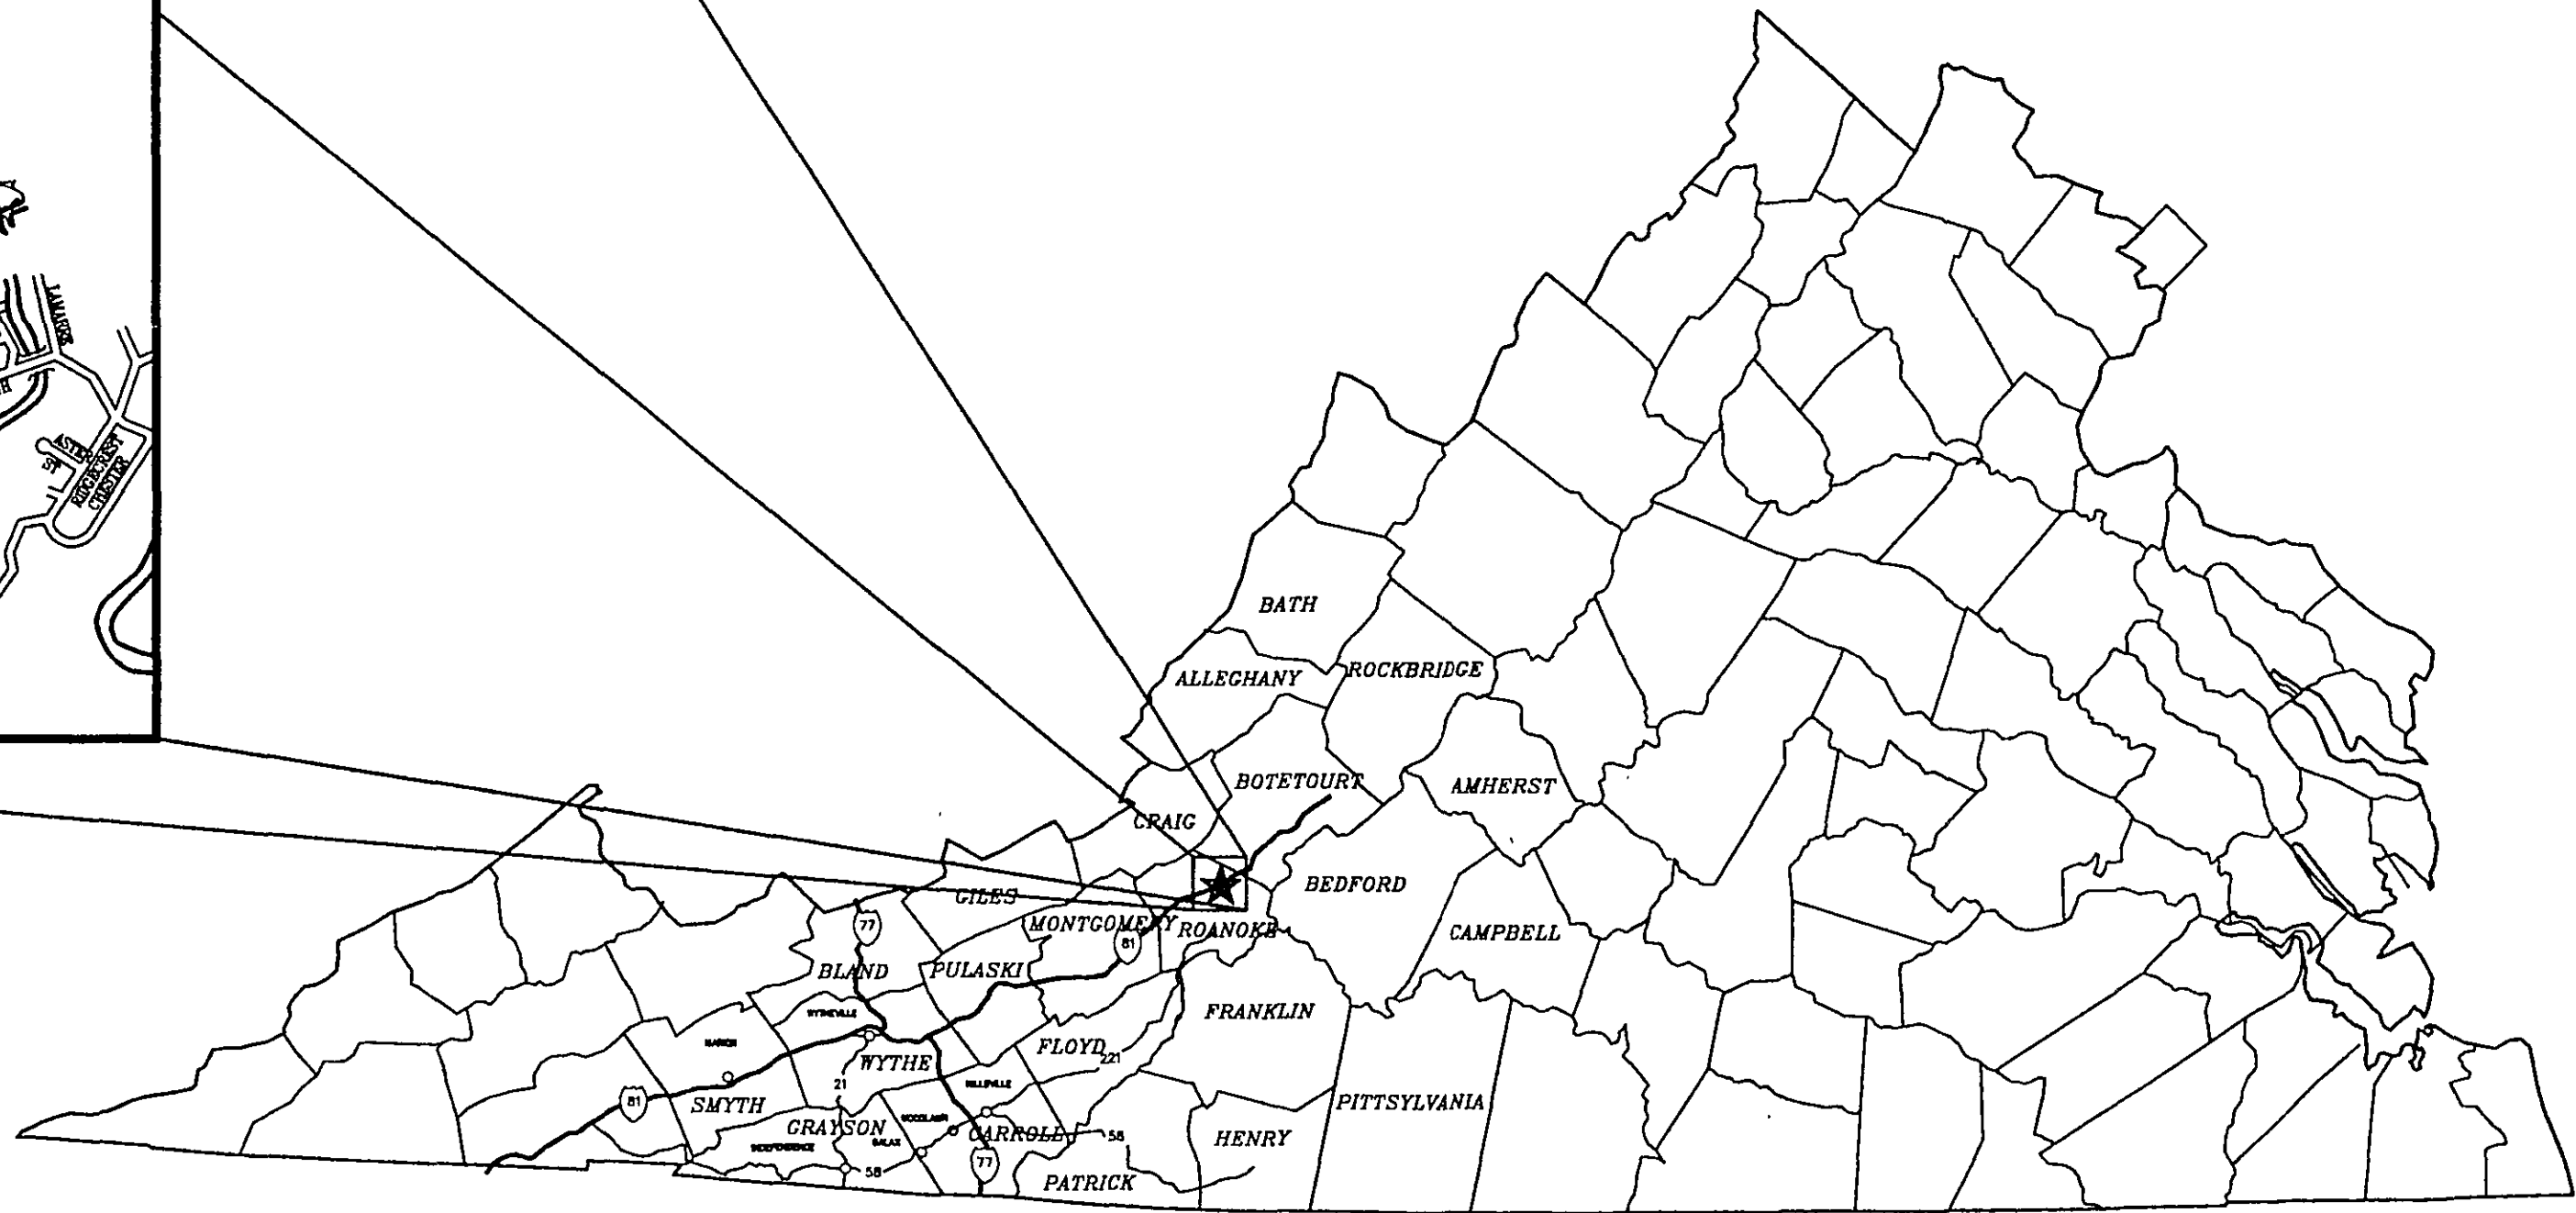


CARVINS COVE PHASE II
WATER IMPROVEMENTS PROJECT
CONTRACT A-1
ROANOKE, VIRGINIA


VICINITY MAP

NOT TO SCALE

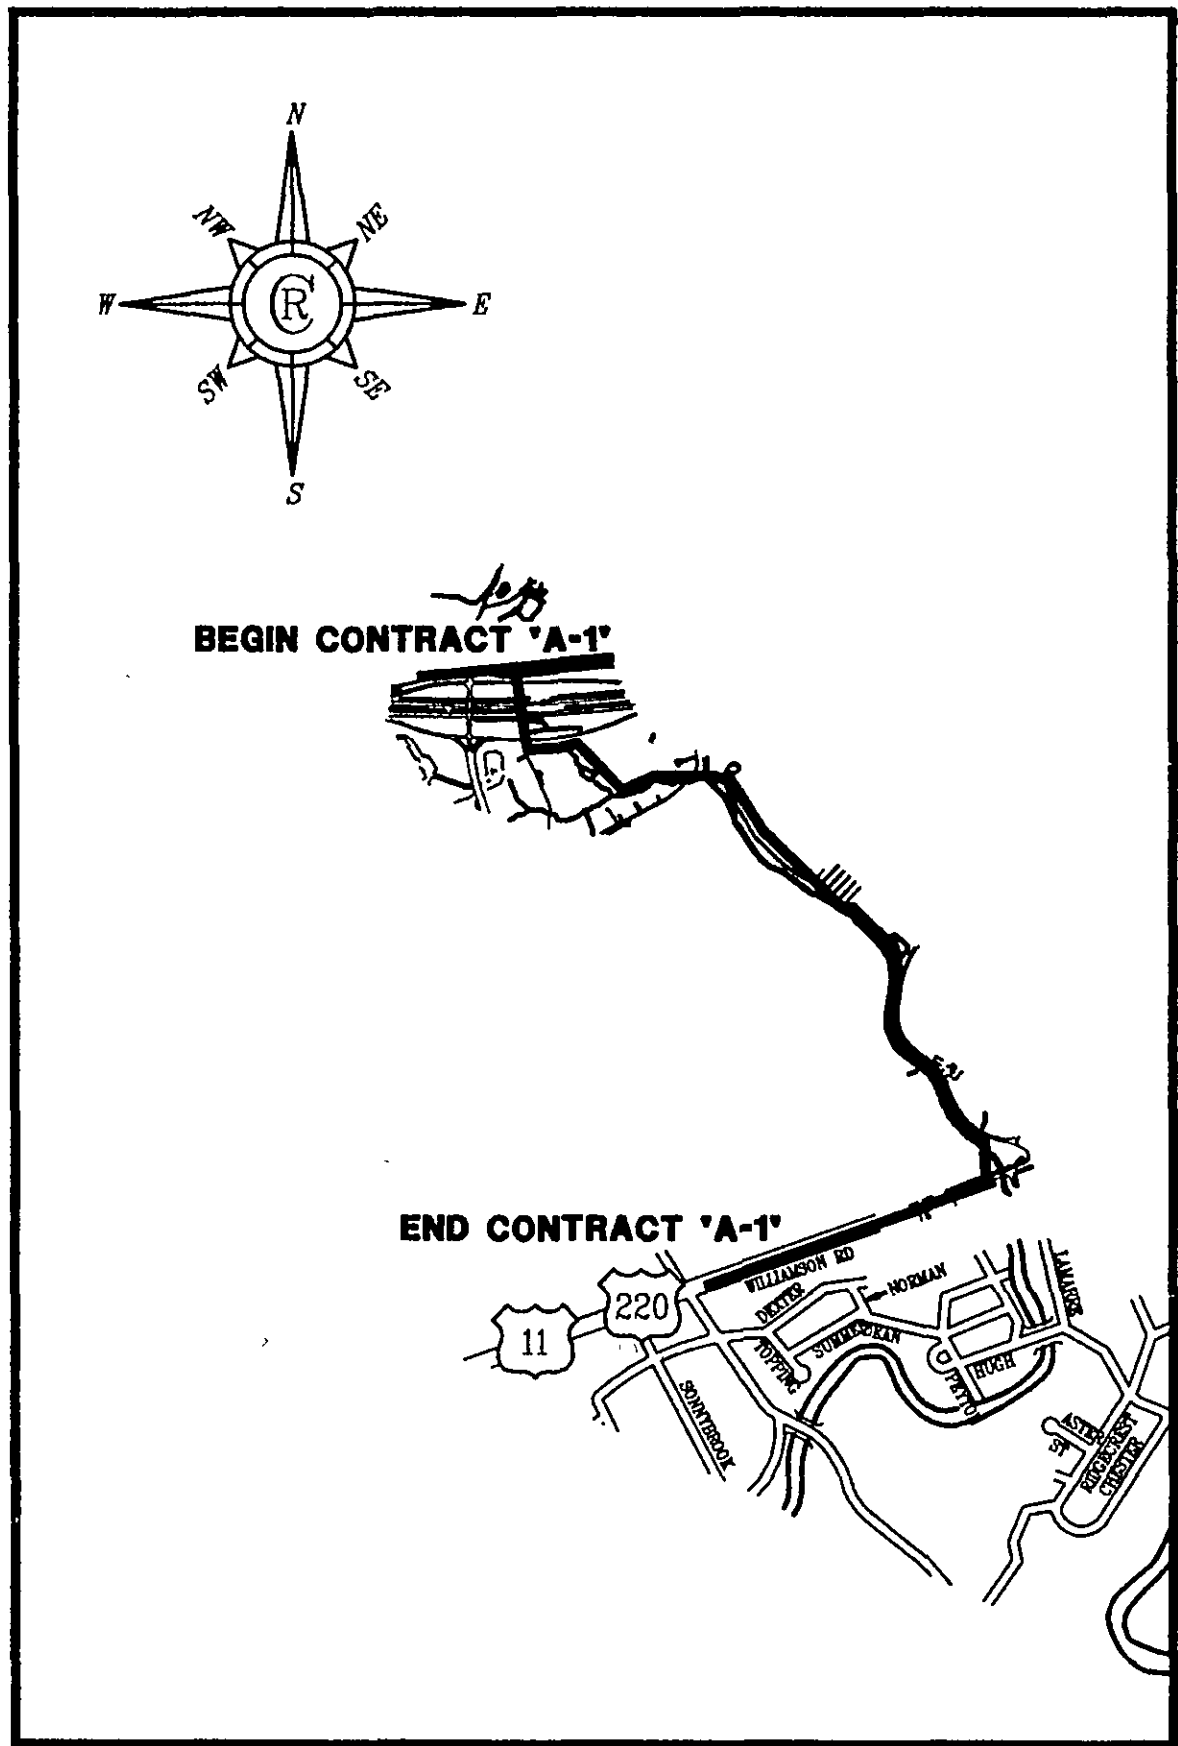

INDEX OF SHEETS

SHEET	TITLE	
1	LINE 100	STA. 0+00.00 TO 8+74.72
2	LINE 100	STA. 8+74.72 TO 22+48.08
3	LINE 100	STA. 22+48.08 TO 36+08.83
4	LINE 100	STA. 36+08.83 TO 48+38.45
5	LINE 100	STA. 48+38.45 TO 60+89.70
6	LINE 100	STA. 60+89.70 TO 72+62.03
7	DETAILS	
8	DETAILS	
9	DETAILS / SOIL EROSION / LEGEND	

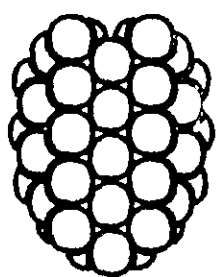


Dewberry & Davis

5238 VALLEYPONTE PARKWAY
SUITE ONE-B
ROANOKE, VIRGINIA 24019
(703) 362-7725

Contractor's Set

As BUILT DWGS 1/23/95

MEASURED BY BOB WELLS Supt.
Carvins Cove
A-1

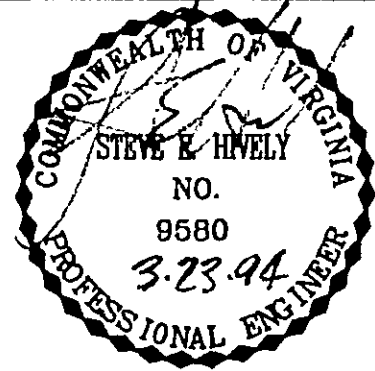

ENGINEER'S SEAL