

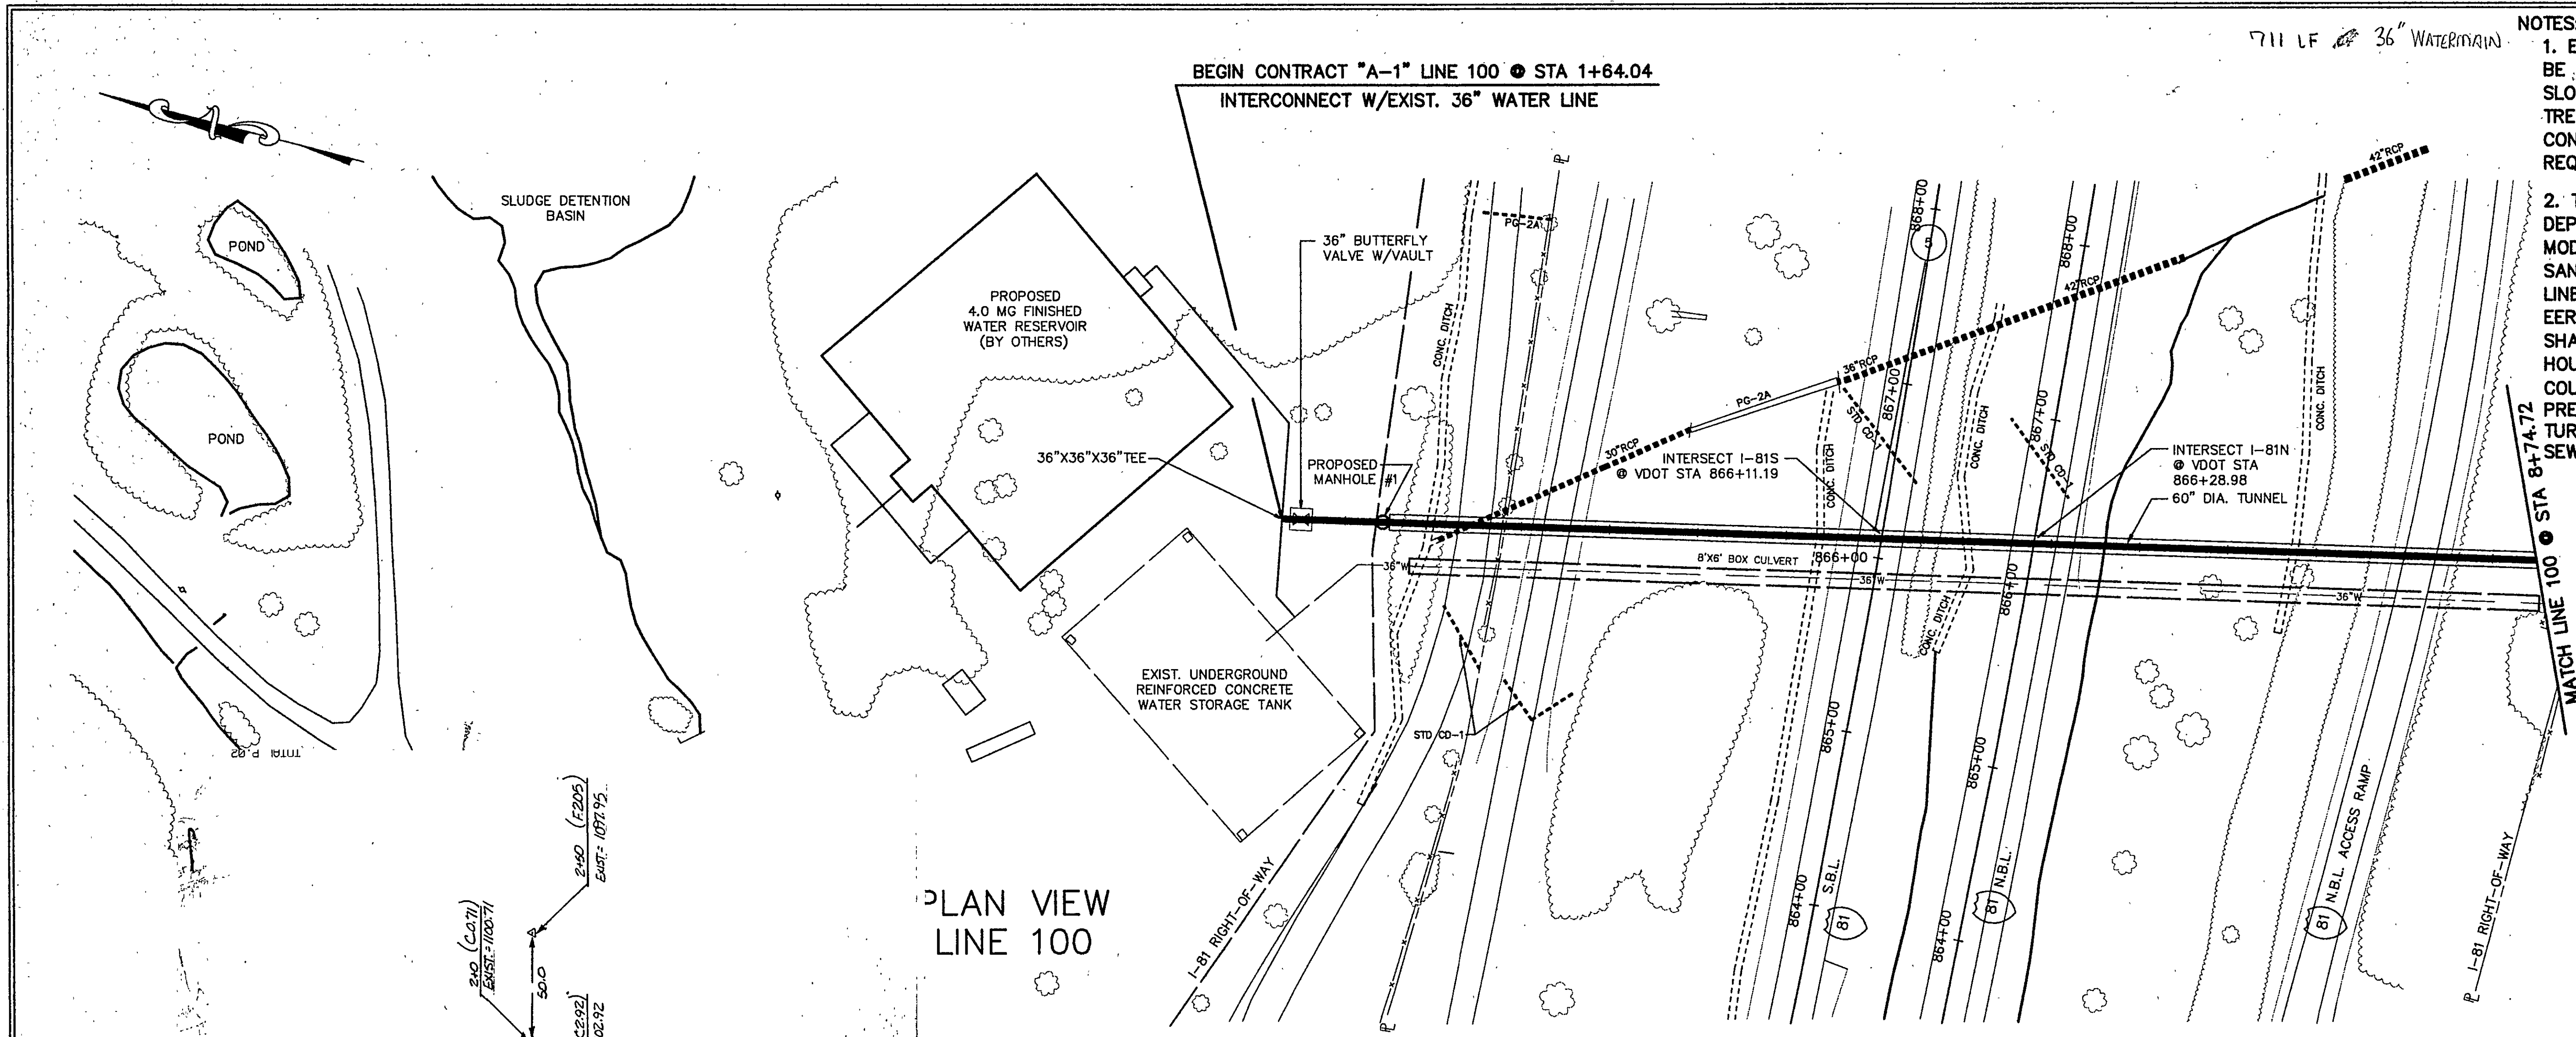
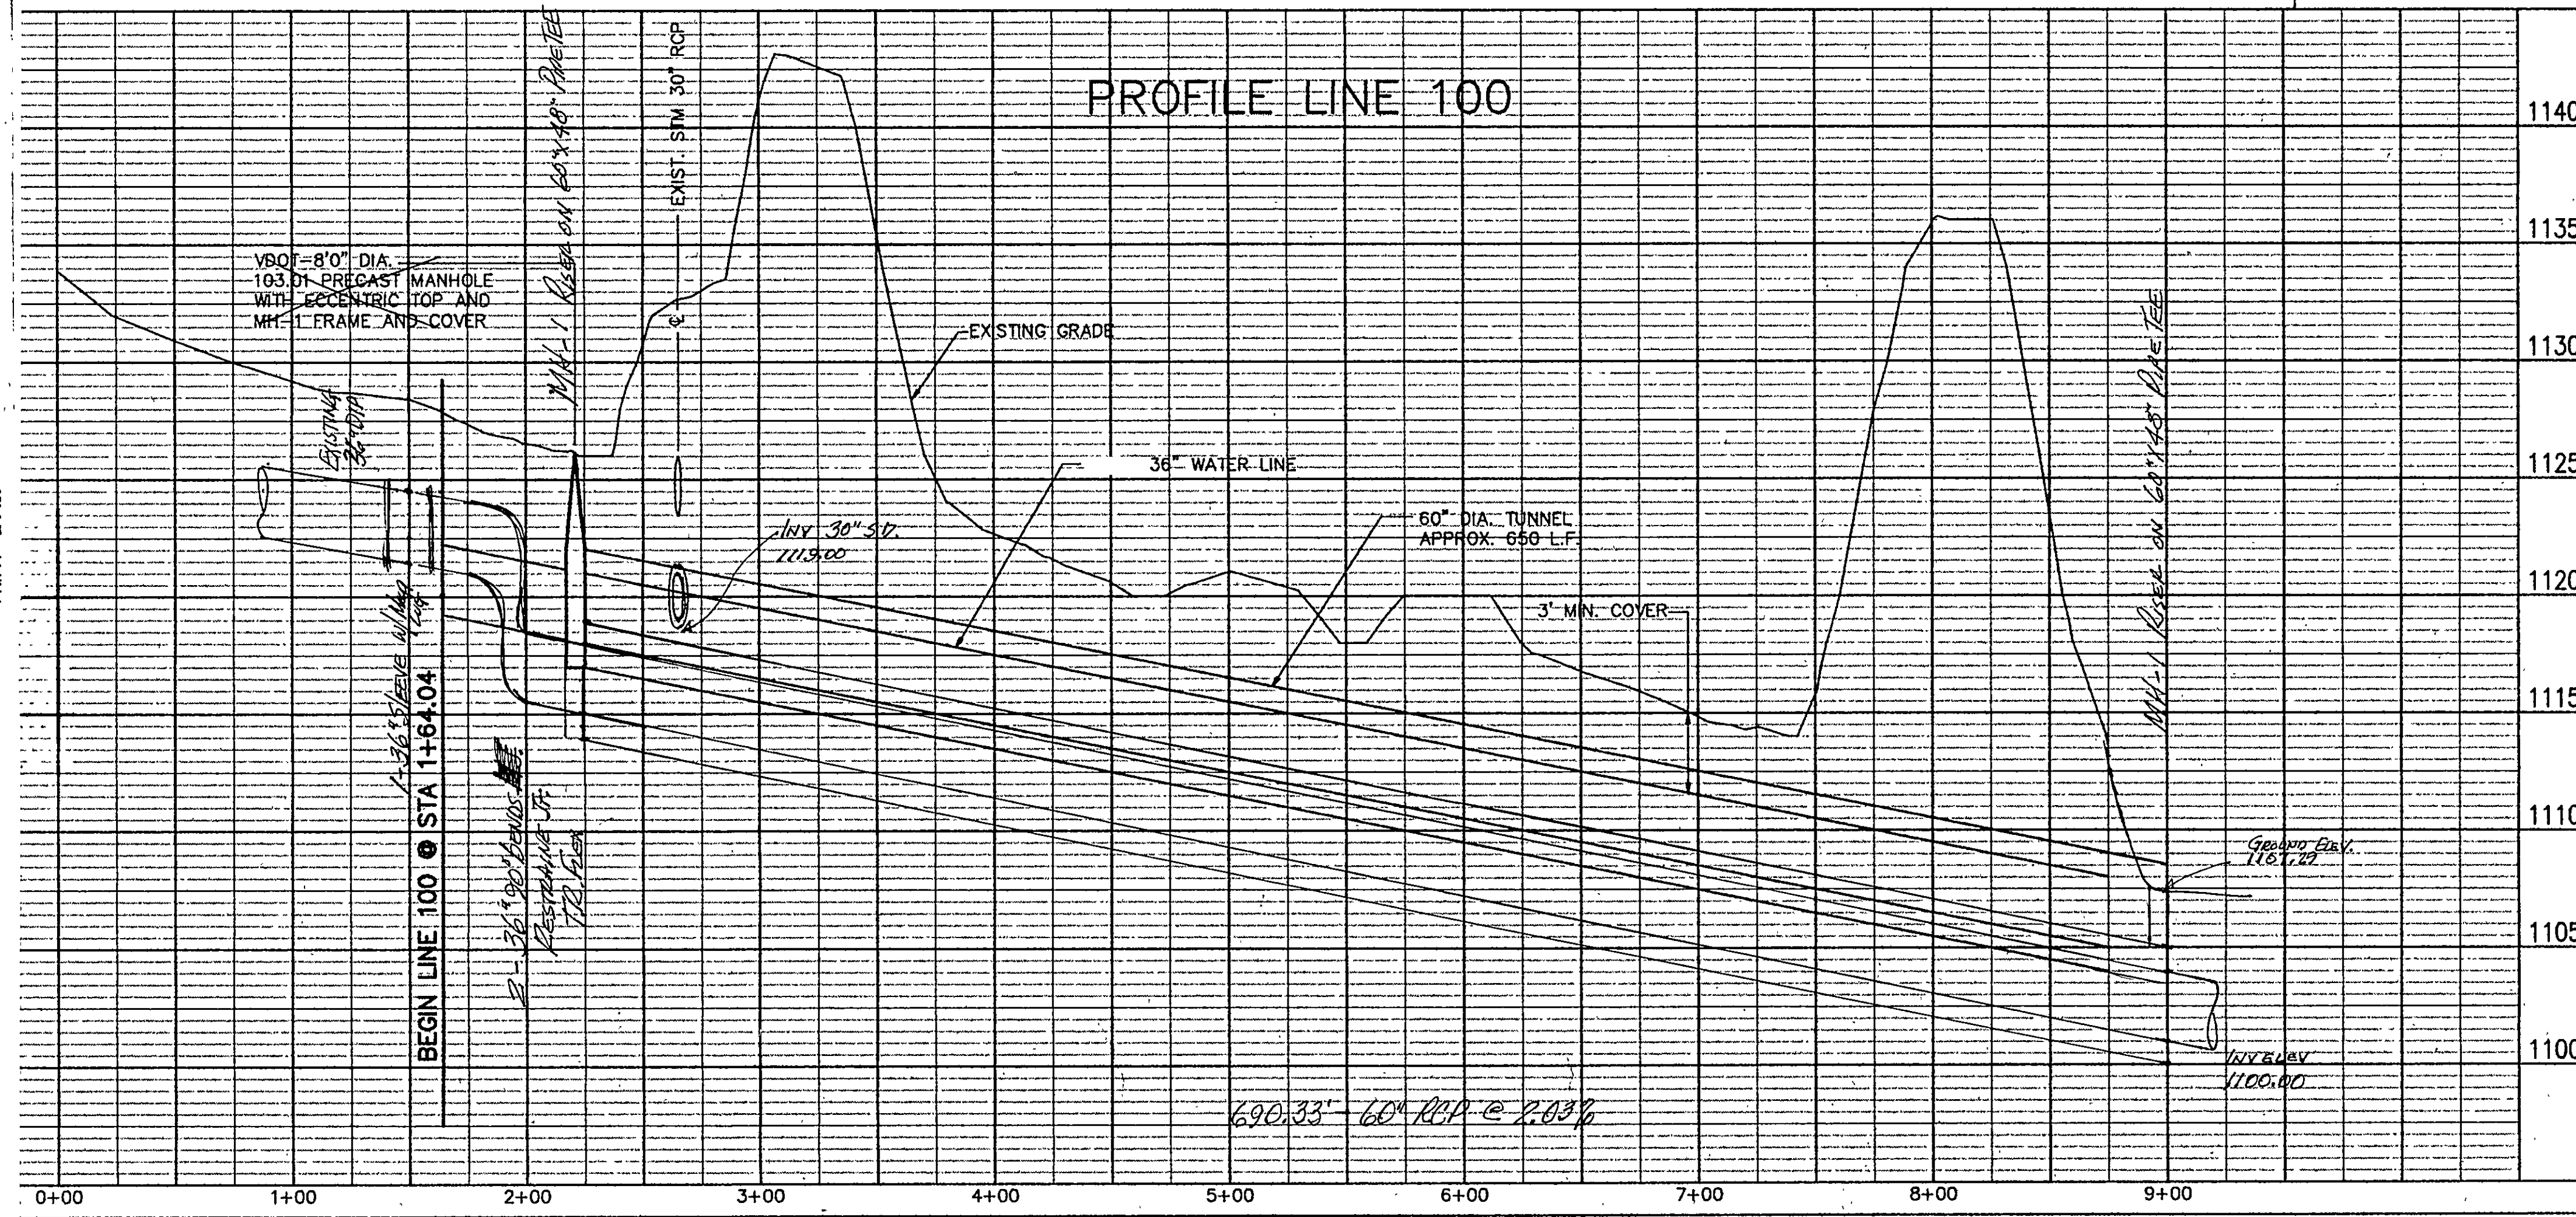


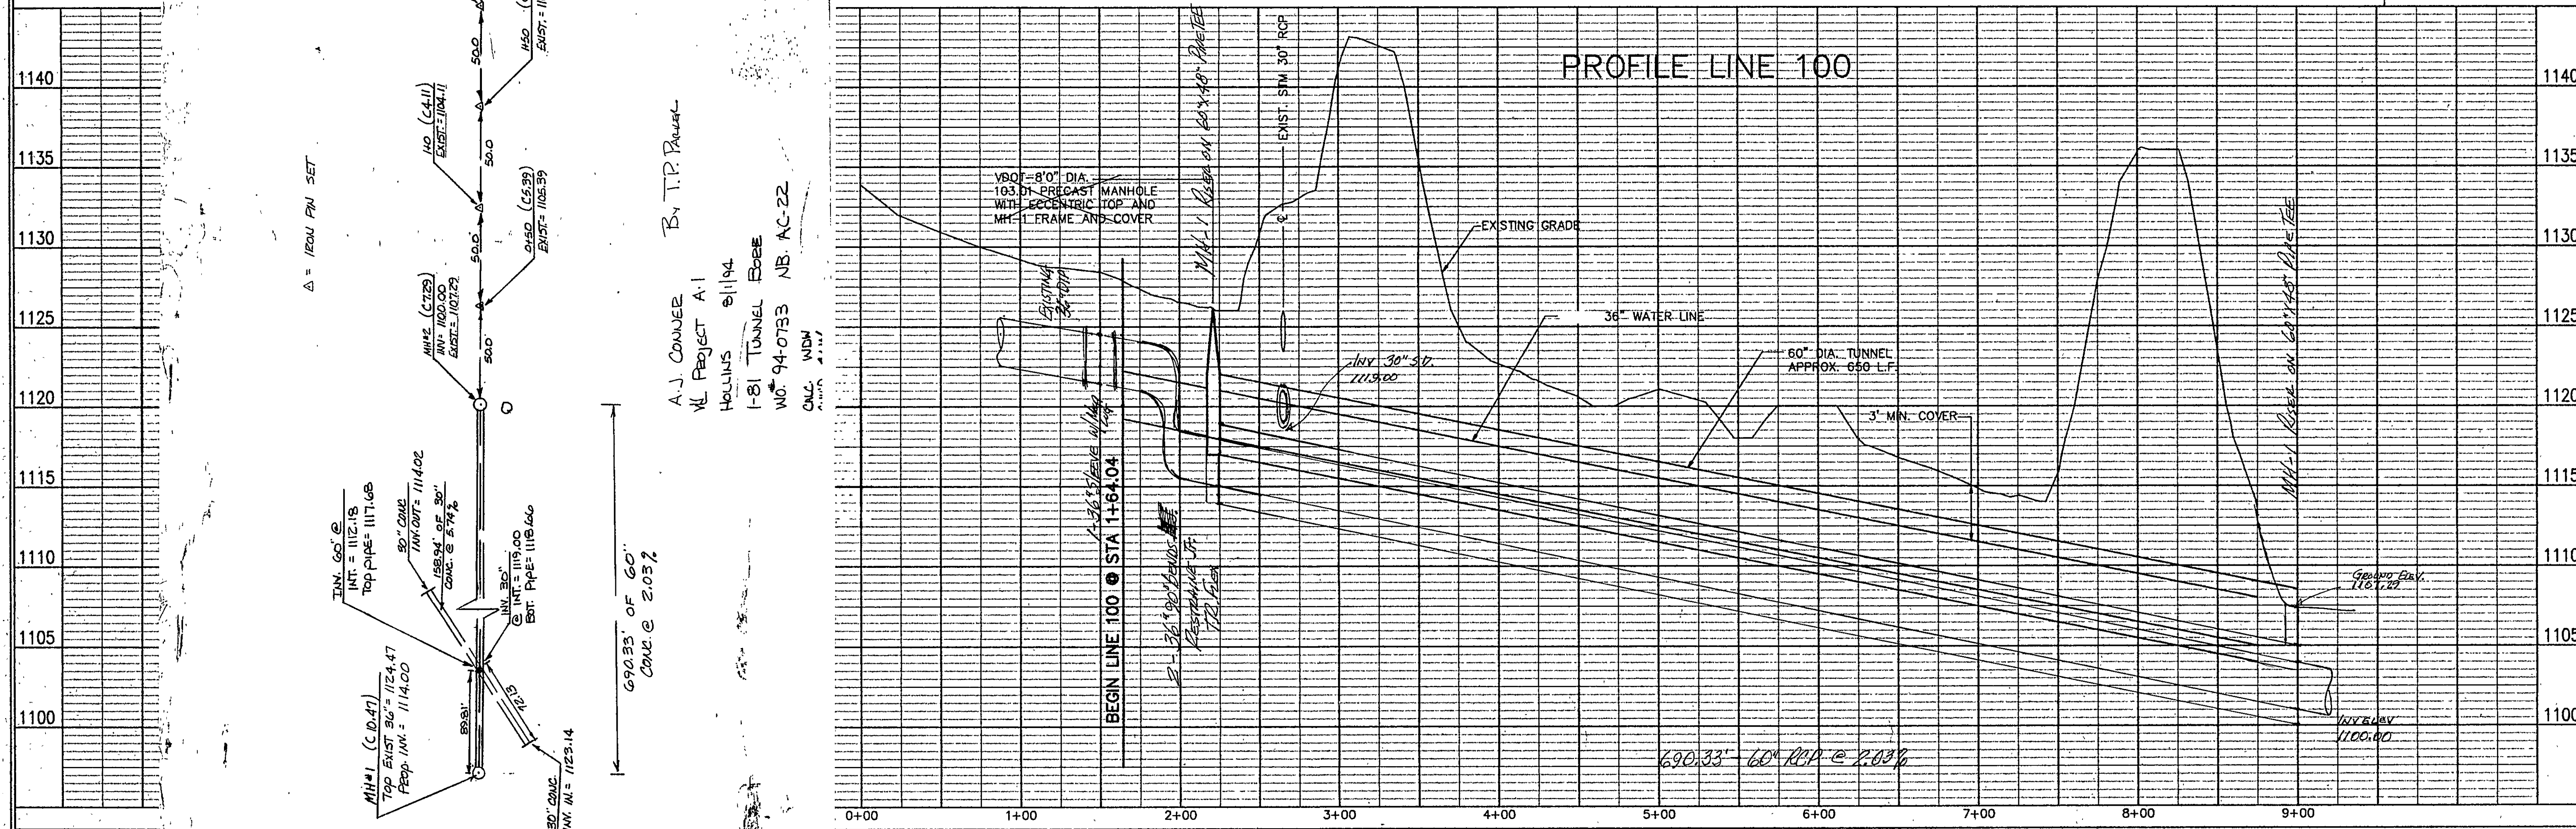

NOTES:

1. EROSION CONTROL MEASURES BE INSTALLED ON THE DOWN SLOPE OF THE EXCAVATED TRENCH. ADDITIONAL EROSION CONTROL MEASURES MAY BE REQUIRED BY ROANOKE COUNTY.

2. THE ROANOKE COUNTY UTILITY DEPARTMENT WILL MAKE ALL MODIFICATIONS/REPAIRS TO SANITARY SEWER AND WATER LINES. ROANOKE COUNTY ENGINEERING INSPECTIONS DEPARTMENT SHALL BE NOTIFIED AT LEAST 72 HOURS PRIOR TO WORK AND A COUNTY INSPECTOR SHALL BE PRESENT PRIOR TO ANY DISTURBANCE WITHIN A SANITARY SEWER OR WATER EASEMENT.

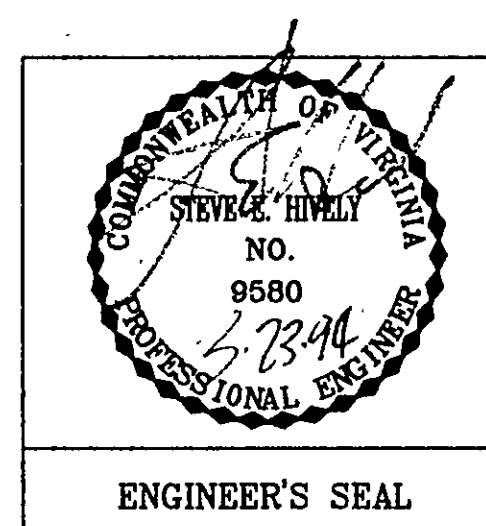

Carvins Cove, Phase II
City of Roanoke
Roanoke, Virginia

BEGIN CONTRACT "A-1"	
LINE 100	
STA 1+64.04 - 8+74.72	

Drawn By	ACF/RE
Designed By	RB
Checked By	SE
Date	DEC. 1993
Scale	
V:	1" = 5'
H:	1" = 50'
Plan Number	F1
Zoned	NONE
Sheet	1 of 9
File Number	C1160