



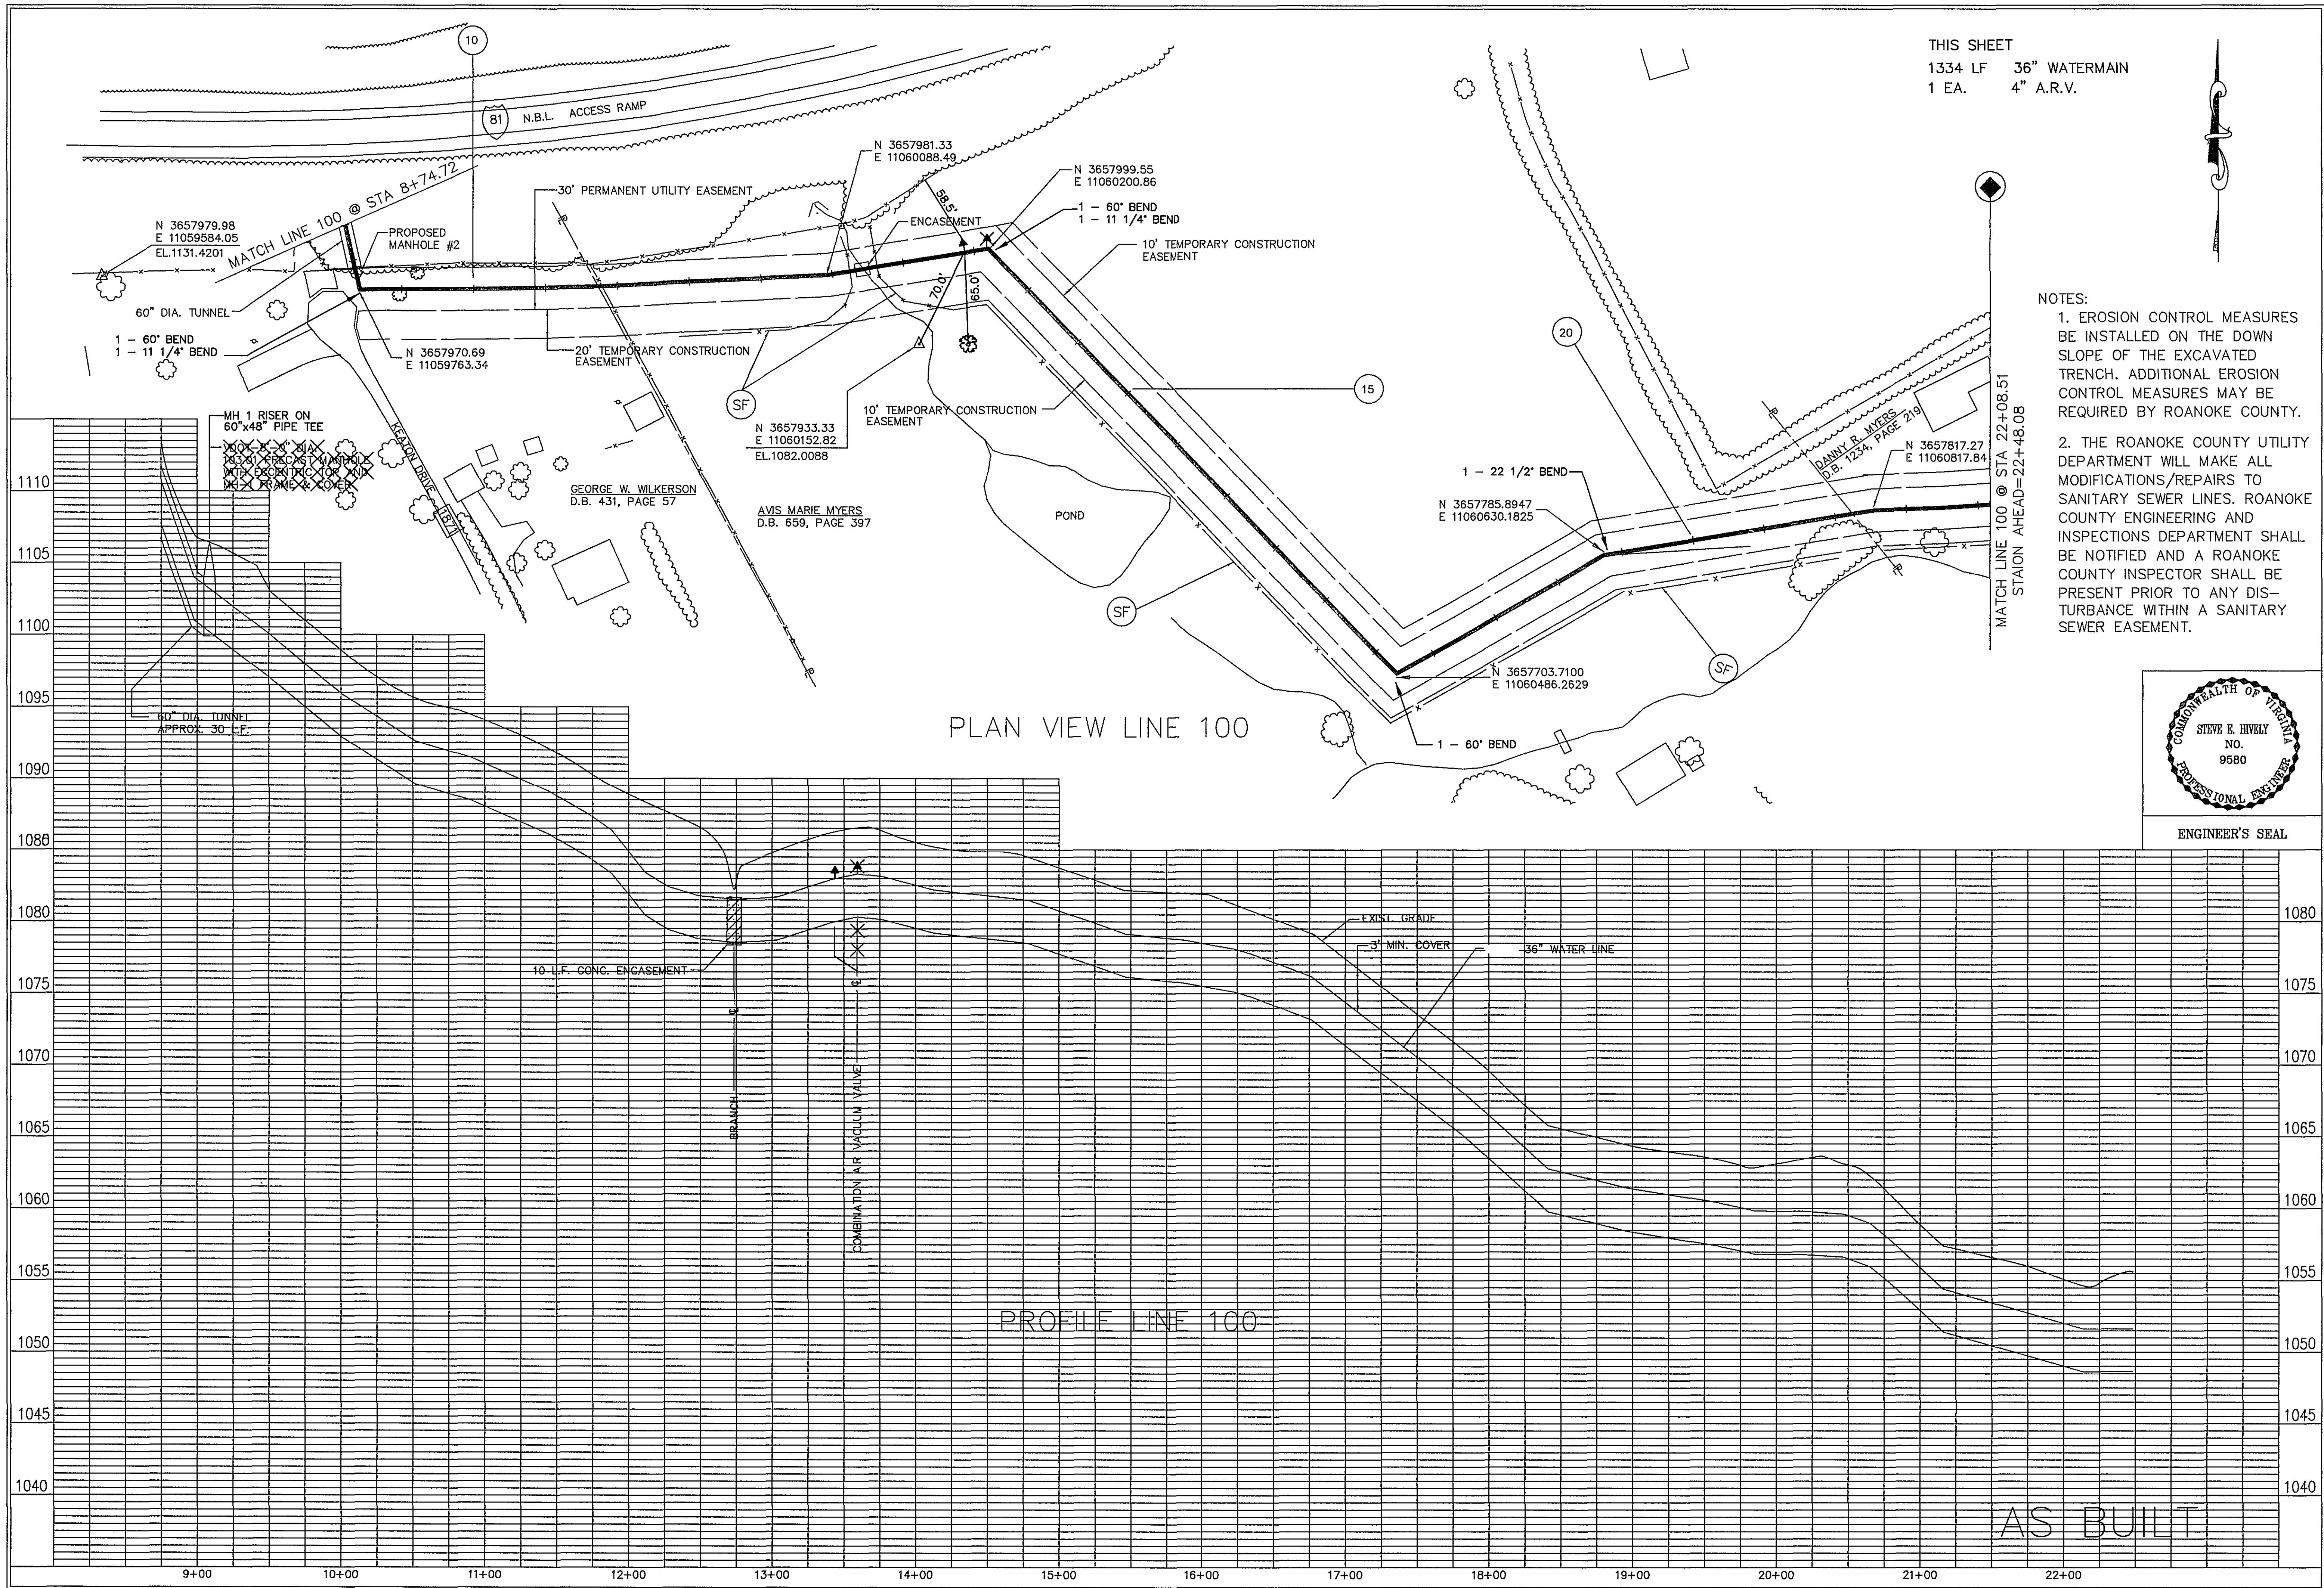

THIS SHEET
1334 LF 36" WATERMAIN
1 EA. 4" A.R.V.

- NOTES:
1. EROSION CONTROL MEASURES BE INSTALLED ON THE DOWN SLOPE OF THE EXCAVATED TRENCH. ADDITIONAL EROSION CONTROL MEASURES MAY BE REQUIRED BY ROANOKE COUNTY.
 2. THE ROANOKE COUNTY UTILITY DEPARTMENT WILL MAKE ALL MODIFICATIONS/REPAIRS TO SANITARY SEWER LINES. ROANOKE COUNTY ENGINEERING AND INSPECTIONS DEPARTMENT SHALL BE NOTIFIED AND A ROANOKE COUNTY INSPECTOR SHALL BE PRESENT PRIOR TO ANY DISTURBANCE WITHIN A SANITARY SEWER EASEMENT.

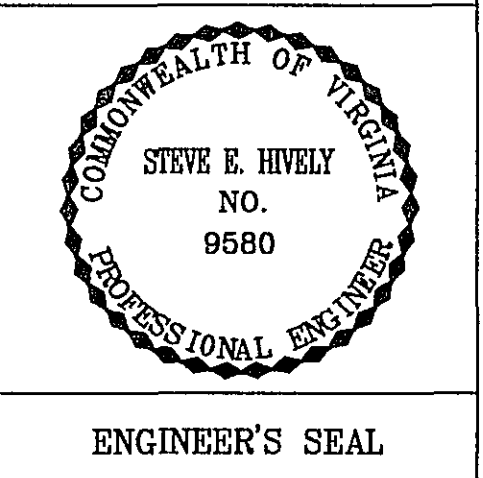

Architects
Engineers
Planners
Surveyors

Dewberry & Davis

5288 Valleypointe Parkway, Suite One-B
Roanoke, Virginia 24019
703 362-7725

Carvins Cove, Phase II

City of Roanoke
Roanoke, Virginia

CONTRACT "A-1"
LINE 100
STA 8+74.72 - 22+08.51

Drawn By ACF/REH
Designed By RBS
Checked By SEH
Date DEC. 1993
Scale V: 1" = 5'
H: 1" = 50'
Plan Number F2
Zoned NONE
Sheet 2 of 9
File Number C1160