
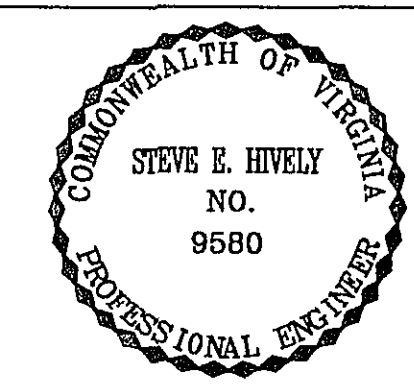
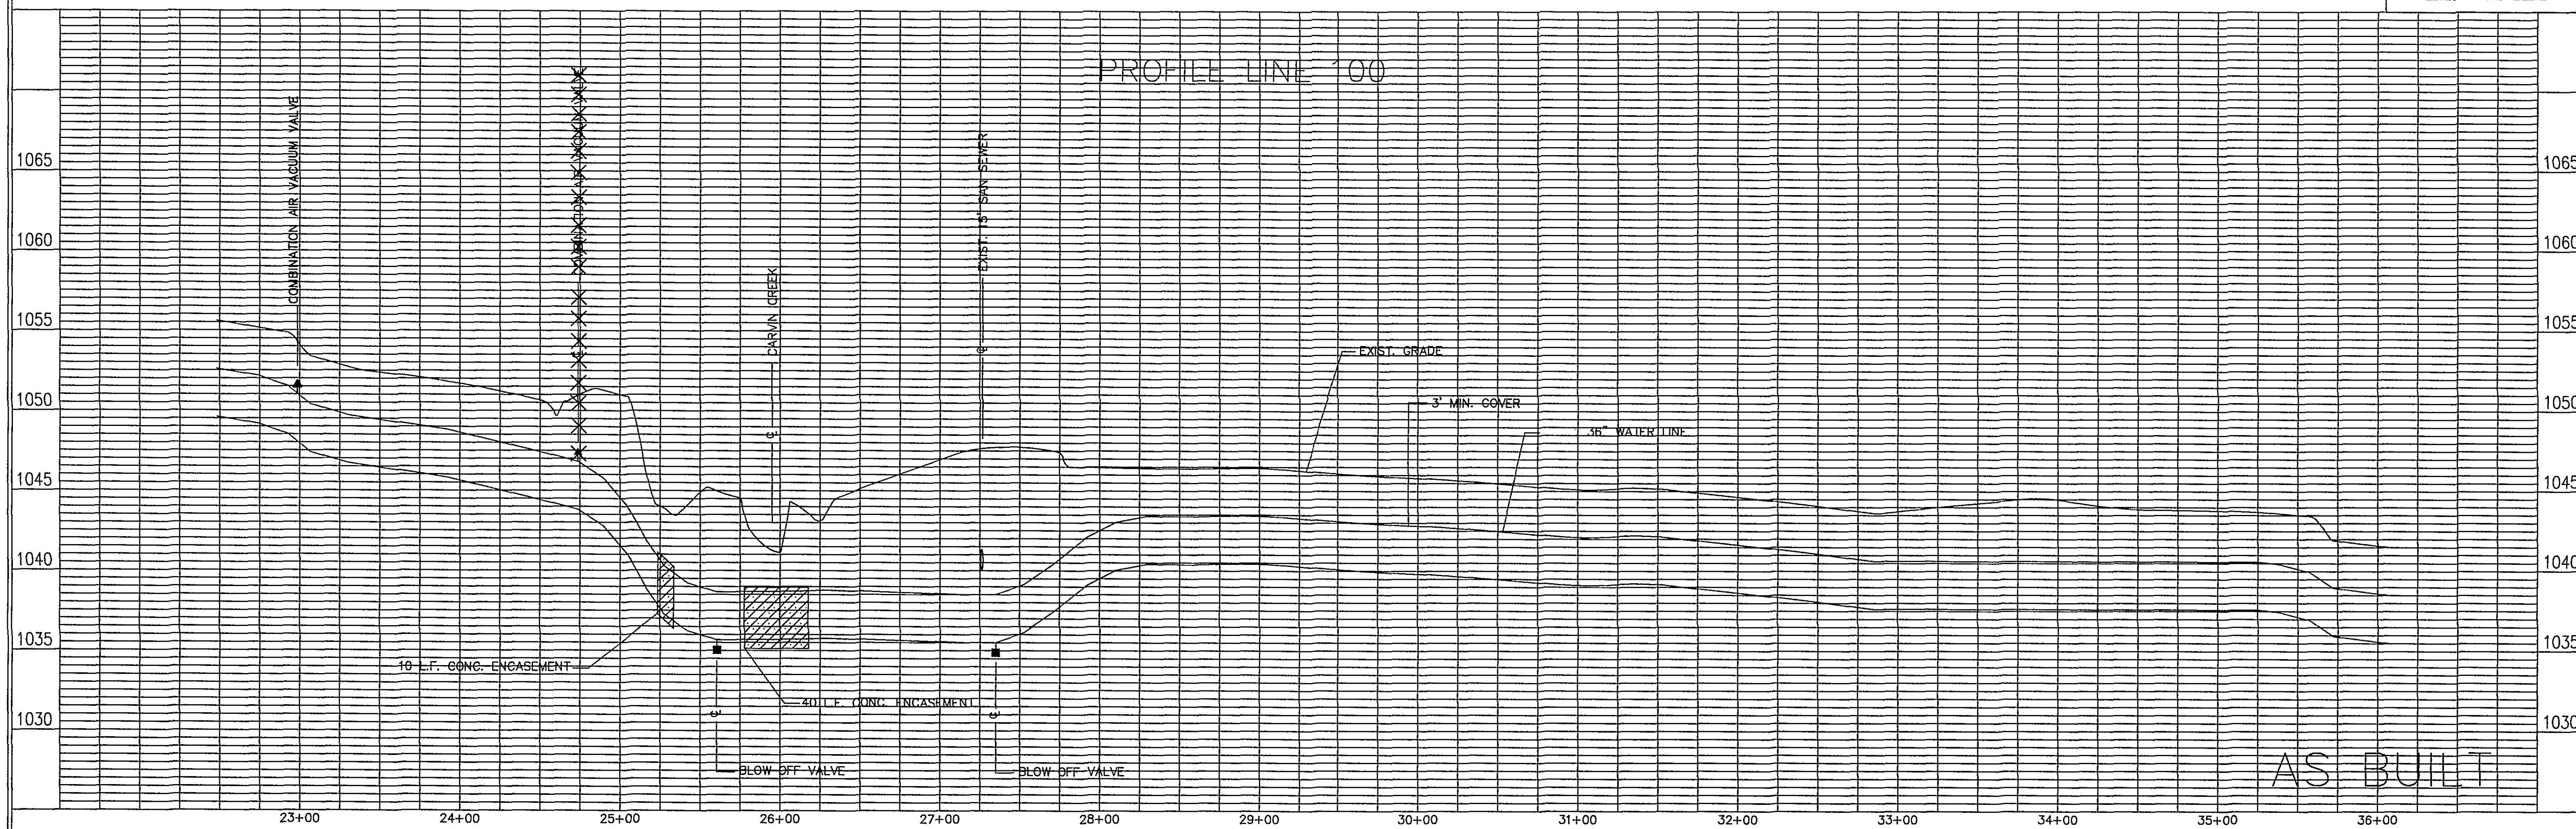


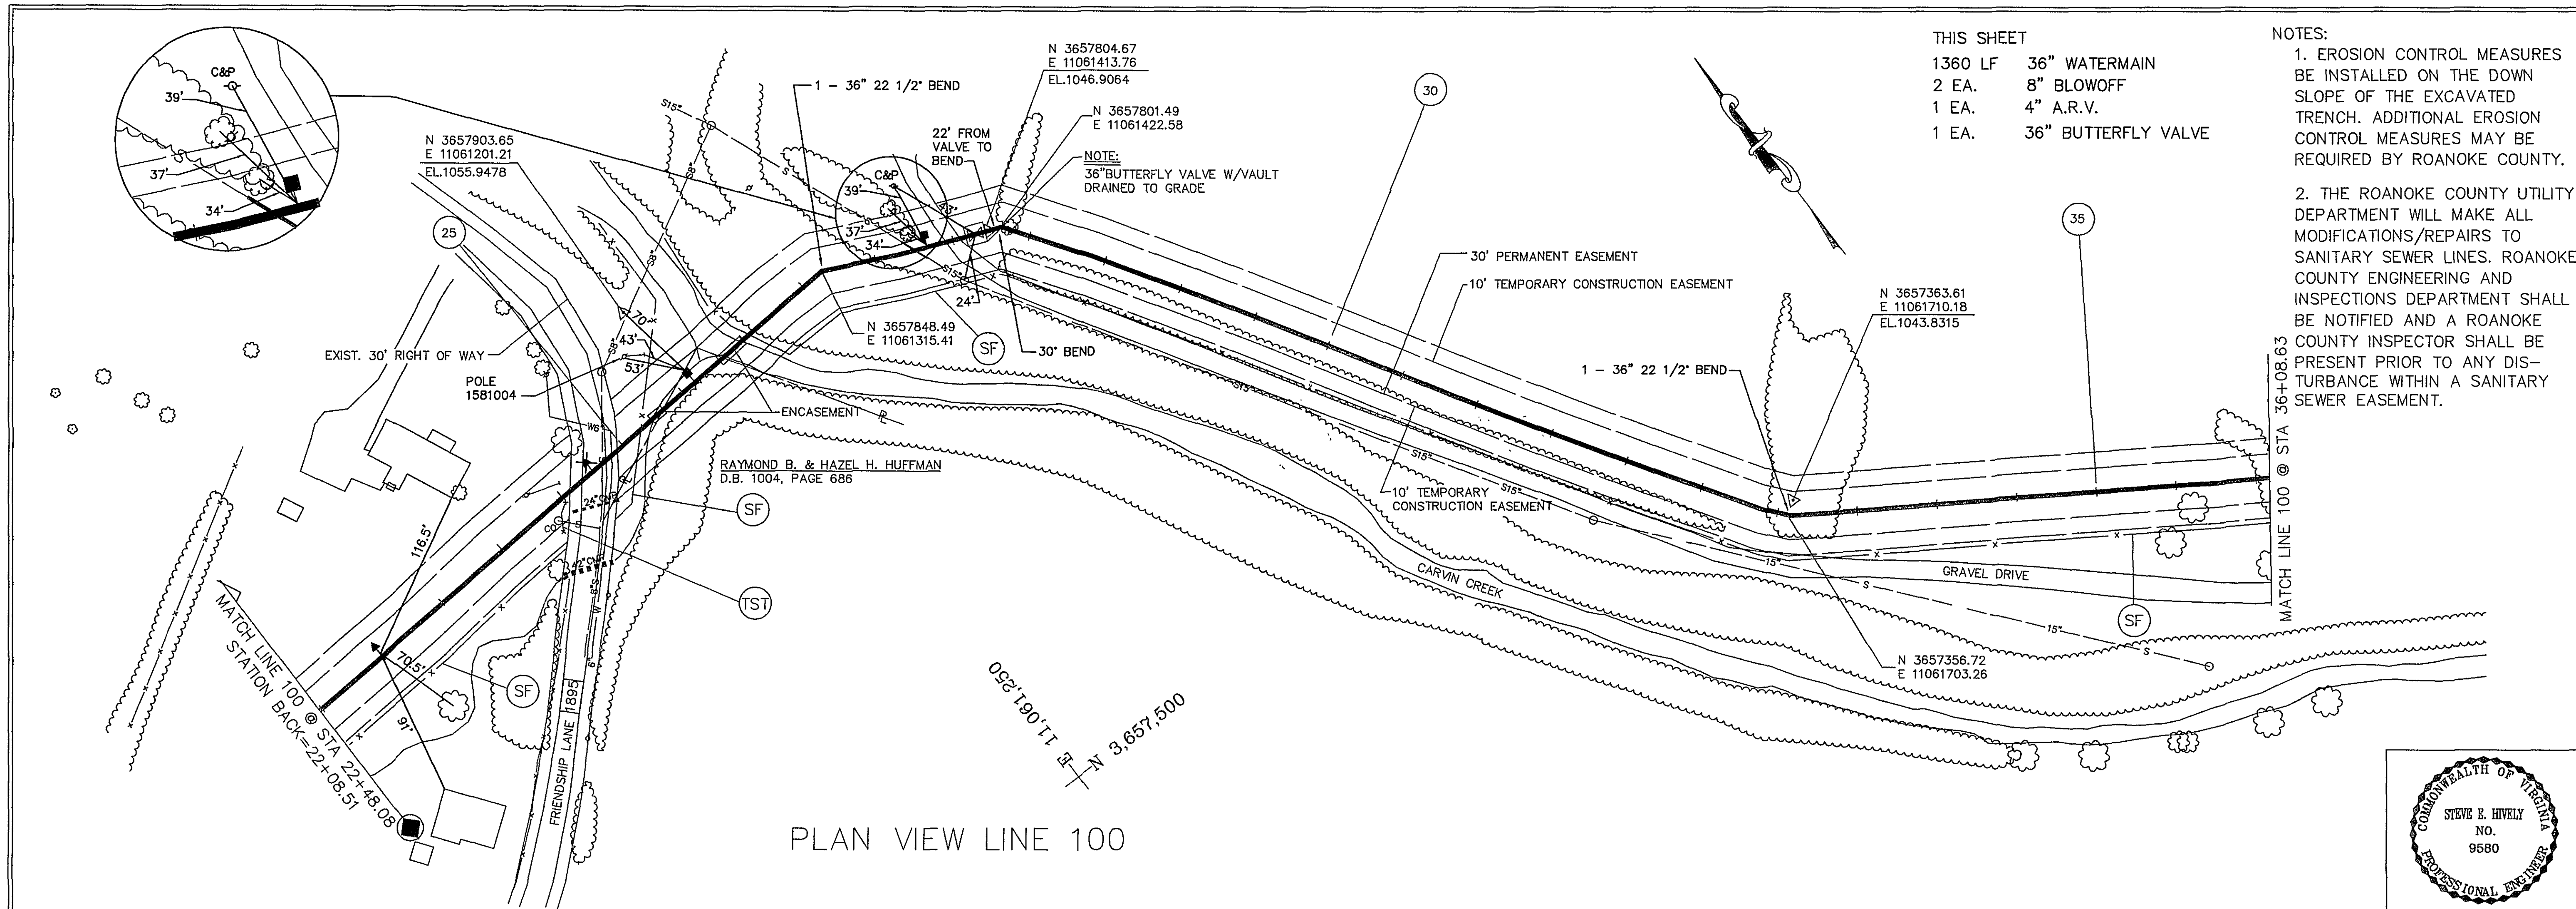

Dewberry & Davis
 Architects
 Engineers
 Planners
 Surveyors

5238 Valleypointe Parkway, Suite One-B
 Roanoke, Virginia 24019
 ☎ 703 362-7725

Carvins Cove, Phase II
 City of Roanoke
 Roanoke, Virginia

CONTRACT "A-1"
LINE 100
 STA 22+48.08 - 36+08.63

Drawn By ACF/REH
 Designed By RBS
 Checked By SEH
 Date DEC. 1993
 Scale V: 1" = 5'
 H: 1" = 50'
 Plan Number F3
 Zoned NONE
 Sheet 3 of 9
 File Number C1160