
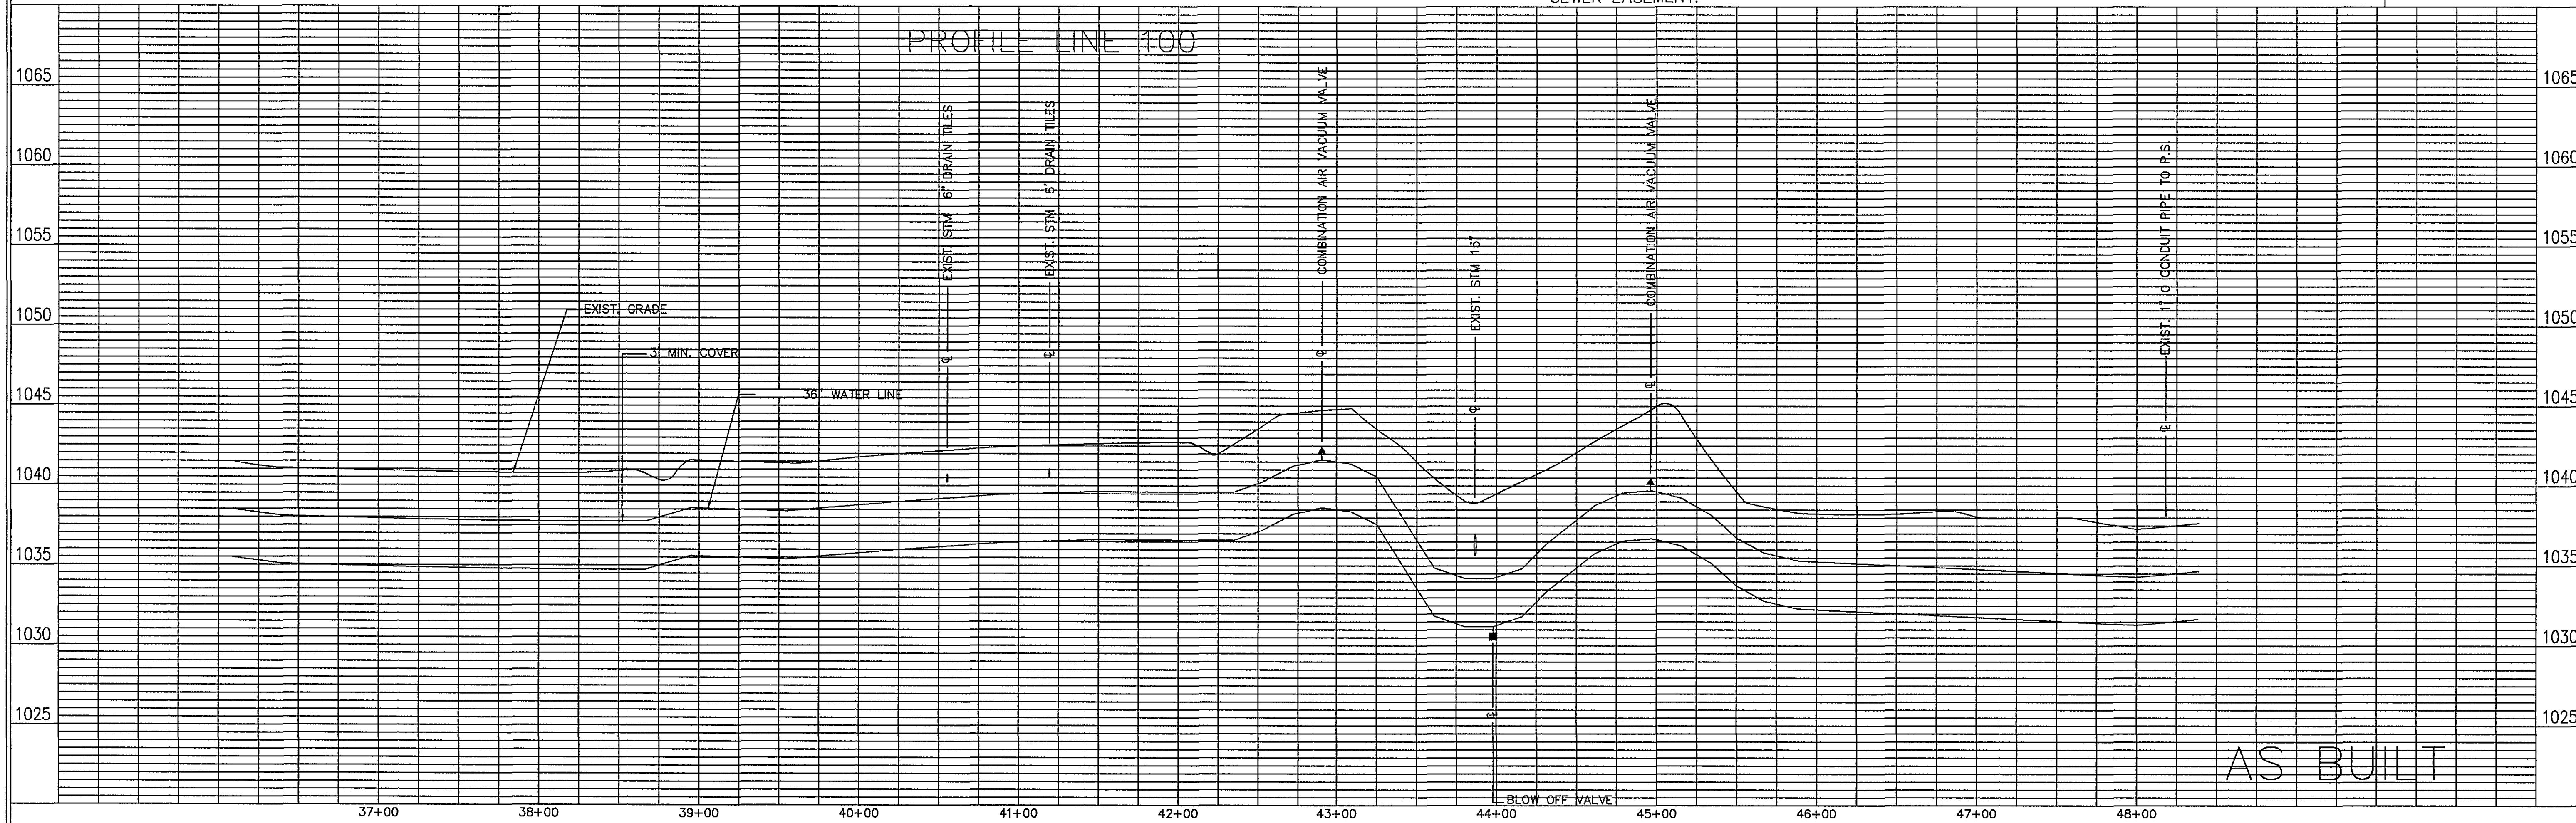


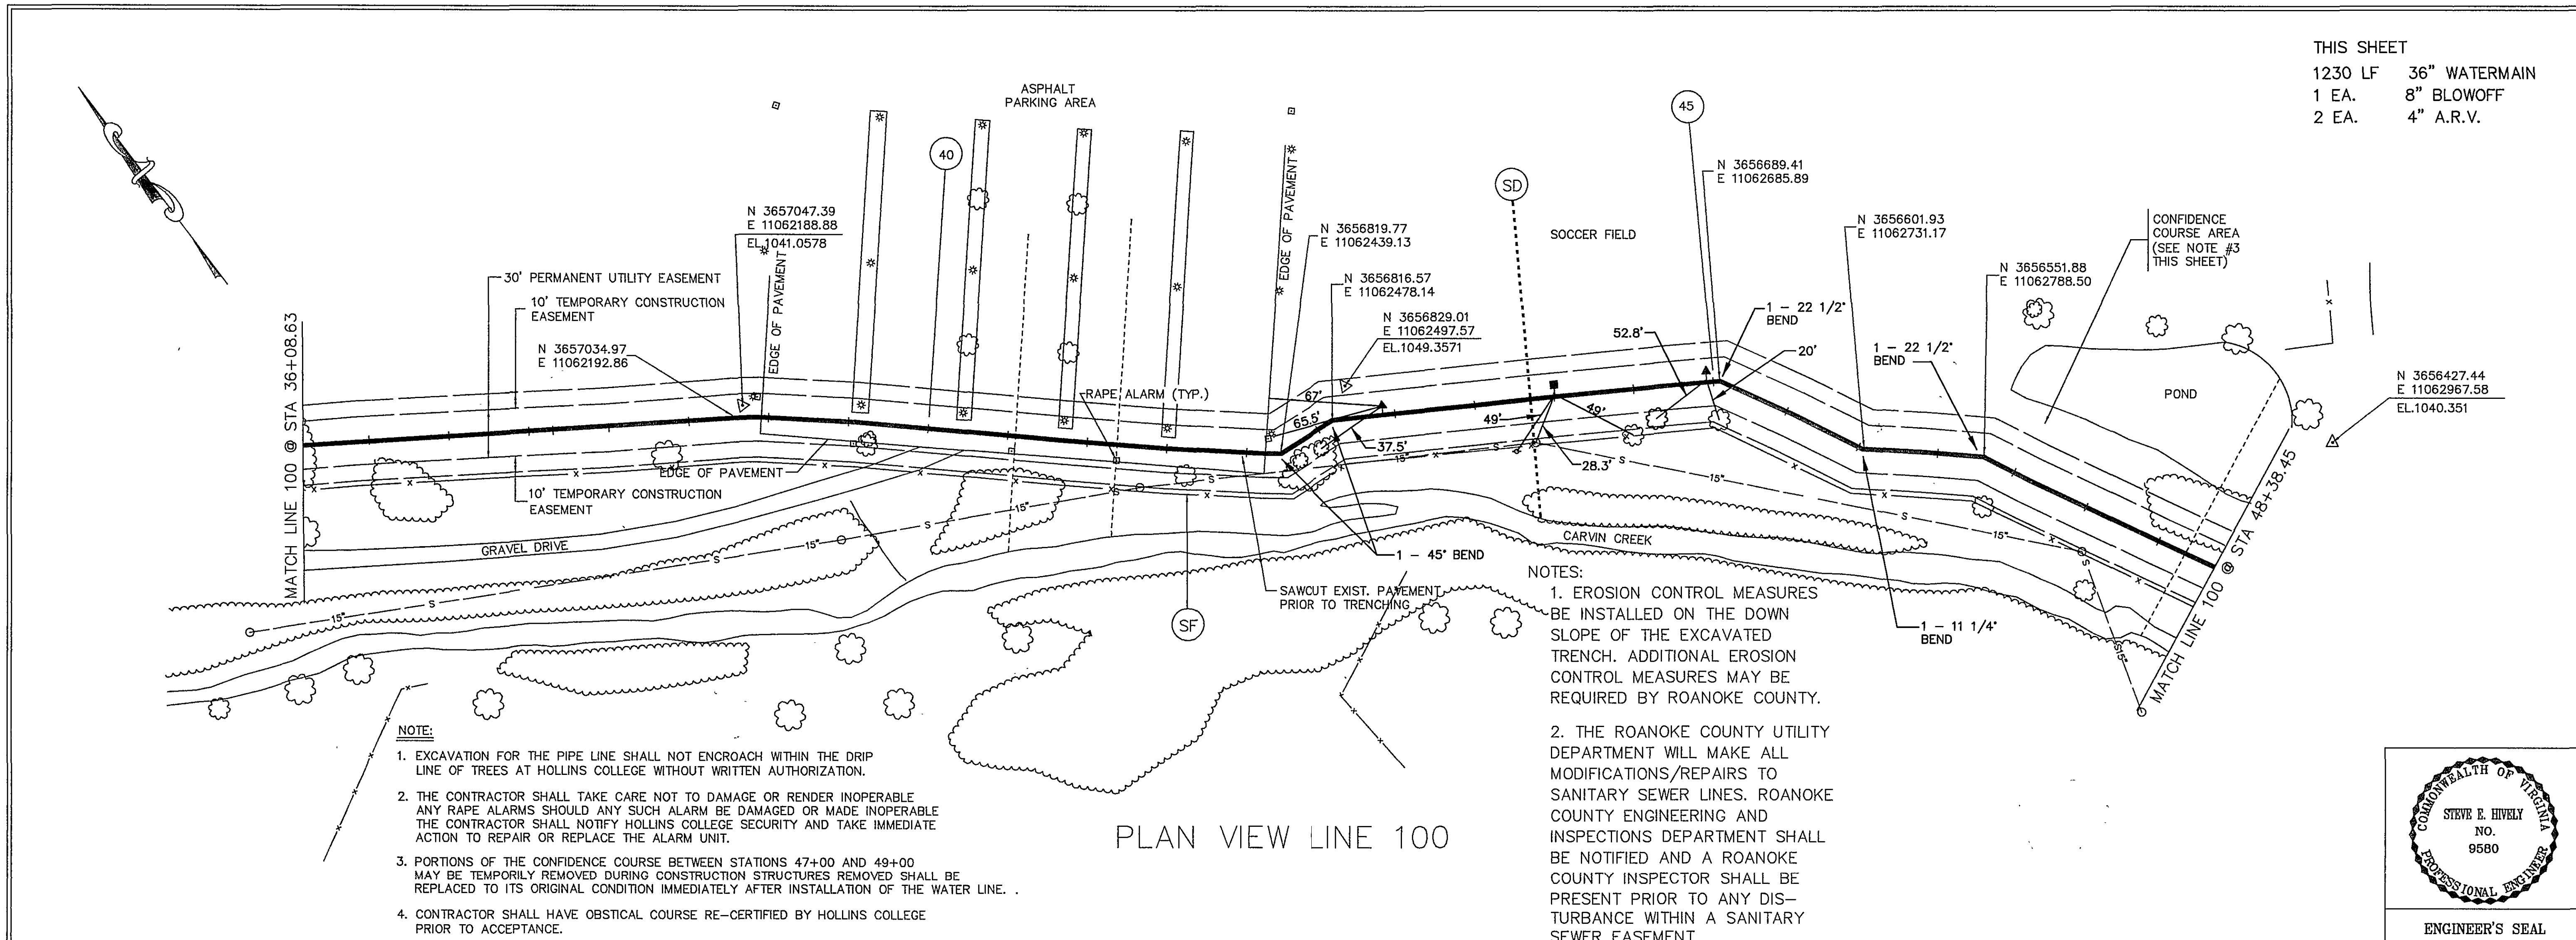

Architects
Engineers
Planners
Surveyors

Dewberry & Davis

5238 Valleypointe Parkway, Suite One-B
Roanoke, Virginia 24019
703 362-7725

Carvins Cove, Phase II
City of Roanoke
Roanoke, Virginia

CONTRACT "A-1"
LINE 100
STA 36+08.63 - 48+38.45

Drawn By ACF/REH
Designed By RBS
Checked By SEH
Date DEC. 1993
Scale V: 1" = 5'
H: 1" = 50'
Plan Number F4
Zoned NONE
Sheet 4 of 9
File Number C1160