


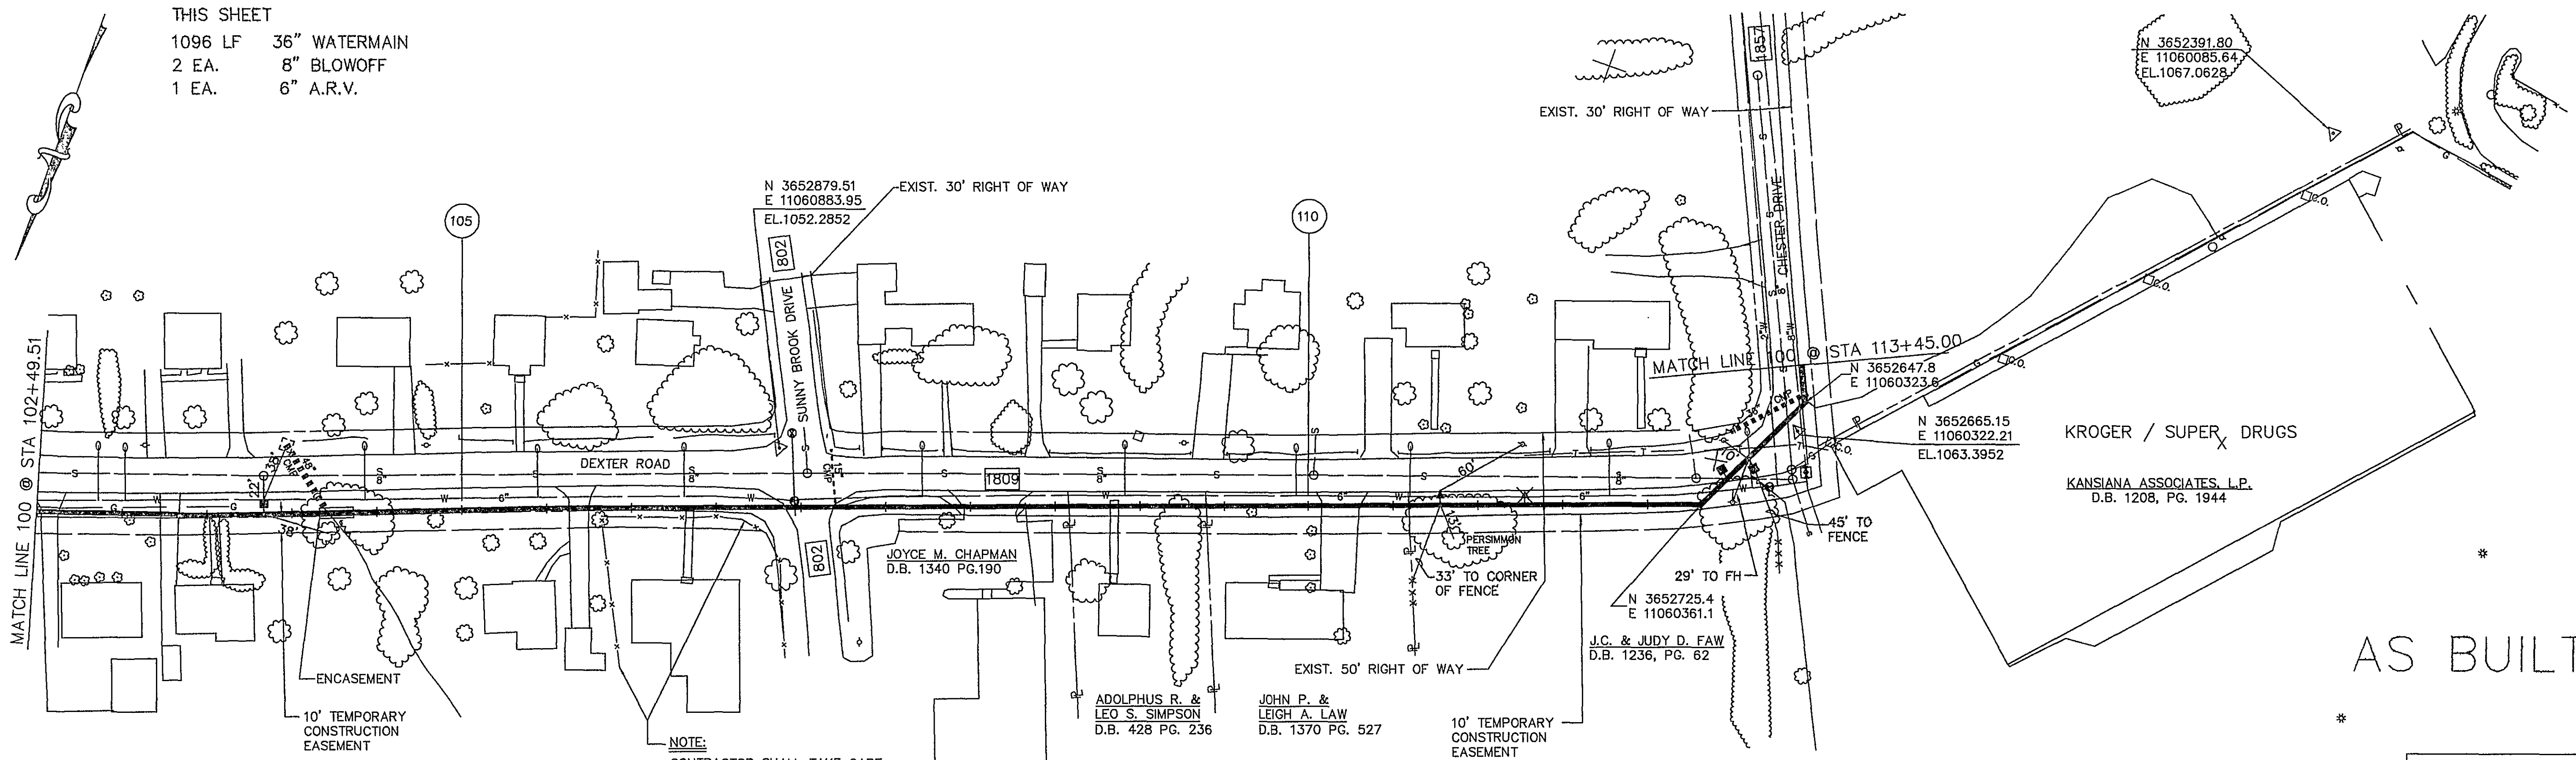

NOTE:
1. CONTRACTOR SHALL ADJUST PROP. 36" WATER LINE
(SEE SEPARATION DETAILS) FOR ALL SANITARY SEWER LATERALS.


NOTE:
CONTRACTOR SHALL TAKE CARE,
TO INSURE PROPERTY OWNERS
FENCE IS UNDISTURBED DURING
ALL CONSTRUCTION PHASES.

NOTES:
1. EROSION CONTROL MEASURES
BE INSTALLED ON THE DOWN
SLOPE OF THE EXCAVATED
TRENCH. ADDITIONAL EROSION
CONTROL MEASURES MAY BE
REQUIRED BY ROANOKE COUNTY.


2. THE ROANOKE COUNTY UTILITY
DEPARTMENT WILL MAKE ALL
MODIFICATIONS/REPAIRS TO
SANITARY SEWER AND WATER
LINES. ROANOKE COUNTY ENGI-
NEERING INSPECTIONS DEPARTMENT
SHALL BE NOTIFIED AT LEAST 72

HOURS PRIOR TO WORK AND A
COUNTY INSPECTOR SHALL BE
PRESENT PRIOR TO ANY DIS-
TURBANCE WITHIN A SANITARY
SEWER OR WATER EASEMENT.

AS BUILT

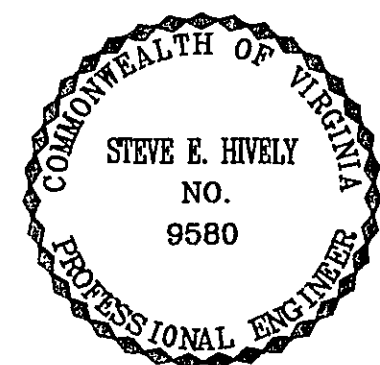

ENGINEER'S SEAL

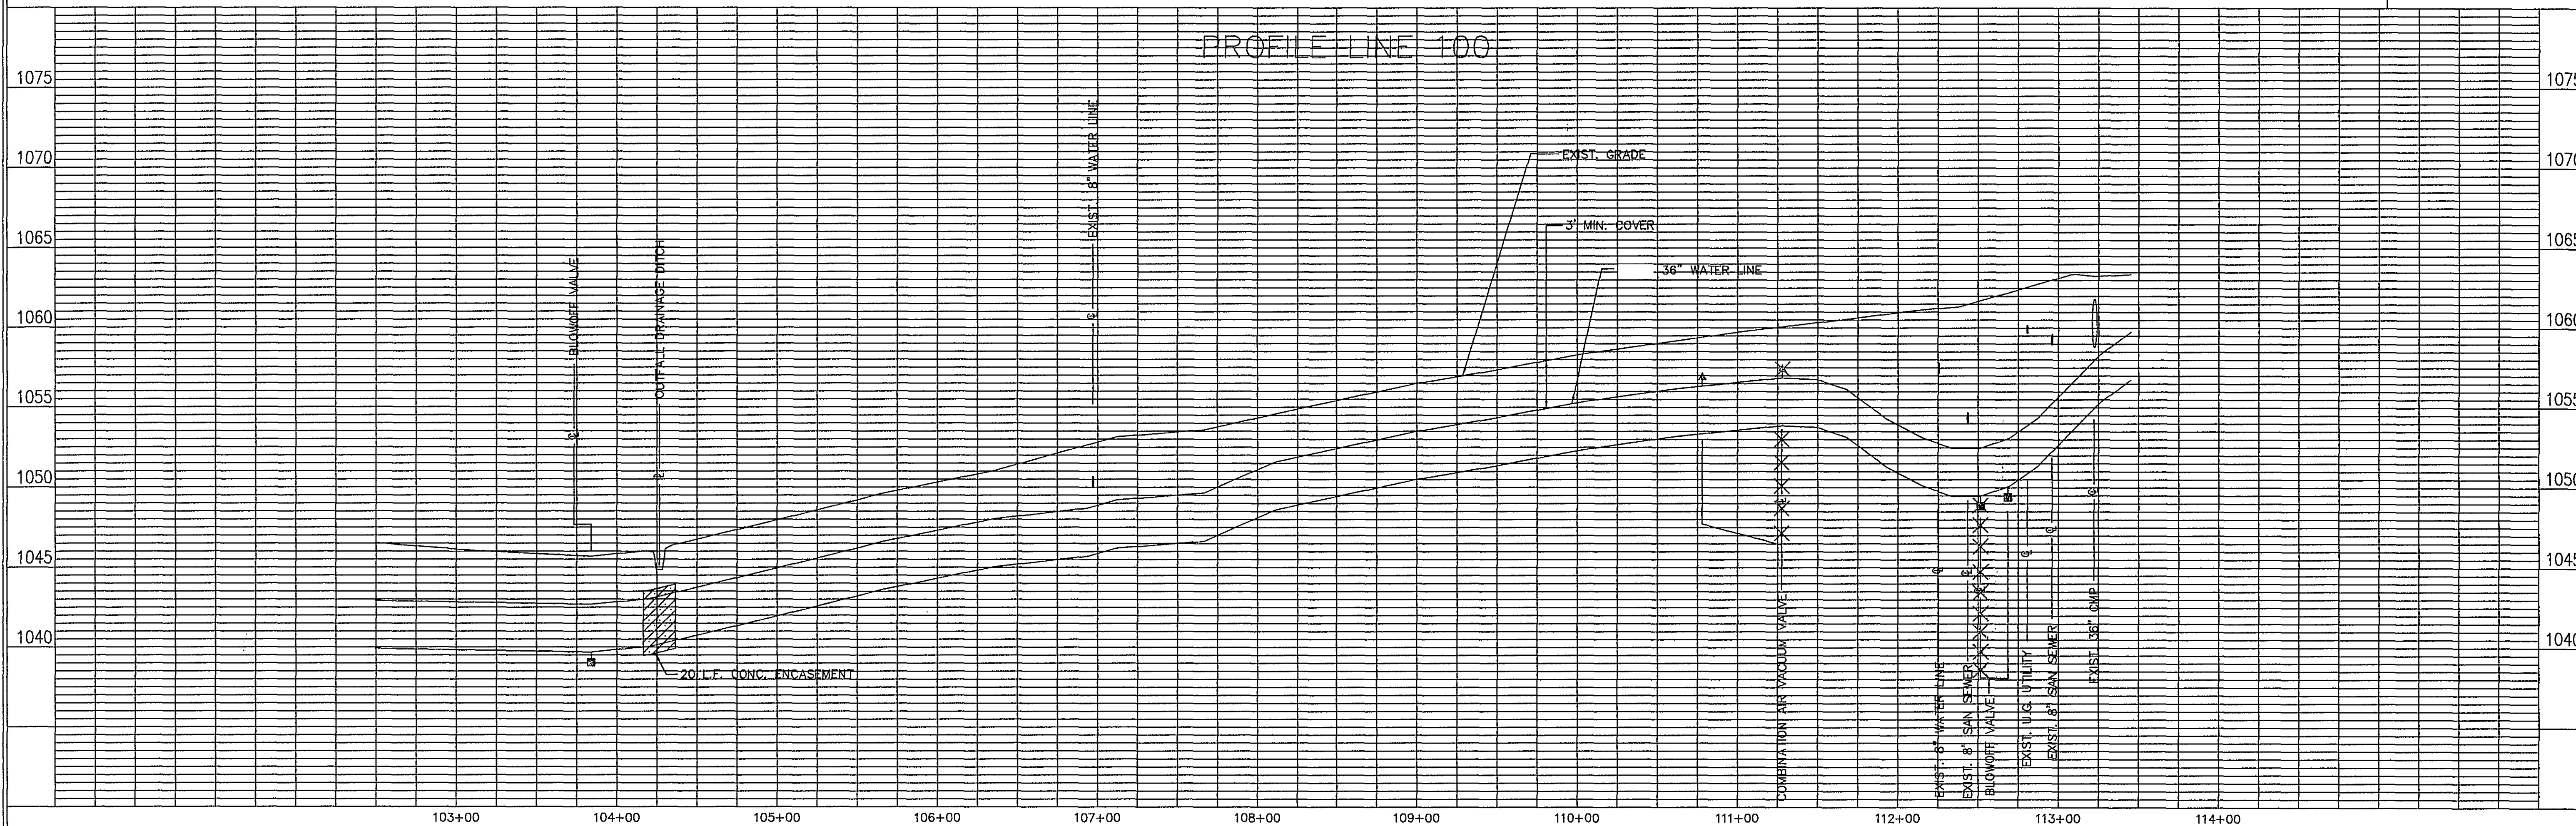

Architects
Engineers
Planners
Surveyors

Dewberry & Davis

5238 Valleypointe Parkway, Suite One-B
Roanoke, Virginia 24019
703 362-7725

Carvins Cove, Phase II

City of Roanoke
Roanoke, Virginia

CONTRACT "A-2"

LINE 100

STA 102+49.51 - 113+45.00

Drawn By REH/ACF
Designed By RBS
Checked By SEH
Date DEC. 1993
Scale V: 1" = 5'
H: 1" = 50'
Plan Number F9
Zoned NONE
Sheet **2** of 12
File Number C1160