
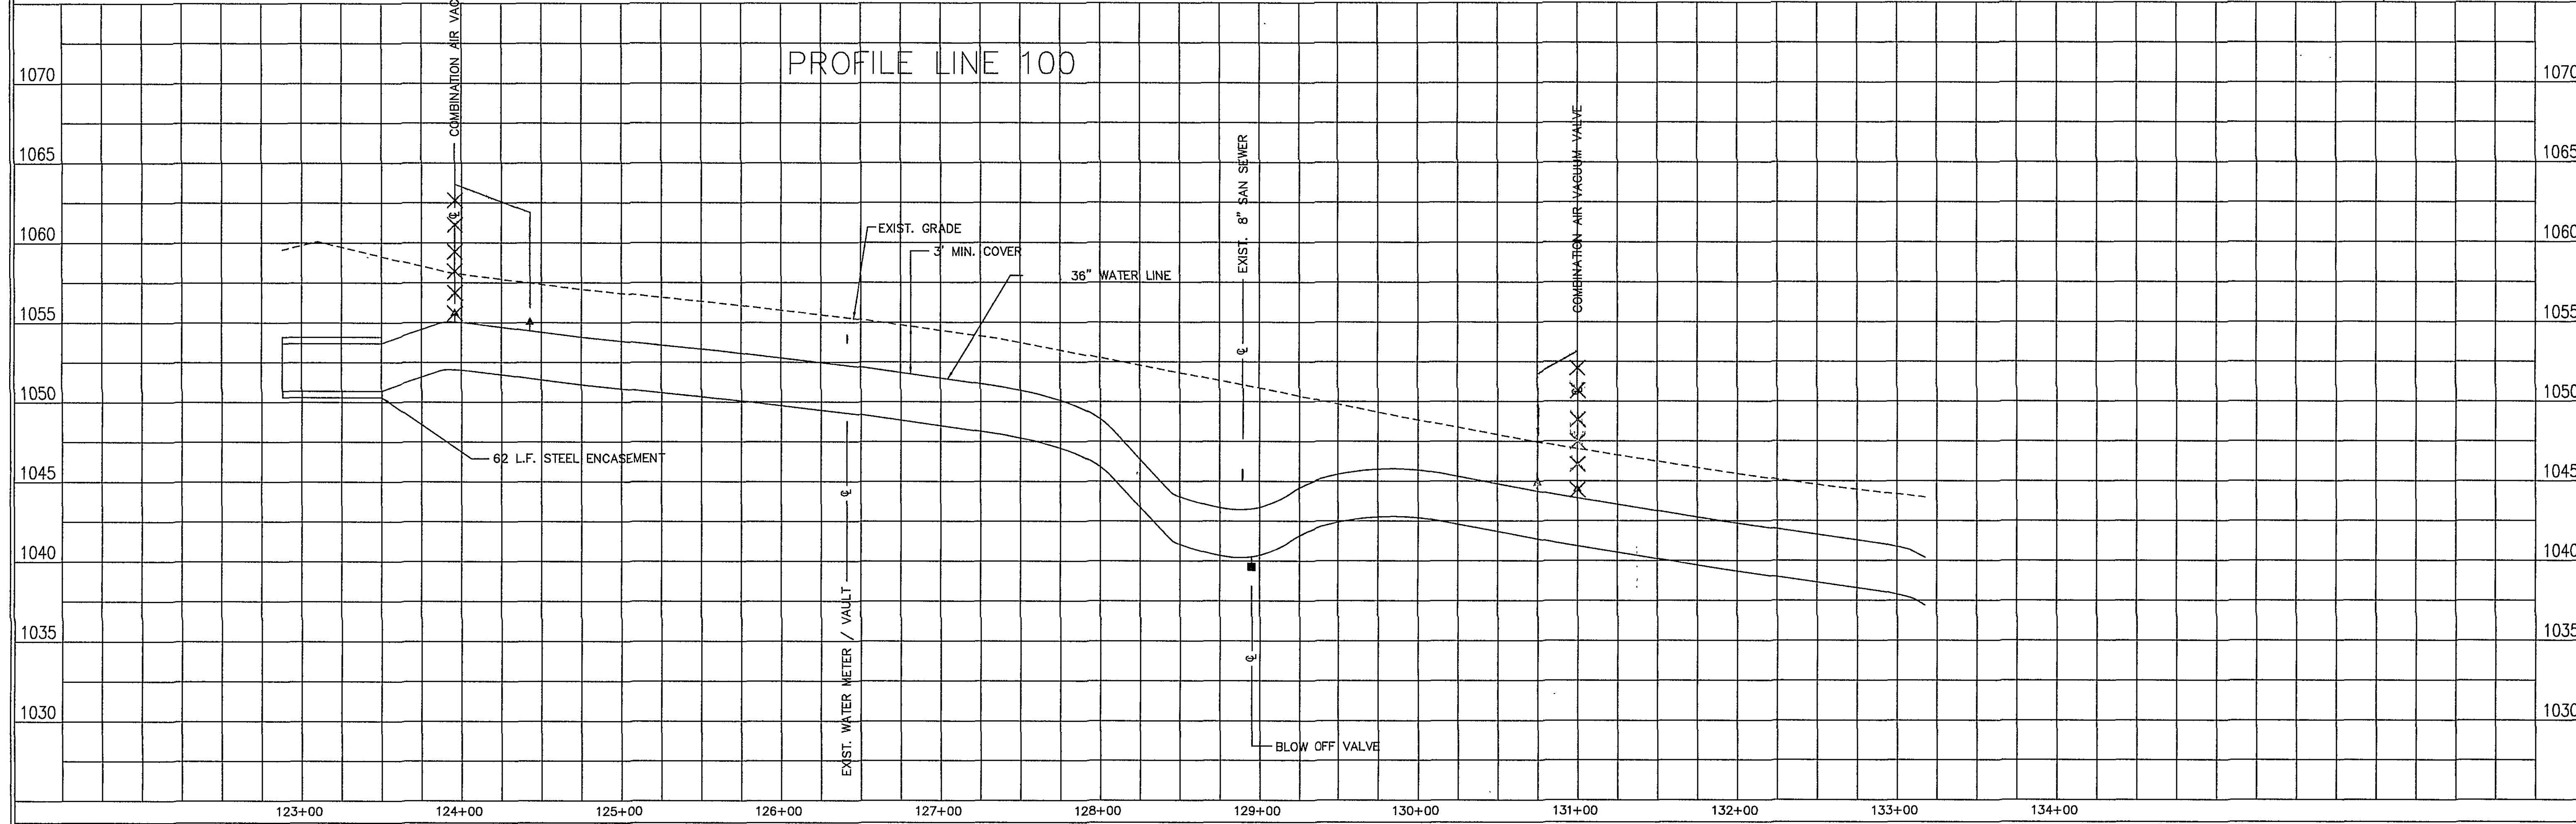


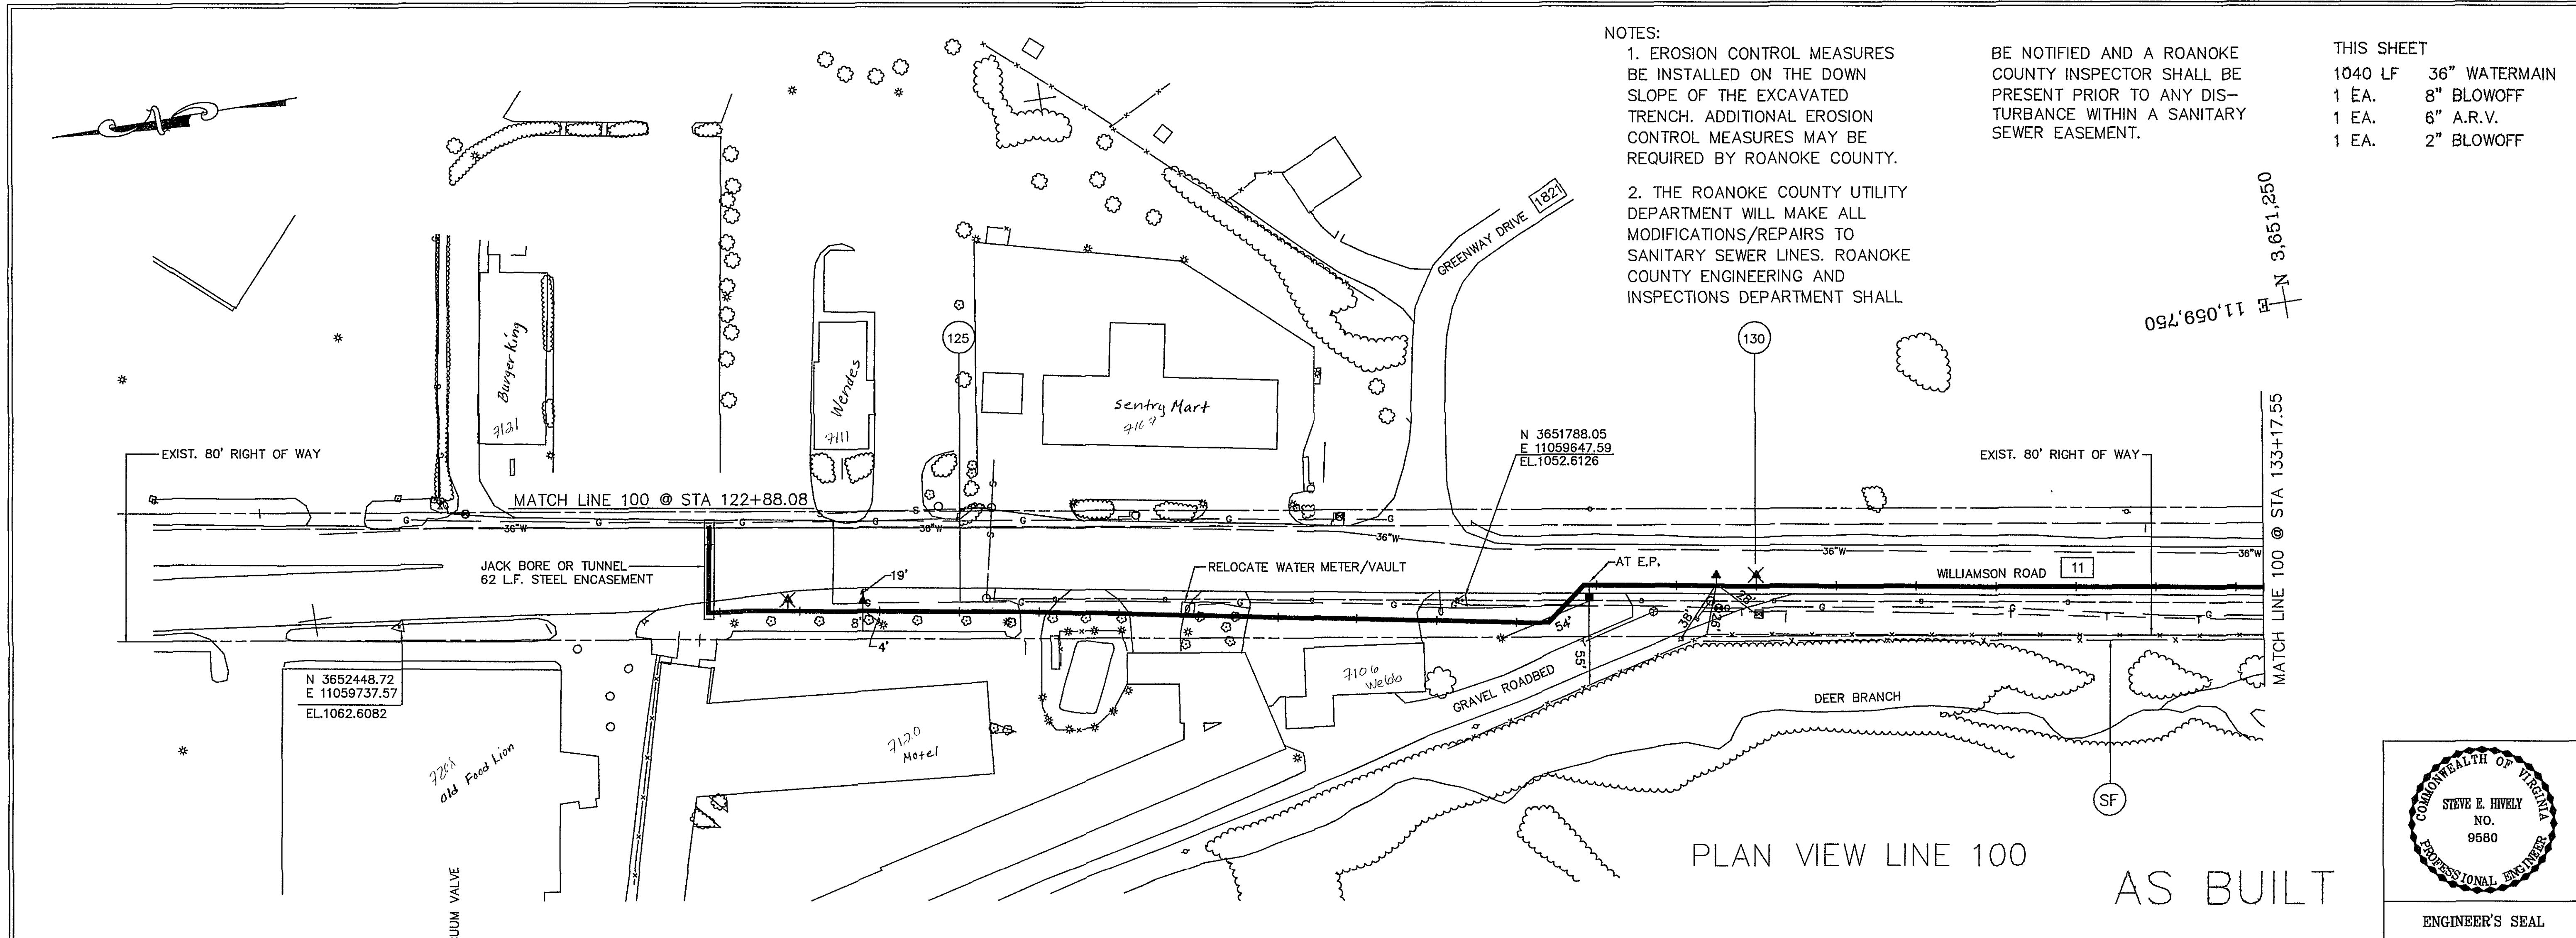


NOTES:

1. EROSION CONTROL MEASURES BE INSTALLED ON THE DOWN SLOPE OF THE EXCAVATED TRENCH. ADDITIONAL EROSION CONTROL MEASURES MAY BE REQUIRED BY ROANOKE COUNTY.

2. THE ROANOKE COUNTY UTILITY DEPARTMENT WILL MAKE ALL MODIFICATIONS/REPAIRS TO SANITARY SEWER LINES. ROANOKE COUNTY ENGINEERING AND INSPECTIONS DEPARTMENT SHALL BE NOTIFIED AND A ROANOKE COUNTY INSPECTOR SHALL BE PRESENT PRIOR TO ANY DISTURBANCE WITHIN A SANITARY SEWER EASEMENT.

THIS SHEET

1040 LF	36" WATERMAIN
1 EA.	8" BLOWOFF
1 EA.	6" A.R.V.
1 EA.	2" BLOWOFF

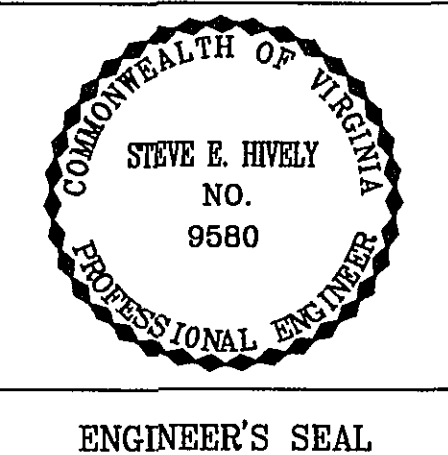

Architects
Engineers
Planners
Surveyors

Dewberry & Davis

5238 Valleypointe Parkway, Suite One-B
Roanoke, Virginia 24019
☎ 703 362-7726

Carvins Cove, Phase II

City of Roanoke
Roanoke, Virginia

CONTRACT "A-2"

LINE 100

STA 122+88.08 - 133+17.55

Drawn By REH/ACF

Designed By RBS

Checked By SEH

Date MARCH 1995

Scale
V: 1" = 5'
H: 1" = 50'

Plan Number F10.DWG

Zoned NONE

Sheet **4** of 12

File Number C1160