

CARVINS COVE PHASE II

WATER IMPROVEMENTS PROJECT



CONTRACT B1

ROANOKE, VIRGINIA

AS BUILT


VICINITY MAP

NOT TO SCALE

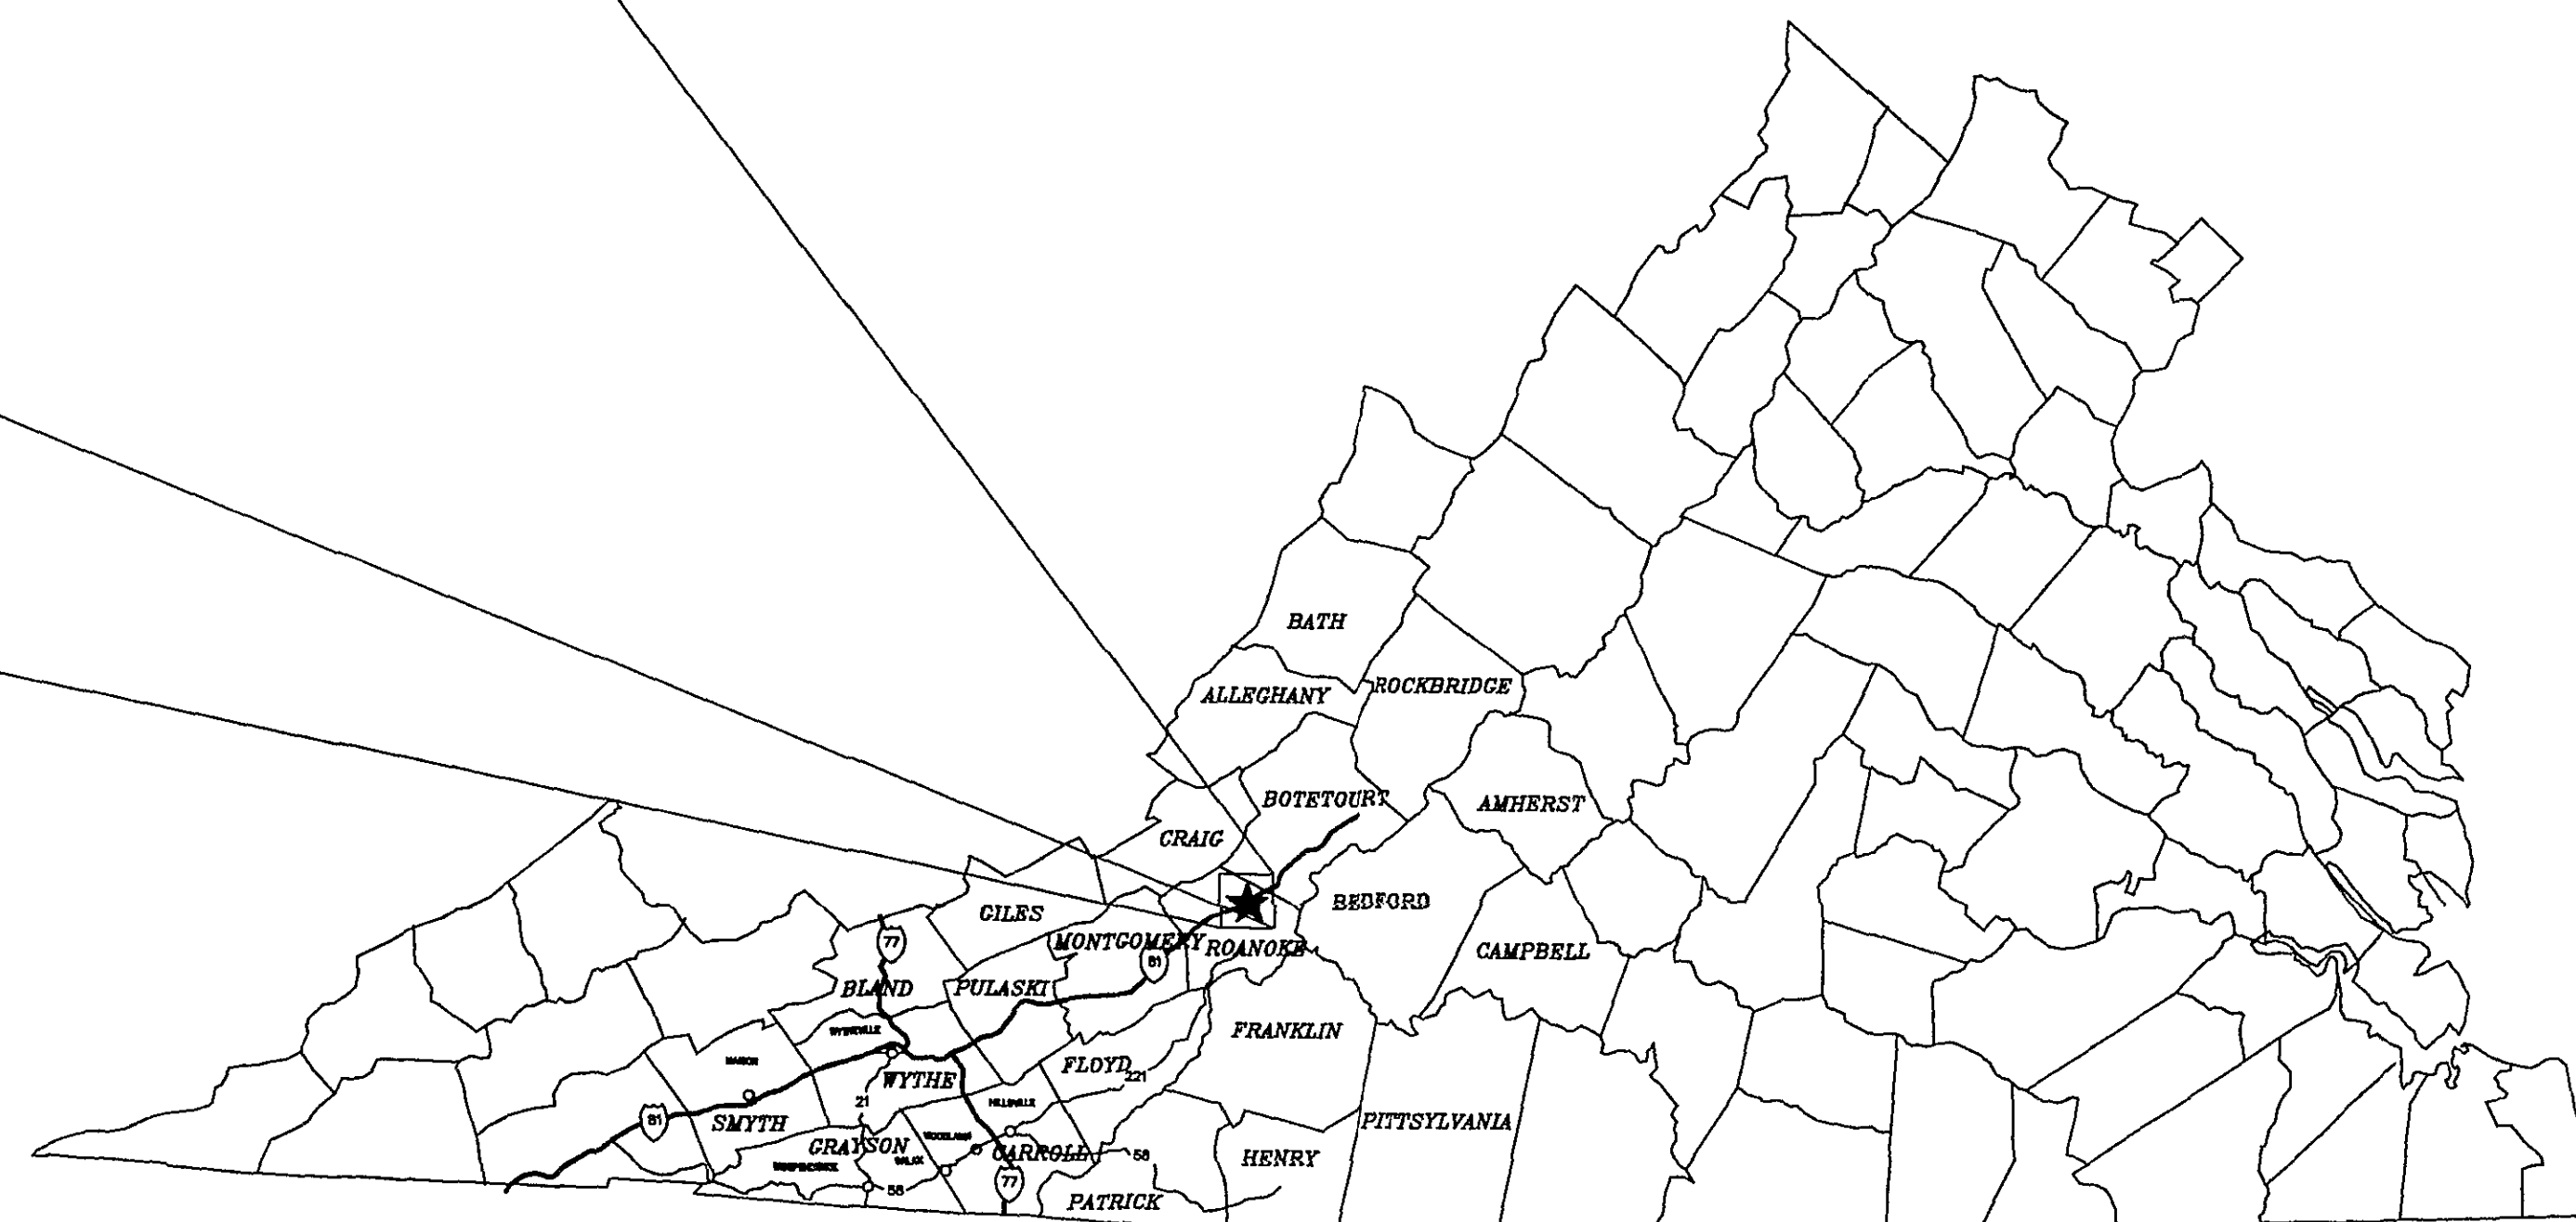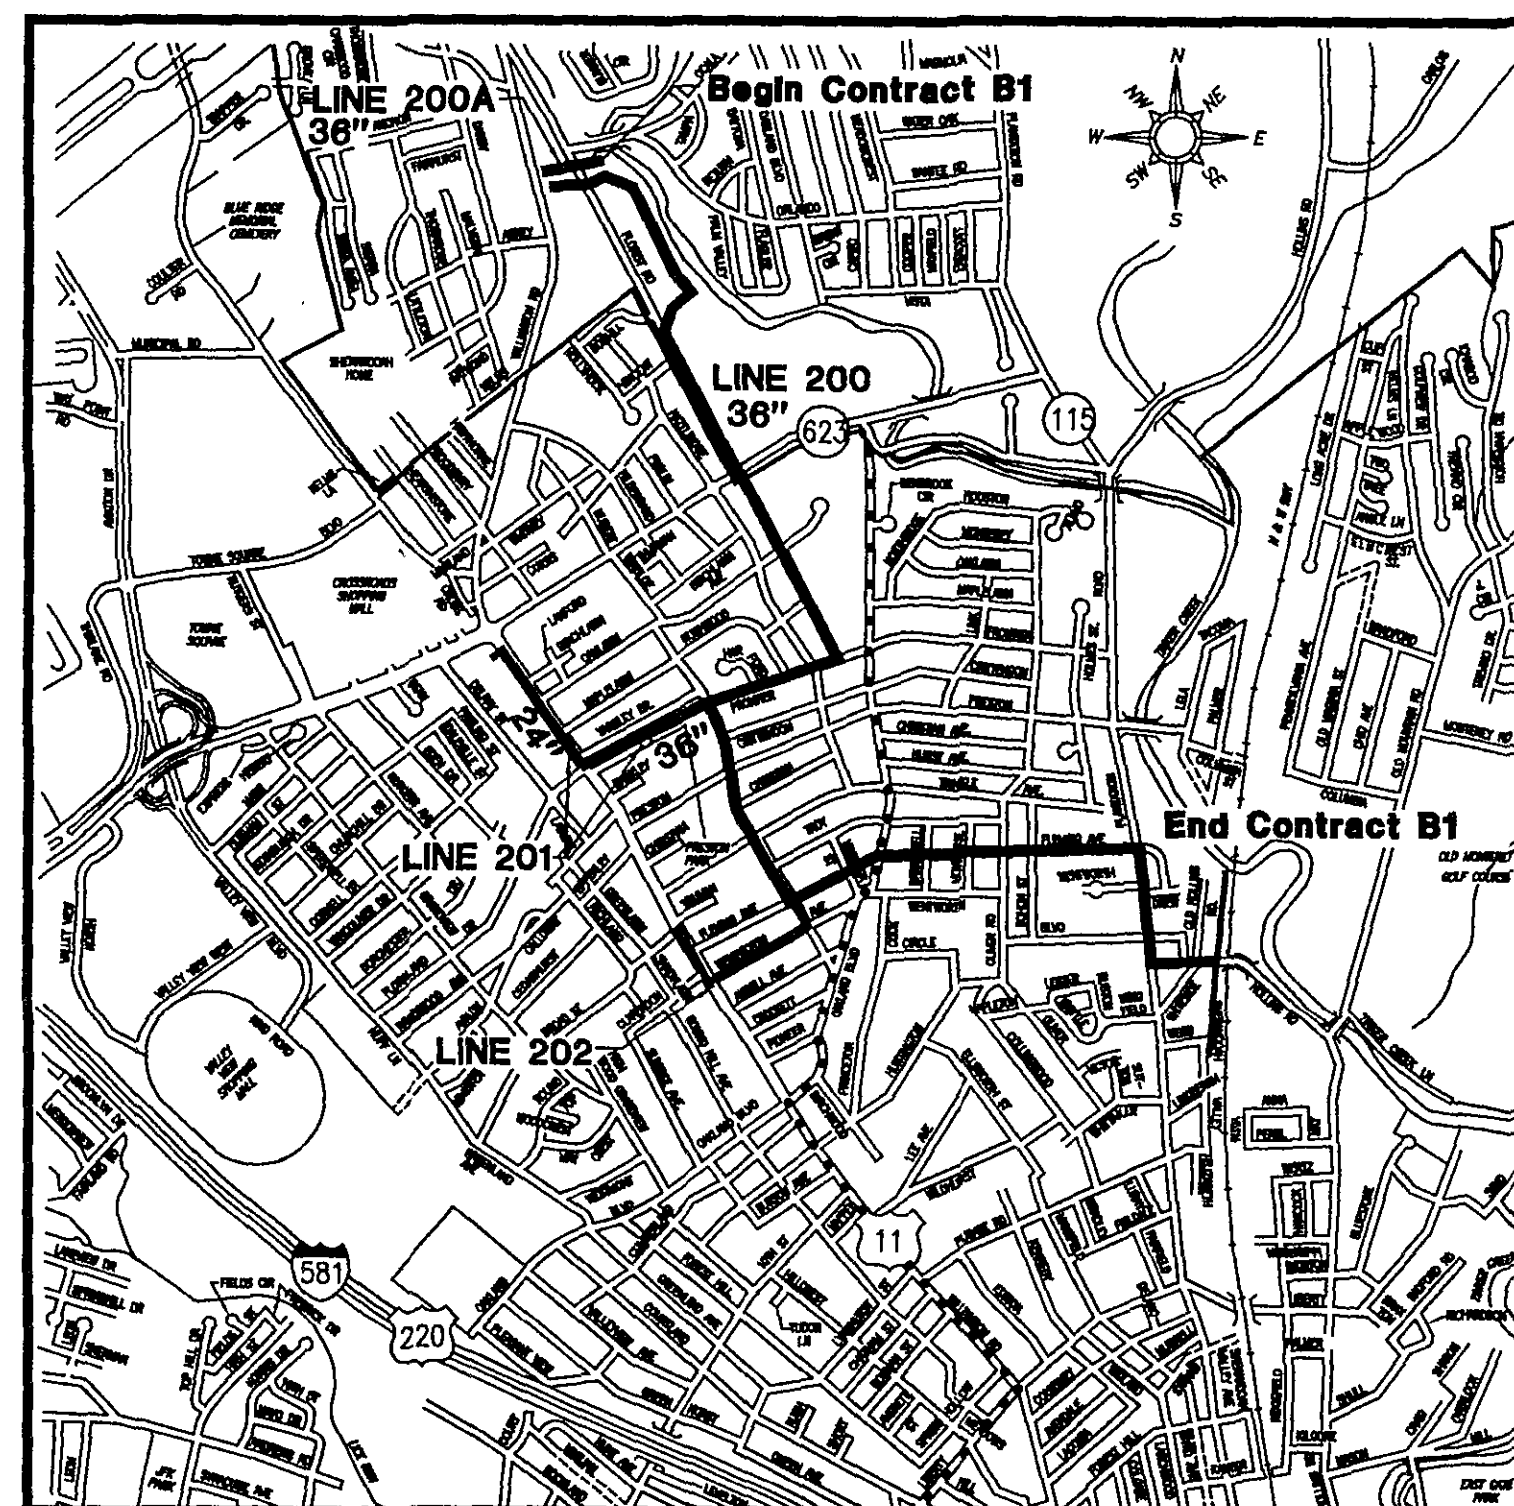

INDEX OF SHEETS

SHEET	TITLE	
1	LINE 200A	EXIST. BOXLEY HILLS PUMPING STATION
	LINE 200	0+00.00 1+49.17
	LINE 200	0+00.00 2+25.89
2	LINE 200	2+25.89 12+26.18
3	LINE 200	12+26.18 23+72.04
4	LINE 200	23+72.04 33+64.71
5	LINE 200	33+64.71 47+70.71
6	LINE 200	47+70.71 60+59.80
7	LINE 200	60+59.80 71+65.30
8	LINE 200	71+65.30 84+66.17
9	LINE 200	84+66.17 98+31.24
10	LINE 200	98+31.24 112+25.84
11	LINE 200	112+25.84 124+07.67
12	LINE 200	124+07.67 137+64.81
13	LINE 200	137+64.81 151+45.06
14	LINE 200	151+45.06 161+46.79
15	LINE 200	161+46.79 170+35.36
16	LINE 200	170+35.36 175+69.73
17	LINE 201	0+00.00 10+66.92
18	LINE 201	10+66.92 20+01.23
19	LINE 201	20+01.23 30+98.44
20	LINE 201	EXIST. DELRAY PUMPING STATION
	LINE 201	30+98.44 33+98.34
21	LINE 202	0+00.00 8+50.00
22	LINE 202	8+50.00 16+34.25
23	DETAILS	
24	DETAILS	
25	DETAILS / SOIL EROSION / LEGEND	

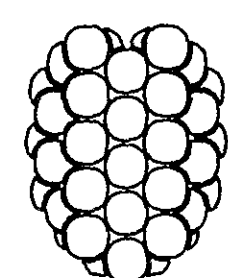


Dewberry & Davis

5238 VALLEYPONTE PARKWAY
SUITE ONE-B
ROANOKE, VIRGINIA 24019
(703) 362-7725


CONTRACT B-1 WATER PLAN #93-22

COMPLETED 4/30/1995

CONTRACTOR: HAMNER GAYE

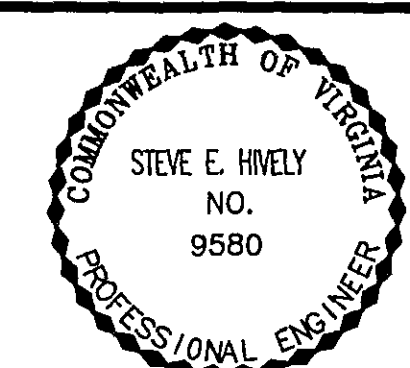

ENGINEER'S SEAL

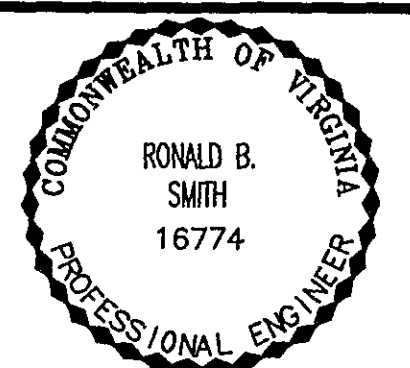

ENGINEER'S SEAL