




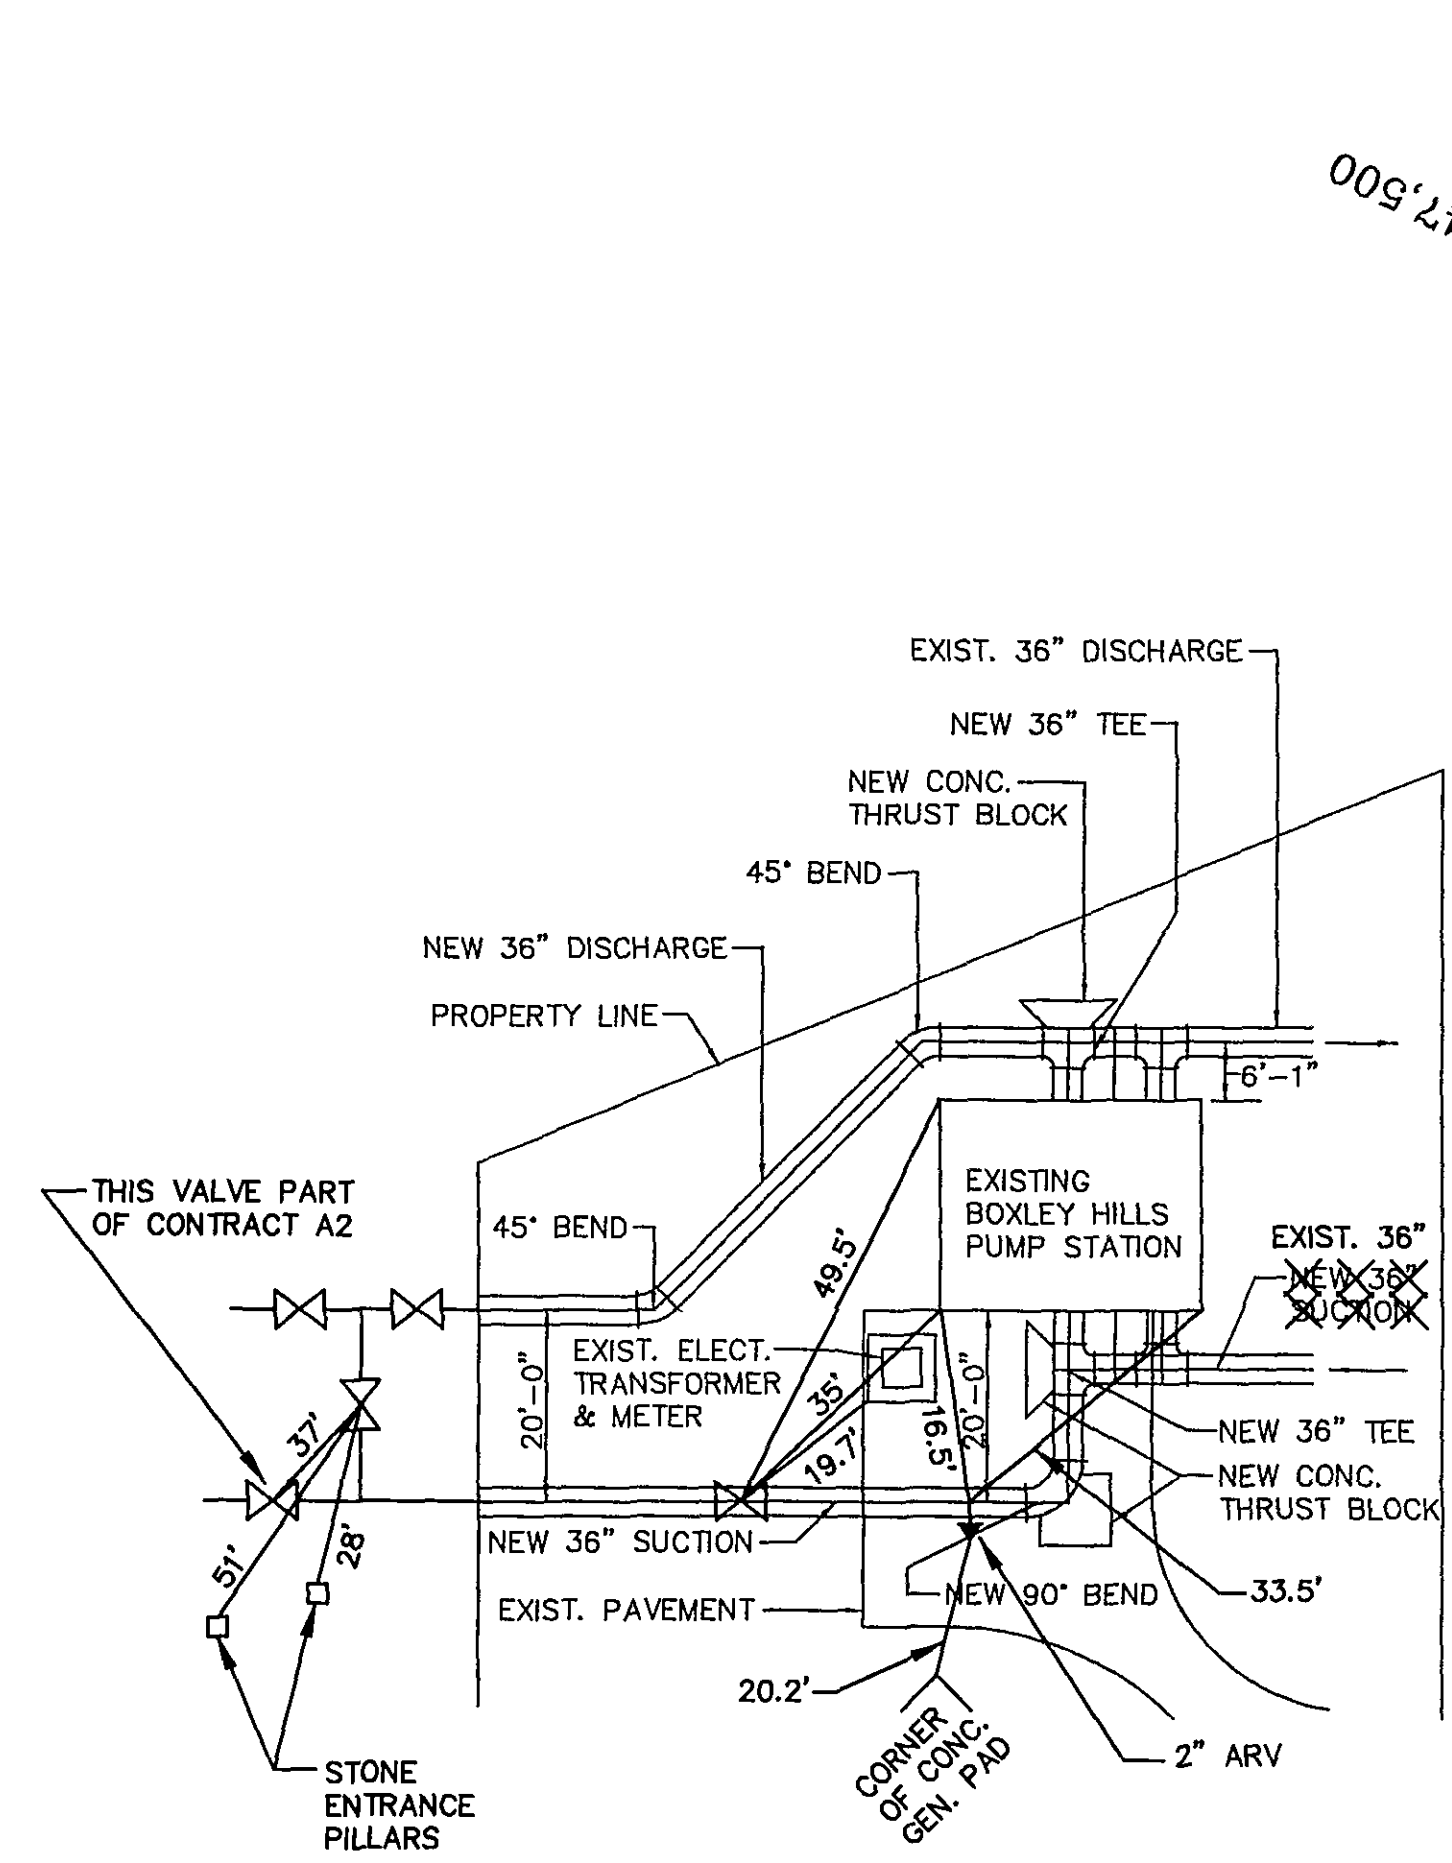

ENLARGED PLAN VIEW
BOXLEY HILLS PUMP STATION
NTS

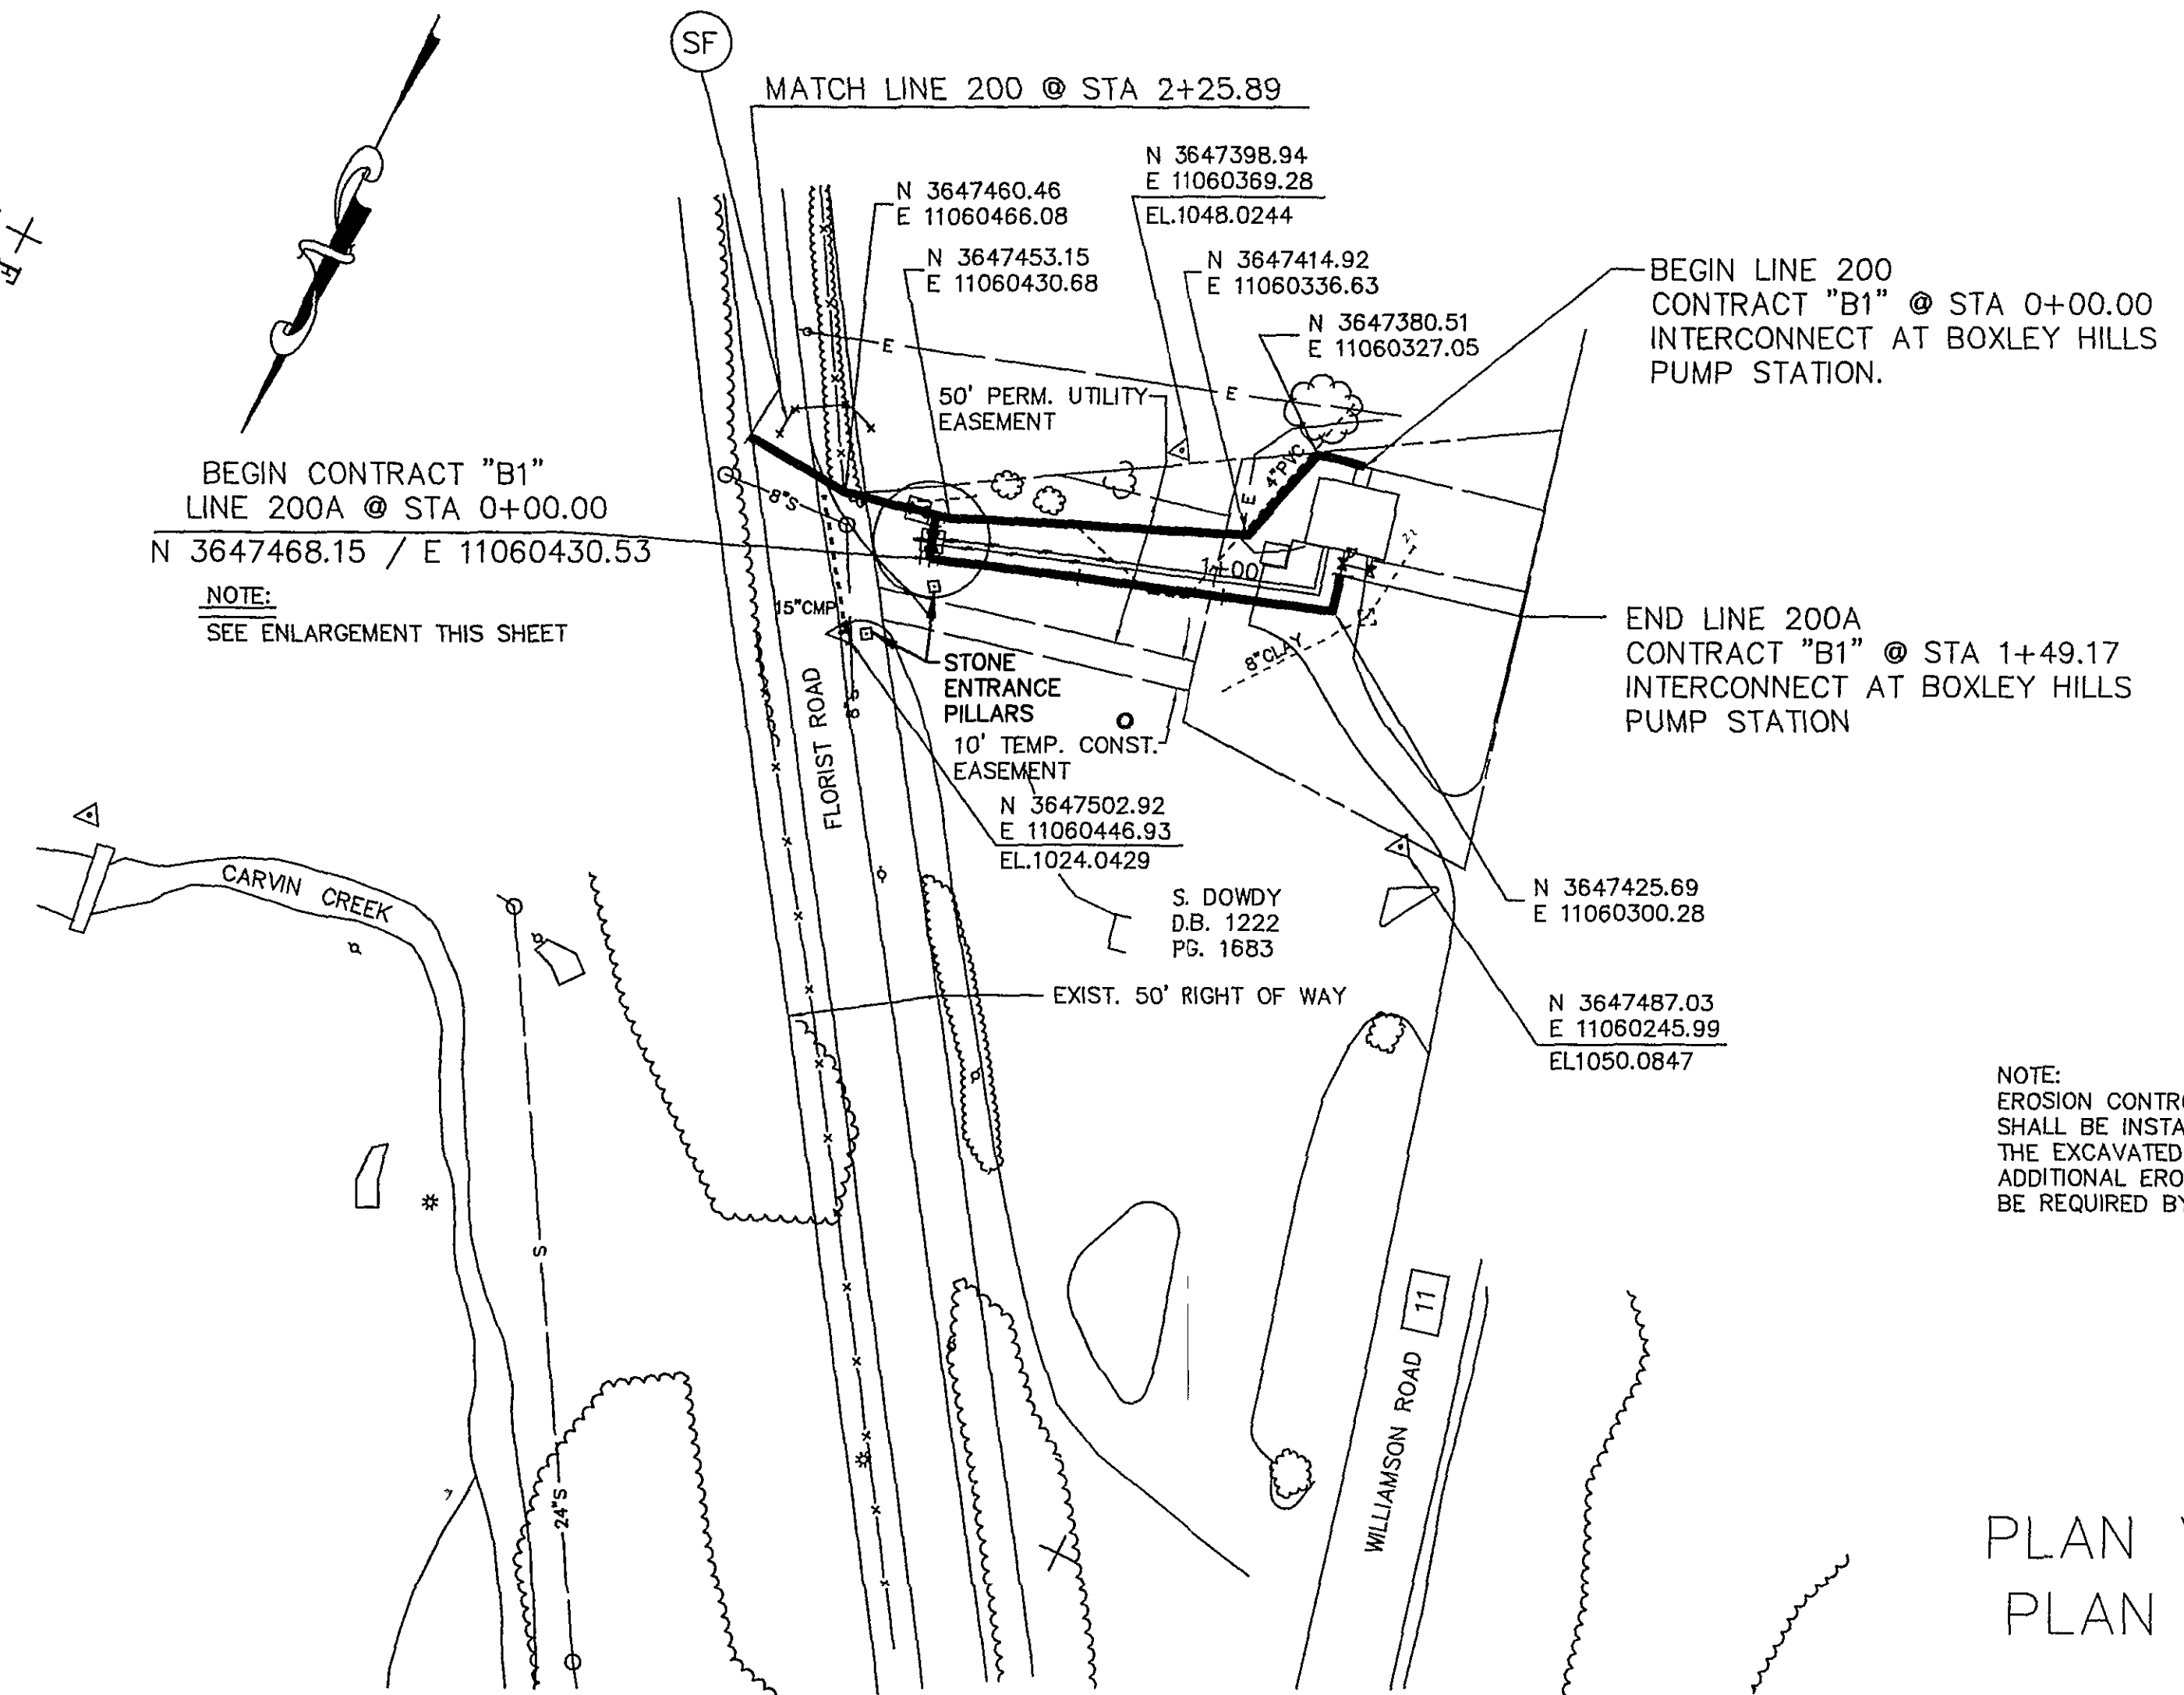


PLAN VIEW LINE 200A
PLAN VIEW LINE 200

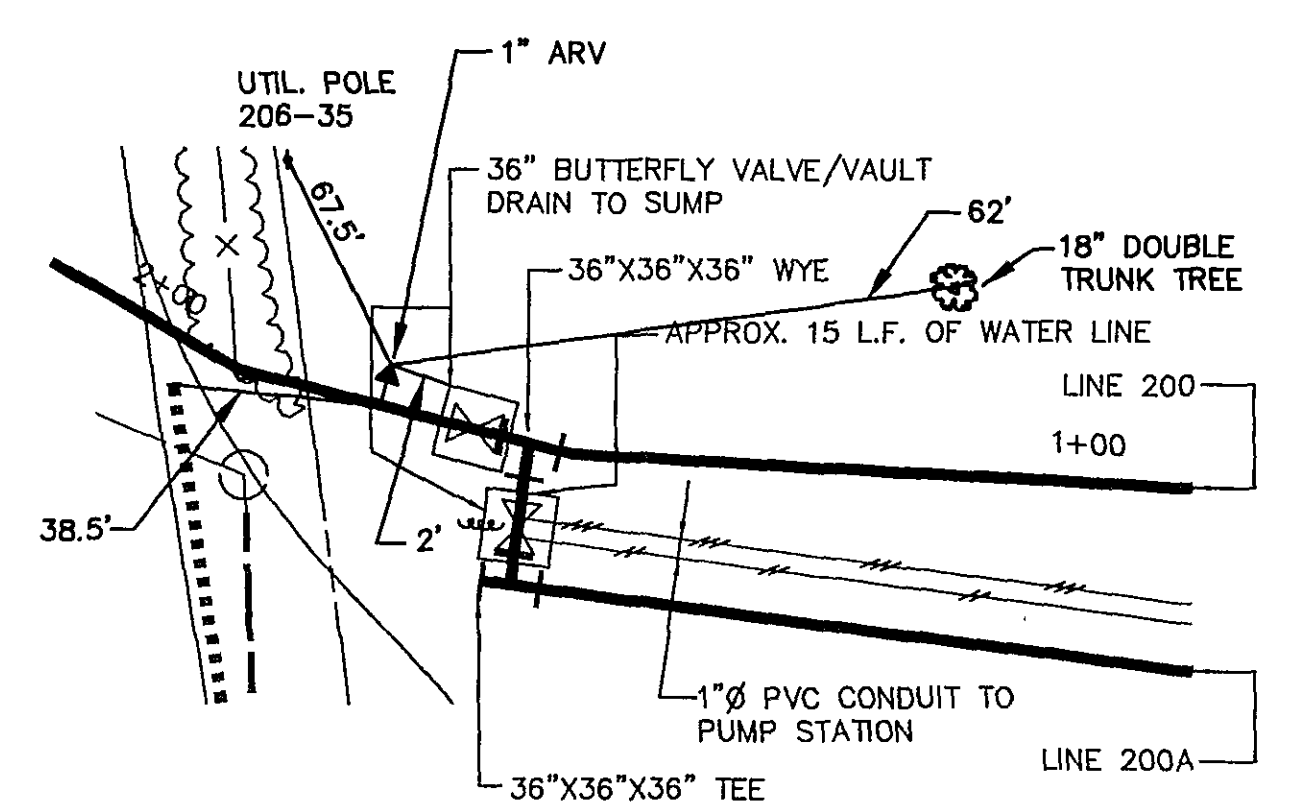


ENLARGED PLAN VIEW
NTS


THIS SHEET
374 LF 36" WATERMAIN
1 EA. 2" A.R.V.
1 EA. 1" A.R.V.
4 EA. 36" BUTTERFLY VALVES

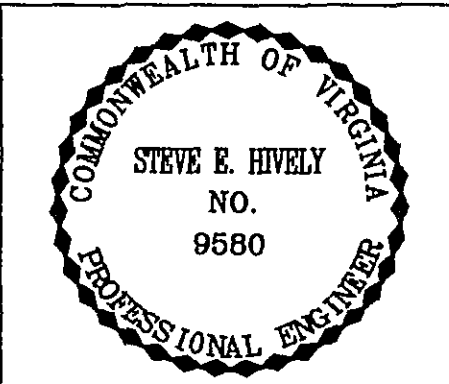


ENGINEER'S SEAL

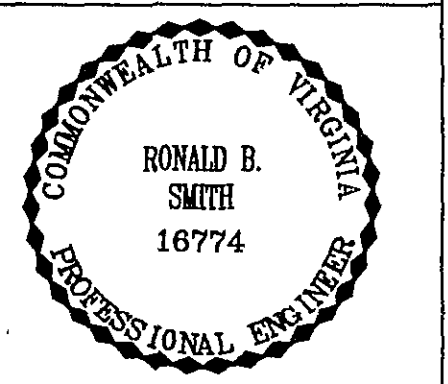


ENGINEER'S SEAL

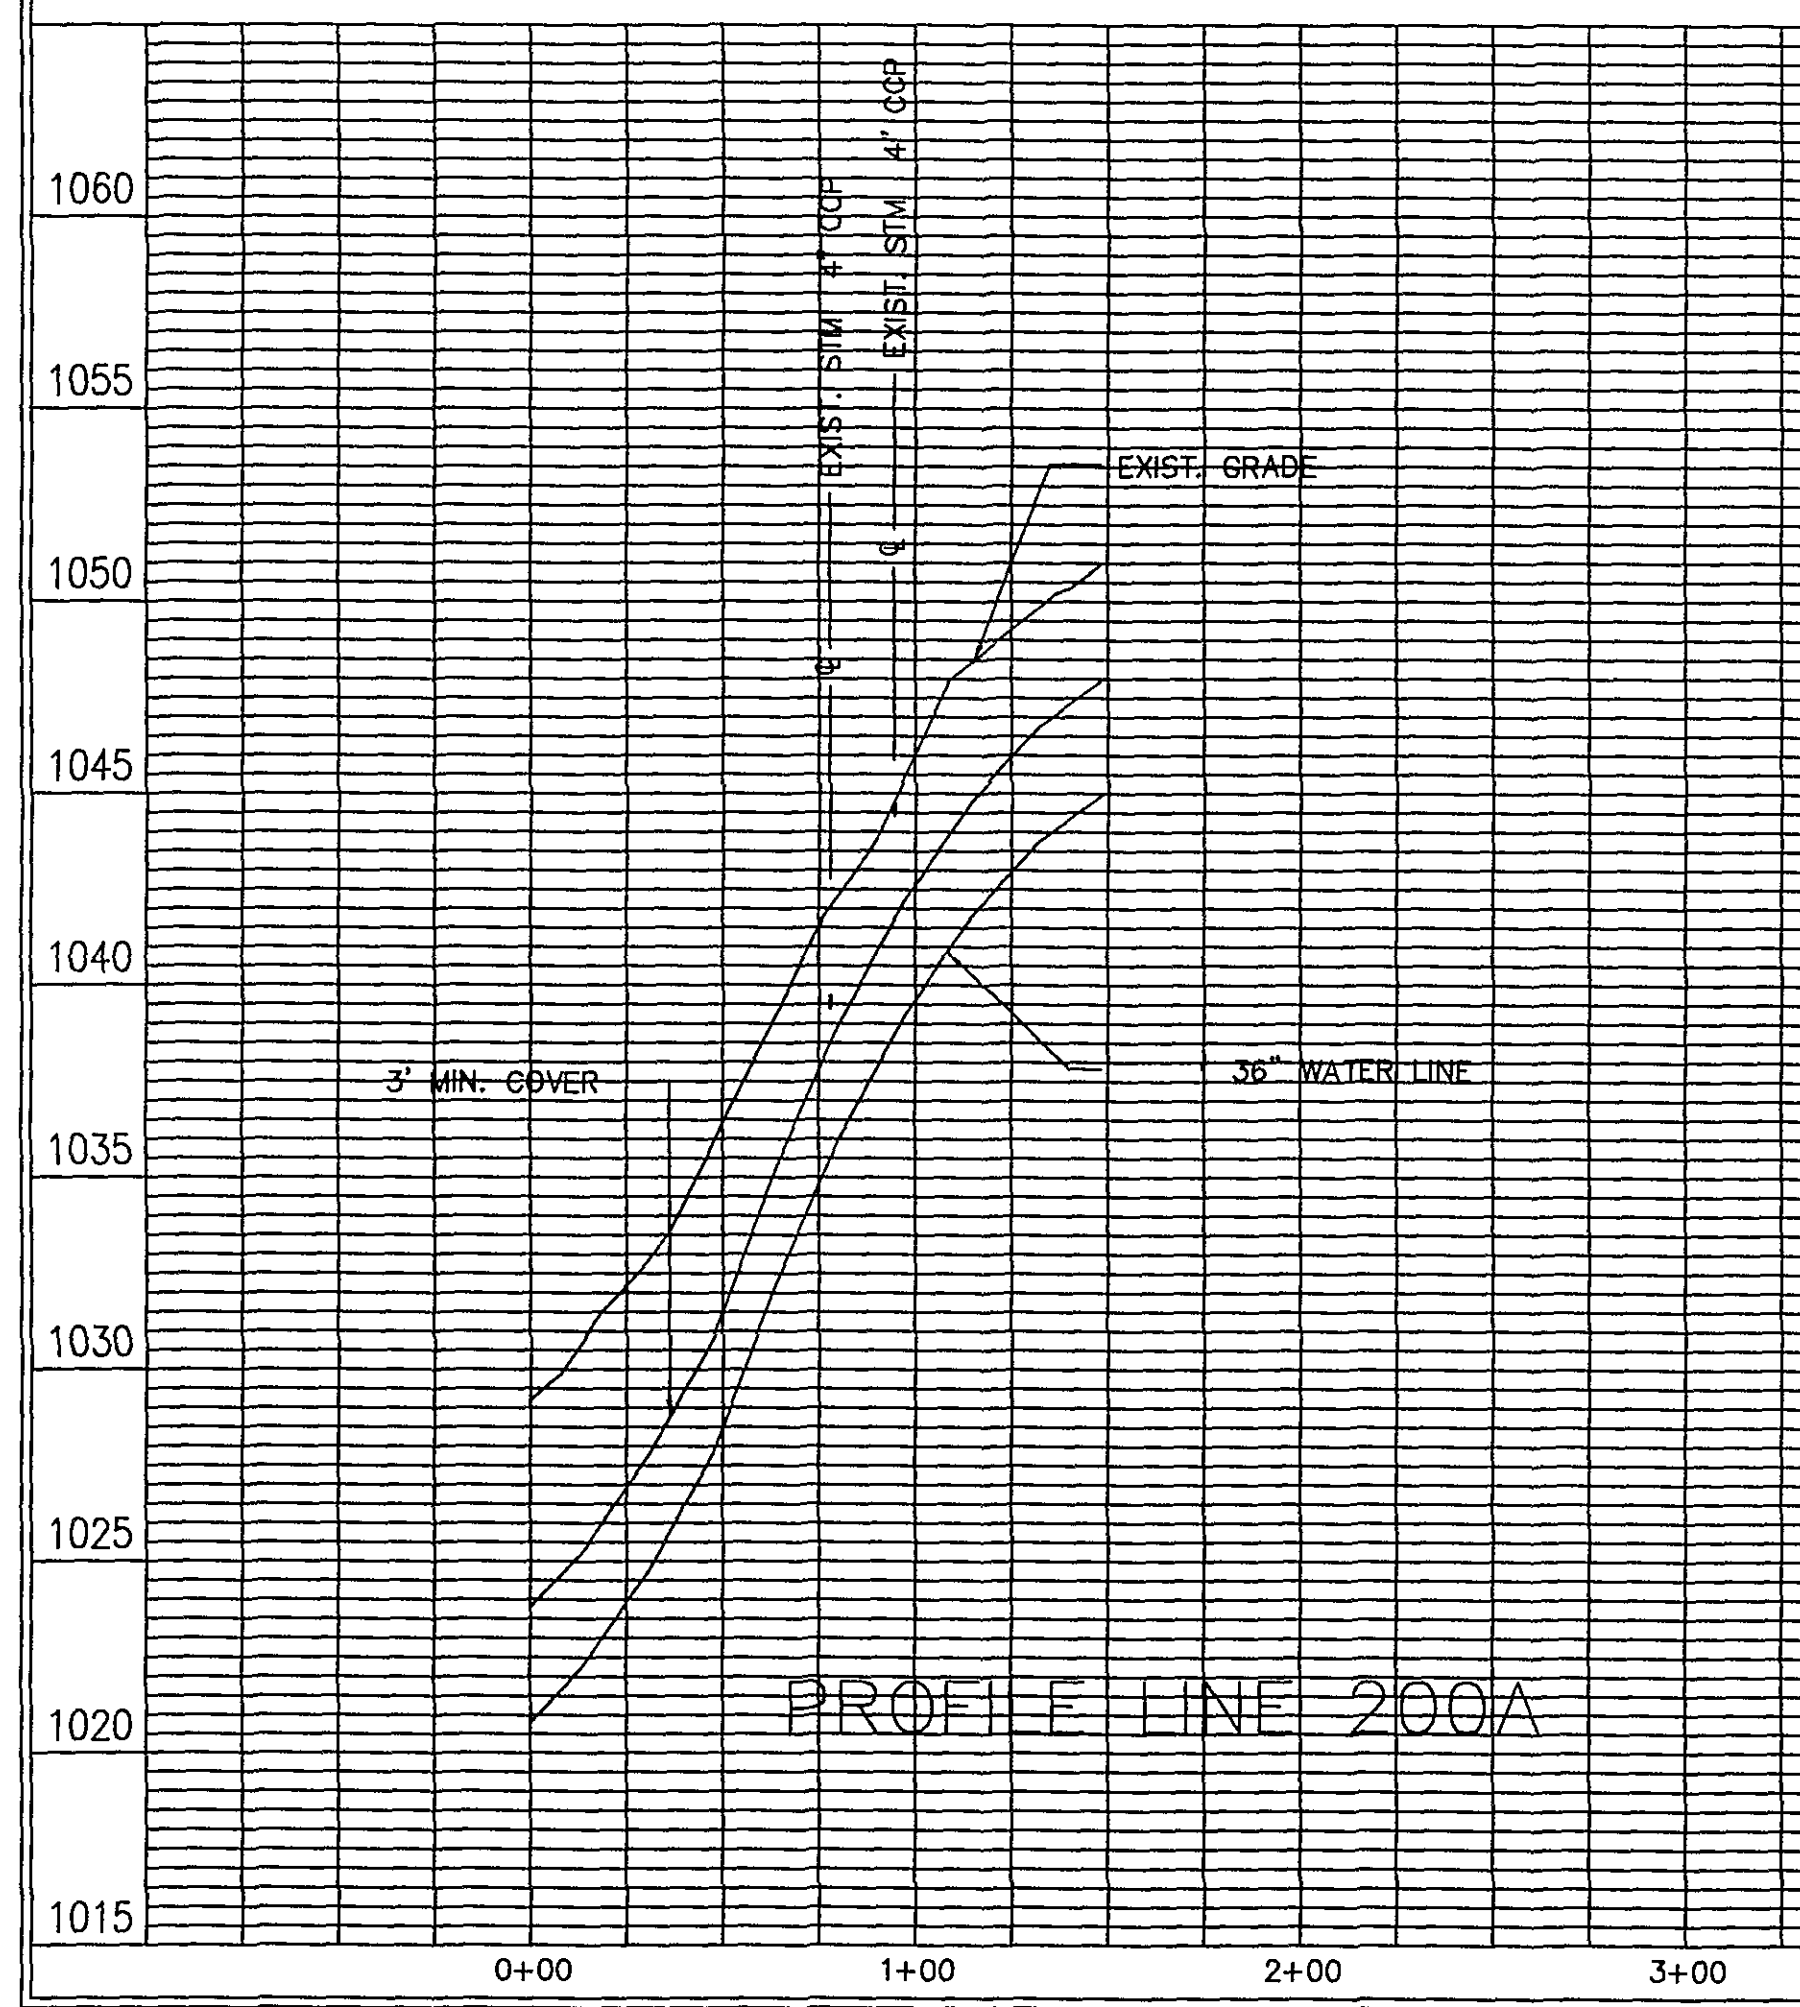

PROFILE LINE 200A

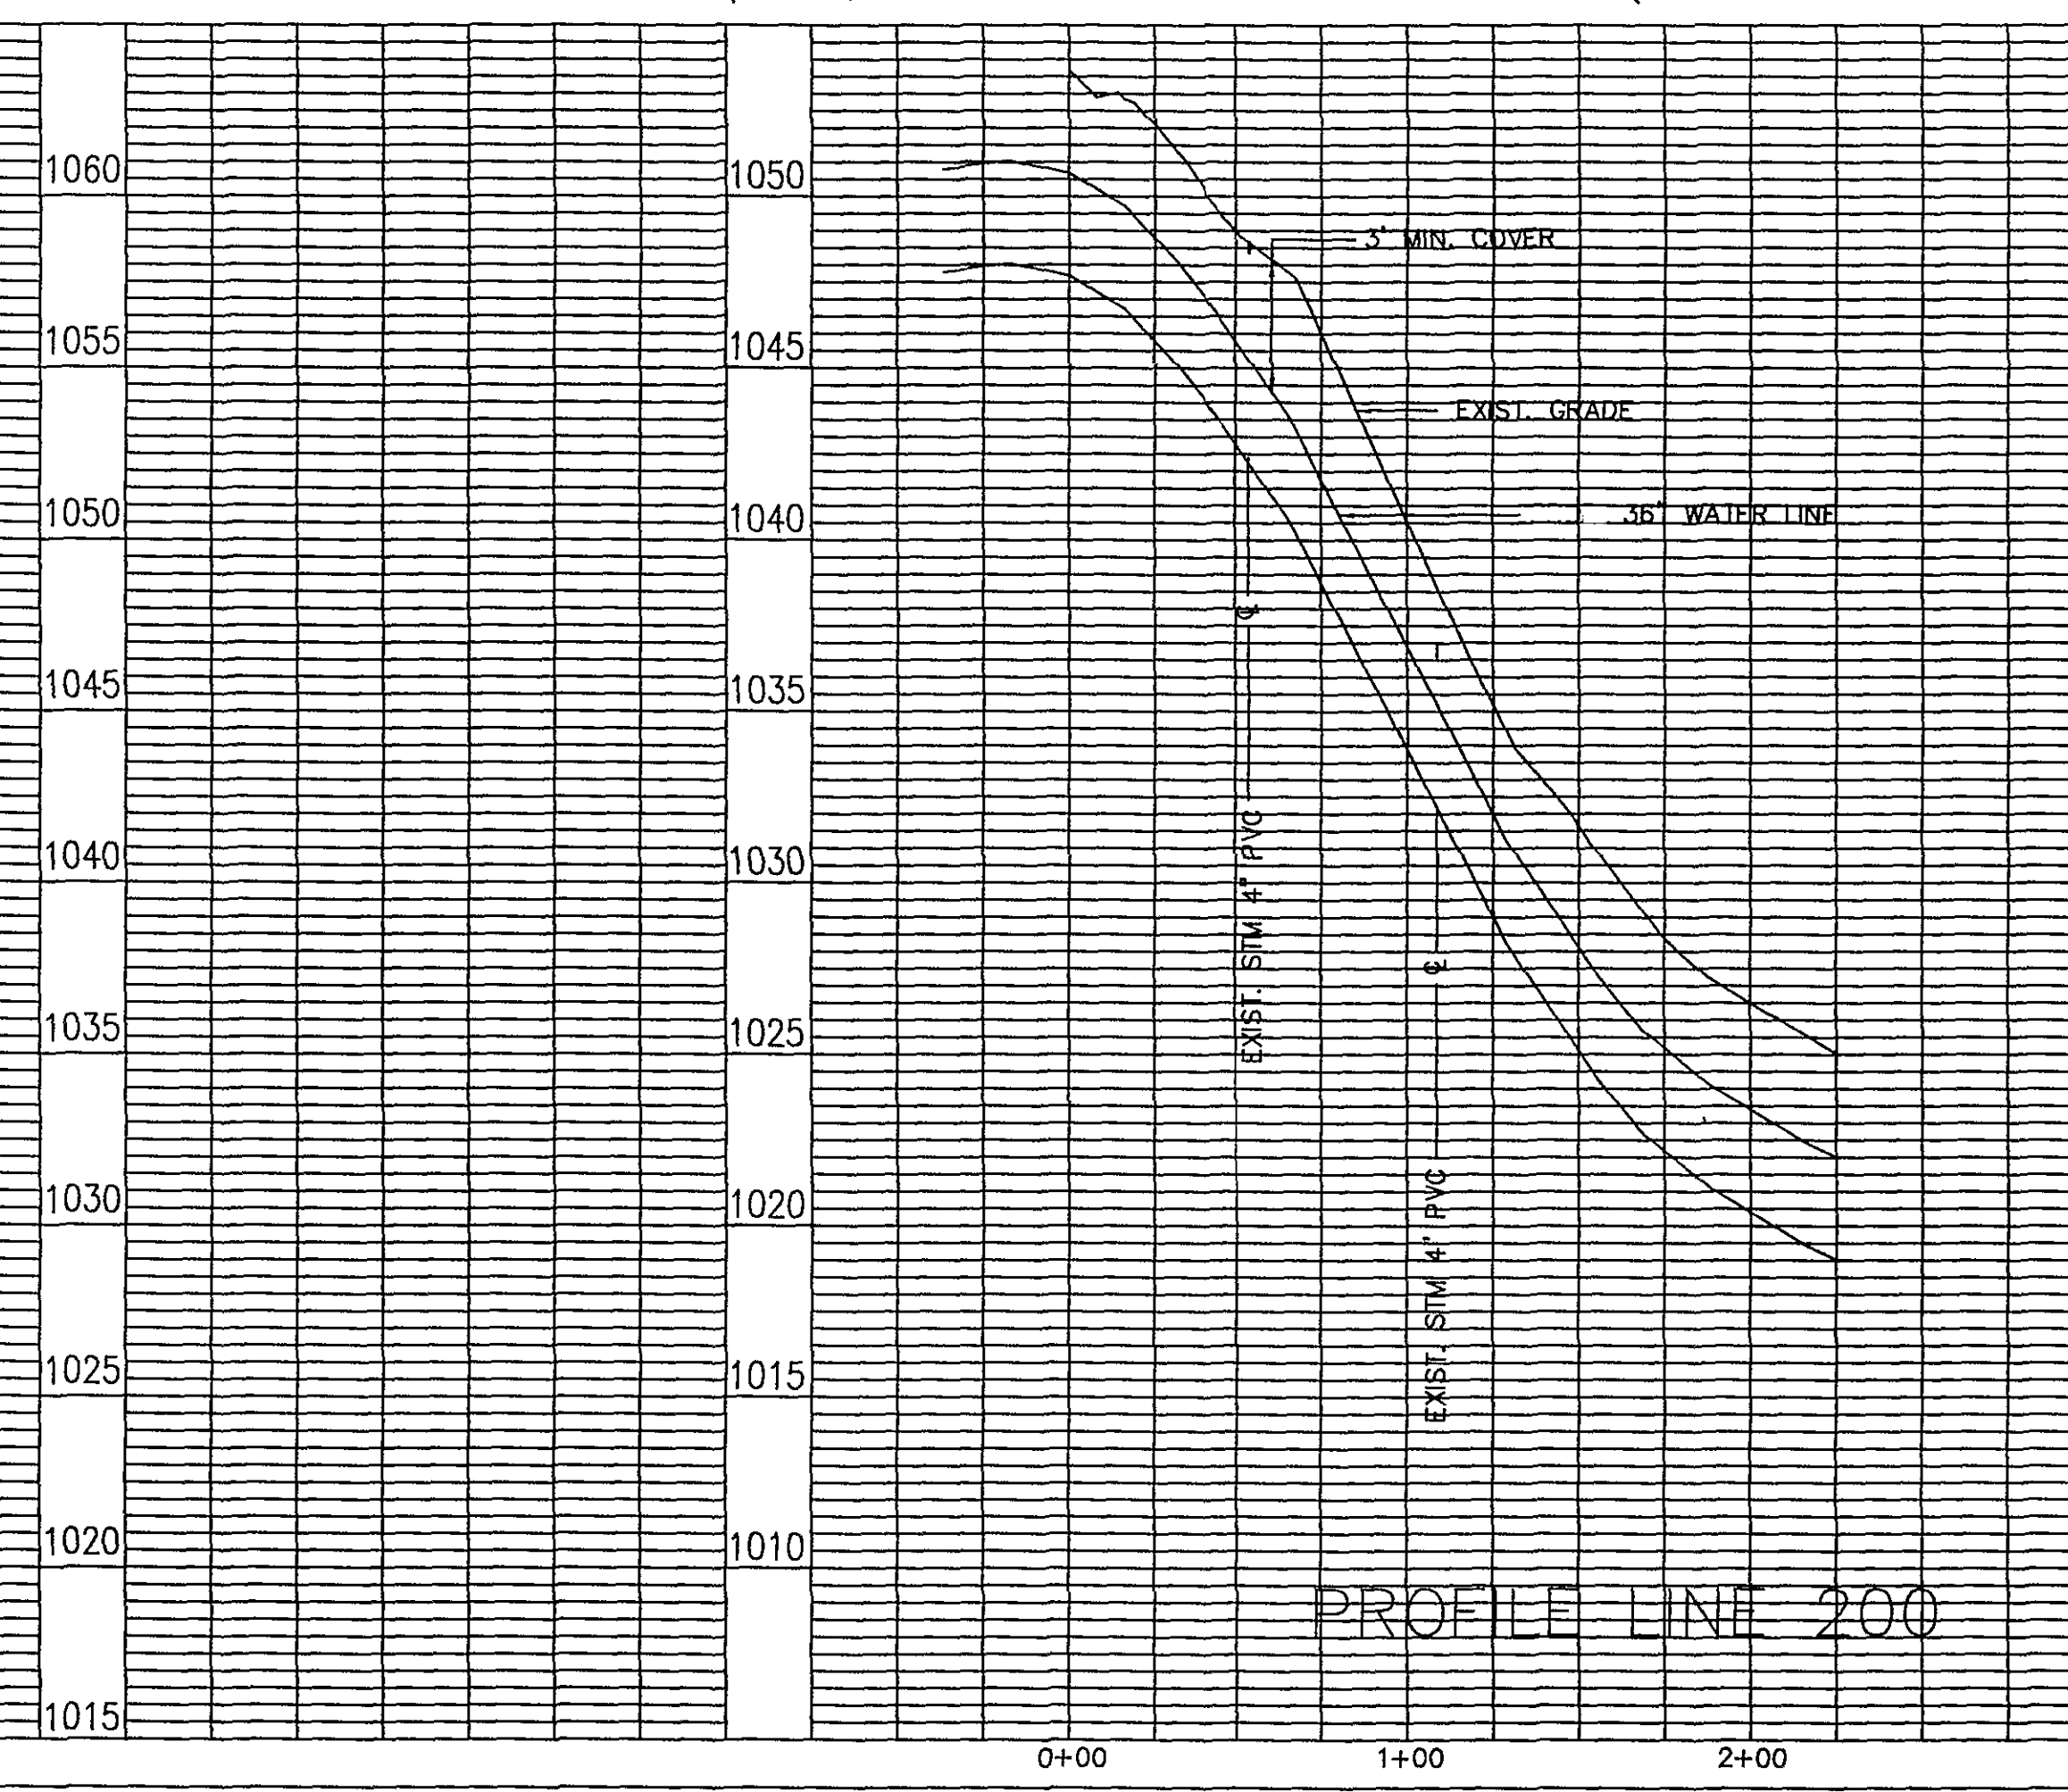

PROFILE LINE 200

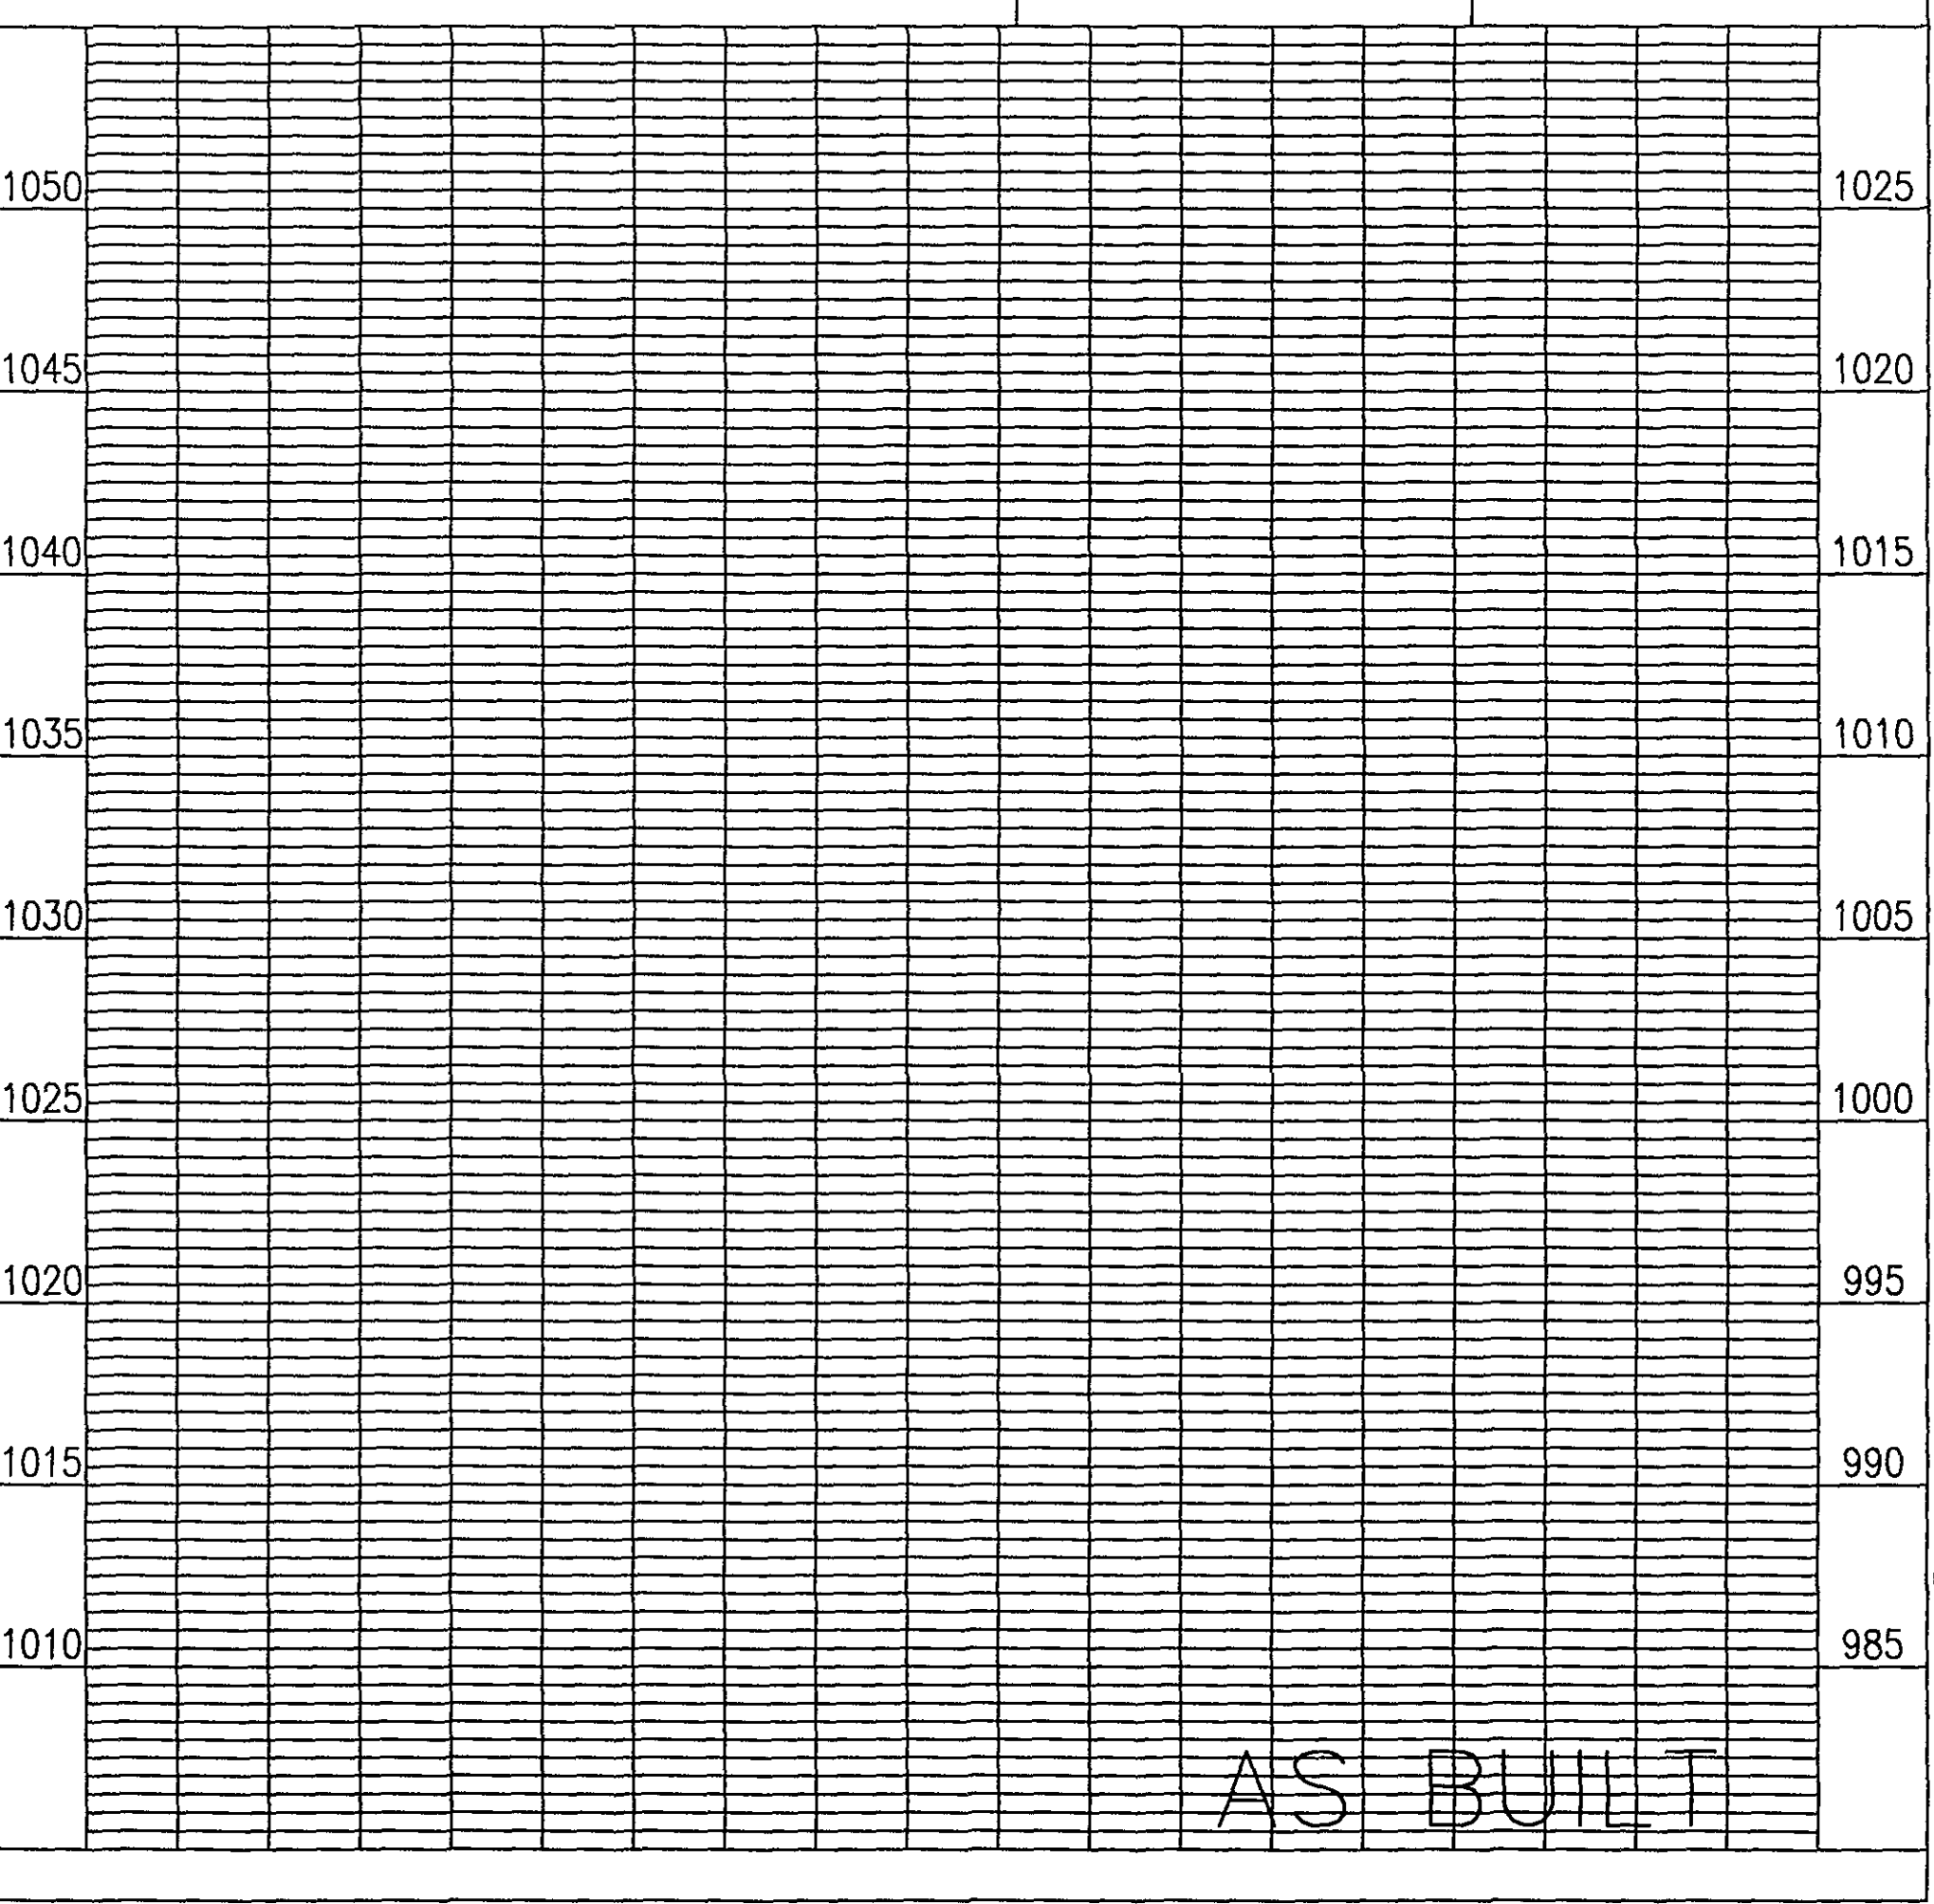

AS BUILT

Dewberry & Davis
Architects
Engineers
Planners
Surveyors
5238 Valleypointe Parkway, Suite One-B
Roanoke, Virginia 24019
703 962-7725

Carvins Cove, Phase II
City of Roanoke
Roanoke, Virginia

CONTRACT "B1"
LINE 200A
STA 0+00.00 - 1+49.17
LINE 200
STA 0+00.00 - 2+25.89

Drawn By REH/ACF
Designed By RBS
Checked By SEH
Date NOV 93 REV.
Scale V: 1" = 5'
H: 1" = 50'
Plan Number F14
Zoned NONE
Sheet 1 of 25
File Number C1160