

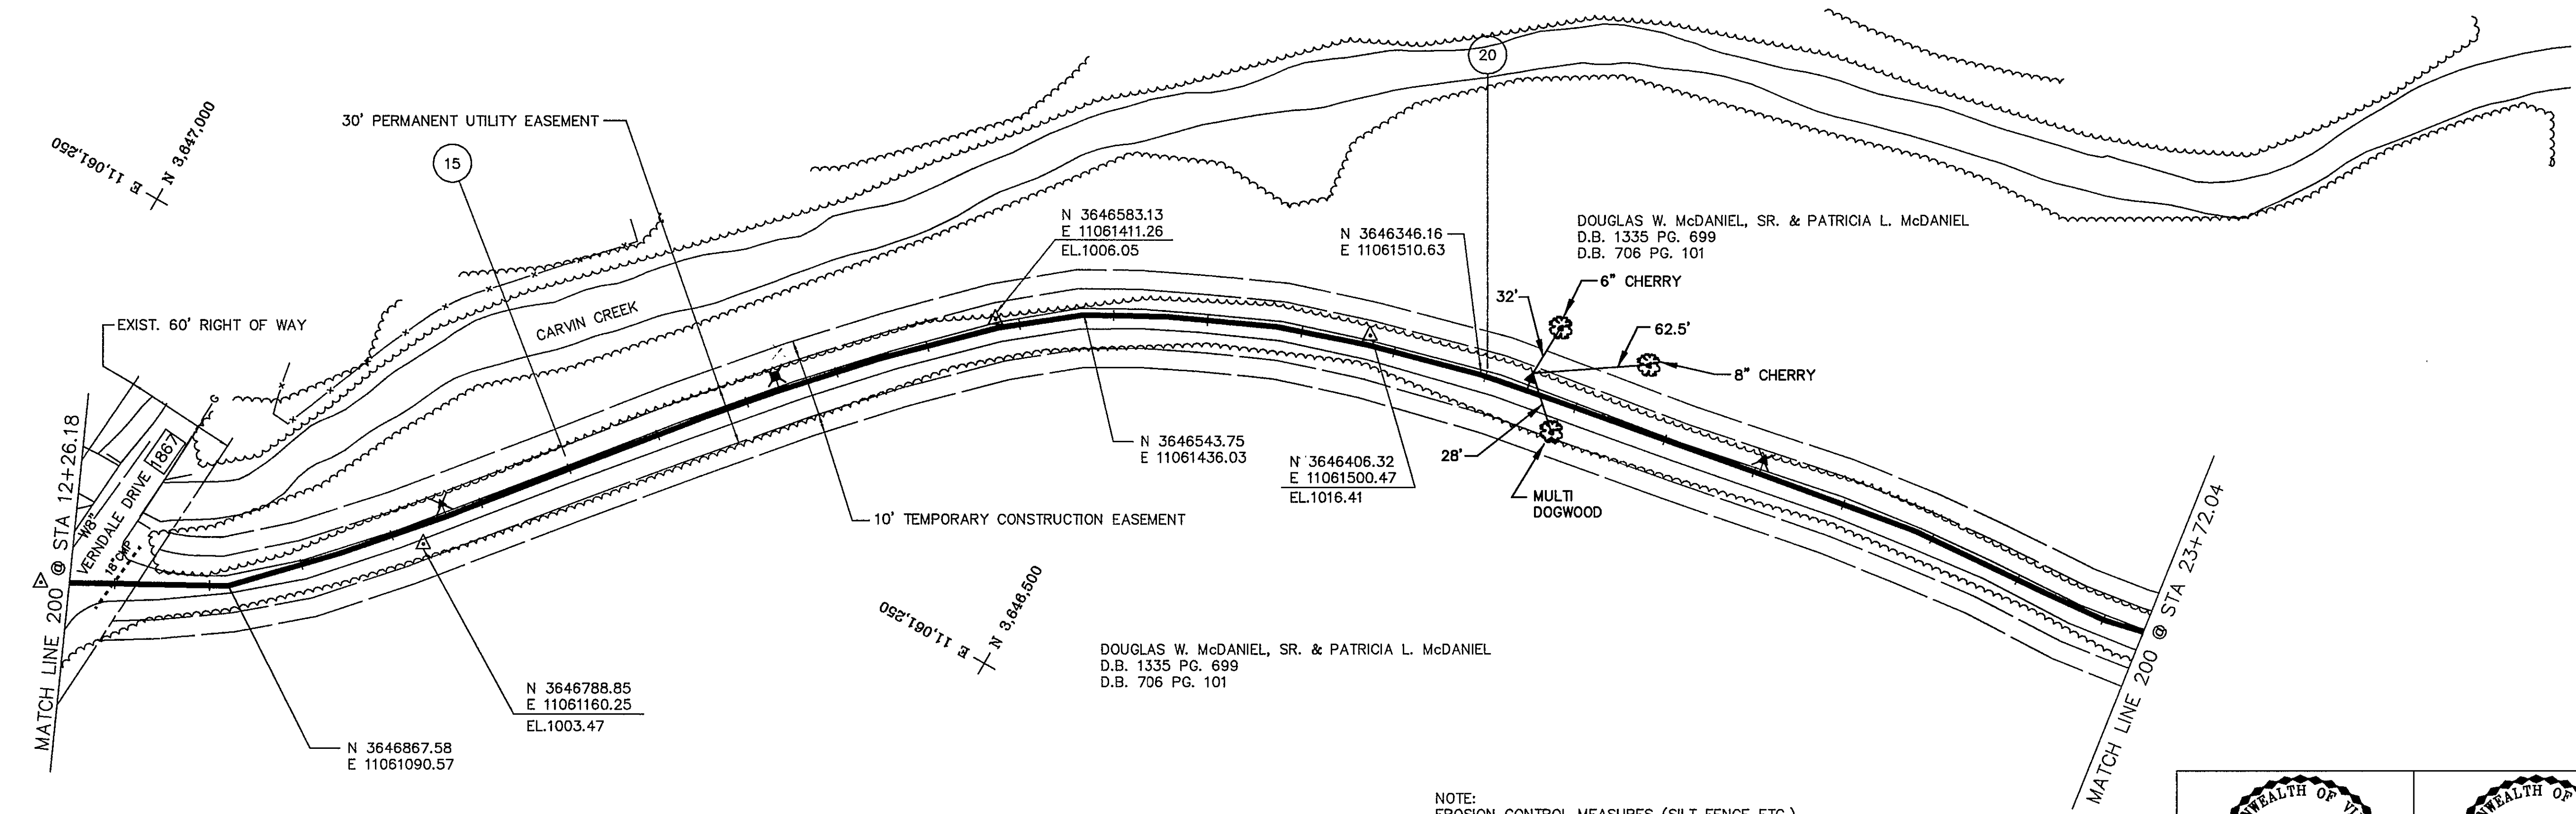


THIS SHEET
1146 LF 36" WATERMAIN
1 EA. 1" A.R.V.

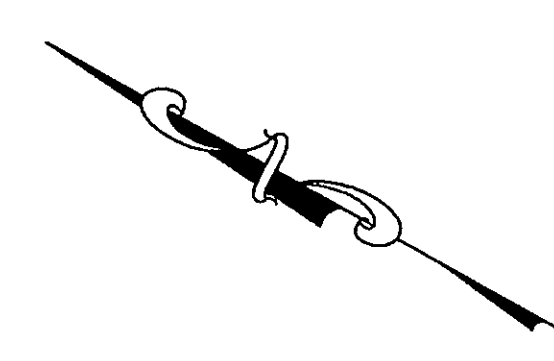


PLAN VIEW LINE 200


NOTE:
EROSION CONTROL MEASURES (SILT FENCE ETC.)
SHALL BE INSTALLED ON THE DOWN SLOPE OF
THE EXCAVATED TRENCH.
ADDITIONAL EROSION CONTROL MEASURES MAY
BE REQUIRED BY ROANOKE COUNTY.

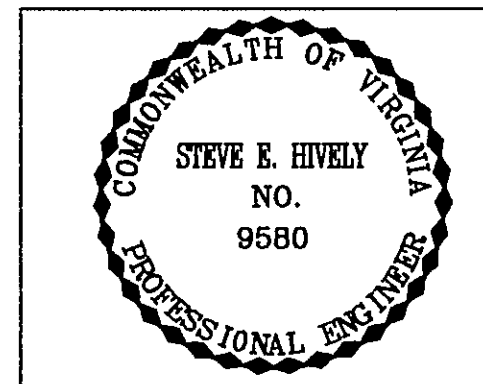

ENGINEER'S SEAL

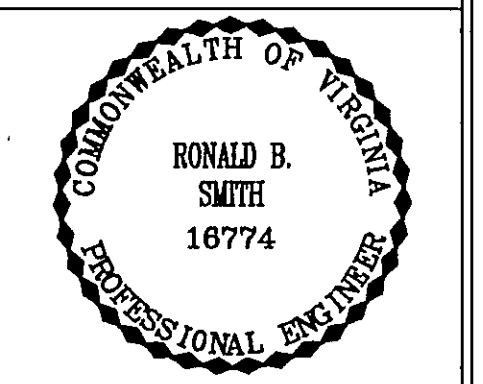

ENGINEER'S SEAL

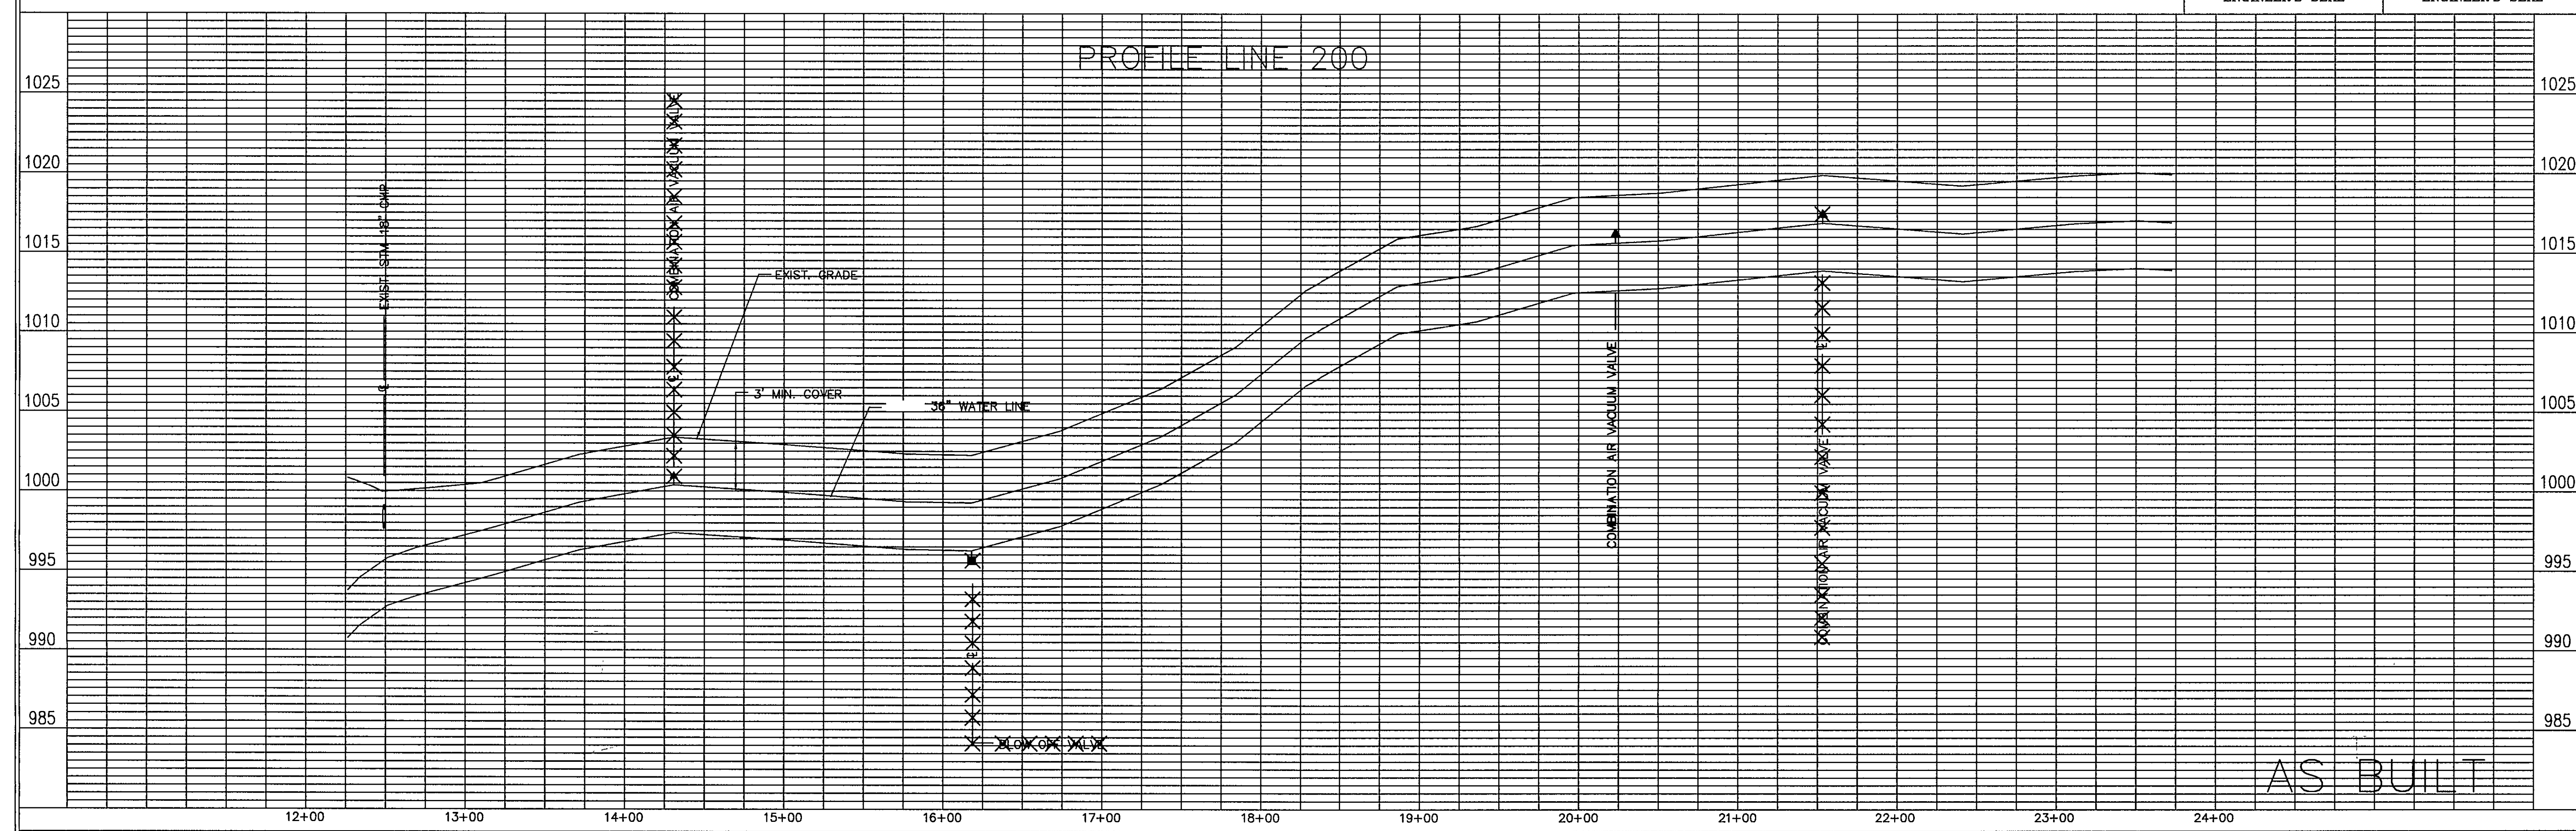

PROFILE LINE 200

AS BUILT

Architects
Engineers
Planners
Surveyors

Dewberry & Davis
5238 Valleypointe Parkway, Suite One-B
Roanoke, Virginia 24019
703 362-7725

Carvins Cove, Phase II
City of Roanoke
Roanoke, Virginia

CONTRACT "B1"
LINE 200
STA 12+26.18 - 23+72.04

Drawn By REH/ACF
Designed By RBS
Checked By SEH
Date OCT 93 REV.
Scale V: 1" = 5'
H: 1" = 50'
Plan Number E2
Zoned NONE
Sheet 3 of 25
File Number C1160