



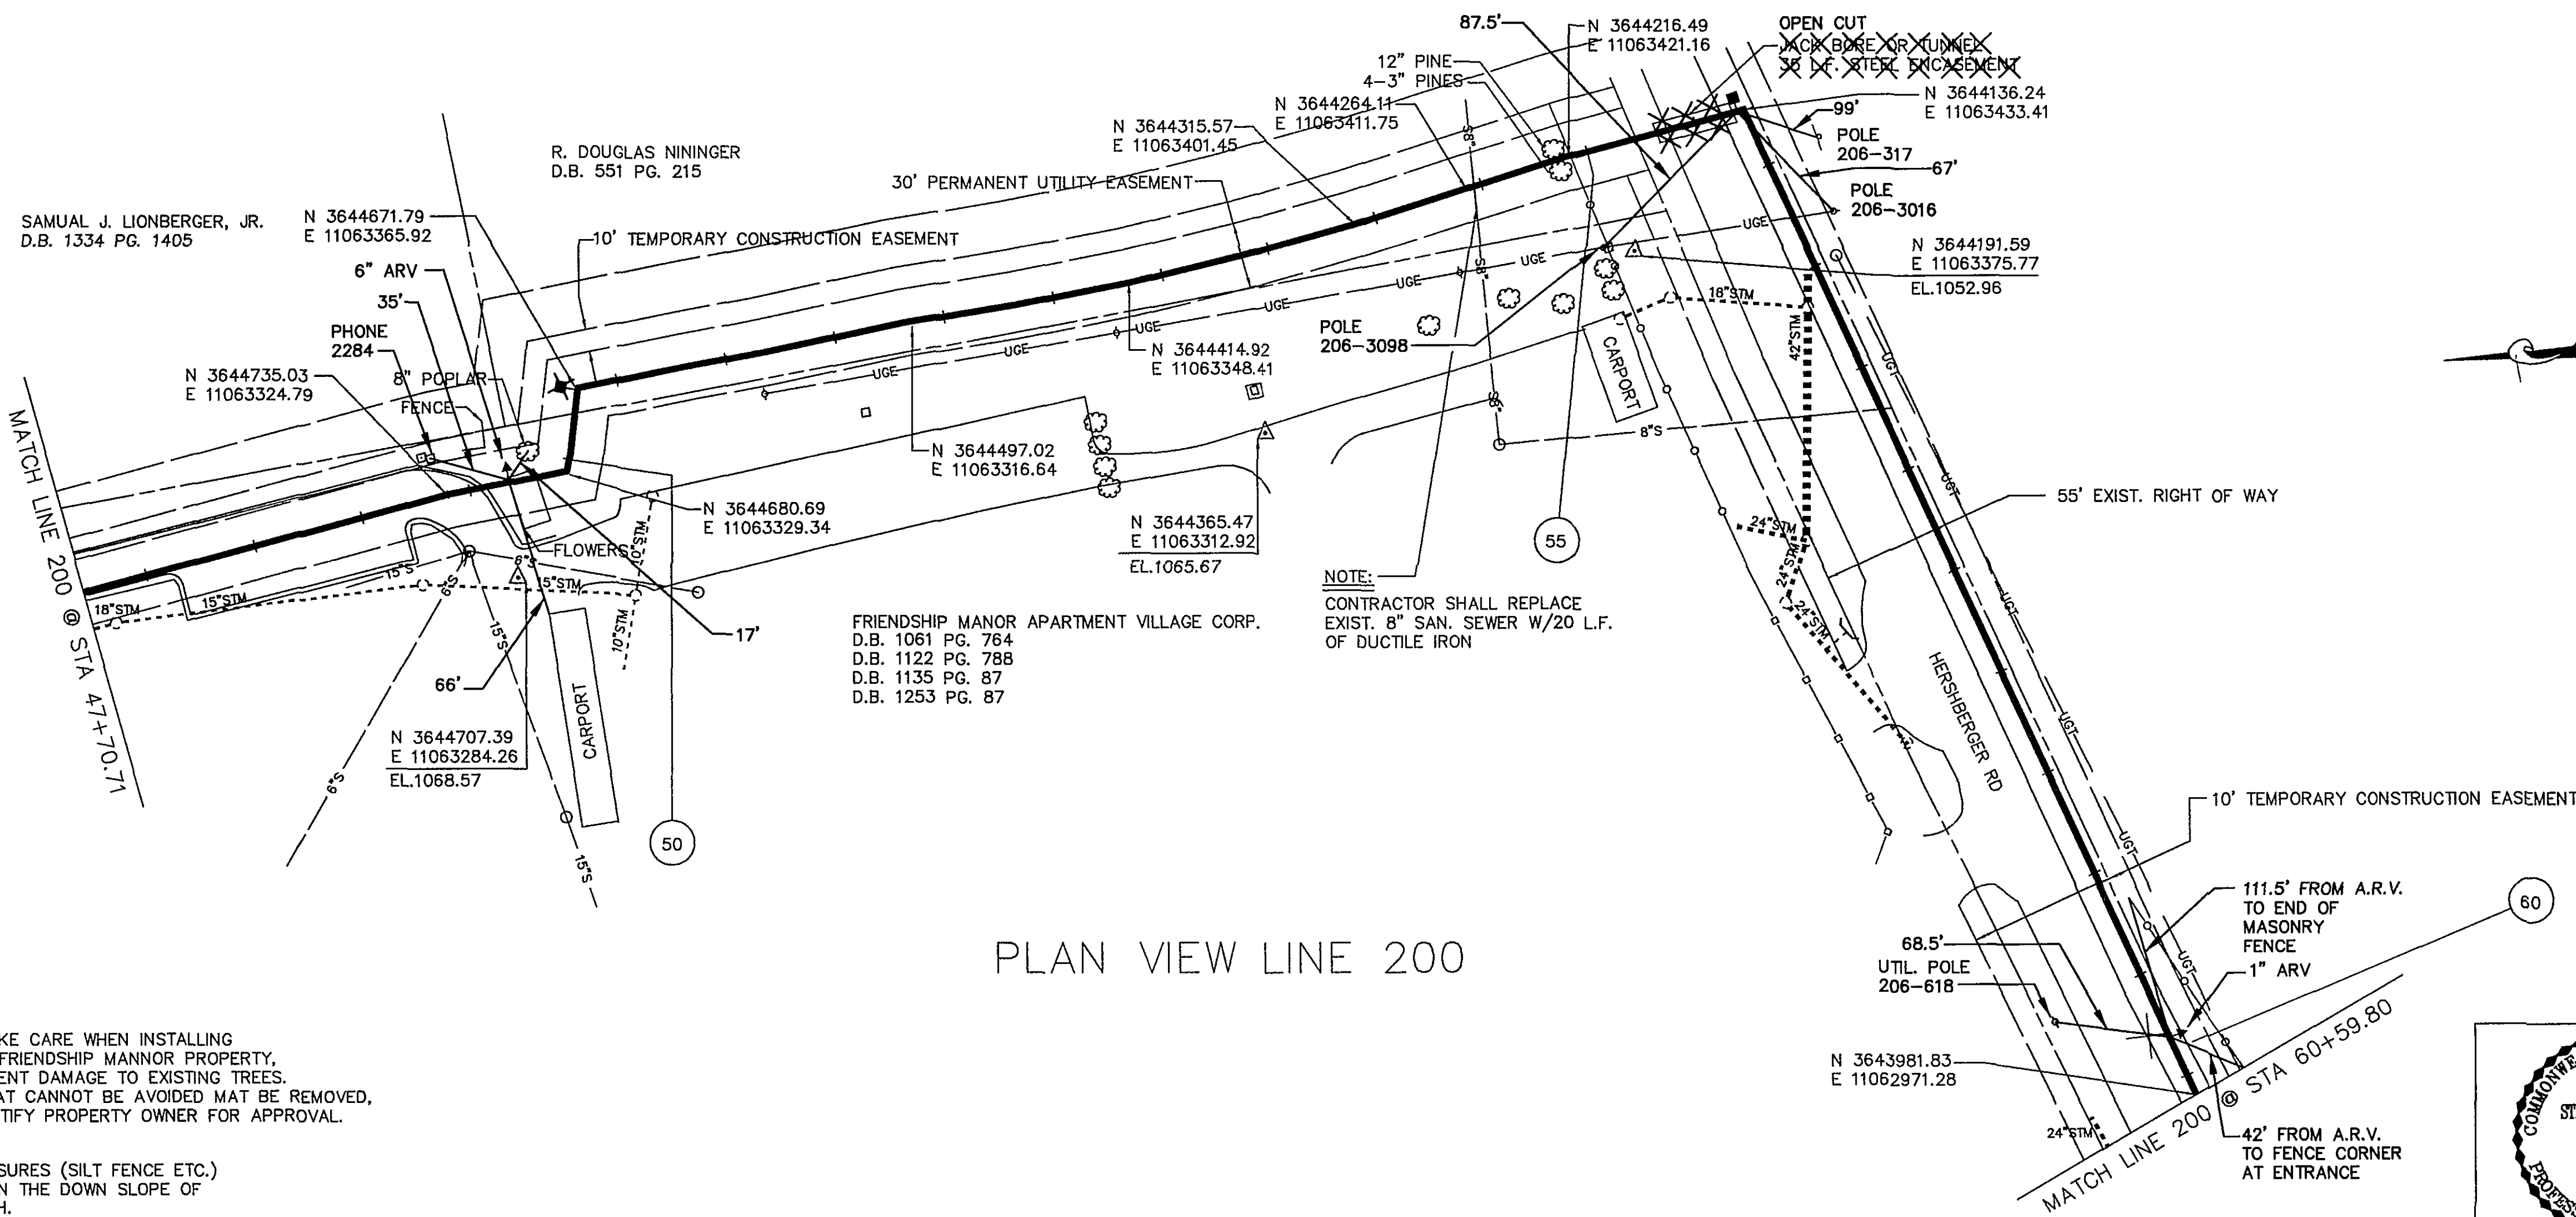


THIS SHEET
 1289 LF 36" WATERMAIN
 1 EA. 8" BLOWOFF
 1 EA. 6" A.R.V.
 1 EA. 1" A.R.V.

- NOTE:
- CONTRACTOR SHALL TAKE CARE WHEN INSTALLING PROP. WATER LINE ON FRIENDSHIP MANNOR PROPERTY, TO INSURE NO PERMANENT DAMAGE TO EXISTING TREES. ONLY THOSE TREES THAT CANNOT BE AVOIDED MAY BE REMOVED. CONTRACTOR SHALL NOTIFY PROPERTY OWNER FOR APPROVAL.
 - EROSION CONTROL MEASURES (SILT FENCE ETC.) SHALL BE INSTALLED ON THE DOWN SLOPE OF THE EXCAVATED TRENCH. ADDITIONAL EROSION CONTROL MEASURES MAY BE REQUIRED BY ROANOKE COUNTY.


PLAN VIEW LINE 200

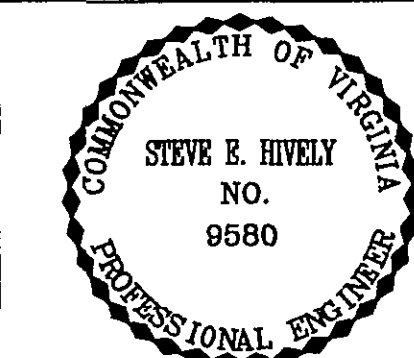

ENGINEER'S SEAL

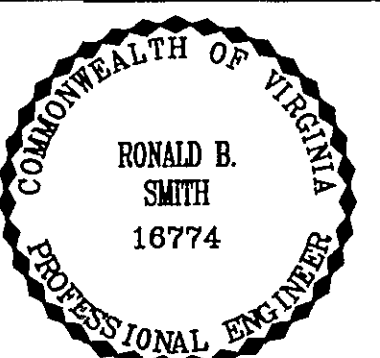

ENGINEER'S SEAL

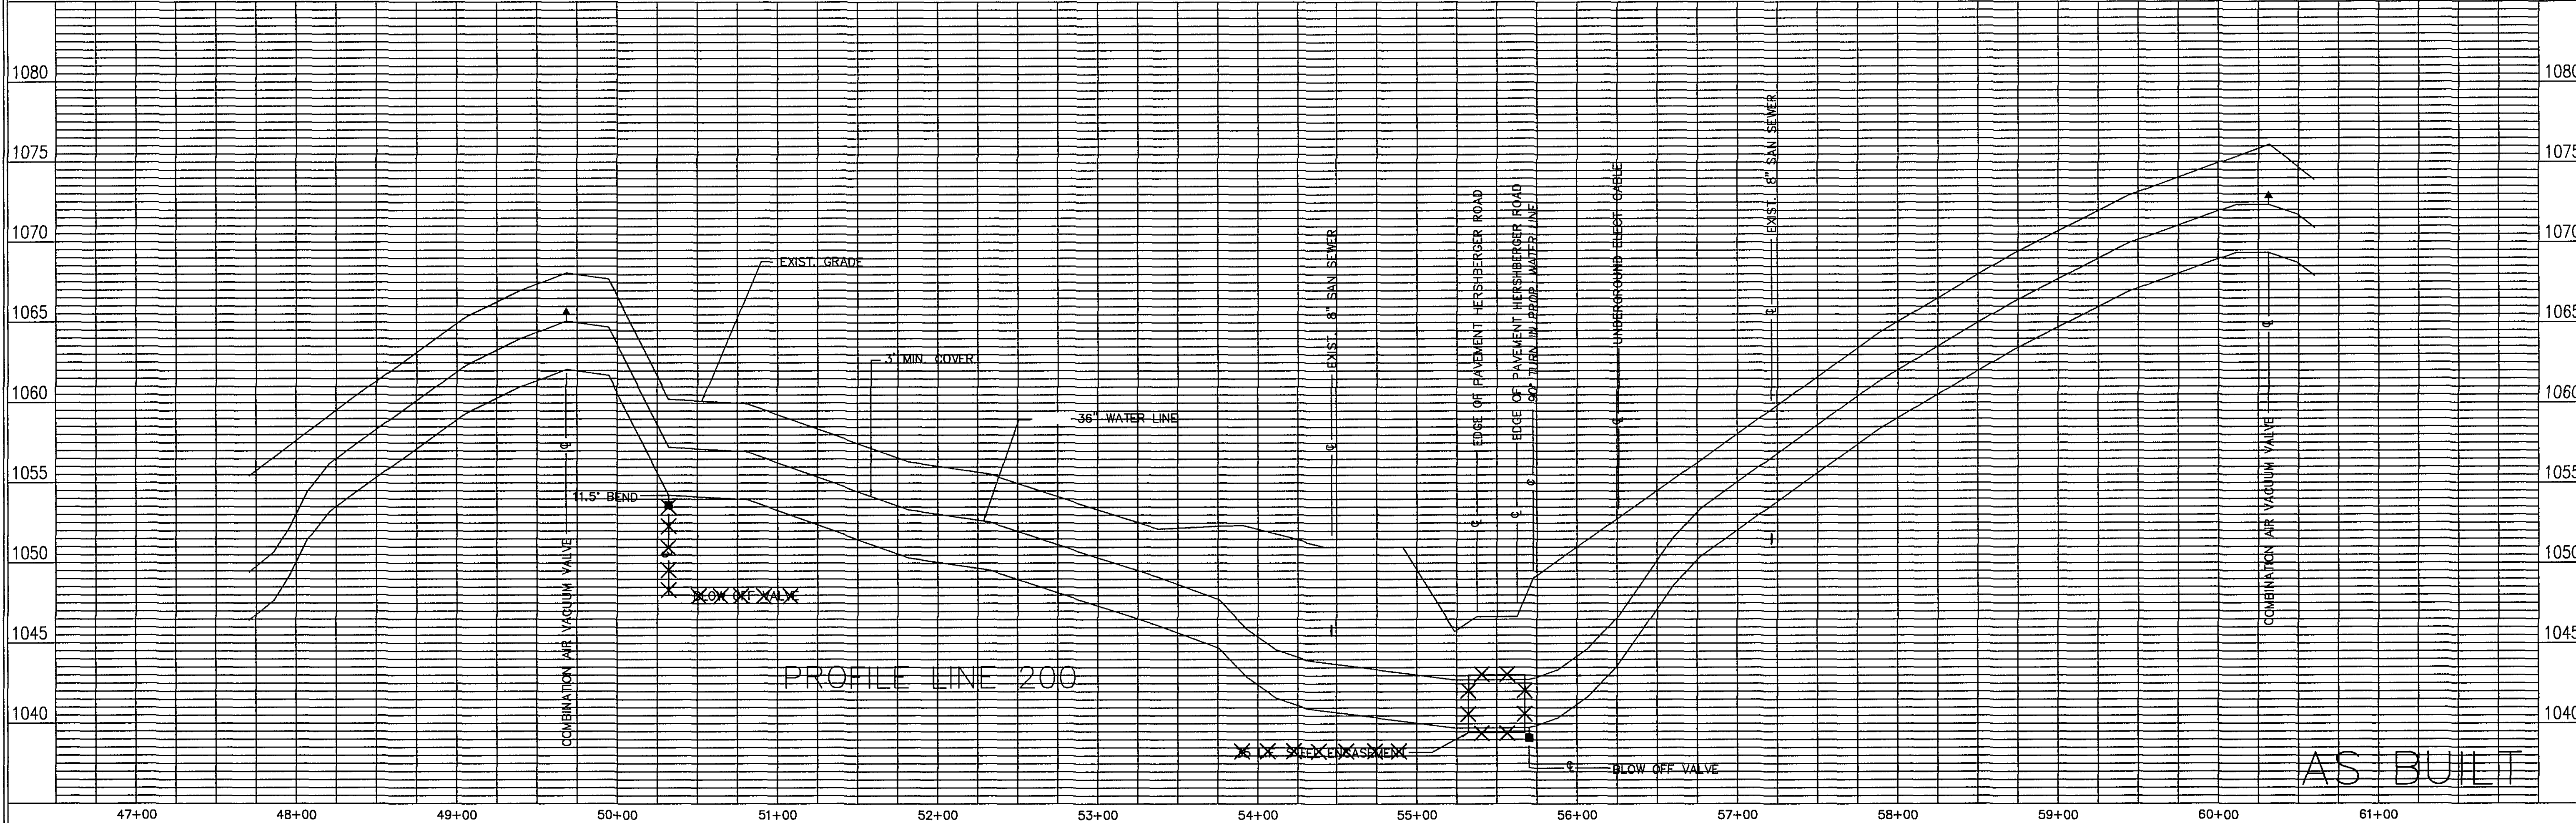

AS BUILT

Dewberry & Davis
 Architects
 Engineers
 Planners
 Surveyors
 5238 Valleypointe Parkway, Suite One-B
 Roanoke, Virginia 24019
 ☎ 703 362-7725

Carvins Cove, Phase II
 City of Roanoke
 Roanoke, Virginia

CONTRACT "B1"
 LINE 200
 STA 47+70.71 - 60+59.80

Drawn By REH/ACF
 Designed By RBS
 Checked By SEH
 Date OCT 93 REV.
 Scale V: 1" = 5'
 H: 1" = 50'
 Plan Number E3B
 Zoned NONE
 Sheet 6 of 25
 File Number C1160