

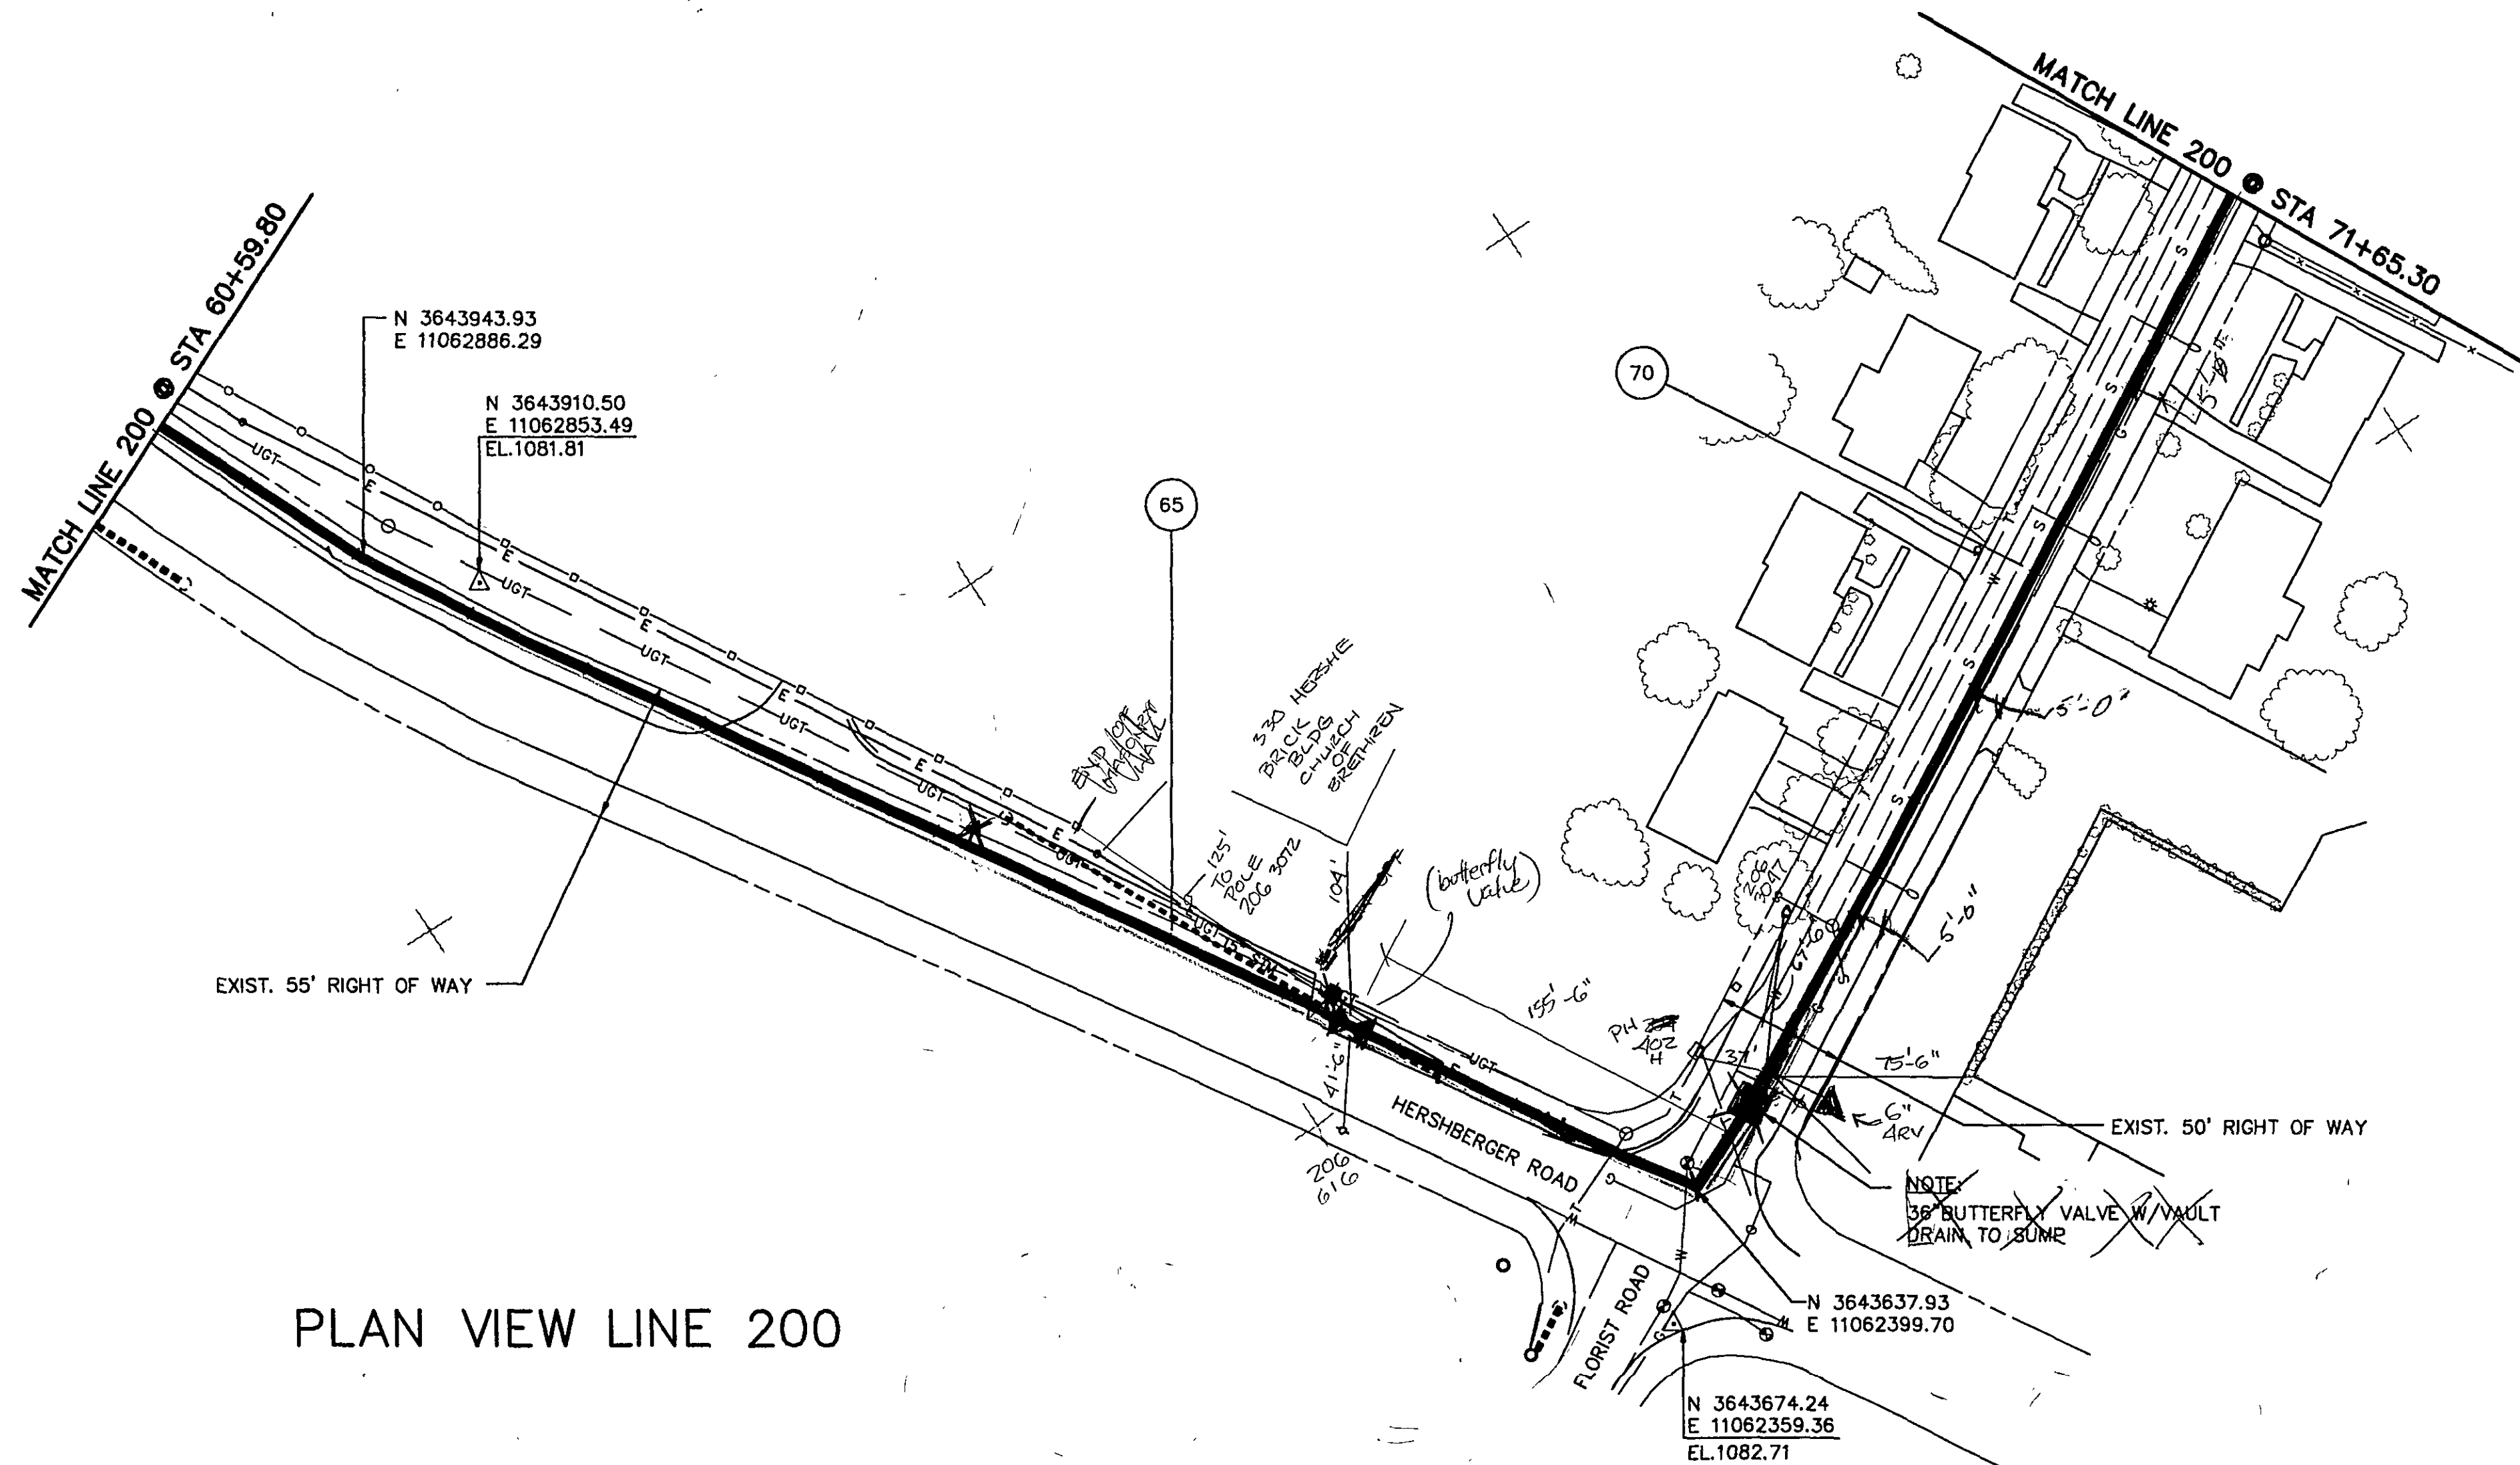
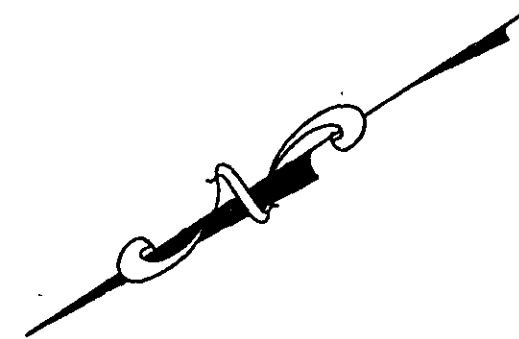
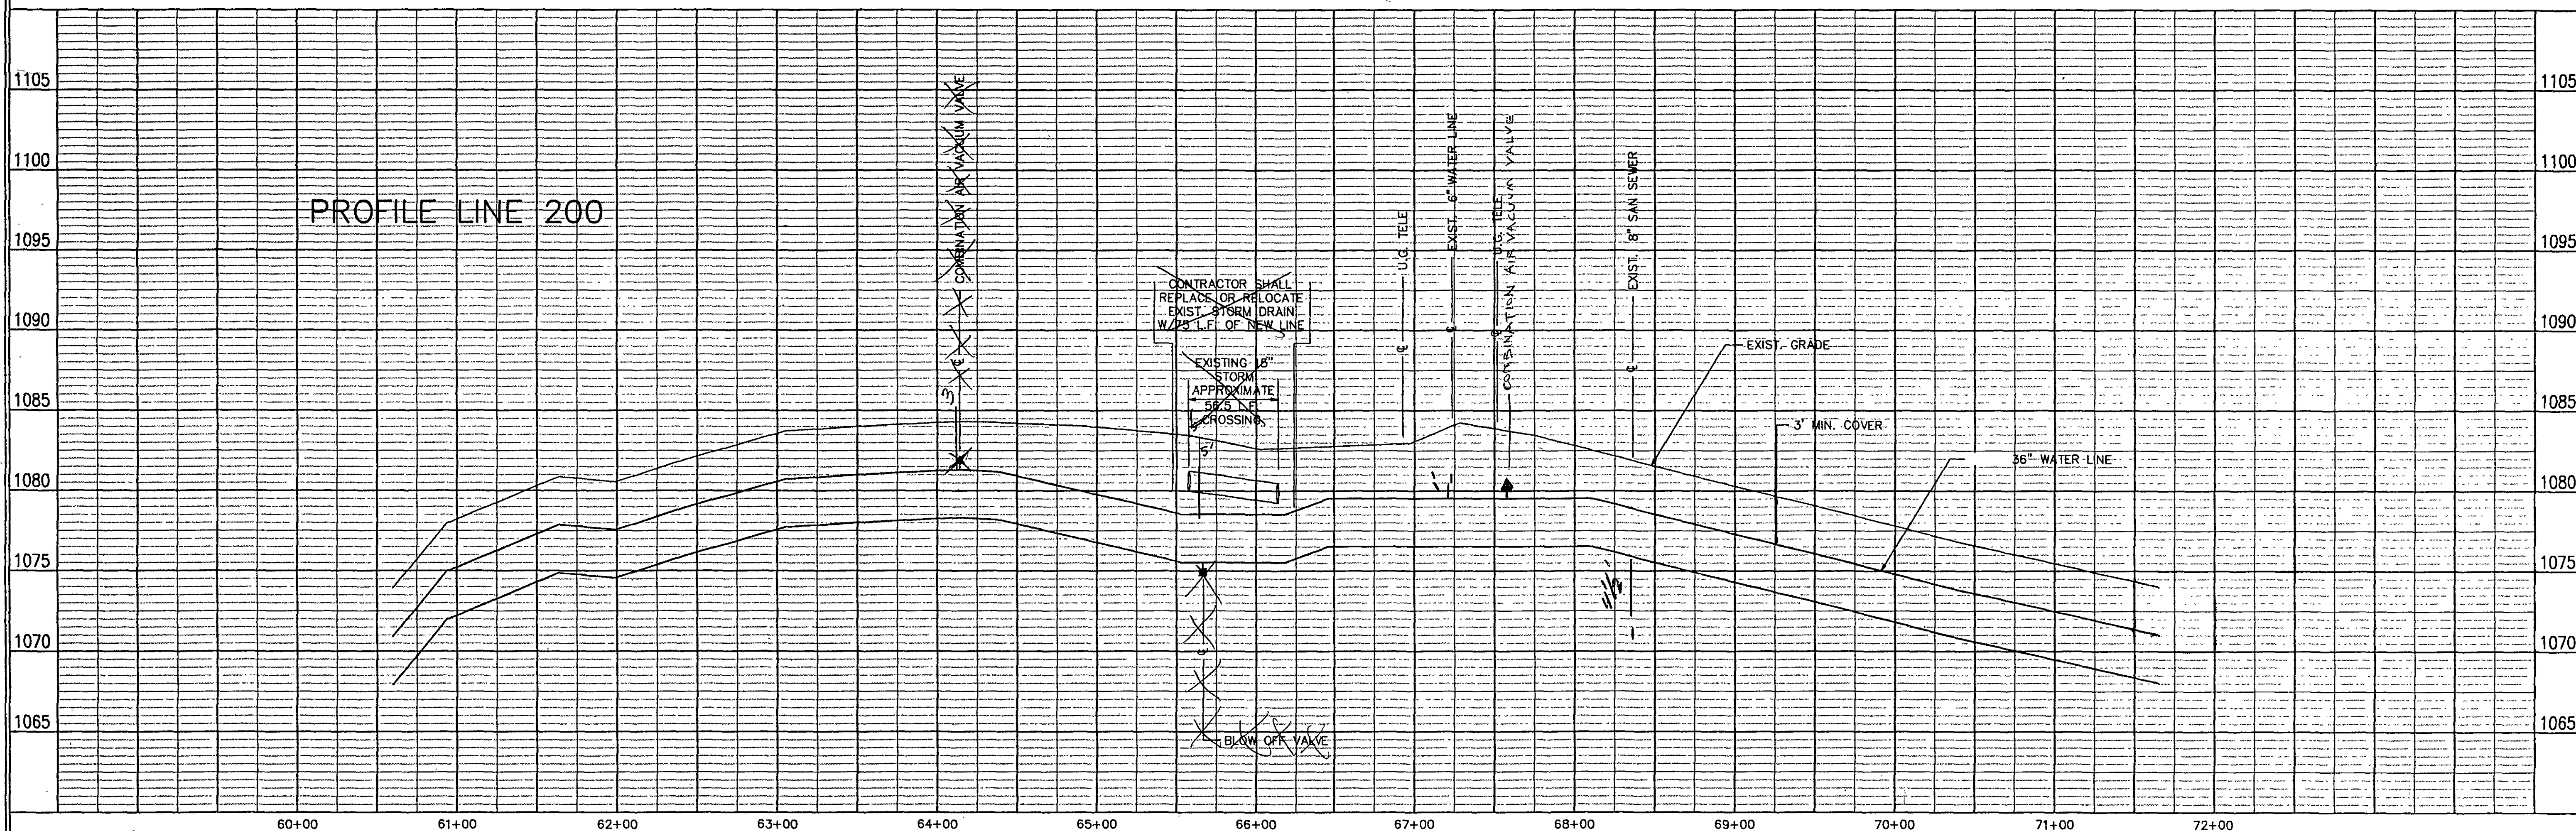


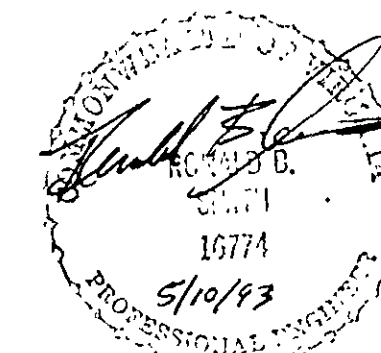

PLAN VIEW LINE 200

N 3,643,250  
E 11,062,250

1105 LF 36" WATERMAIN  
1 EA 36" BUTTERFLY VALVE  
1 EA 6" ARV

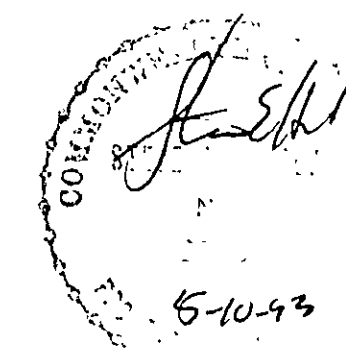

PROFILE LINE 200

|                                                                                                                                                                               |                                                                       |
|-------------------------------------------------------------------------------------------------------------------------------------------------------------------------------|-----------------------------------------------------------------------|
| <b>Dewberry &amp; Davis</b><br>Architects<br>Engineers<br>Planners<br>Surveyors<br>5238 Valleypointe Parkway, Suite One-B<br>Roanoke, Virginia 24019<br>703 362-7725          | <b>Carvins Cove, Phase II</b><br>City of Roanoke<br>Roanoke, Virginia |
|                                                                                                                                                                               | <b>CONTRACT "B1"</b><br><b>LINE 200</b><br>STA 60+59.80 - 71+65.30    |
| Drawn By REH/ACF<br>Designed By RBS<br>Checked By SEH<br>Date MAY 93<br>Scale V: 1" = 5'<br>H: 1" = 50'<br>Plan Number E4<br>Zoned NONE<br>Sheet 7 of 25<br>File Number C1160 |                                                                       |