

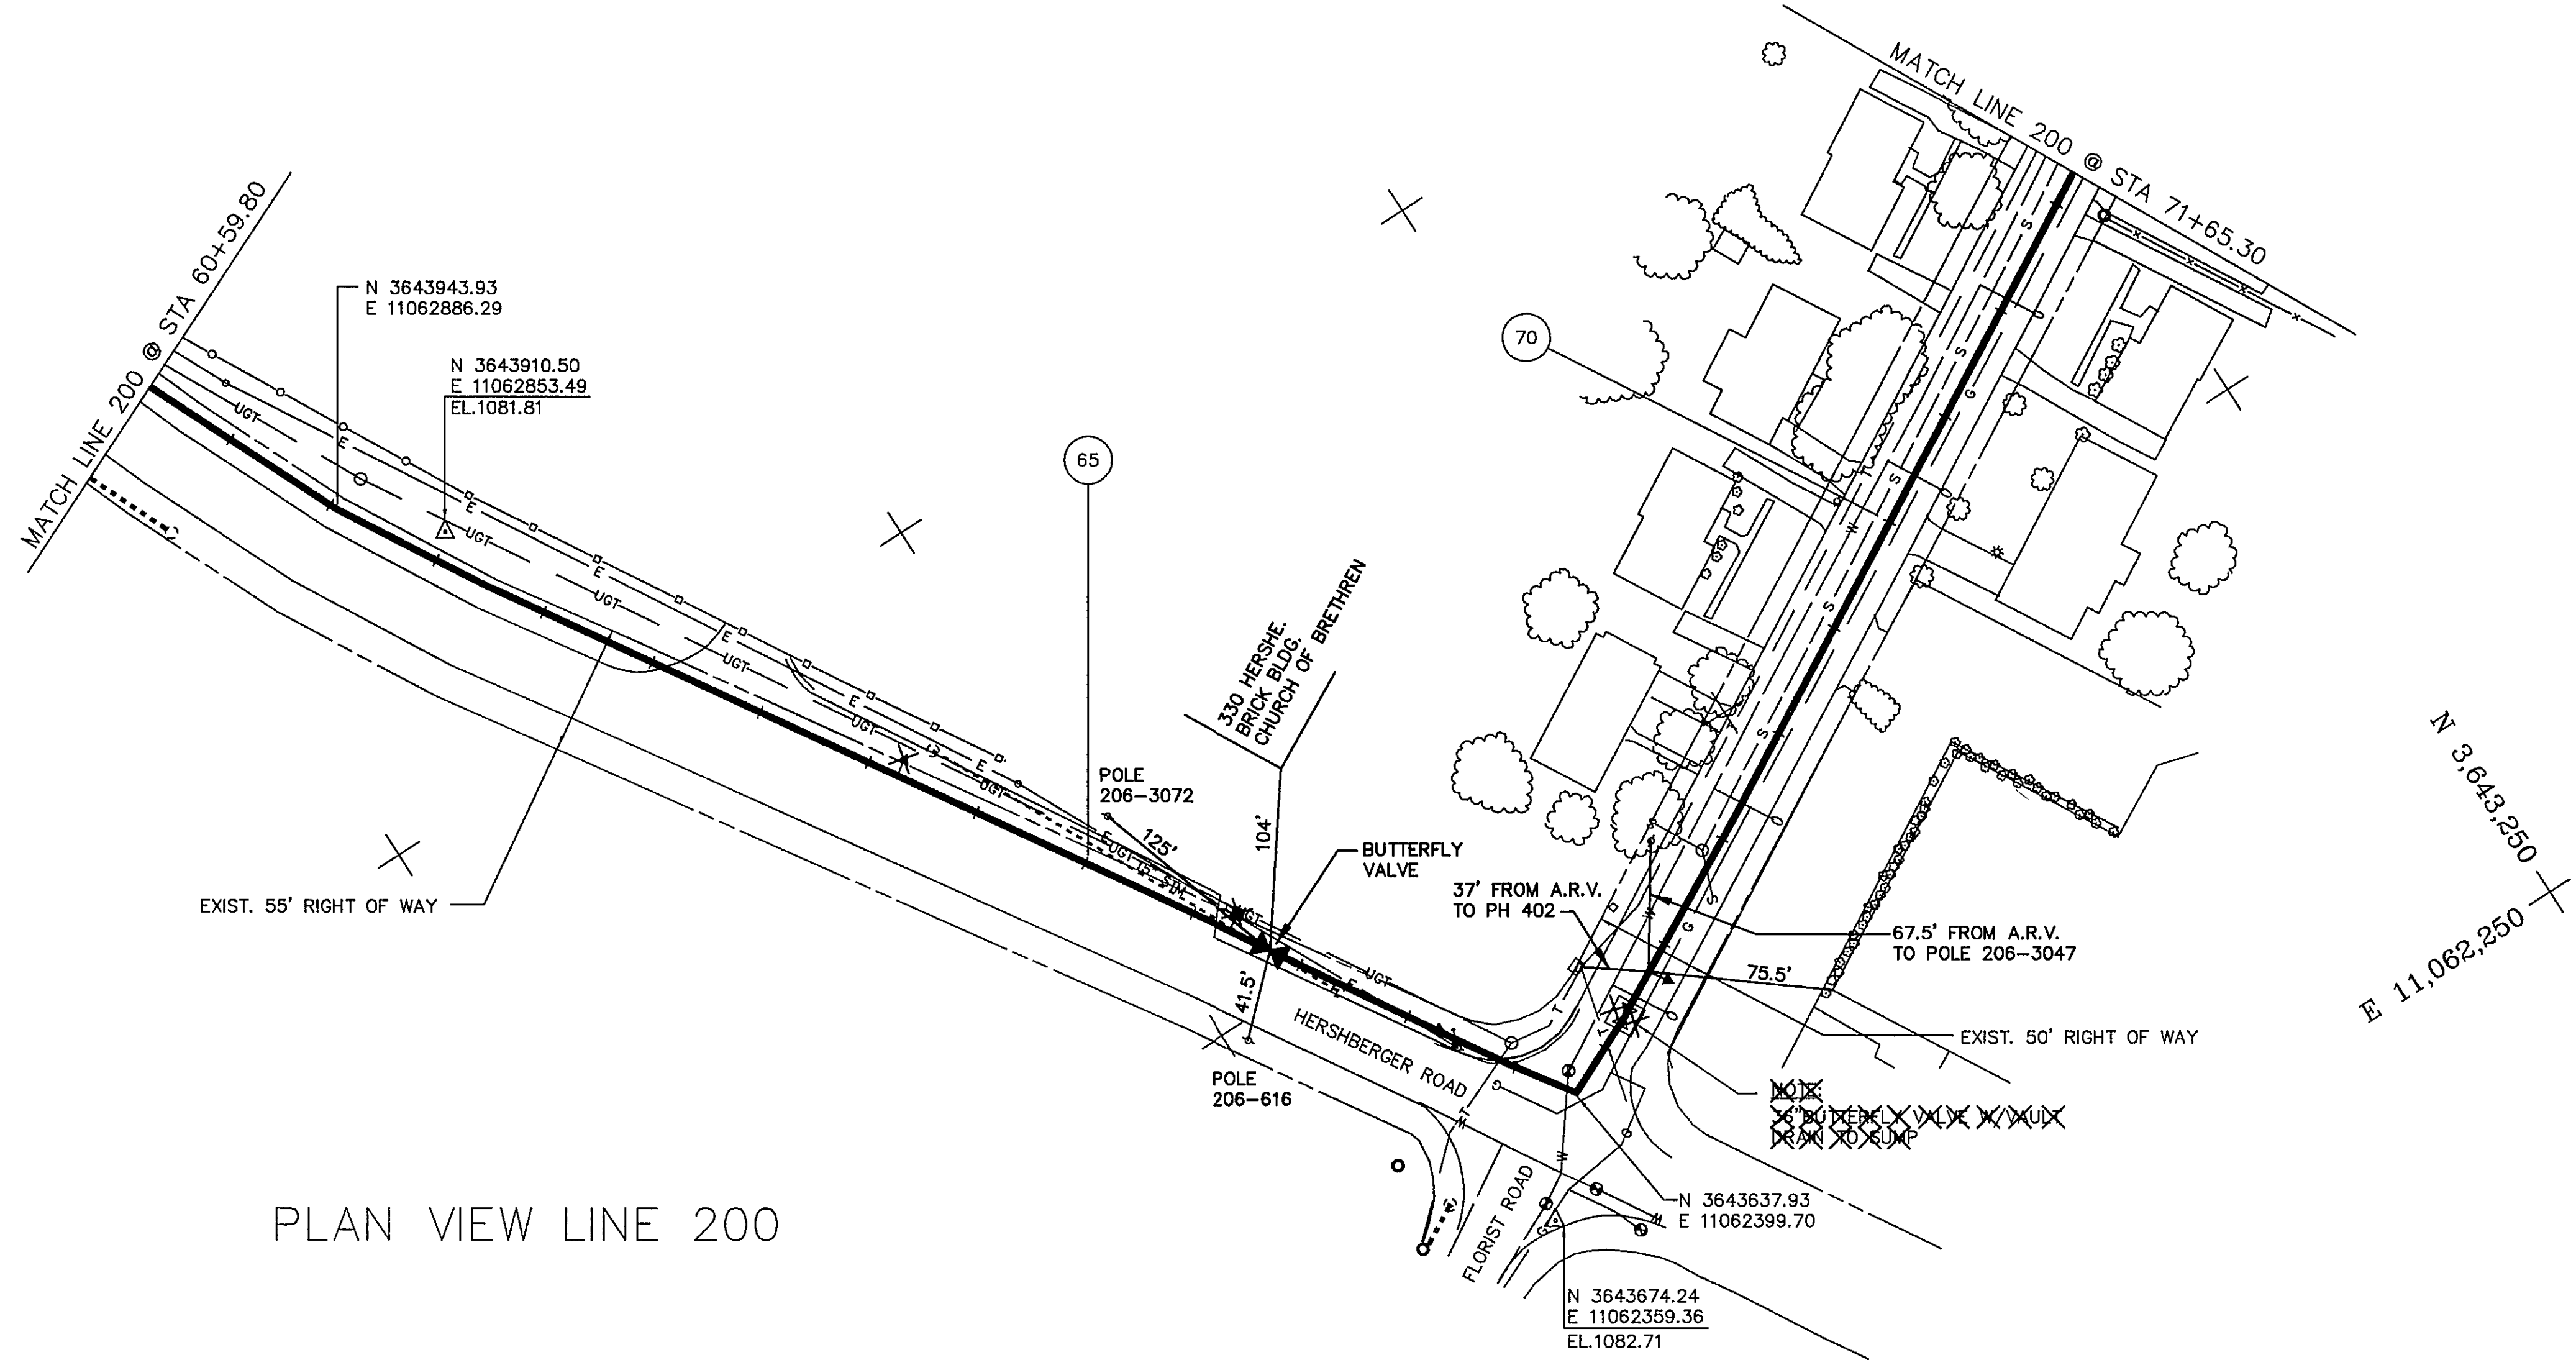


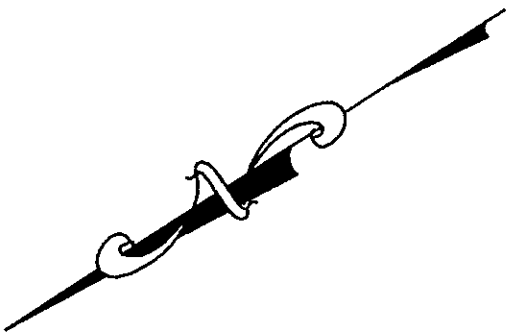

PLAN VIEW LINE 200

THIS SHEET
1105 LF 36" WATERMAIN
1 EA. 36" BUTTERFLY VALVE
1 EA. 6" A.R.V.

N 3,643,250
E 11,062,250

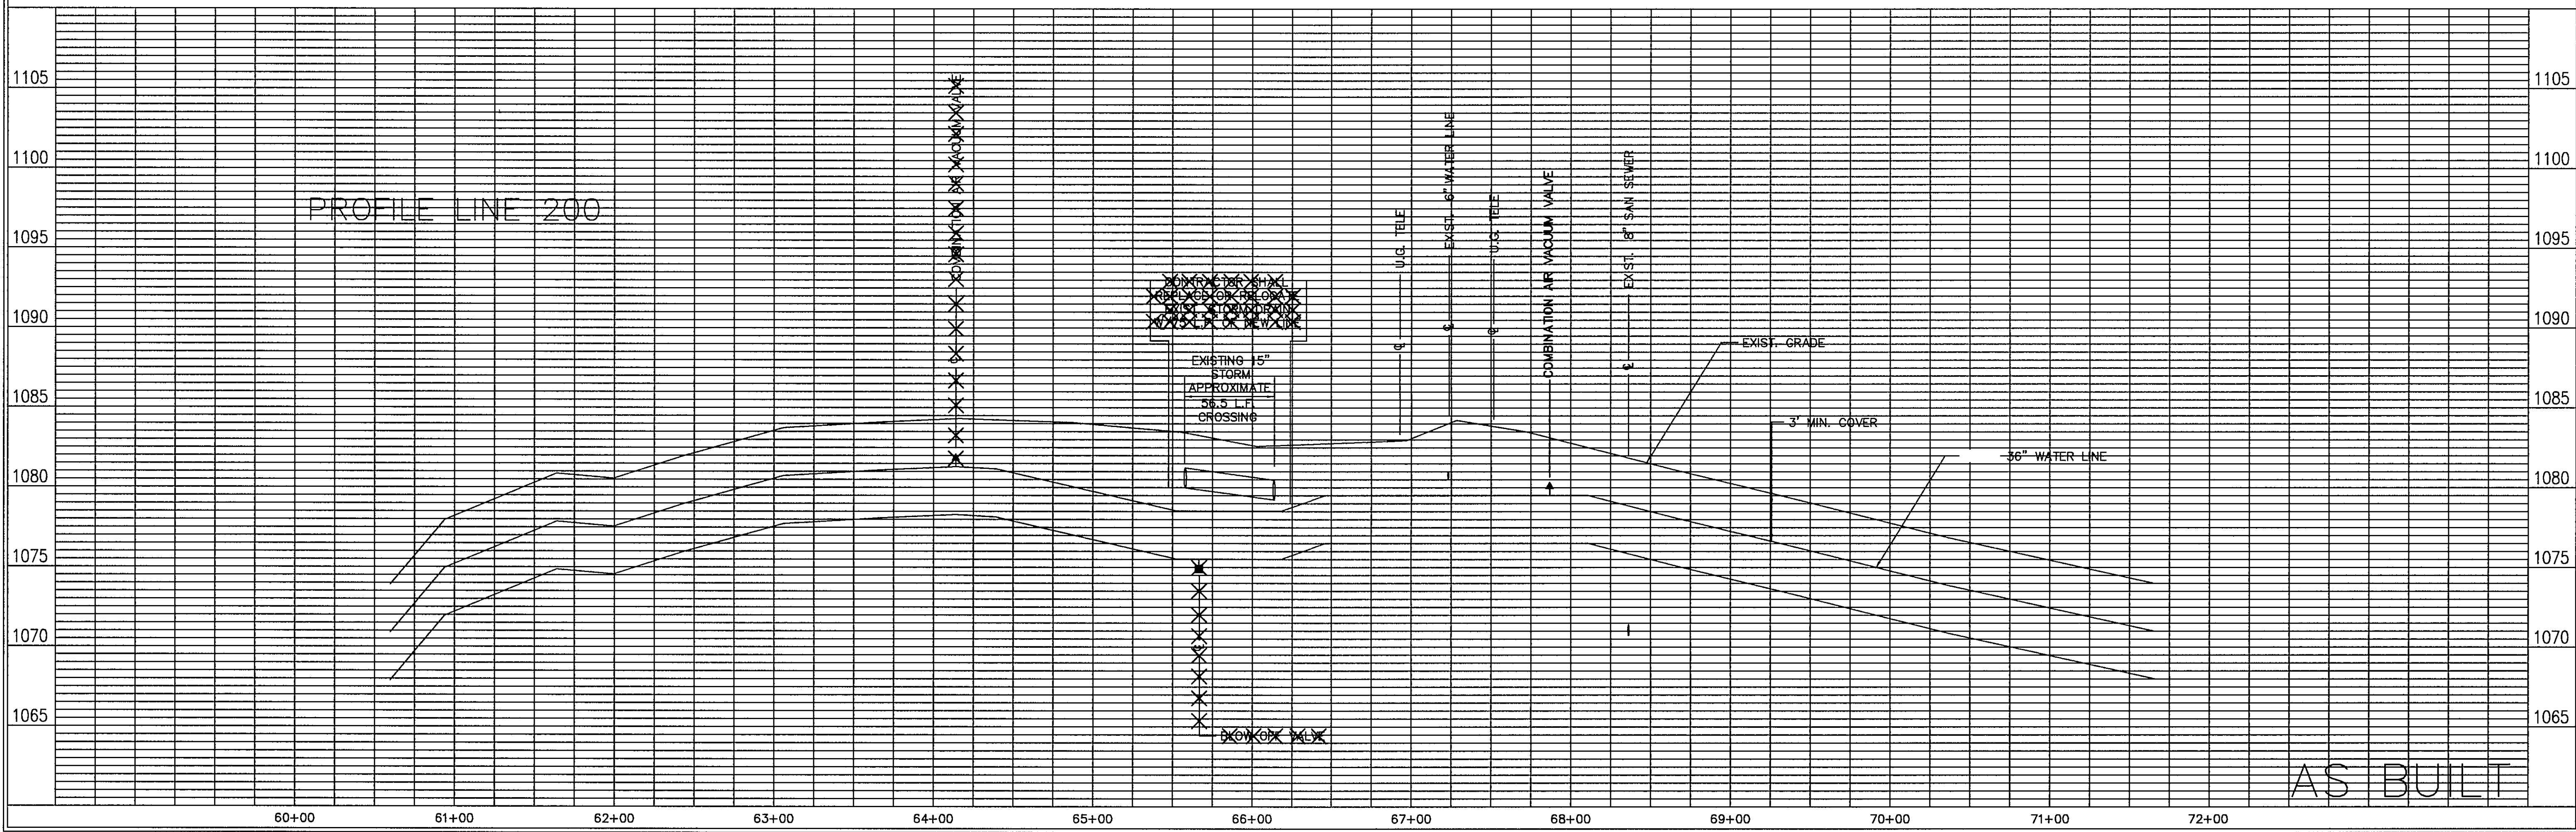

Dewberry & Davis
Architects
Engineers
Planners
Surveyors
5238 Valleypointe Parkway, Suite One-B
Roanoke, Virginia 24019
703 362-7726

Carvins Cove, Phase II
City of Roanoke
Roanoke, Virginia

CONTRACT "B1"
LINE 200
STA 60+59.80 - 71+65.30

Drawn By REH/ACF
Designed By RBS
Checked By SEH
Date MAY 93
Scale V: 1" = 5'
H: 1" = 50'
Plan Number E4
Zoned NONE
Sheet 7 of 25
File Number C1160