



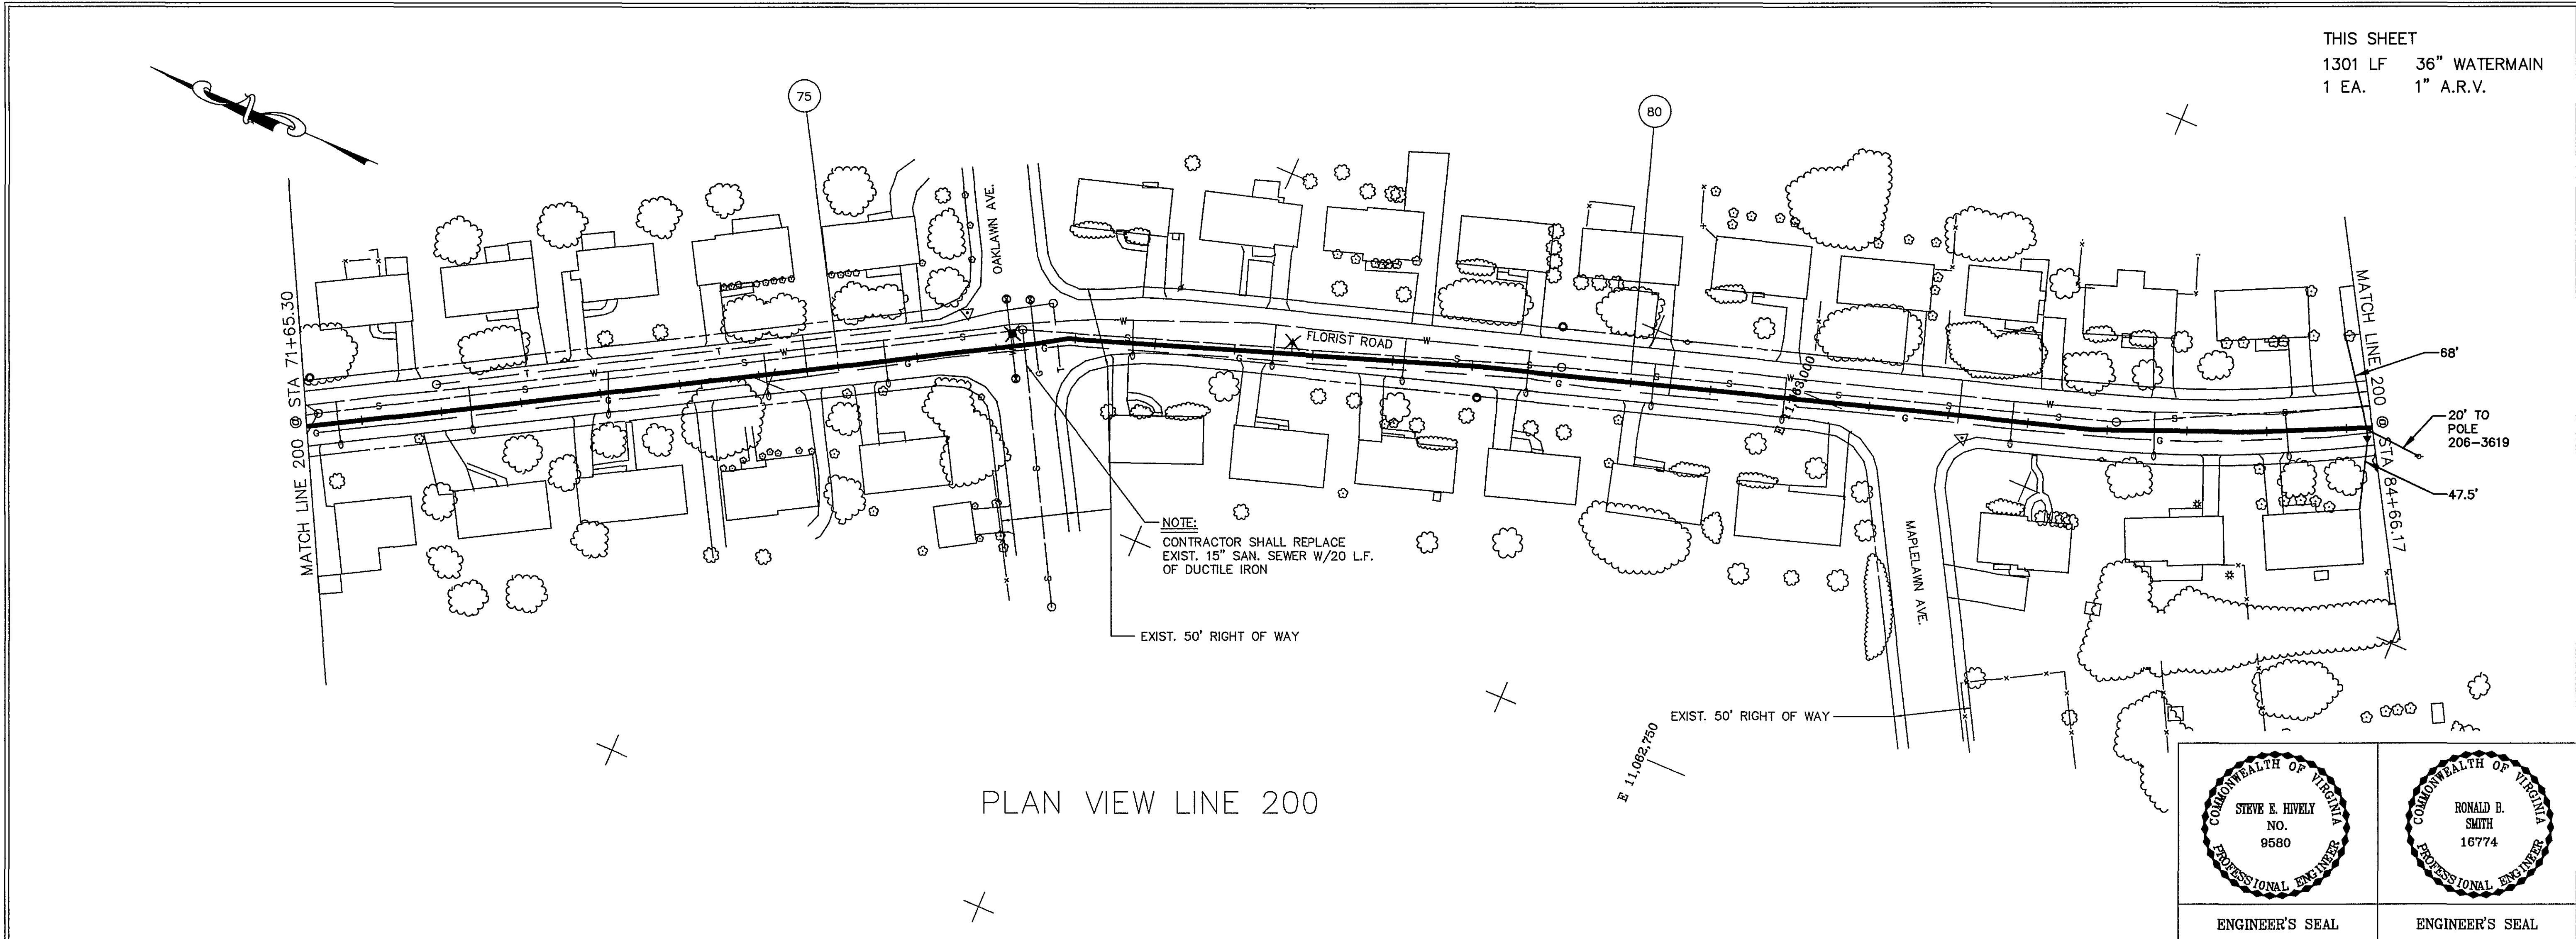

PLAN VIEW LINE 200

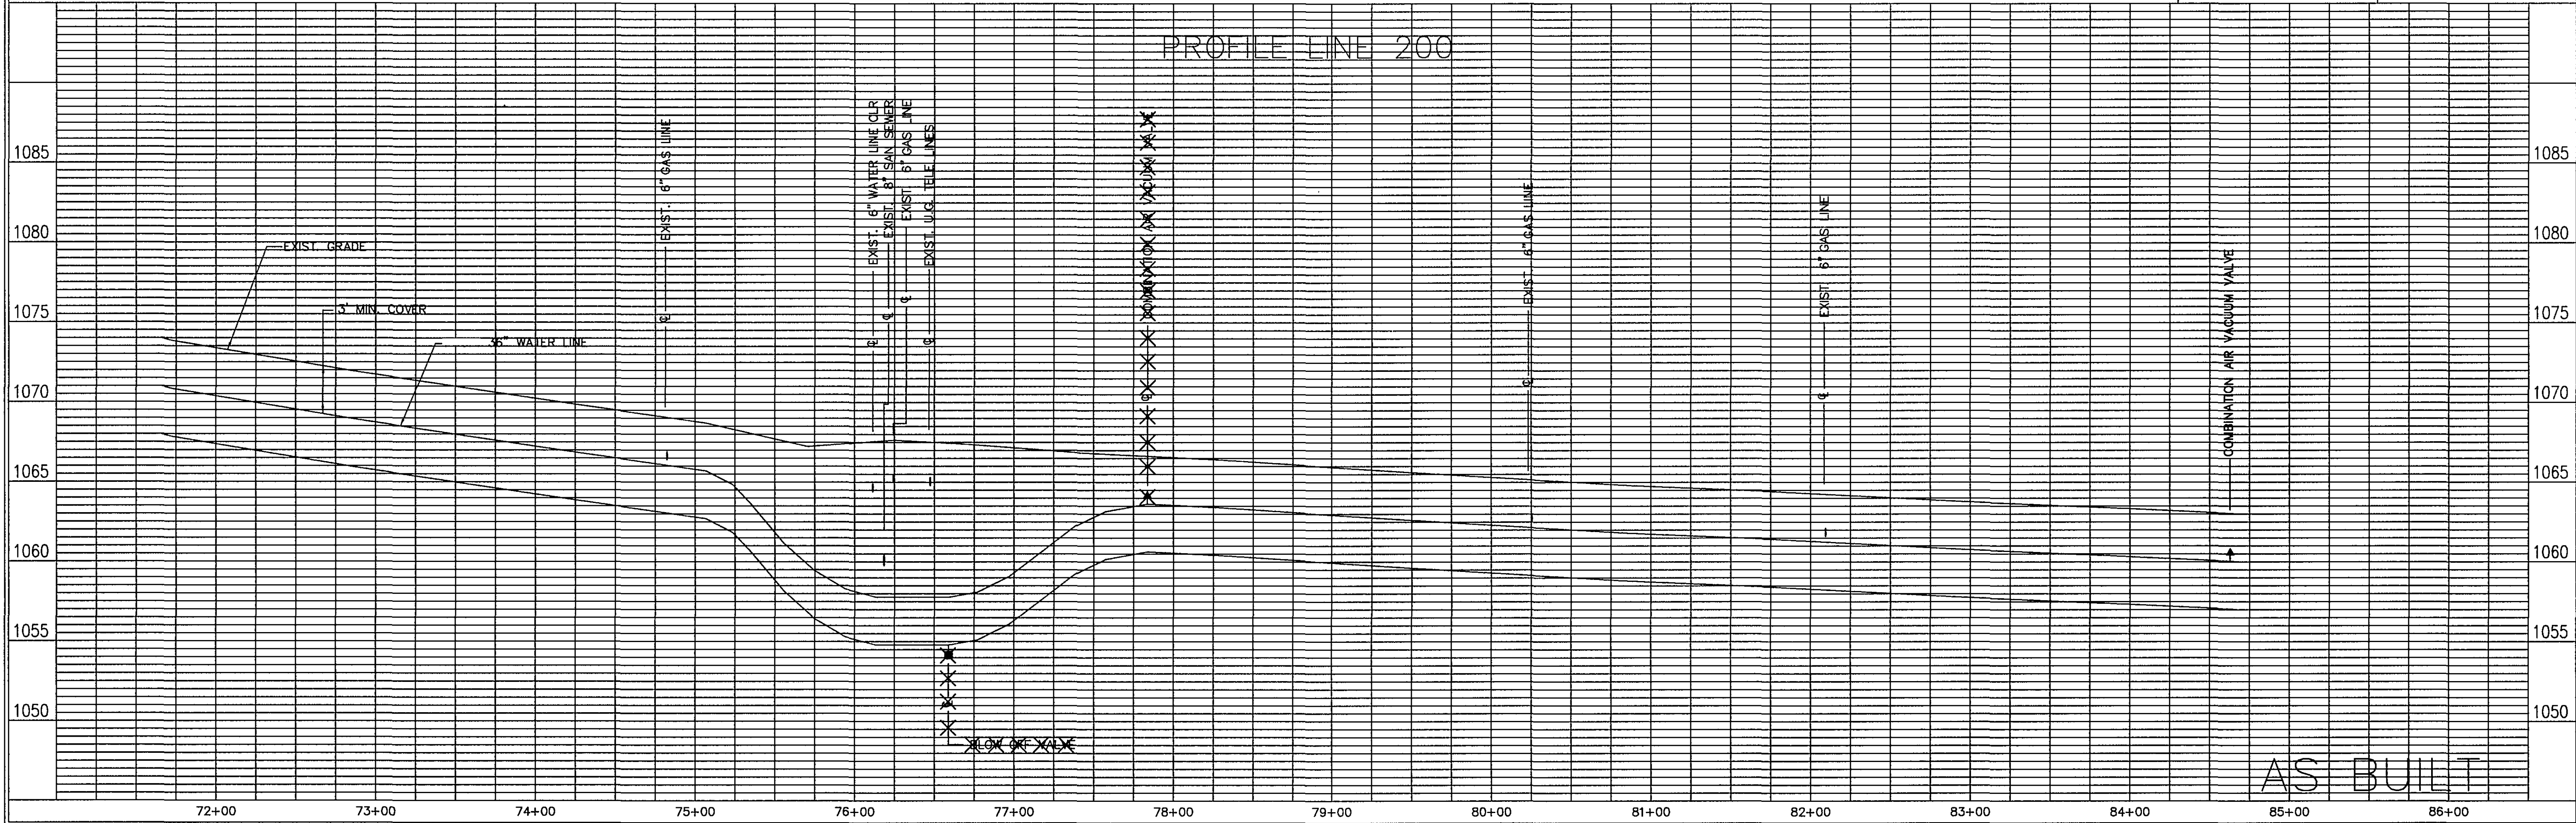

PROFILE LINE 200

ENGINEER'S SEAL	ENGINEER'S SEAL

 Dewberry & Davis Architects Engineers Planners Surveyors 5238 Valleypointe Parkway, Suite One-B Roanoke, Virginia 24019 ☎ 703 362-7725	Carvins Cove, Phase II City of Roanoke Roanoke, Virginia
	CONTRACT "B1" LINE 200 STA 71+65.30 - 84+66.17
	Drawn By ACF/REH Designed By RBS Checked By SEH Date MAY 93 Scale V: 1" = 5' H: 1" = 50' Plan Number E5 Zoned NONE Sheet 8 of 25 File Number C1160