

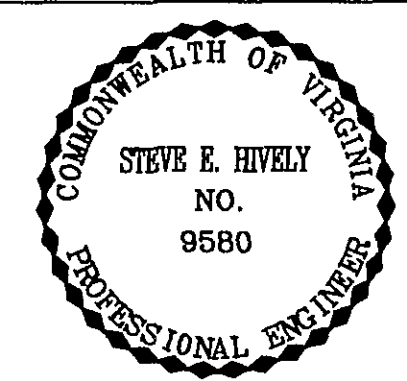
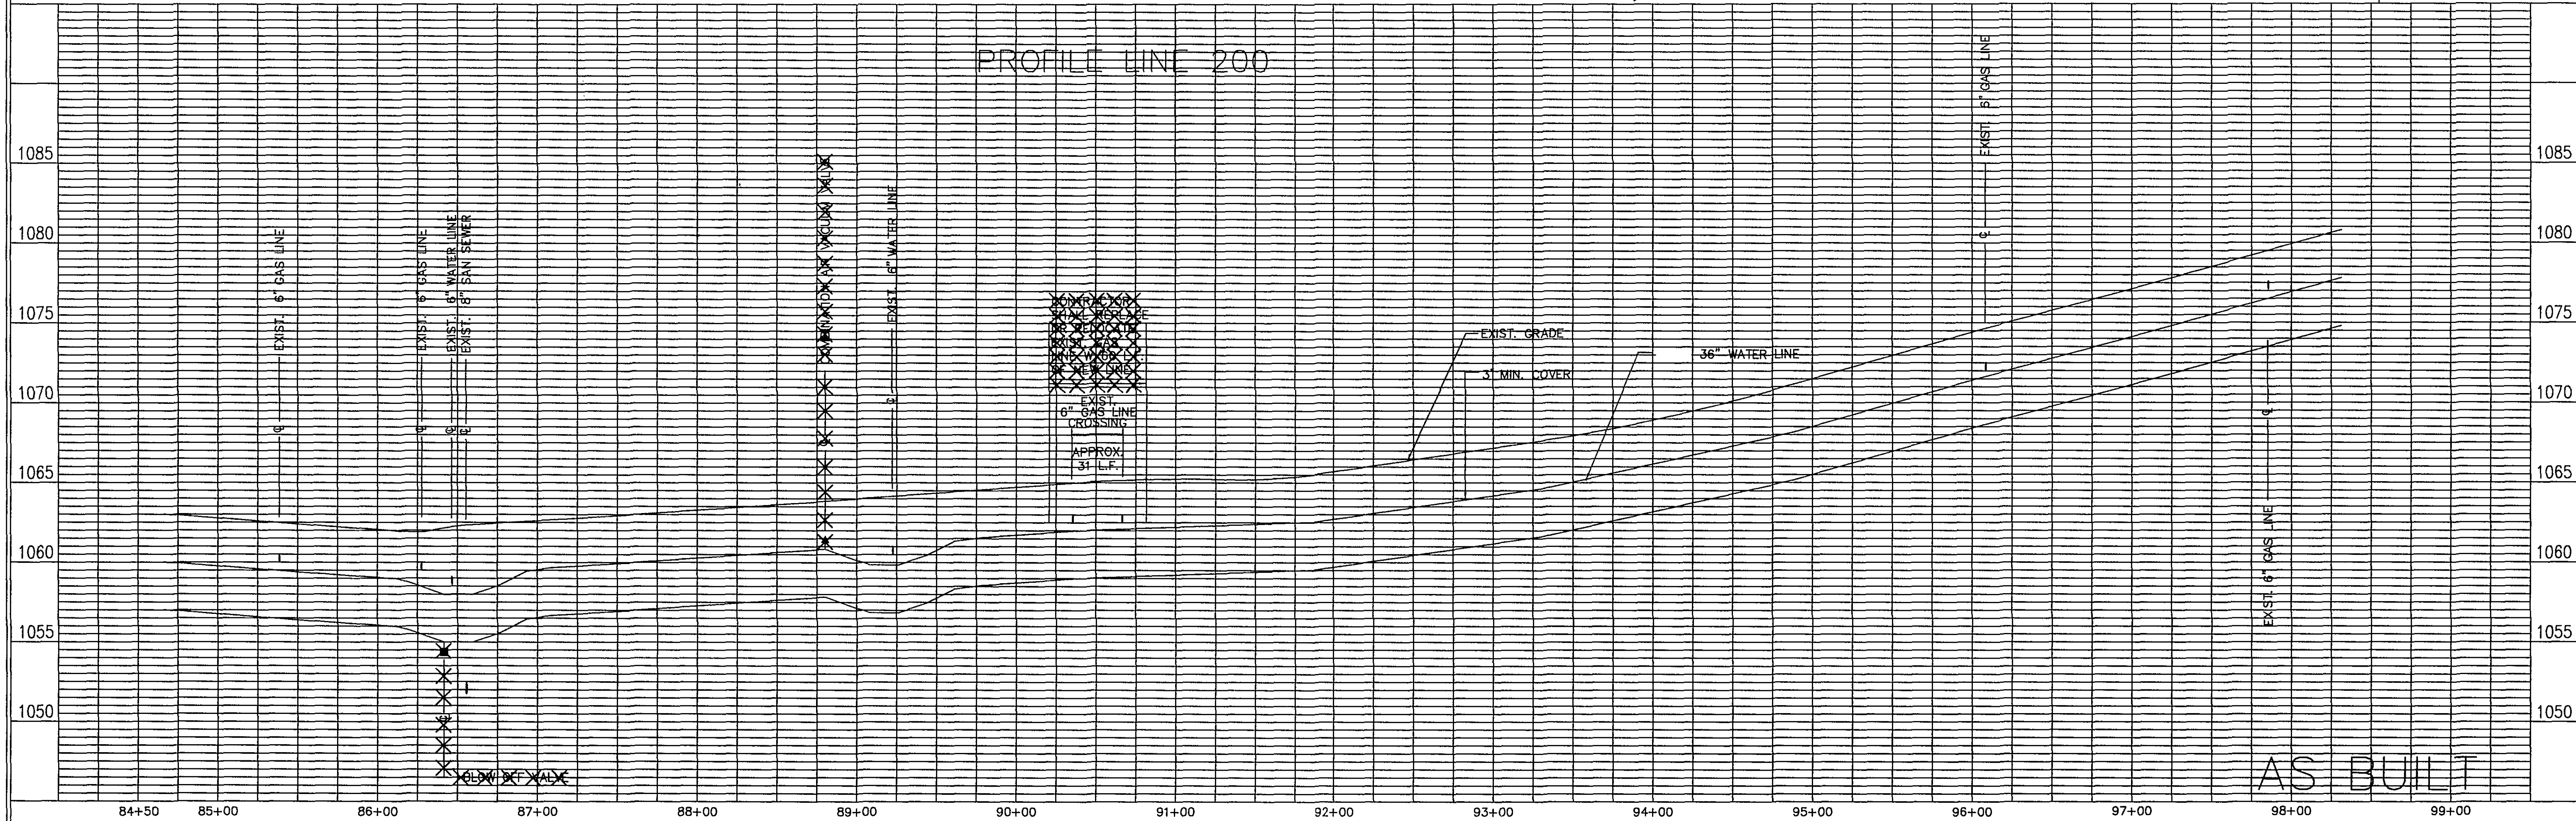


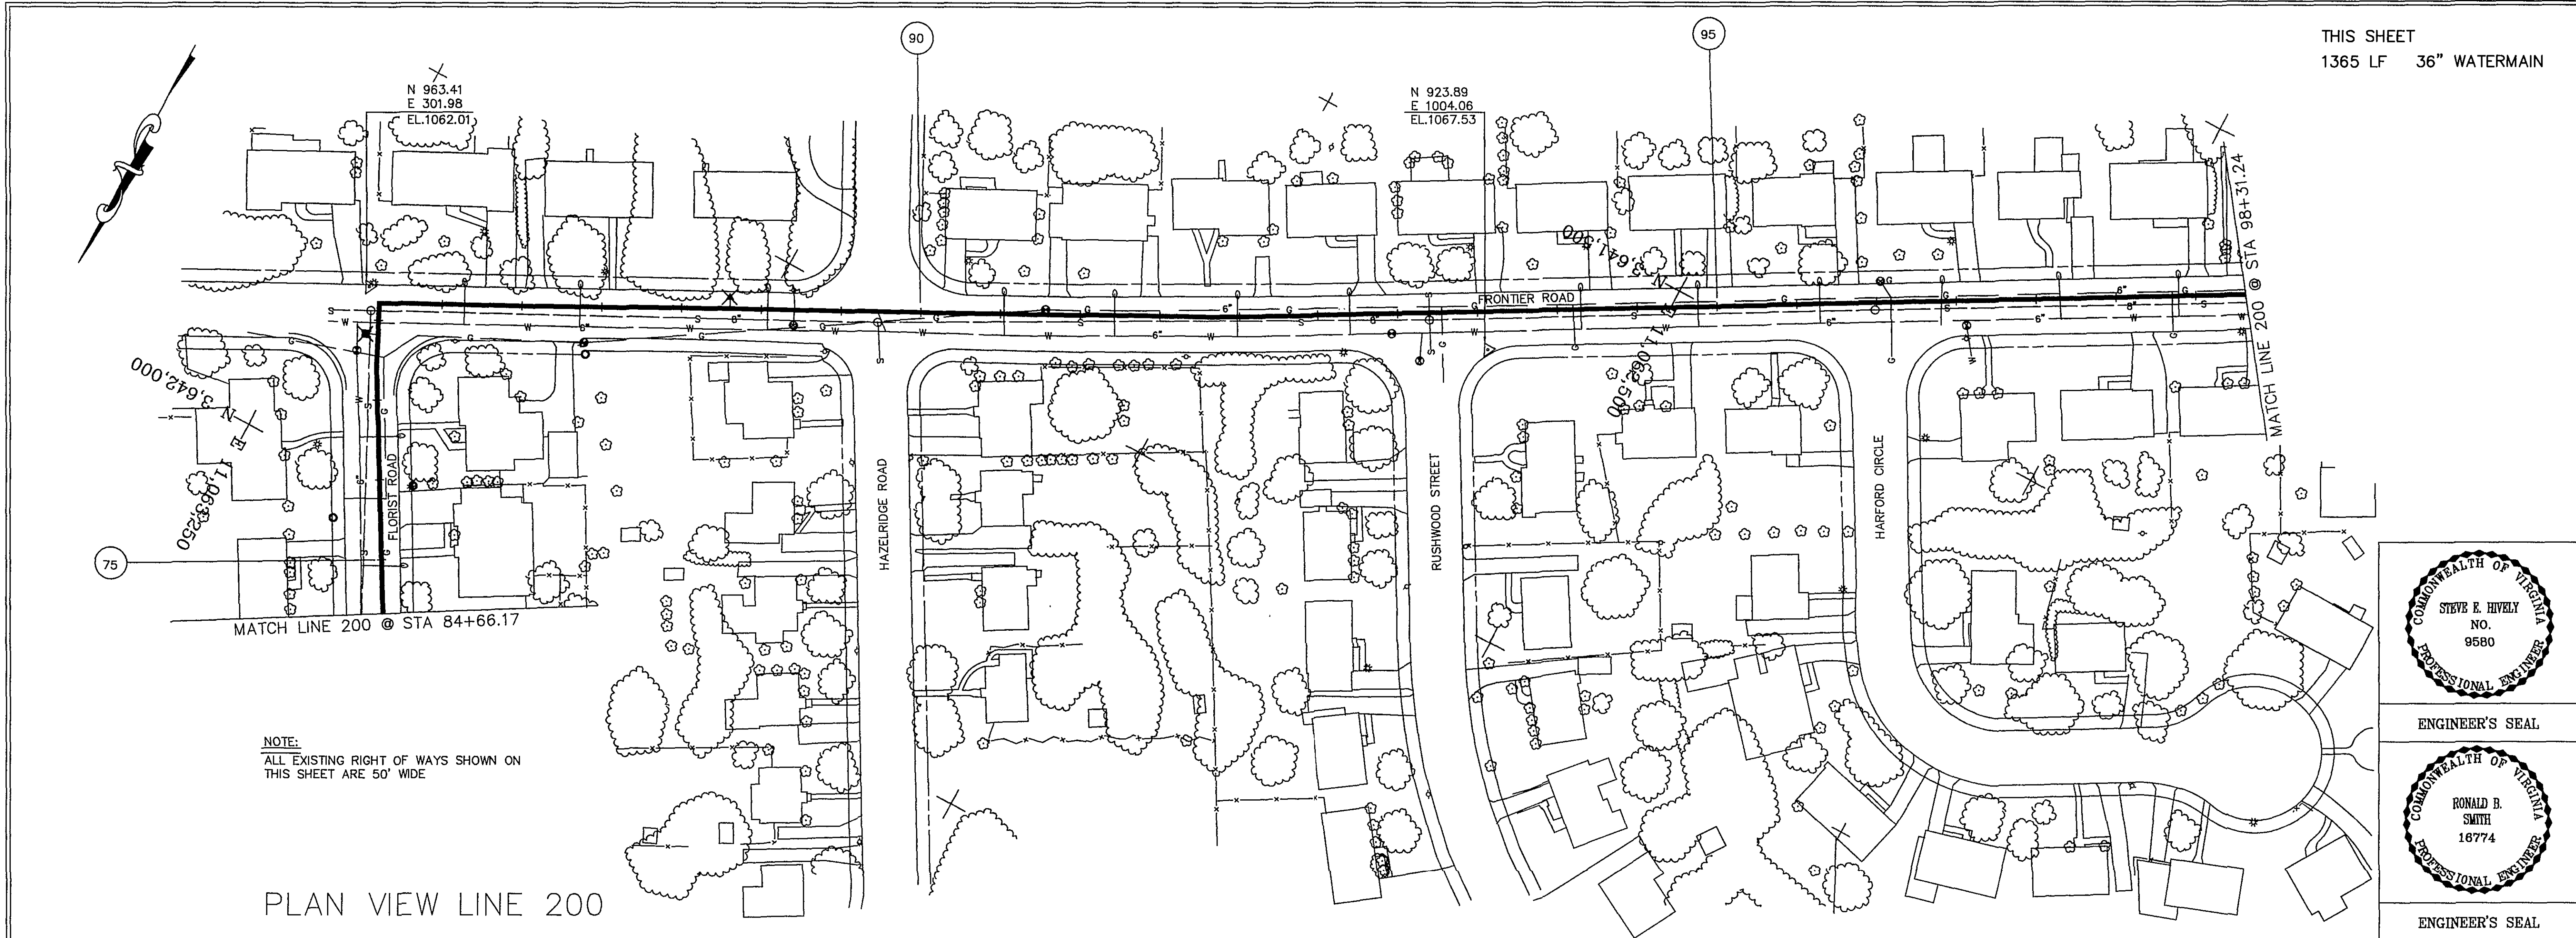

ENGINEER'S SEAL

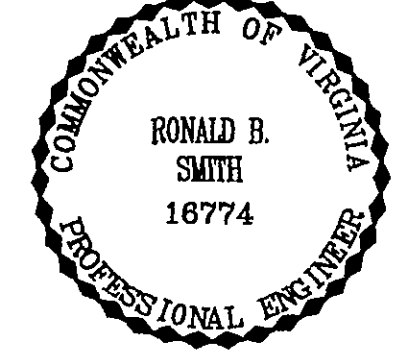

ENGINEER'S SEAL

Architects
Engineers
Planners
Surveyors

Dewberry & Davis

5238 Valleypointe Parkway, Suite One-B
Roanoke, Virginia 24019
703 382-7725

Carvins Cove, Phase II
City of Roanoke
Roanoke, Virginia

CONTRACT "B1"
LINE 200
STA 84+66.17 - 98+31.24

Drawn By	ACF/REH
Designed By	RBS
Checked By	SEH
Date	MAY 93
Scale	V: 1" = 5' H: 1" = 50'
Plan Number	E6
Zoned	NONE
Sheet	9 of 25
File Number	C1160