


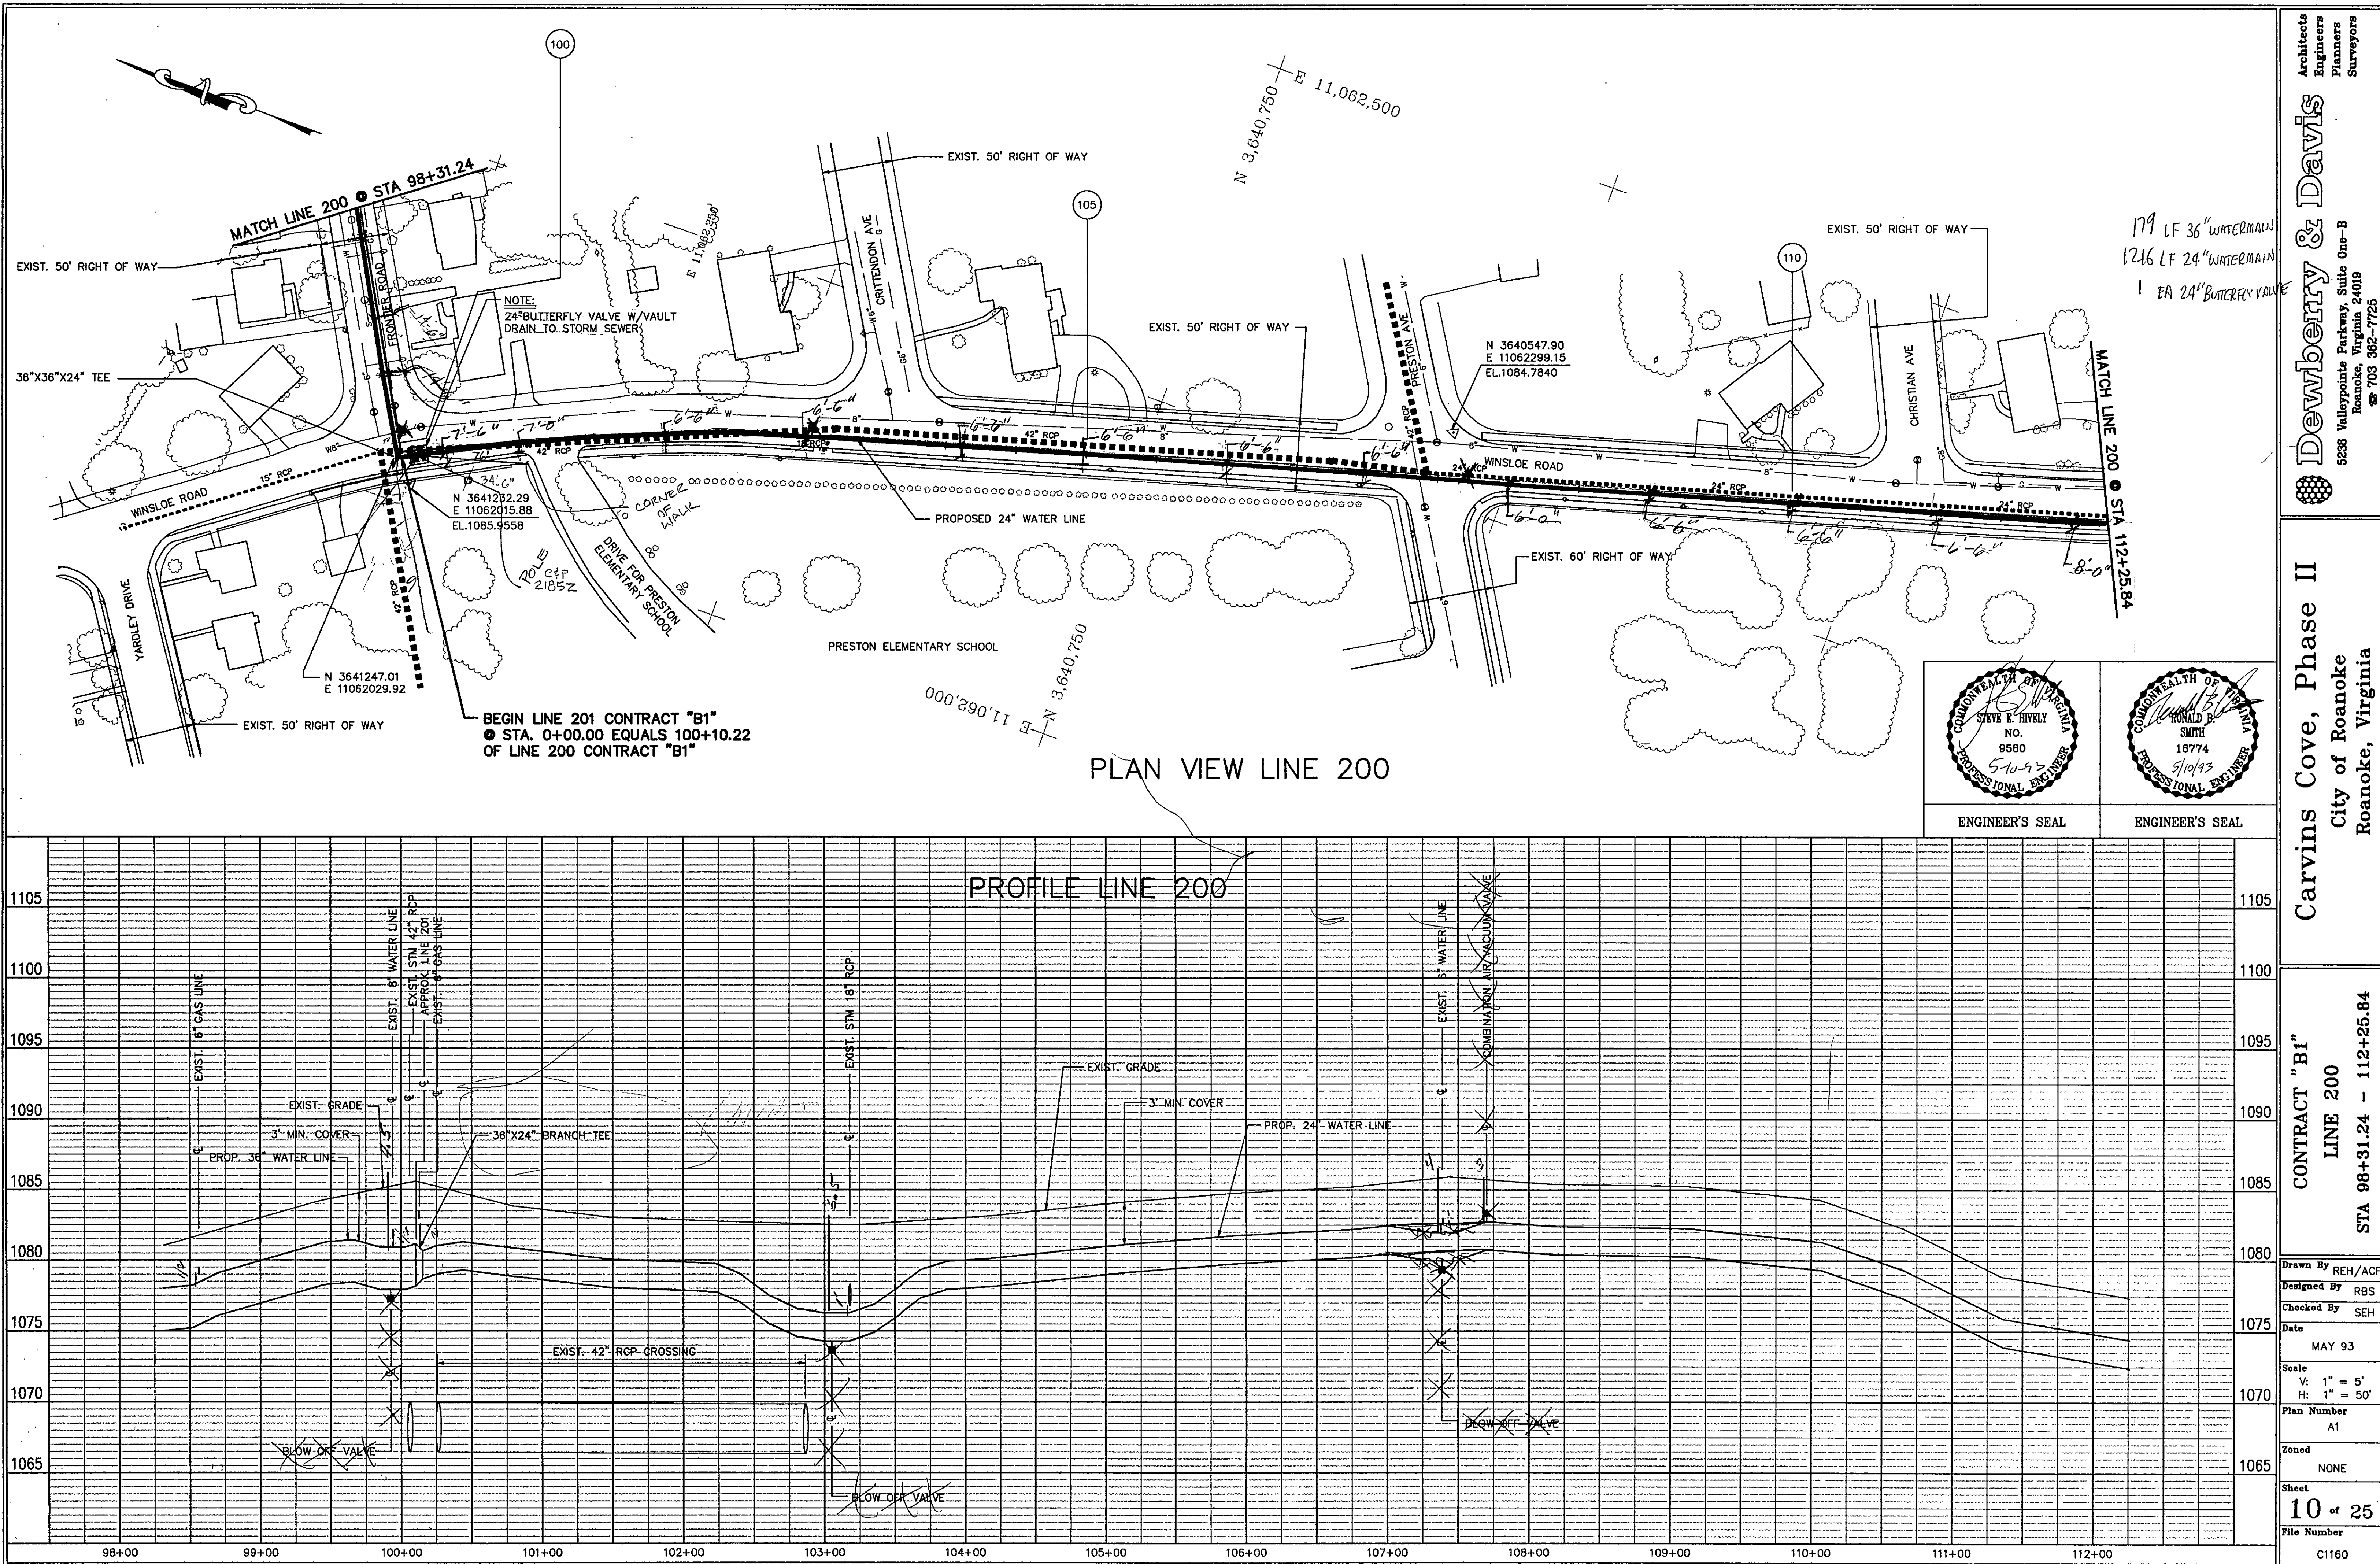

Architects
Engineers
Planners
Surveyors

Dewberry & Davis

5238 Valleypointe Parkway, Suite One-B
Roanoke, Virginia 24019
703 362-7725

Carvins Cove, Phase II

City of Roanoke

Roanoke, Virginia

CONTRACT "B1"

LINE 200

STA 98+31.24 - 112+25.84

Drawn By REH/ACF

Designed By RBS

Checked By SEH

Date MAY 93

Scale V: 1" = 5'
H: 1" = 50'

Plan Number A1

Zoned NONE

Sheet 10 of 25

File Number C1160