
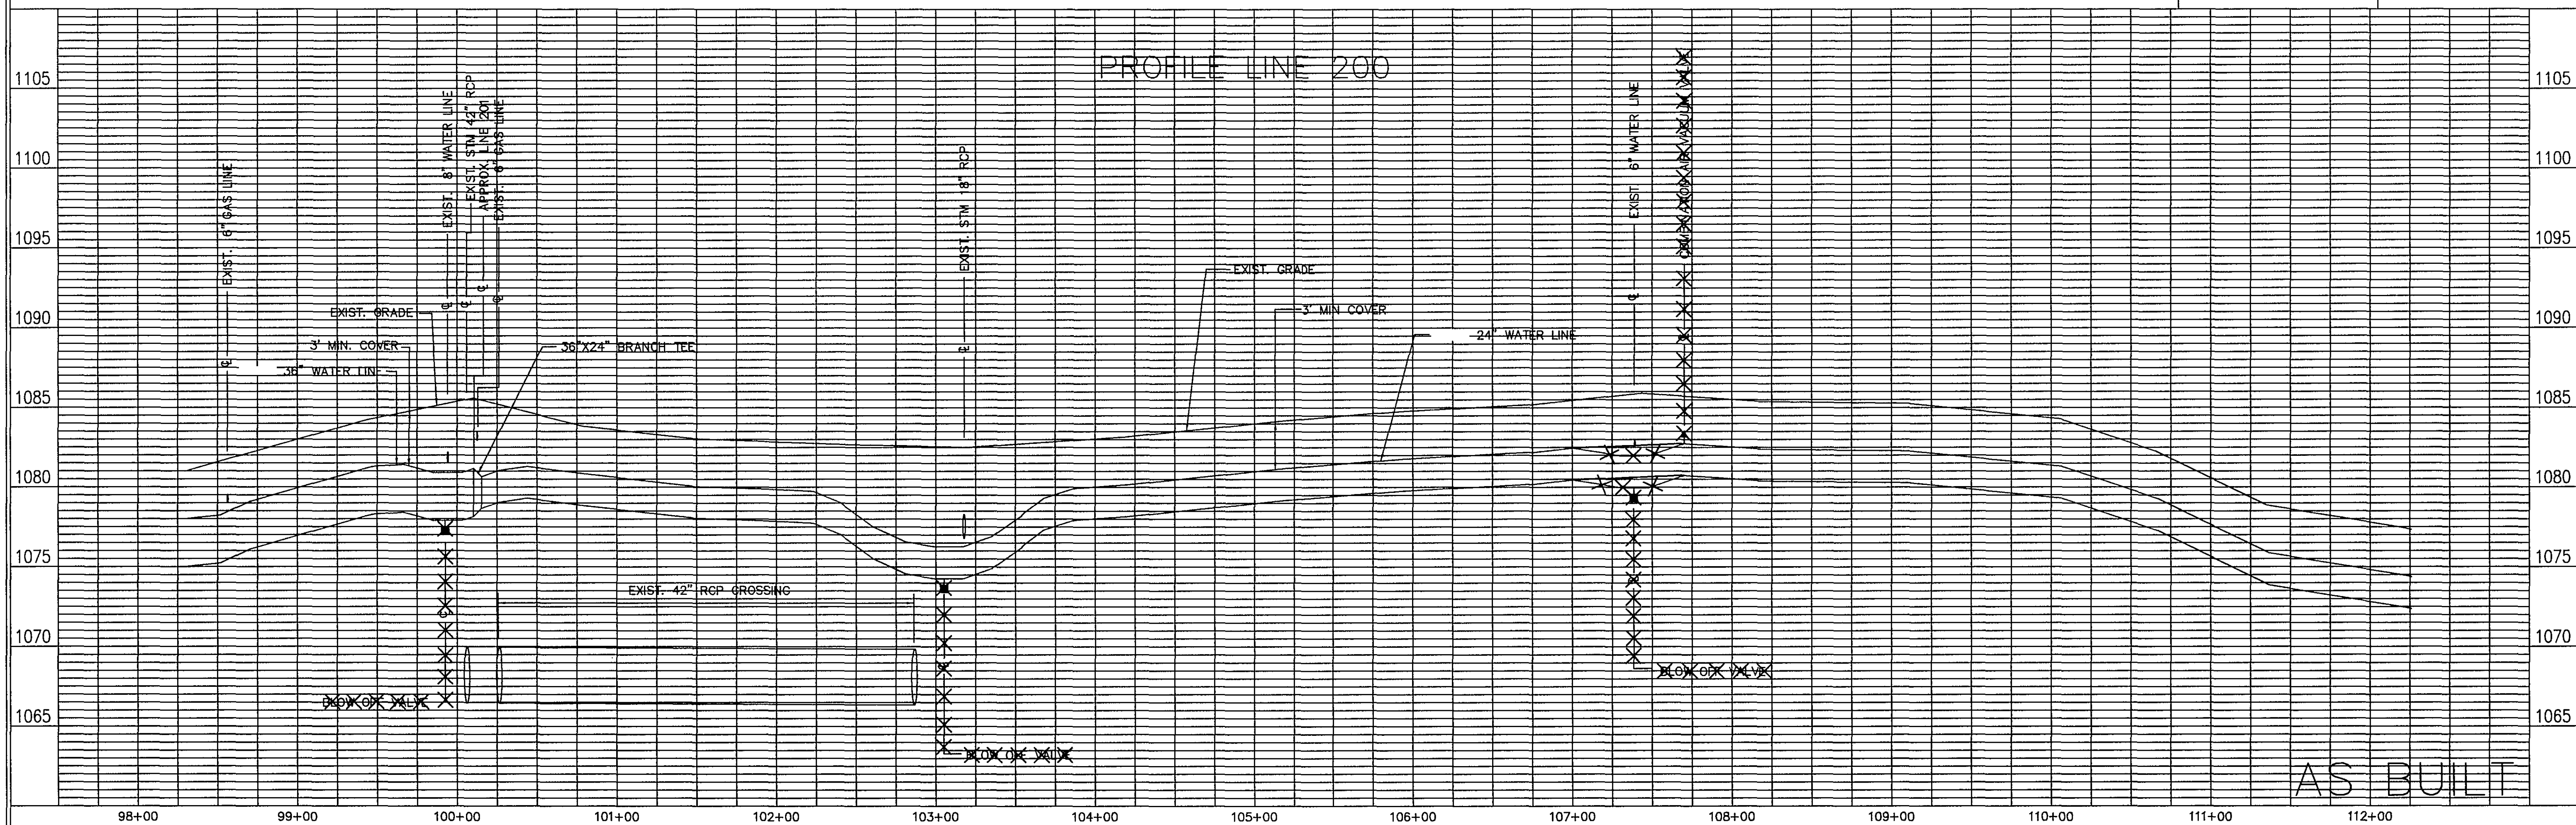


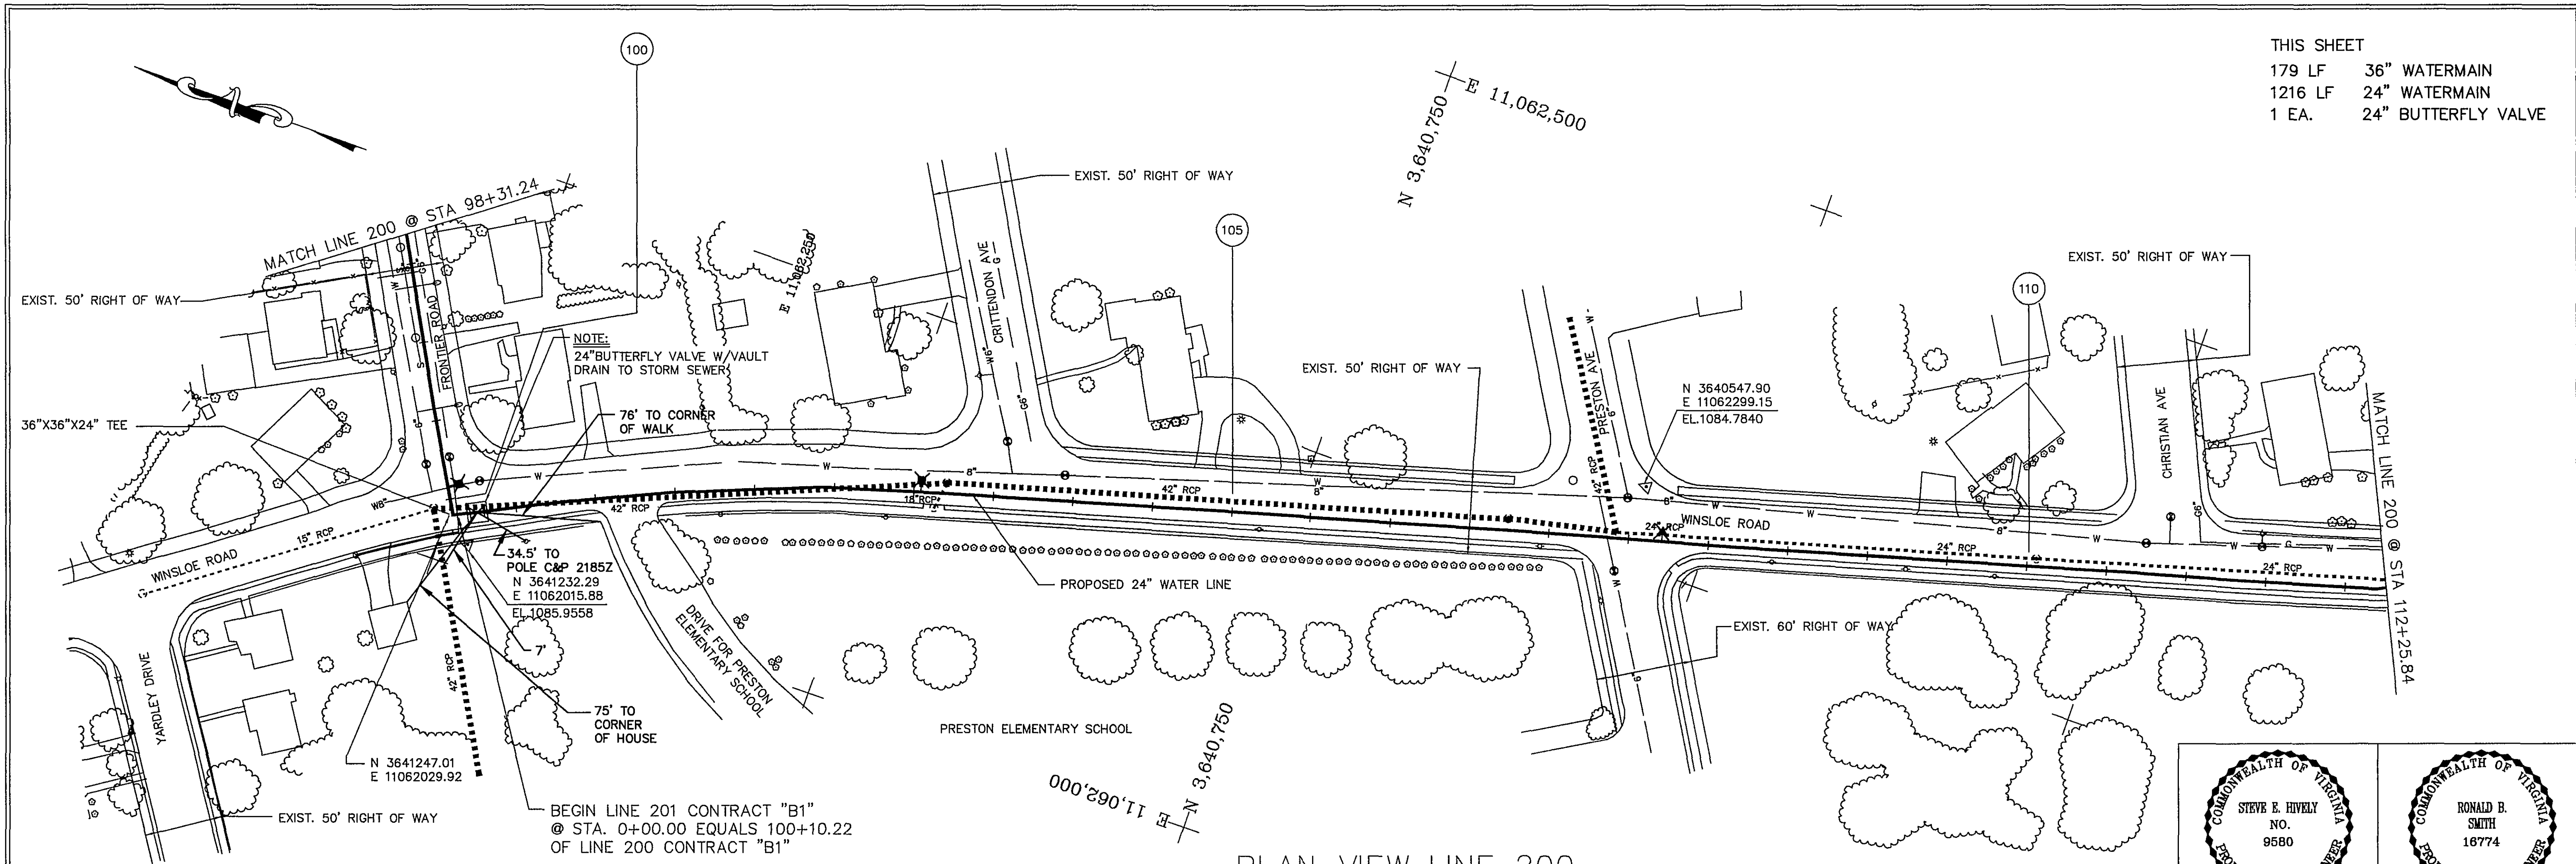

Dewberry & Davis
Architects
Engineers
Planners
Surveyors
6238 Valleypointe Parkway, Suite One-B
Roanoke, Virginia 24019
703 362-7725

Carvins Cove, Phase II
City of Roanoke
Roanoke, Virginia

CONTRACT "B1"
LINE 200
STA 98+31.24 - 112+25.84

Drawn By REH/ACF
Designed By RBS
Checked By SEH
Date MAY 93
Scale V: 1" = 5'
H: 1" = 50'
Plan Number A1
Zoned NONE
Sheet 10 of 25
File Number C1160

ENGINEER'S SEAL
STEVE E. HIVELY
NO. 9580
PROFESSIONAL ENGINEER
COMMONWEALTH OF VIRGINIA

ENGINEER'S SEAL
RONALD B. SMITH
18774
PROFESSIONAL ENGINEER
COMMONWEALTH OF VIRGINIA